


USER: THERESA
 SCALE: SCALE=20, 000000
 FILE: V\B\W\H\T\FULL.TBL

I:\AP\01\371301\371301.dgn\371301\UWT17.DGN
 8/13/2010 10:58:10

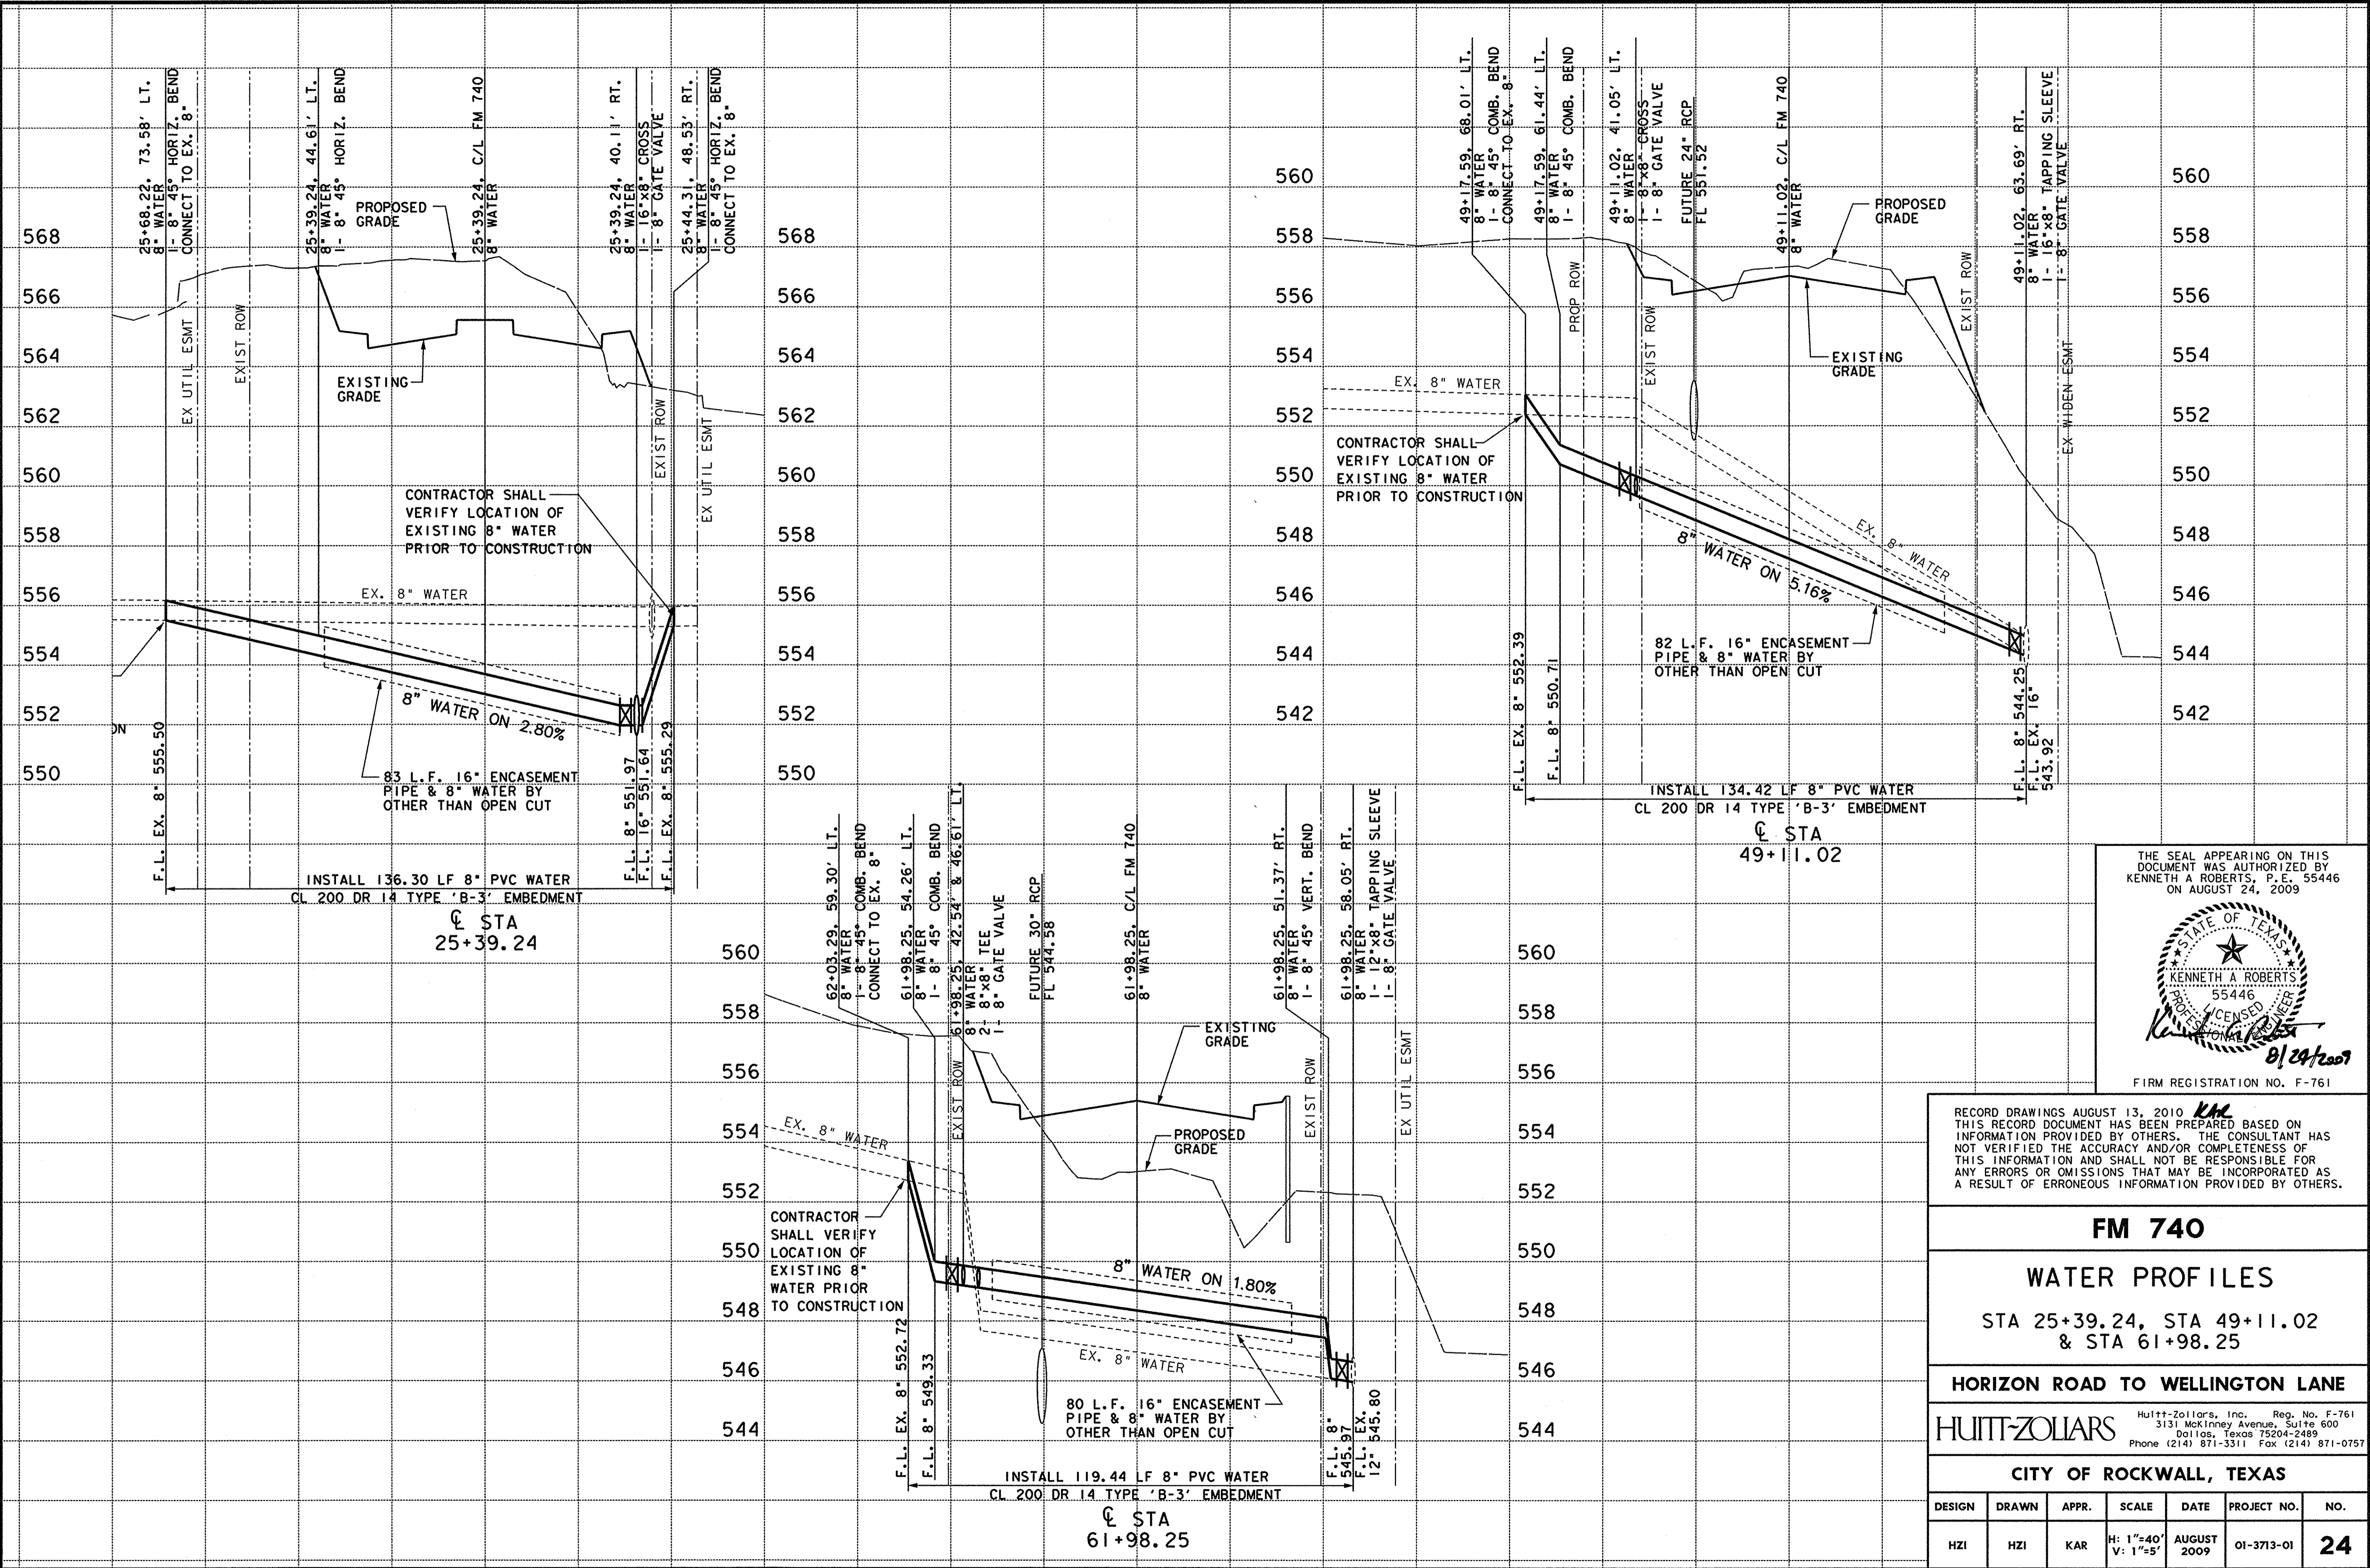

THE SEAL APPEARING ON THIS DOCUMENT WAS AUTHORIZED BY KENNETH A. ROBERTS, P.E. 55446 ON AUGUST 24, 2009

FIRM REGISTRATION NO. F-761

RECORD DRAWINGS AUGUST 13, 2010
 THIS RECORD DOCUMENT HAS BEEN PREPARED BASED ON INFORMATION PROVIDED BY OTHERS. THE CONSULTANT HAS NOT VERIFIED THE ACCURACY AND/OR COMPLETENESS OF THIS INFORMATION AND SHALL NOT BE RESPONSIBLE FOR ANY ERRORS OR OMISSIONS THAT MAY BE INCORPORATED AS A RESULT OF ERRONEOUS INFORMATION PROVIDED BY OTHERS.

FM 740

WATER PROFILES

STA 25+39.24, STA 49+11.02
 & STA 61+98.25

HORIZON ROAD TO WELLINGTON LANE

HUITT-ZOLLARS

Huitt-Zollars, Inc. Reg. No. F-761
 3131 McKinney Avenue, Suite 600
 Dallas, Texas 75204-2489
 Phone (214) 871-3311 Fax (214) 871-0757

CITY OF ROCKWALL, TEXAS

DESIGN	DRAWN	APPR.	SCALE	DATE	PROJECT NO.	NO.
HZI	HZI	KAR	H: 1"=40' V: 1"=5'	AUGUST 2009	01-3713-01	24

I:\AP\01\371301\371301.dgn\371301\UWT17.DGN 8/13/2010 10:58:10