


USER=TERESSA
 SCALE=SCALE=20.000000
 F:\TBL\Y8HW\FULL.TBL

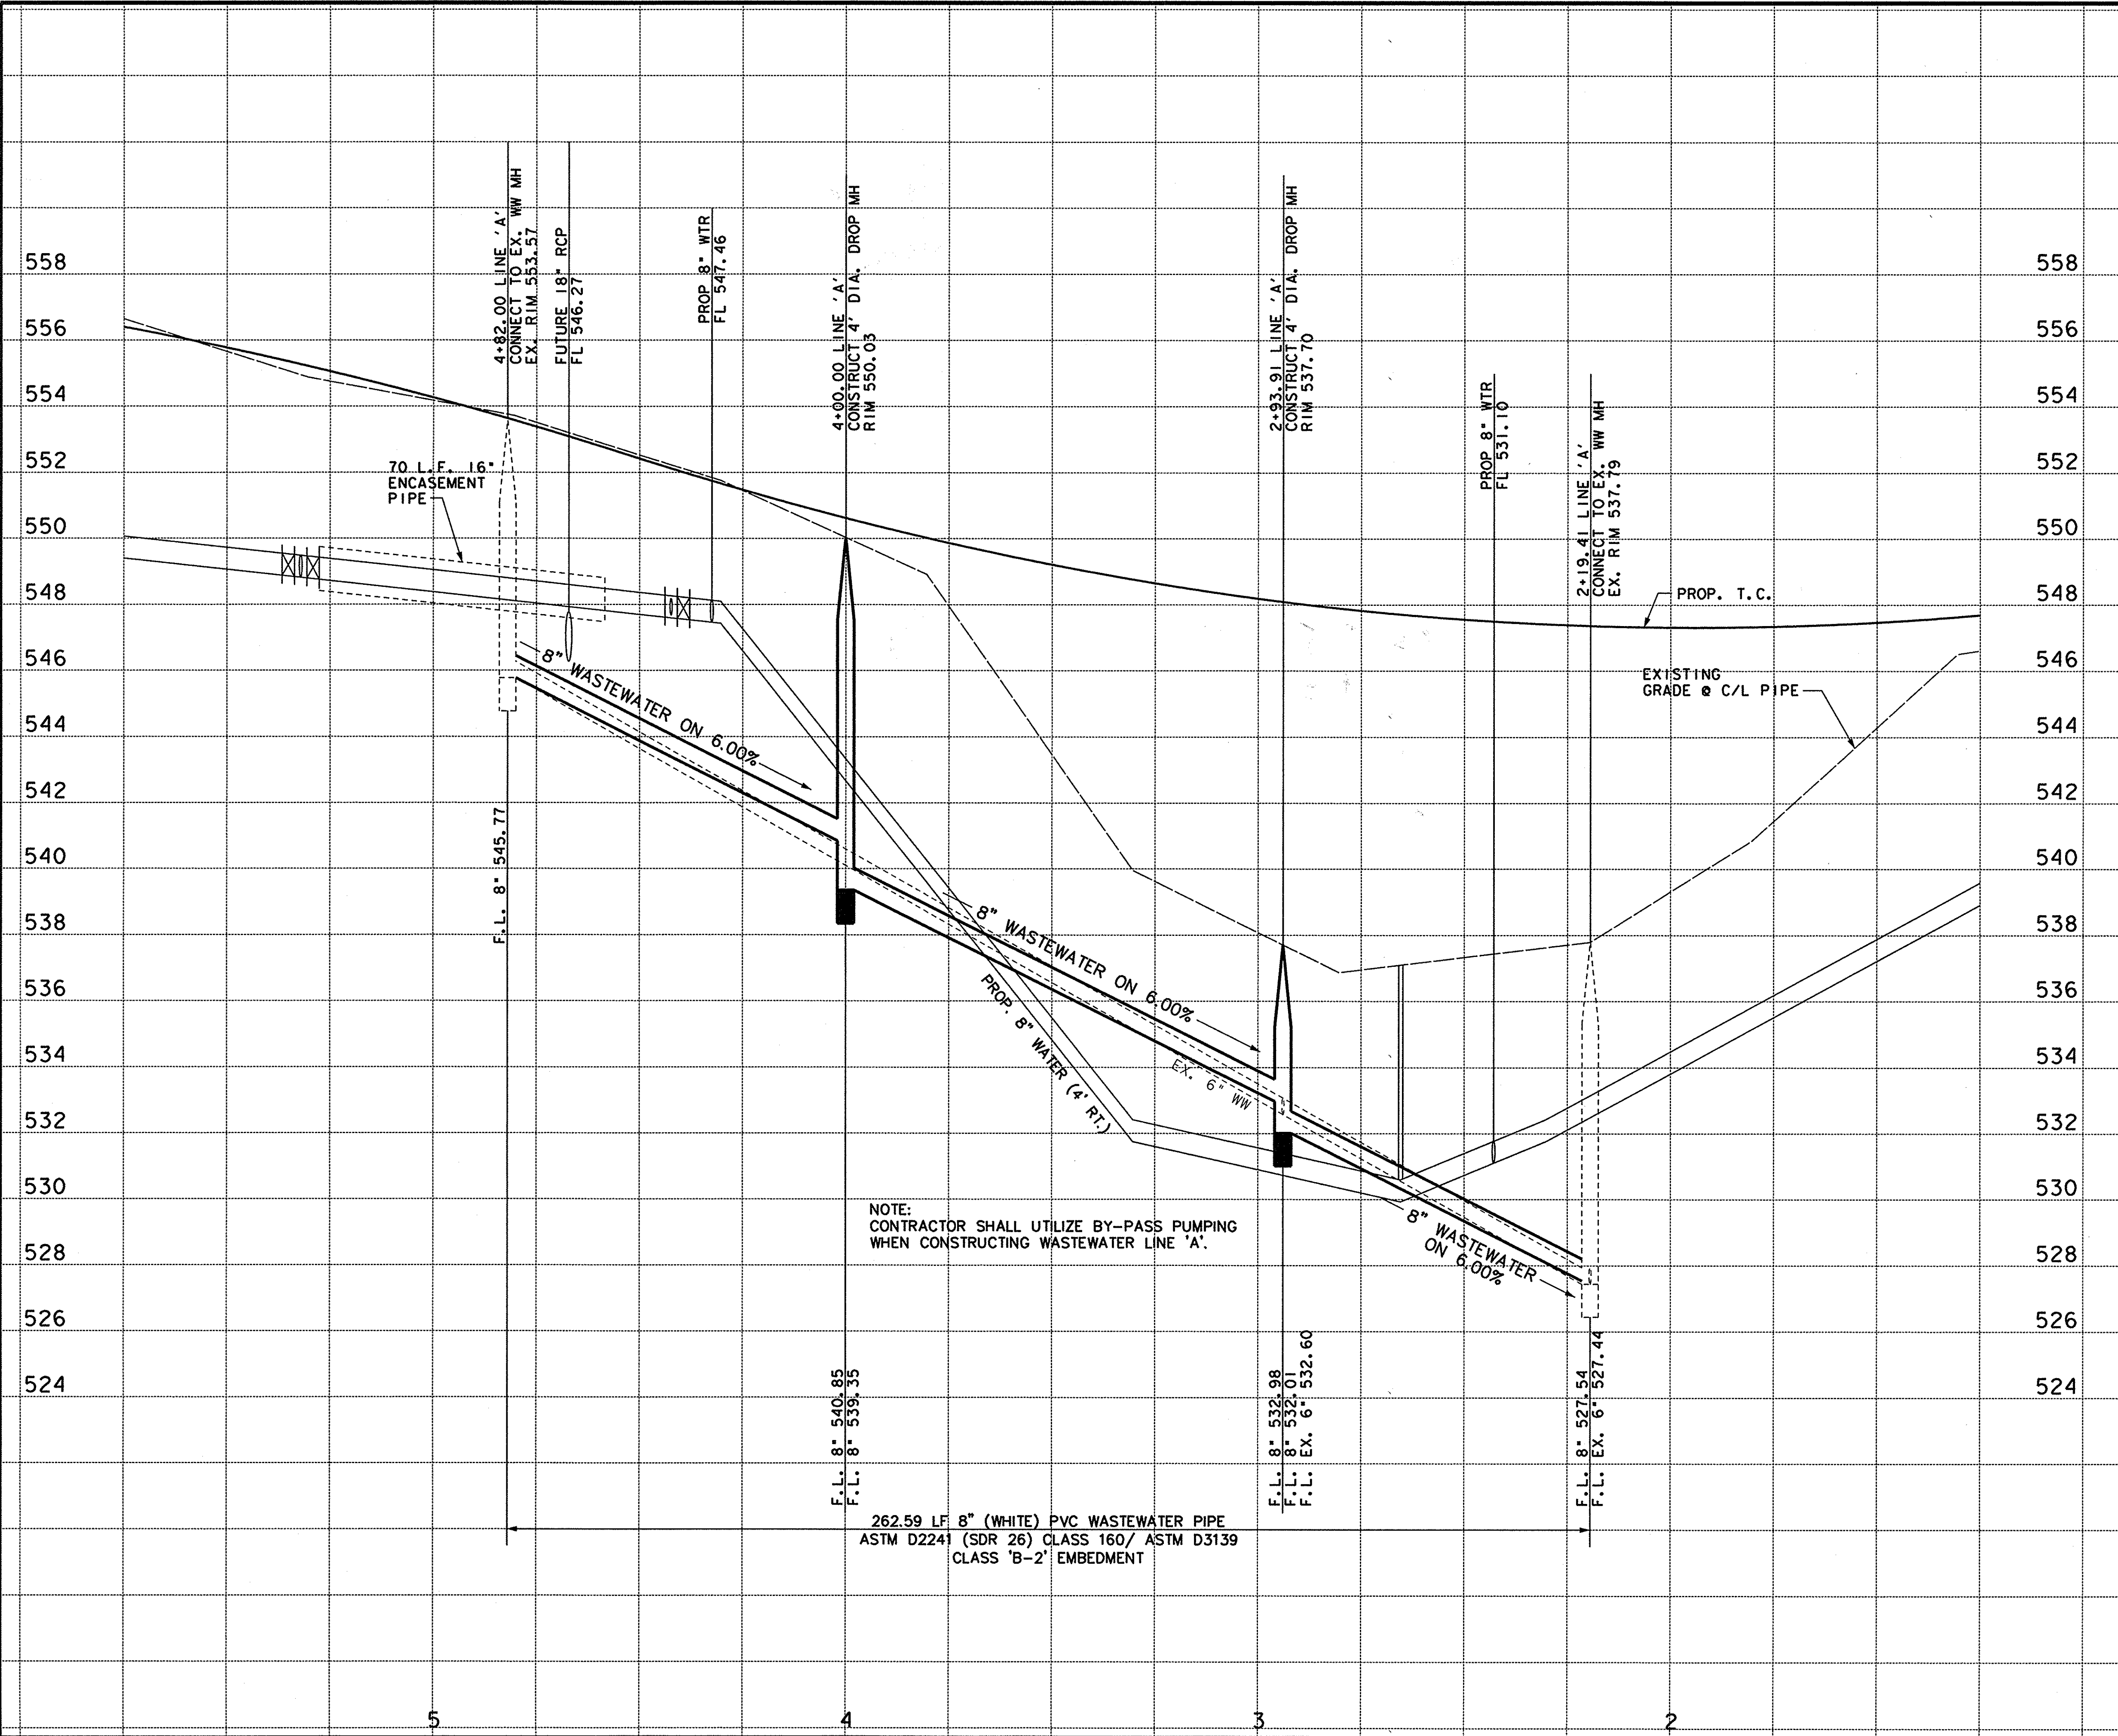

THE SEAL APPEARING ON THIS DOCUMENT WAS AUTHORIZED BY KENNETH A ROBERTS, P.E. 55446 ON AUGUST 24, 2009

FIRM REGISTRATION NO. F-761

RECORD DRAWINGS AUGUST 13, 2010
 THIS RECORD DOCUMENT HAS BEEN PREPARED BASED ON INFORMATION PROVIDED BY OTHERS. THE CONSULTANT HAS NOT VERIFIED THE ACCURACY AND/OR COMPLETENESS OF THIS INFORMATION AND SHALL NOT BE RESPONSIBLE FOR ANY ERRORS OR OMISSIONS THAT MAY BE INCORPORATED AS A RESULT OF ERRONEOUS INFORMATION PROVIDED BY OTHERS.

FM 740

WASTEWATER PROFILE

LINE 'A'

HORIZON ROAD TO WELLINGTON LANE

HUITT-ZOLLARS Reg. No. F-761
3131 McKinney Avenue, Suite 600
Dallas, Texas 75204-2489
Phone (214) 871-3311 Fax (214) 871-0757

CITY OF ROCKWALL, TEXAS

DESIGN	DRAWN	APPR.	SCALE	DATE	PROJECT NO.	NO.
HZI	HZI	KAR	H: 1"=40' V: 1"=5'	AUGUST 2009	01-3713-01	25

NOTE:
 CONTRACTOR SHALL UTILIZE BY-PASS PUMPING WHEN CONSTRUCTING WASTEWATER LINE 'A'.

262.59 LF 8" (WHITE) PVC WASTEWATER PIPE
 ASTM D2241 (SDR 26) CLASS 160/ ASTM D3139
 CLASS 'B-2' EMBEDMENT

I:\p\01\01371301\dgn\371301UWT18.DGN 8/13/2010 10:58:19