

ROCKWALL, TEXAS

WATER AND WASTEWATER UTILITY RELOCATIONS

F.M. 740 WIDENING

MAYOR

George Hatfield

CITY COUNCIL

Dale Morgan

Pat Luby

Todd W. White


Sam Buffington

Ron Coleson

Nell Welborn

CITY MANAGER

Julie Couch

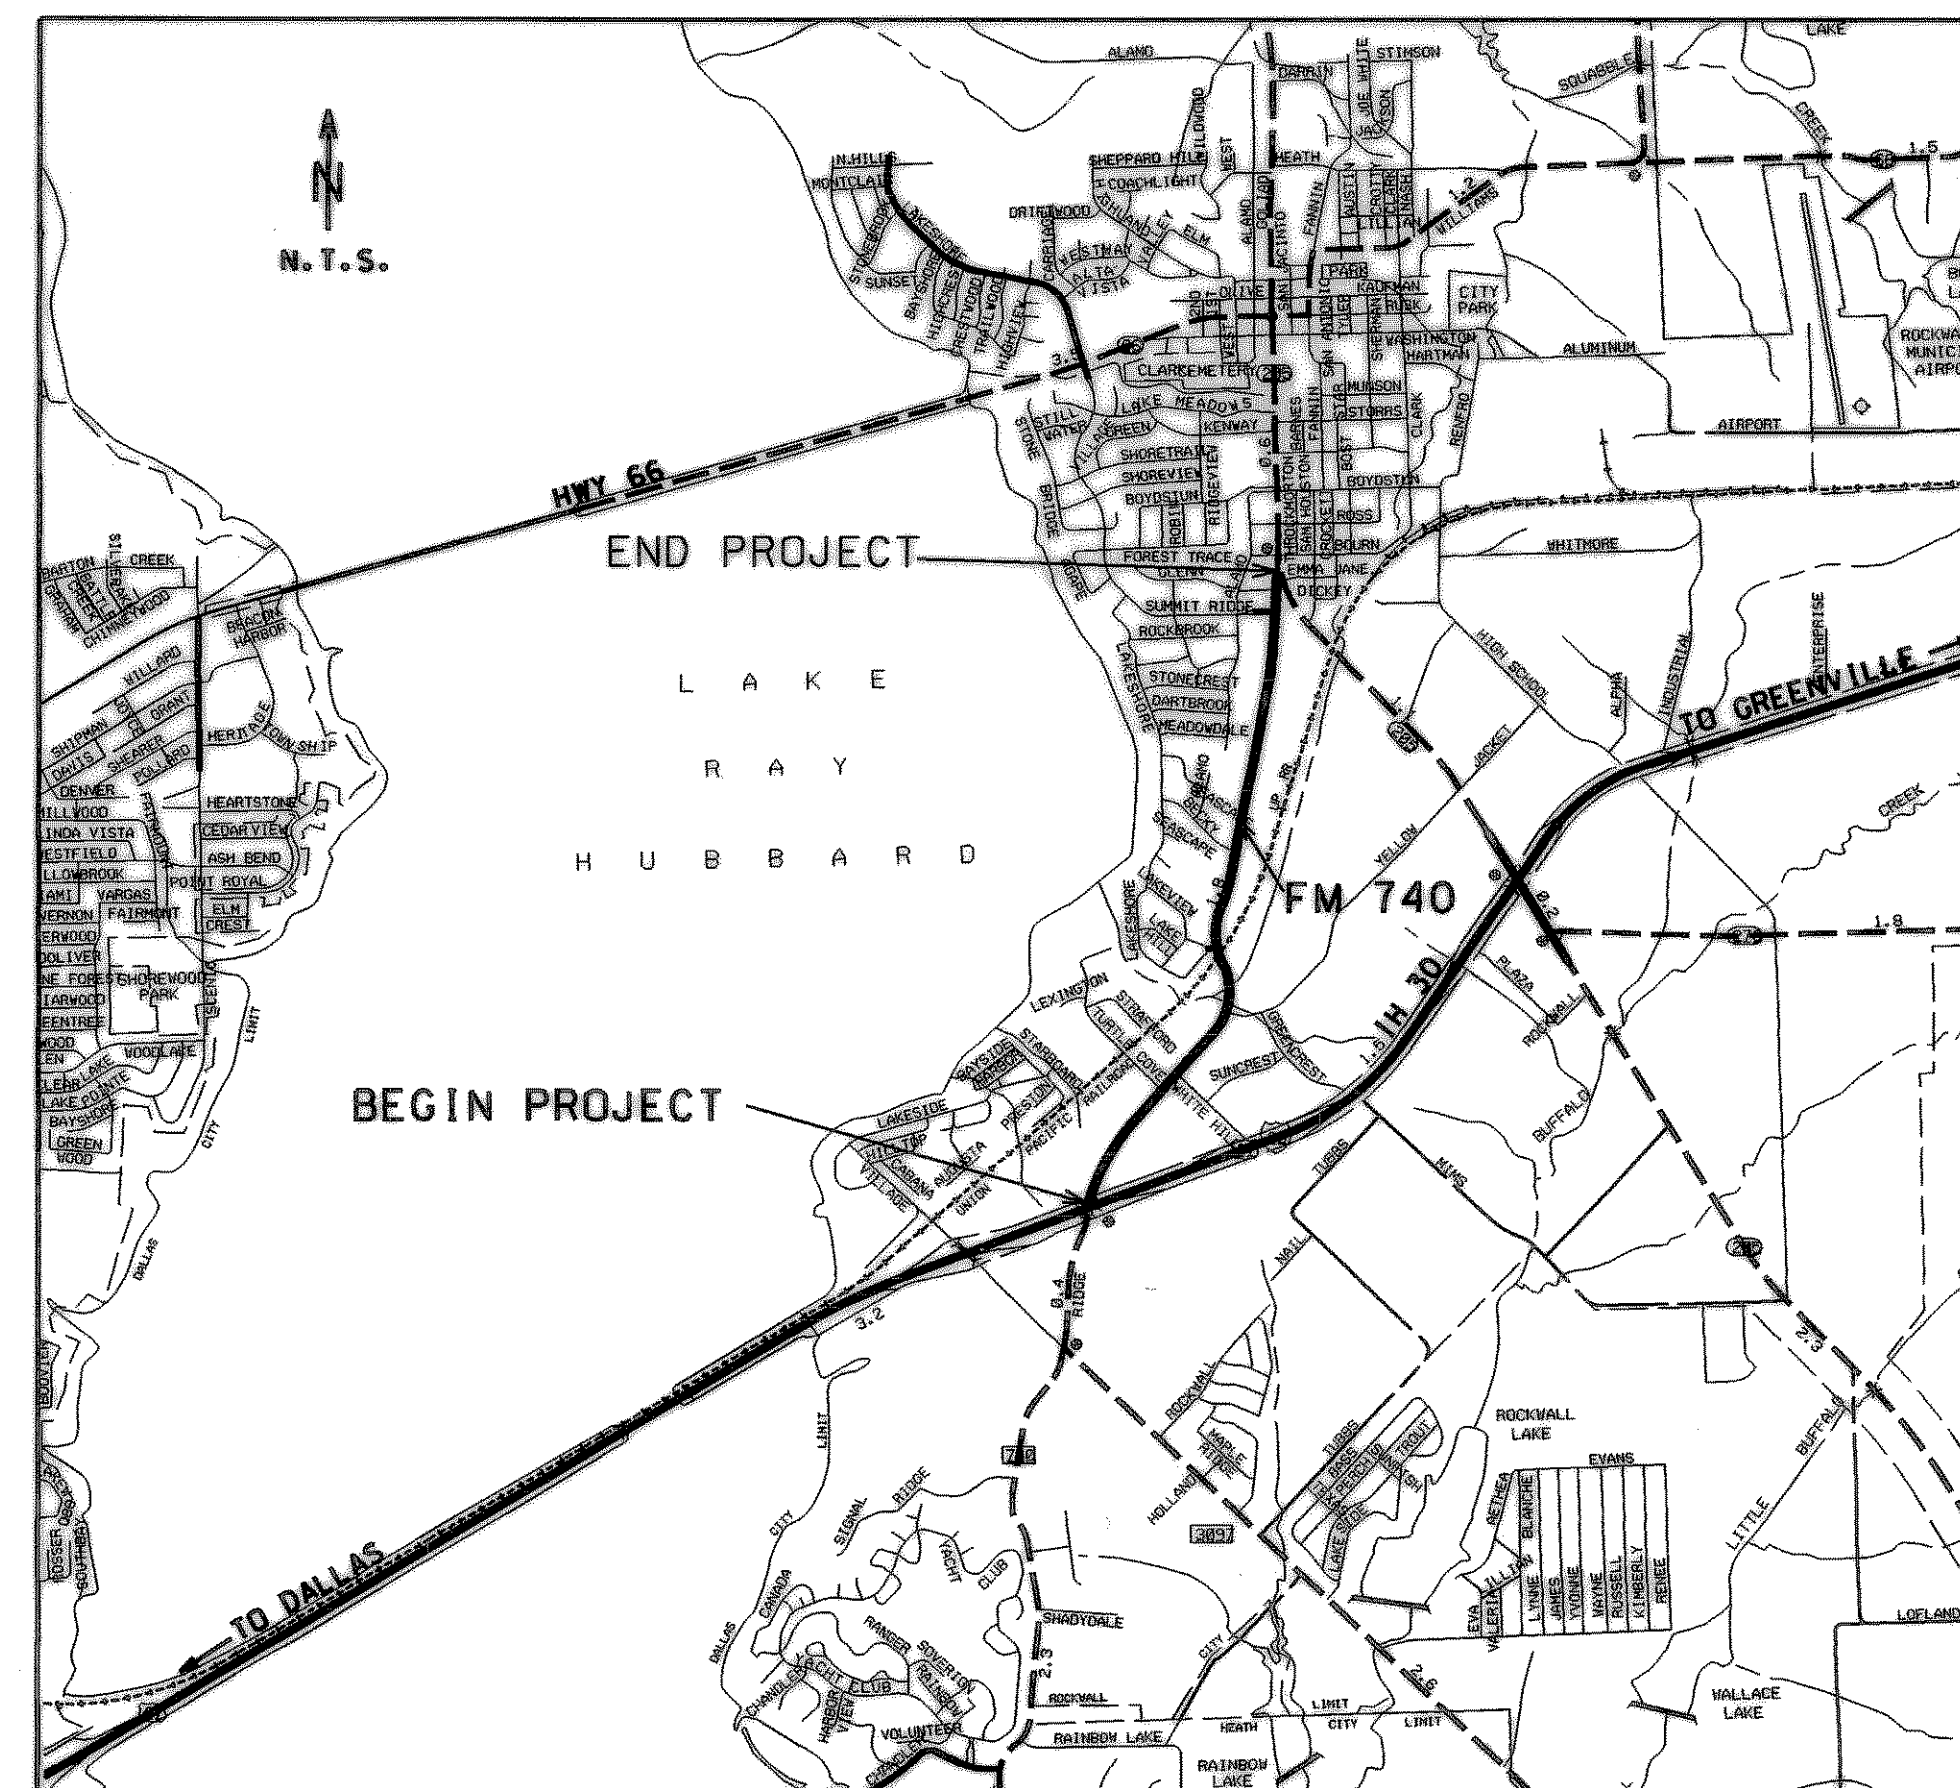

INDEX OF DRAWINGS

SHEET NO.	TITLE
1	COVER SHEET
2	GENERAL NOTES
3	PROJECT LAYOUT PLAN
4	PROJECT CONTROL PLAN
5	TRAFFIC CONTROL PLAN
6	PROPOSED 8" WATER LINE STA. 128+00 TO STA. 133+00
7	PROPOSED 8" WATER LINE STA. 133+00 TO STA. 144+00
8	PROPOSED 8" WATER LINE STA. 144+00 TO STA. 155+00
9	PROPOSED 8" WATER LINE STA. 155+00 TO STA. 166+00
10	PROPOSED 8" WATER LINE STA. 166+00 TO STA. 179+00
11	PROPOSED 8" WATER LINE STA. 179+00 TO STA. 190+00
12	PROPOSED 8" WATER LINE STA. 190+00 TO STA. 200+00
13	PROPOSED 8" WATER LINE STA. 200+00 TO STA. 210+00
14	PROPOSED 8" WATER LINE STA. 210+00 TO STA. 225+50
15	PROPOSED 16" WATER LINE STA. 144+00 TO STA. 155+00
16	PROPOSED 16" WATER LINE STA. 155+00 TO STA. 166+00
17	PROPOSED 16" WATER LINE STA. 166+00 TO STA. 179+00
18	PROPOSED 16" WATER LINE STA. 179+00 TO STA. 190+00
19	PROPOSED 16" WATER LINE STA. 190+00 TO STA. 200+00
20	PROPOSED 16" WATER LINE STA. 200+00 TO STA. 210+00
21	PROPOSED 16" WATER LINE STA. 210+00 TO STA. 222+50
22	8" SANITARY SEWER PLAN & PROFILE
23	CROSSING PROFILES
24	STORM WATER POLLUTION PREVENTION PLAN
25	EROSION CONTROL DETAILS
26	TRAFFIC CONTROL DETAILS
27	TRAFFIC CONTROL DETAILS
28	STANDARD WATER AND SEWER DETAILS
29	STANDARD WATER DETAILS
30	STANDARD WATER DETAILS
31	STANDARD PAVING DETAILS
32-41	BARRICADES AND CONSTRUCTION STANDARDS

Turner Collie & Braden Inc.
Engineers • Planners • Project Managers

PROJECT No. 15-97925-100
DALLAS, TEXAS
JANUARY 1999

RECORD DRAWING
VERIFIED BY *Vernon J. Simon*
DATE *4-20-00*

STATE OF TEXAS
ROBERT C. REACH
48587
Robert C. Reach
1-14-99

STATE OF TEXAS
VERNON J. SIMON
5886
LICENSED PROFESSIONAL ENGINEER
Vernon J. Simon
4-19-00