


RECORD DRAWING
 VERIFIED BY *Vernique Linn*
 DATE *4-20-00*

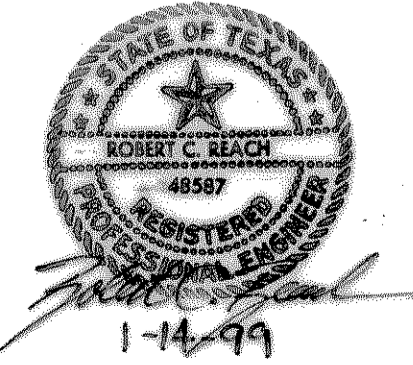

CITY OF ROCKWALL
 "THE NEW HORIZON"

UTILITY RELOCATIONS
 FOR FM 740 WIDENING

PROJECT LAYOUT PLAN

TurnerCollie & Braden Inc.
 ENGINEERS • PLANNERS • PROJECT MANAGERS

UNIT	A103	SCALE	1" = 300'	DATE	JANUARY 1999
DESIGNED	TCB	CHECKED	<i>VS.</i>	JOB NO.	15-97926-100
DRAWN	TCB	APPROVED	<i>[Signature]</i>		SHEET 3 OF 31