



10" WATER LINE  
STA. 133+90.49

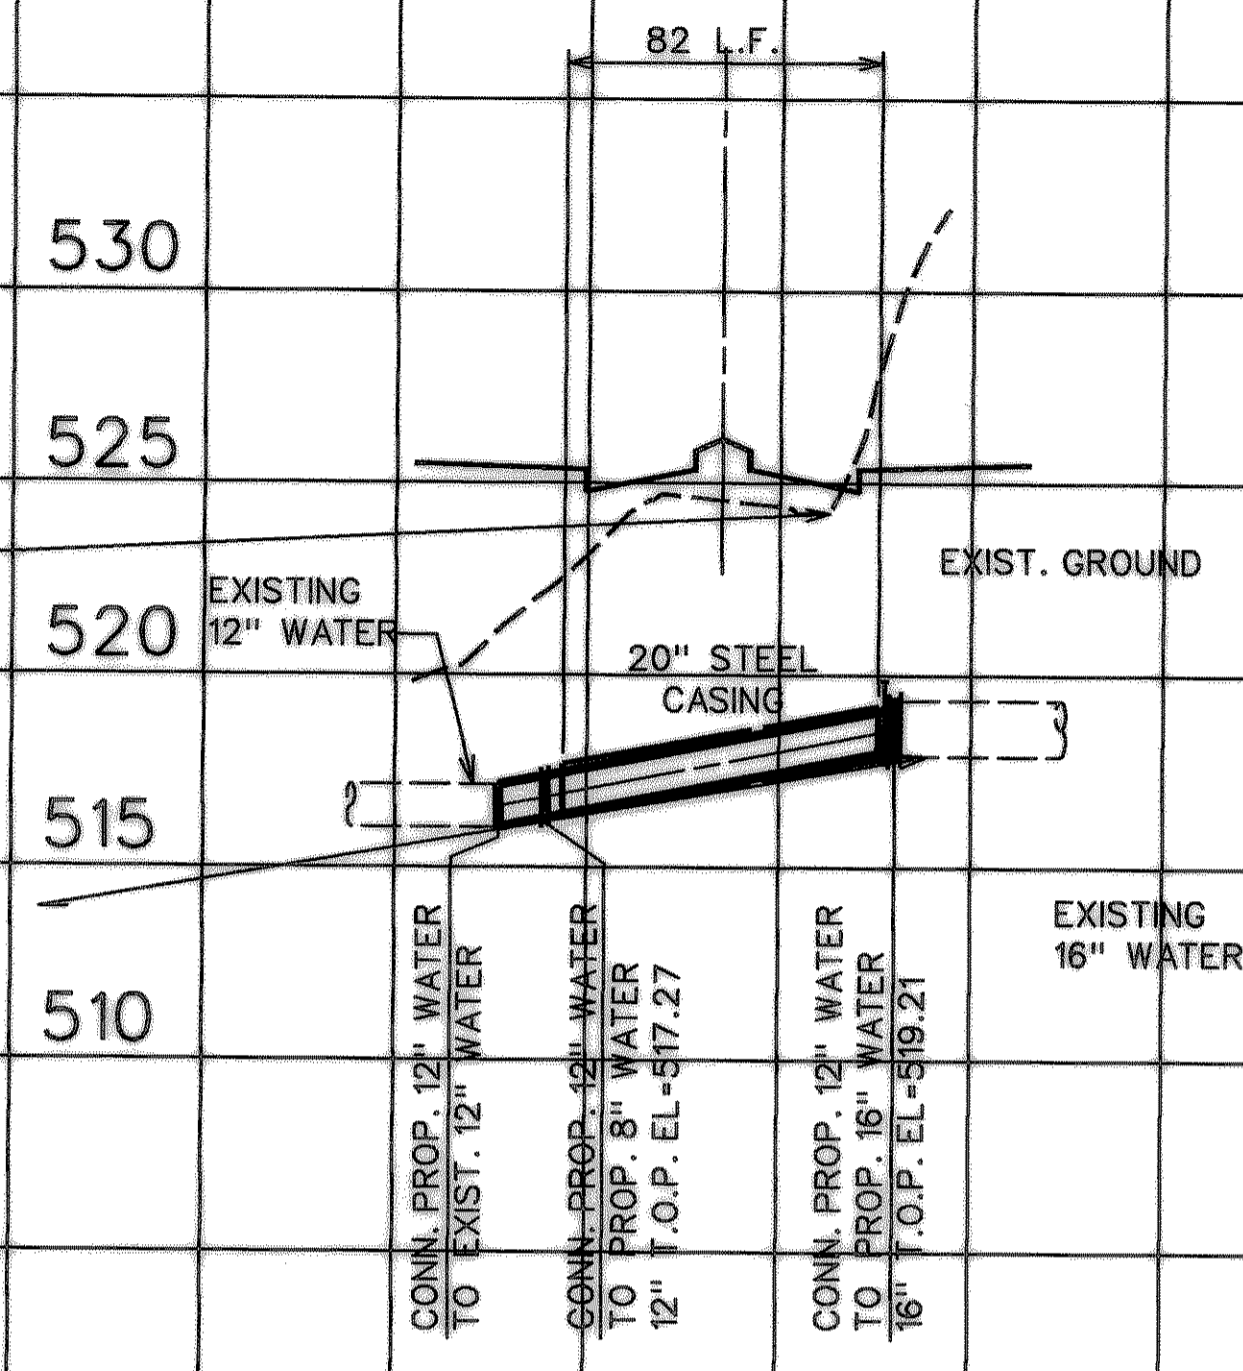

12" WATER LINE  
STA. 145+10.30

**RECORD DRAWING**  
 VERIFIED BY *Doranne Ben*  
 DATE *4-20-00*

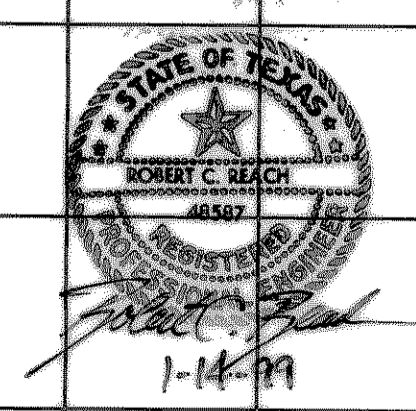

**CITY OF ROCKWALL**  
 "THE NEW HORIZON"

UTILITY RELOCATIONS  
 FOR FM 740 WIDENING

CROSSING PROFILES

**Turner Collie & Braden Inc.**  
 ENGINEERS • PLANNERS • PROJECT MANAGERS

Unit	A103	Scale	V.S.	Date	JANUARY 1999
Designed	TCB	Checked	<i>TCB</i>	Job No.	15-97925-100
Drawn	TCB	Approved	<i>TCB</i>		SHEET 23 OF 31