




TRAFFIC CONTROL DETAIL "A"
N.T.S.

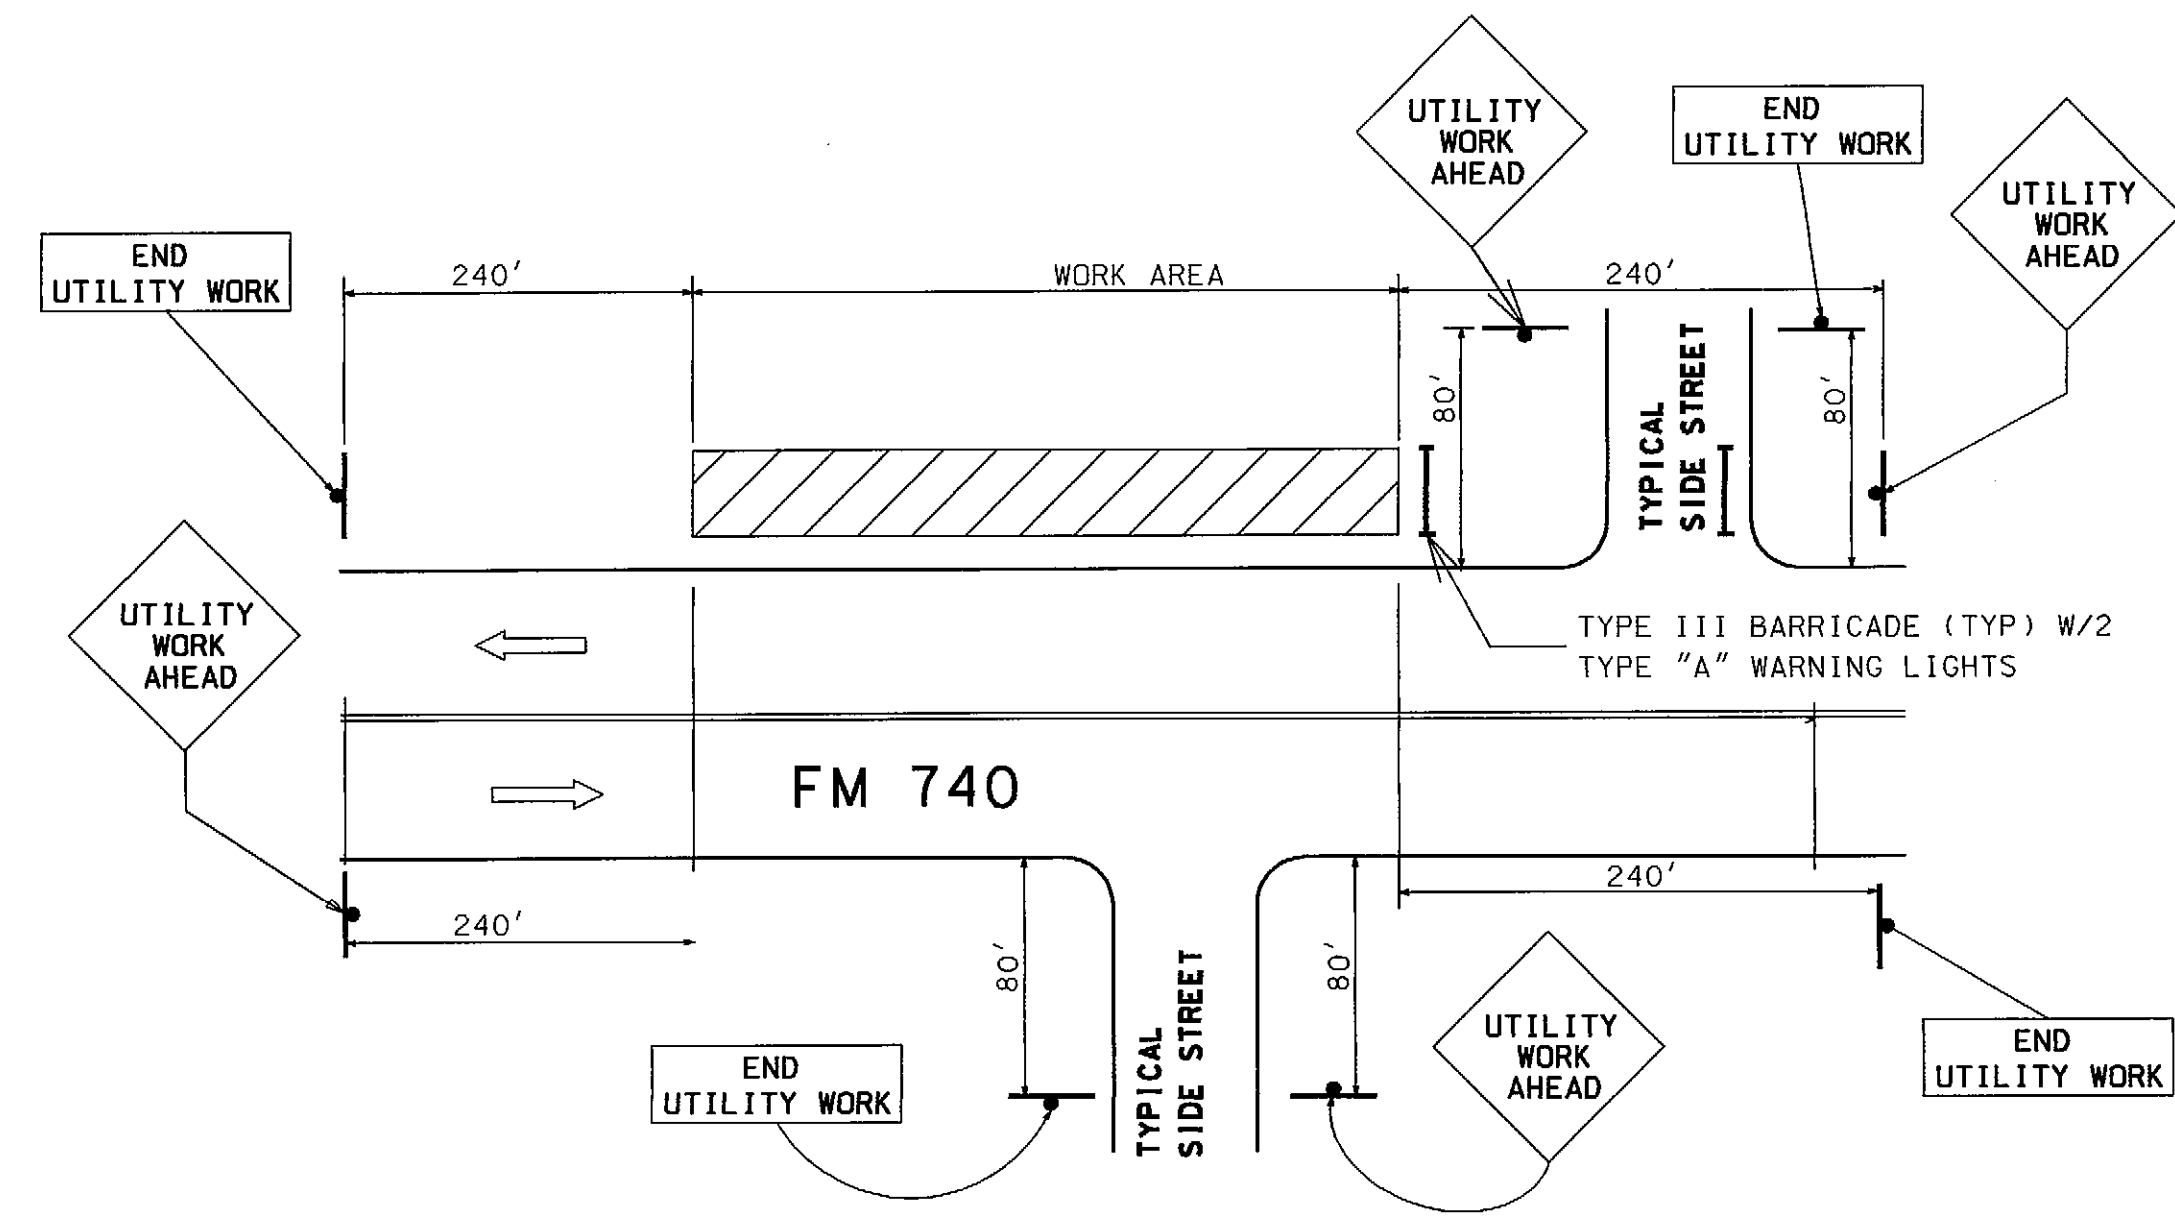

TRAFFIC CONTROL DETAIL "B"
N.T.S.

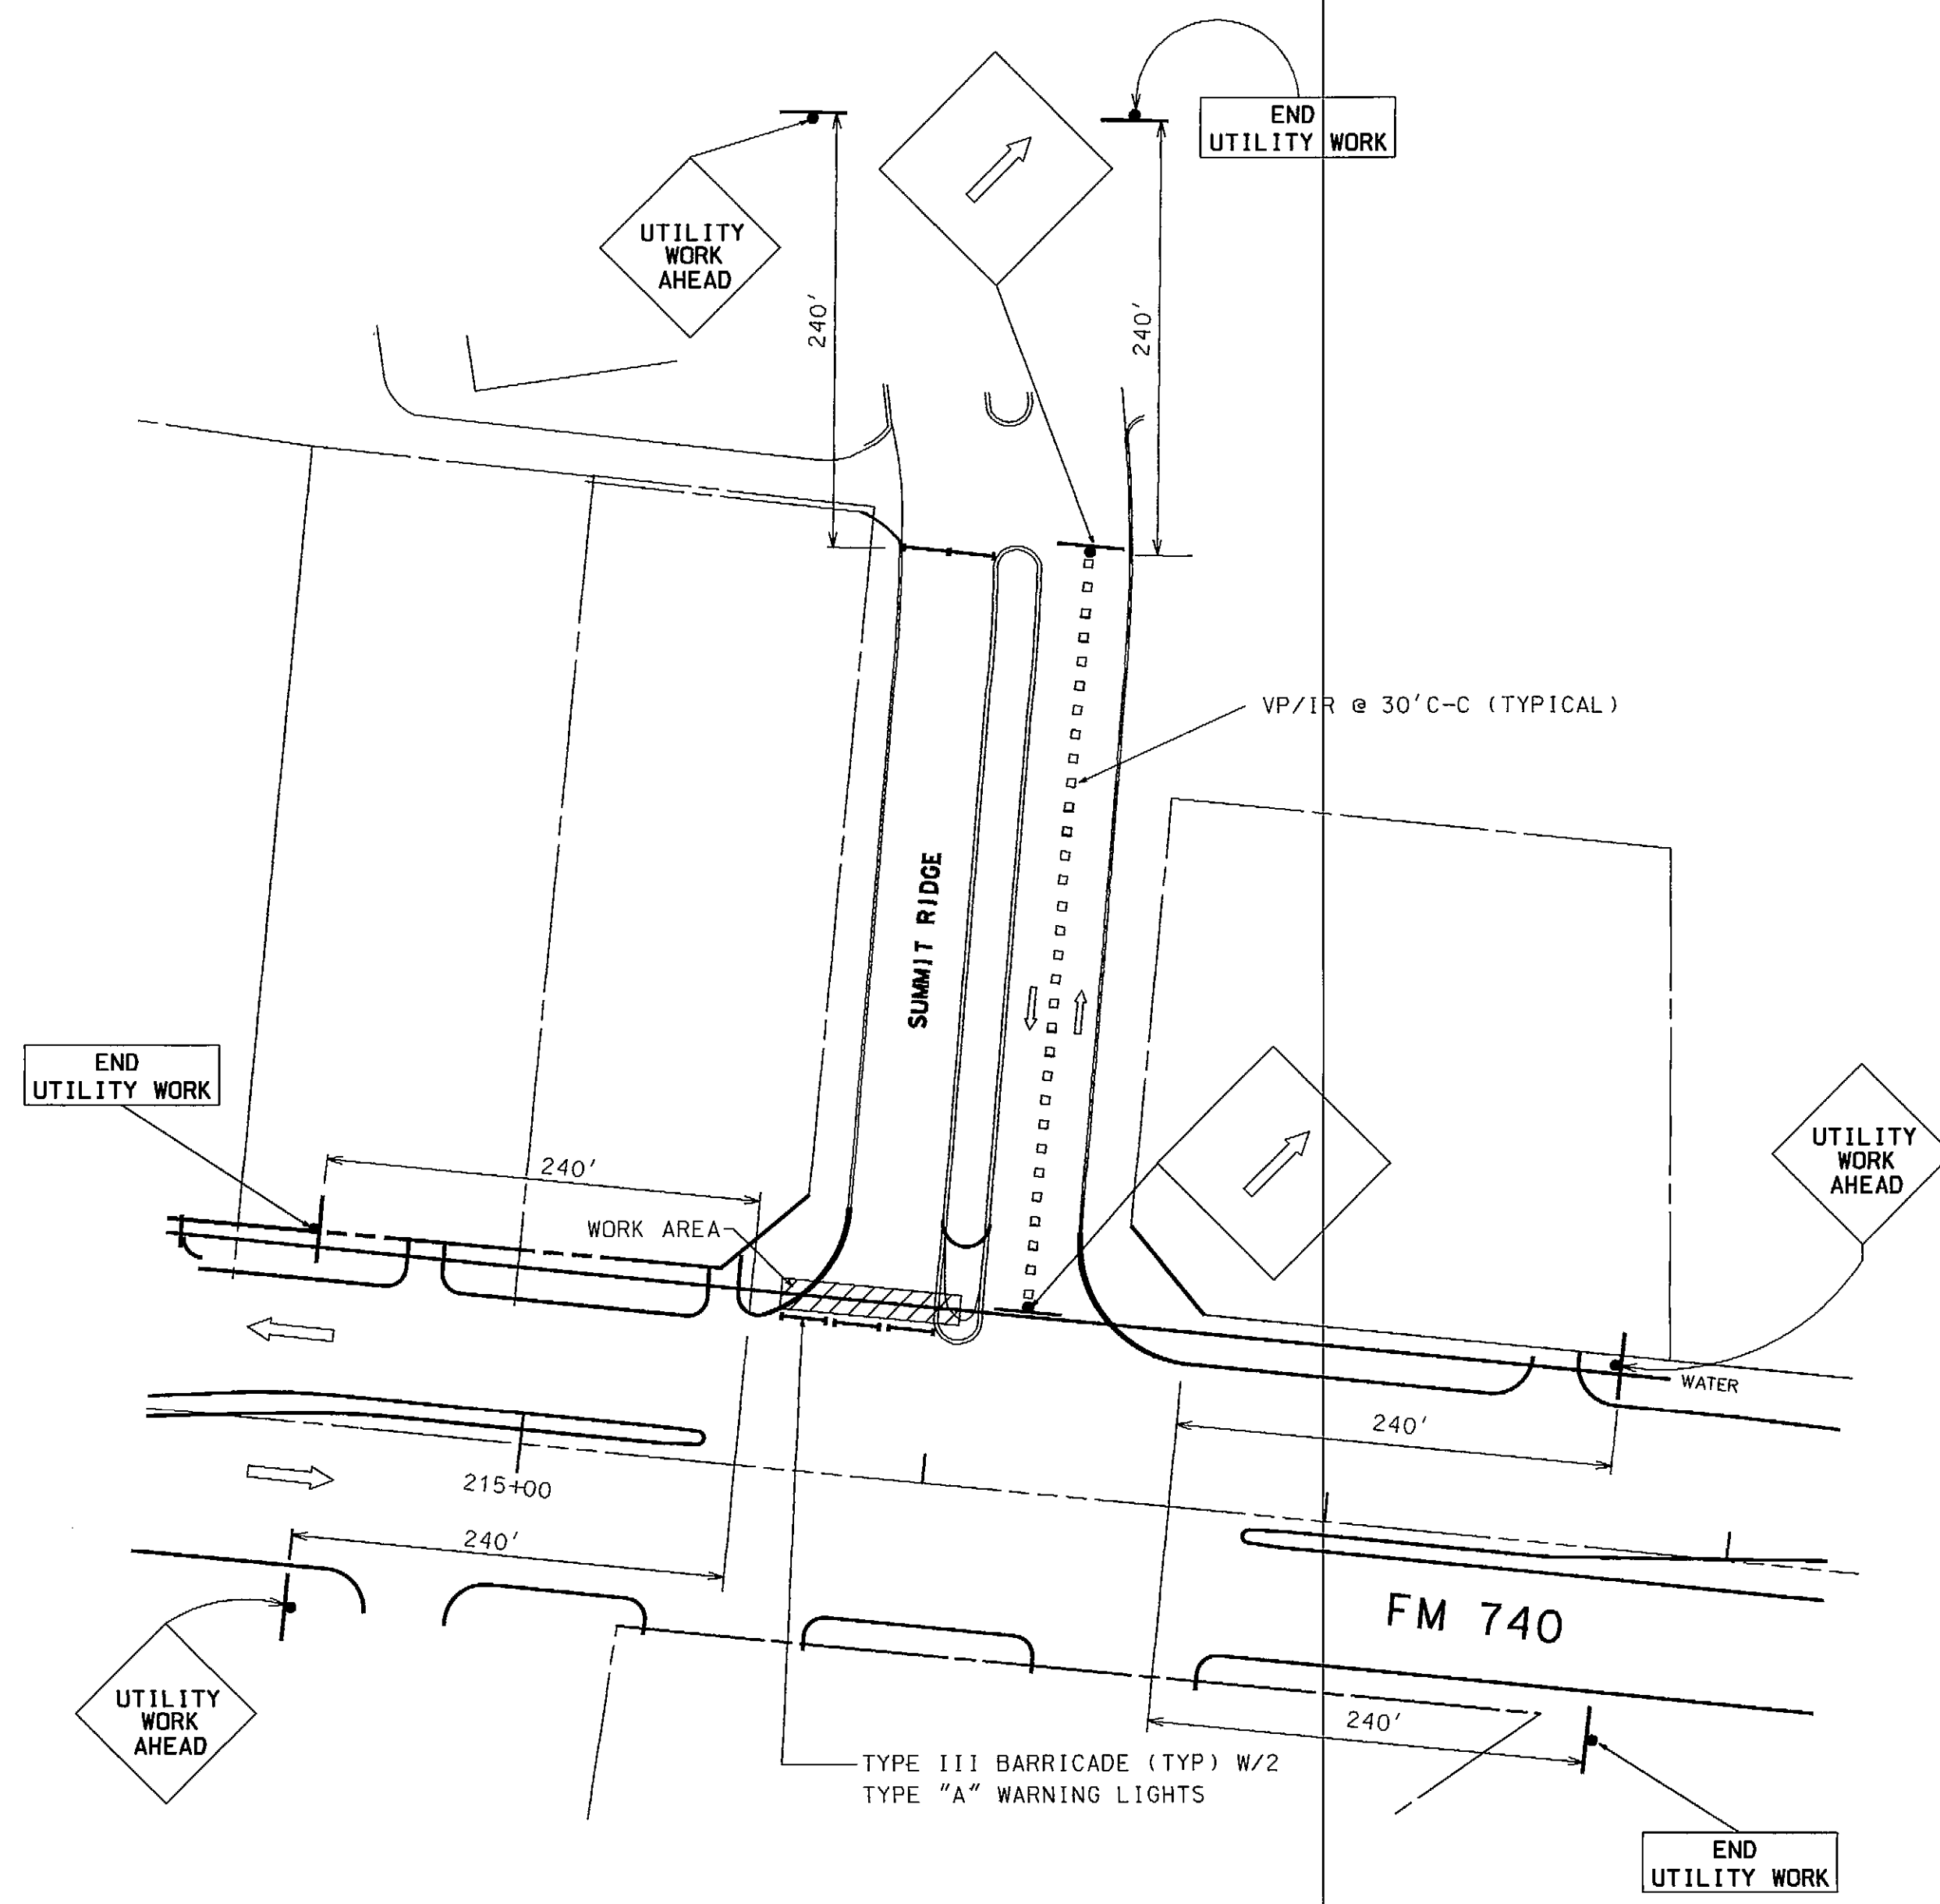


TRAFFIC CONTROL DETAIL "D"
STAGE 1
N.T.S.

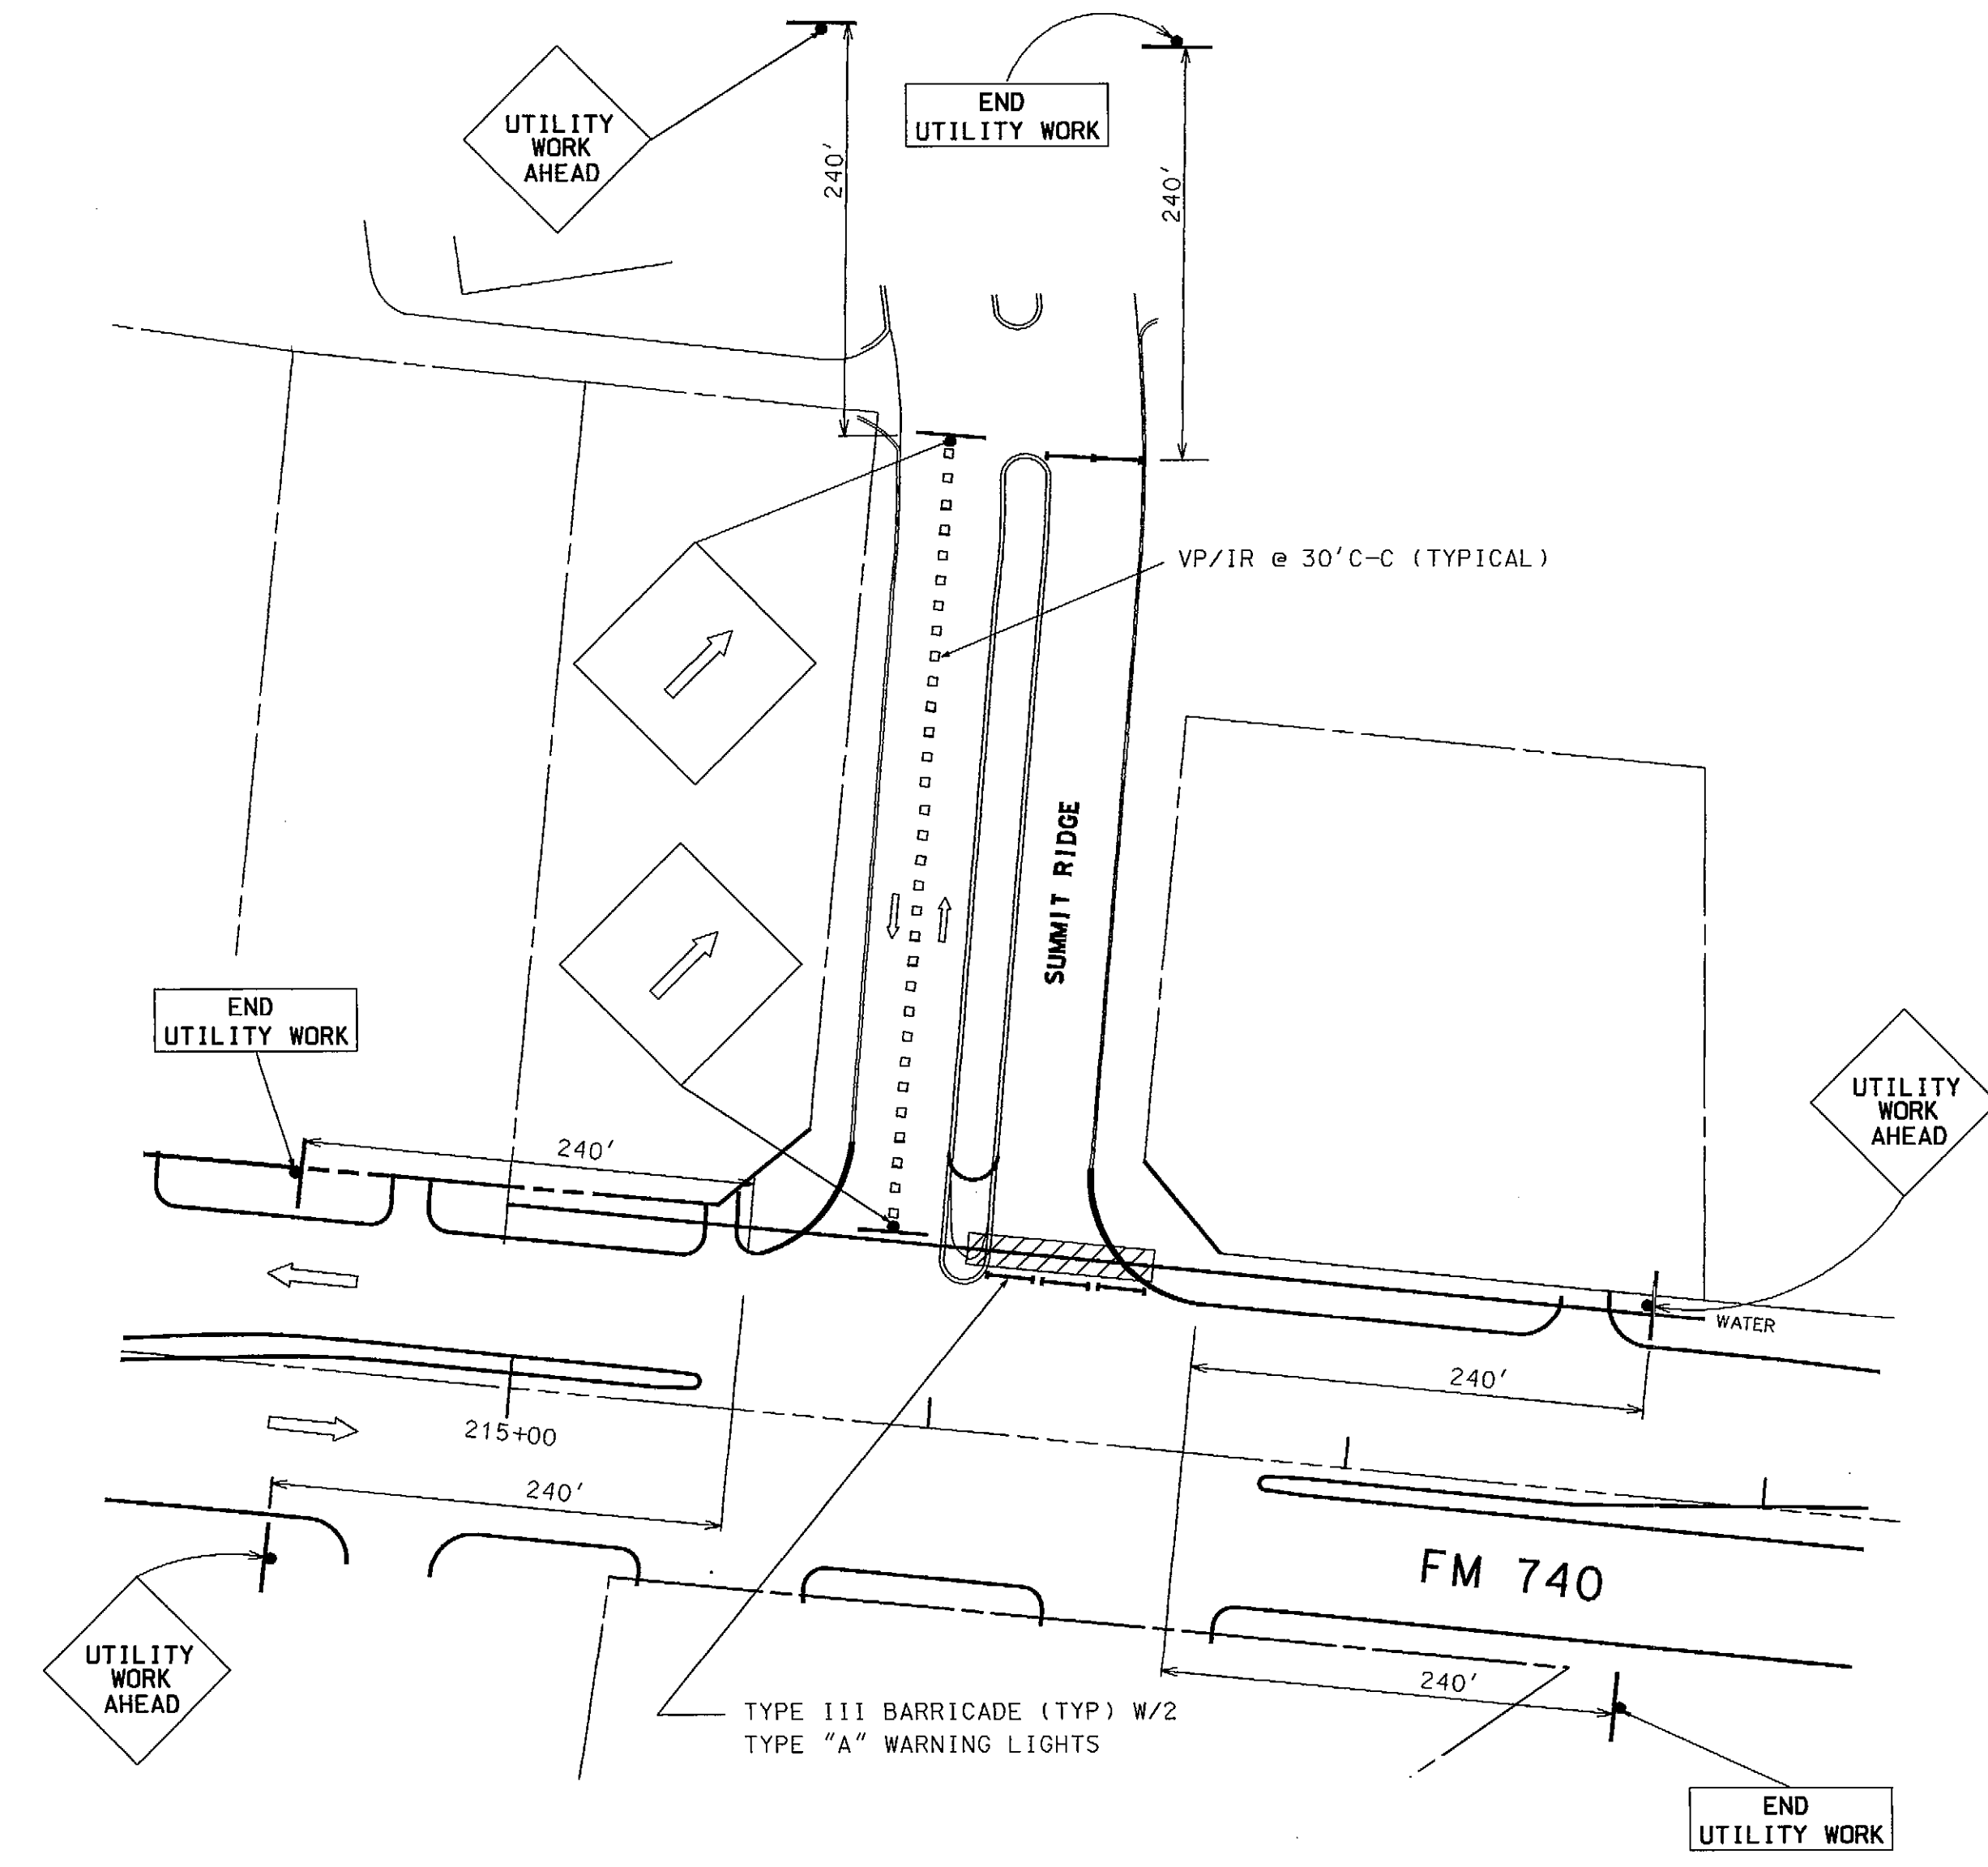

TRAFFIC CONTROL DETAIL "D"
STAGE 2
N.T.S.

RECORD DRAWING
VERIFIED BY *W. Brangan*
DATE *4-20-08*

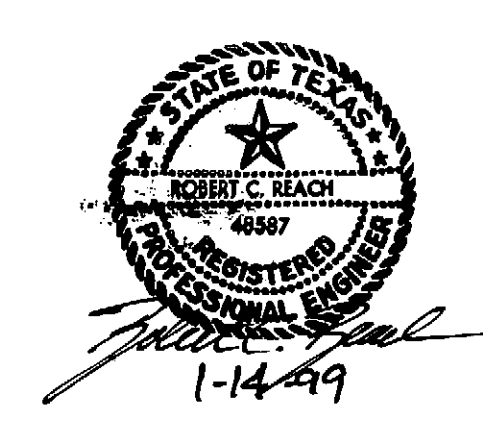

CITY OF ROCKWALL
"THE NEW HORIZON"

UTILITY RELOCATIONS
FOR FM 740 WIDENING

TRAFFIC CONTROL DETAILS
SHEET 1

Turner Collie & Braden Inc.
ENGINEERS • PLANNERS • PROJECT MANAGERS

Unit	A103	Scale: Horiz.	Date	JANUARY 1999
Designed	LJB	Checked	V.S.	Job No. 15-97925-100
Drawn	LJB	Approved	<i>WCB</i>	SHEET 26 of 31