


MATCH LINE STA 210+00

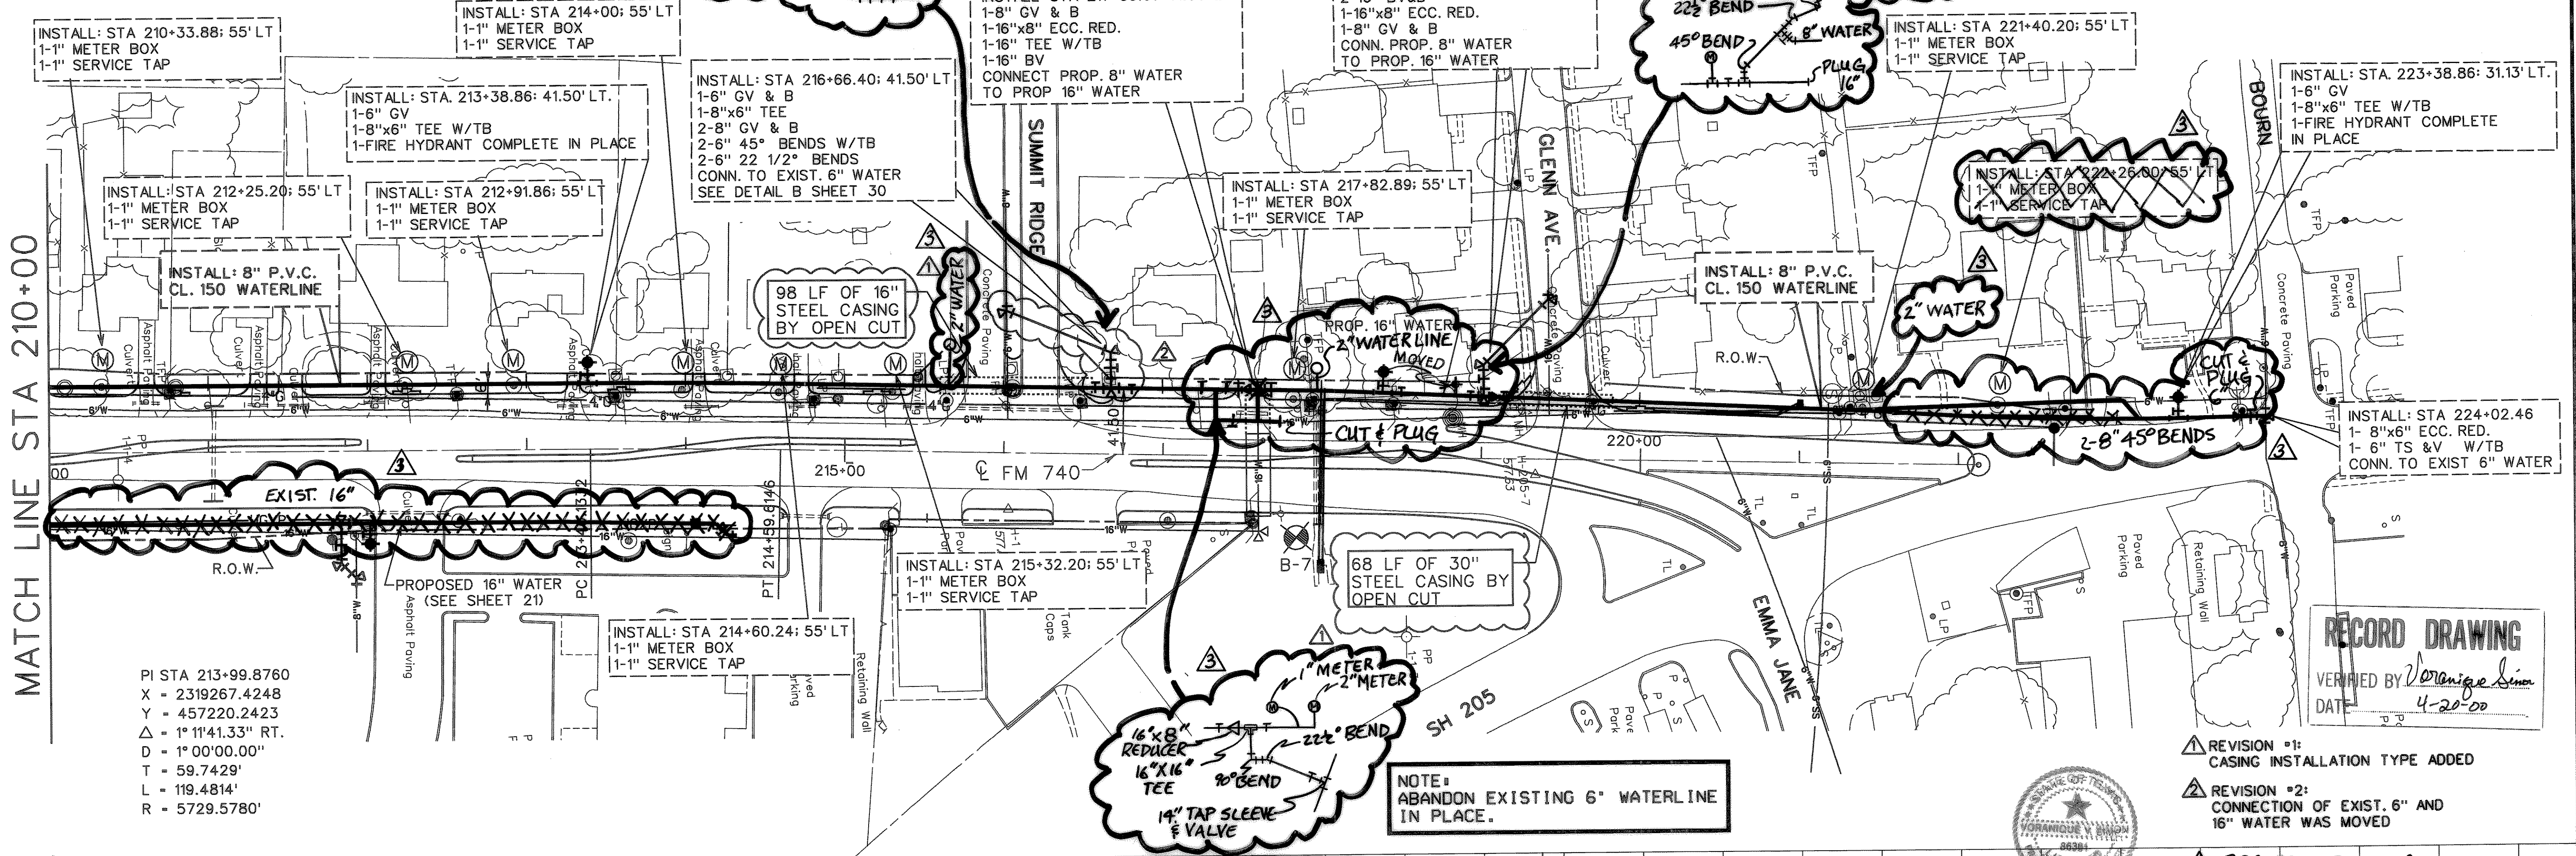


PI STA 213+99.8760
 X = 2319267.4248
 Y = 457220.2423
 Δ = 1° 11' 41.33\"/>

RECORD DRAWING
 VERIFIED BY *V. S.*
 DATE 4-20-00

- ▲ REVISION #1: CASING INSTALLATION TYPE ADDED
- ▲ REVISION #2: CONNECTION OF EXIST. 6\"/>

NOTE:
 ABANDON EXISTING 6\"/>

V. S.
 4-19-00

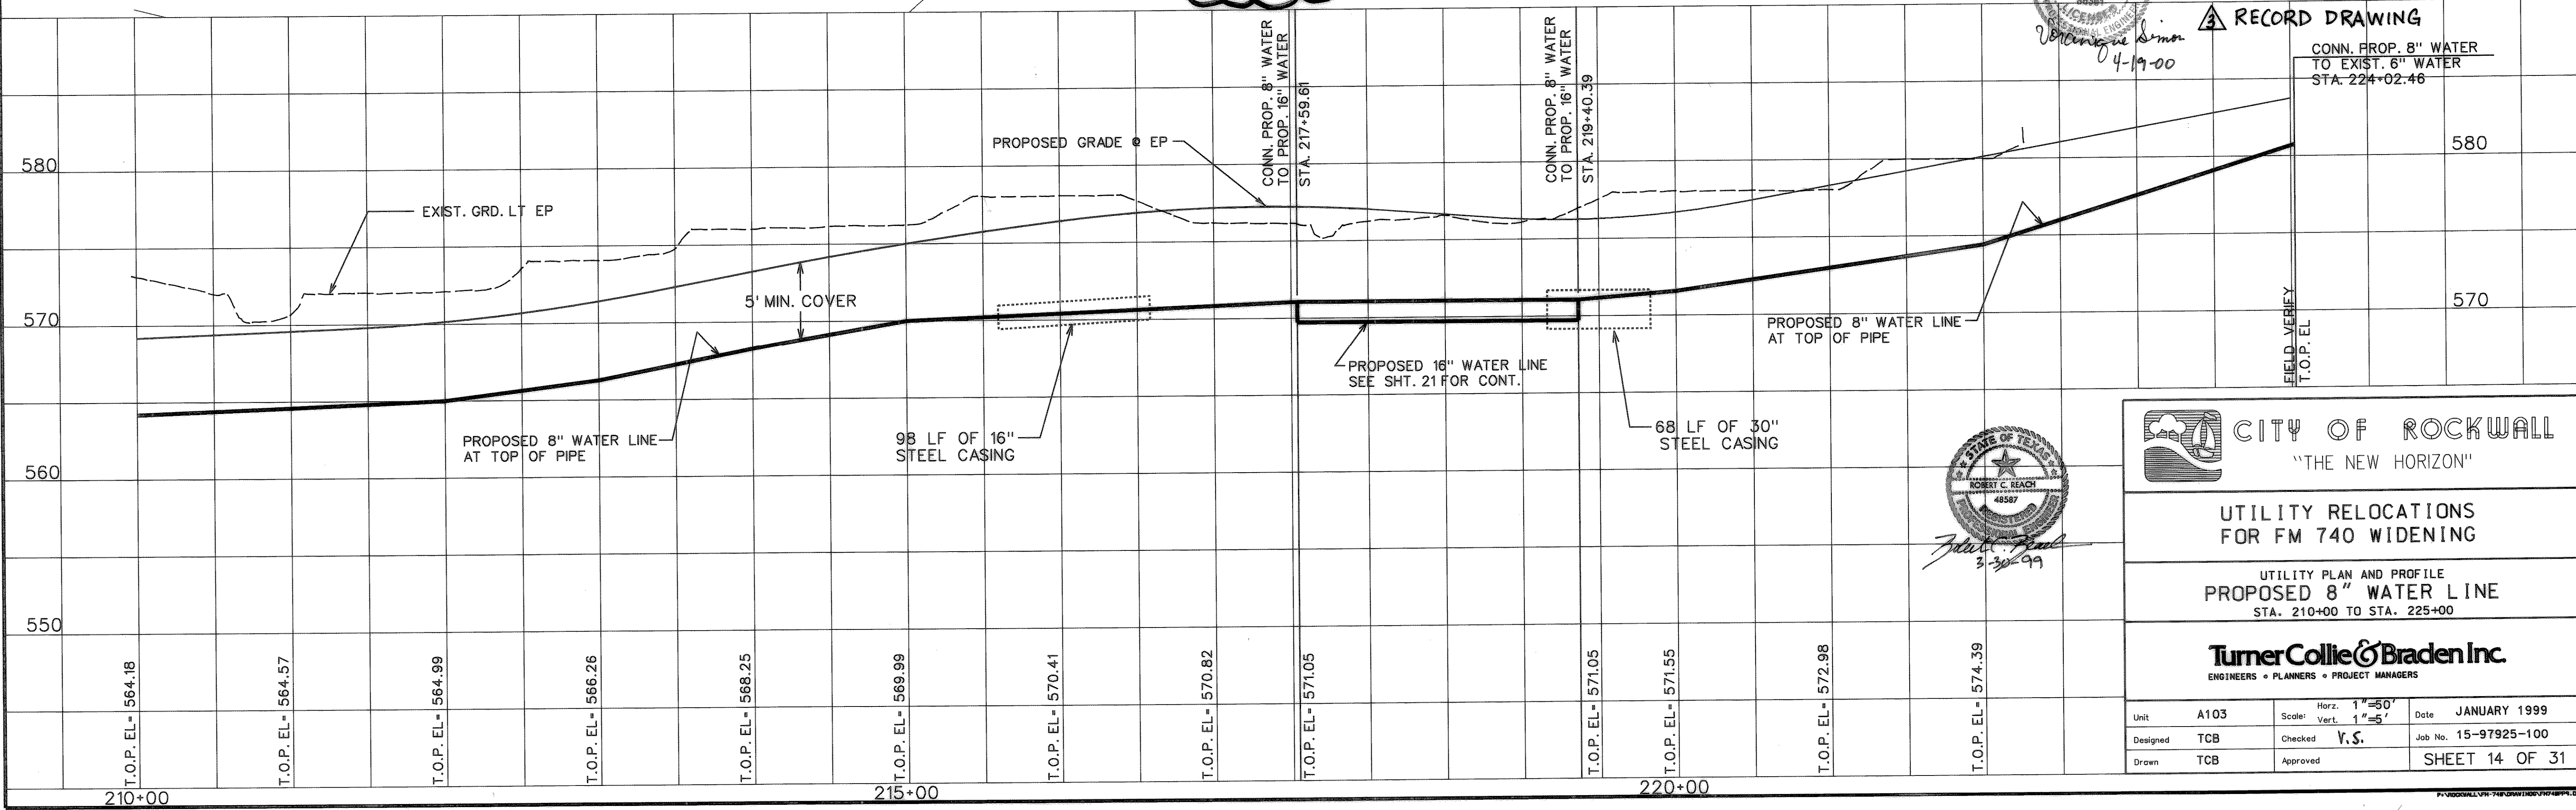

CITY OF ROCKWALL
 "THE NEW HORIZON"

**UTILITY RELOCATIONS
 FOR FM 740 WIDENING**

UTILITY PLAN AND PROFILE
PROPOSED 8\"/>

TurnerCollie & Braden Inc.
 ENGINEERS • PLANNERS • PROJECT MANAGERS

Unit	A103	Scale	Horz. 1"=50' Vert. 1"=5'	Date	JANUARY 1999
Designed	TCB	Checked	V.S.	Job No.	15-97925-100
Drawn	TCB	Approved			SHEET 14 OF 31

Robert C. Reach
 3-30-99

210+00

215+00

220+00