


**BOYDSTUN & FANNIN INTERSECTION  
PAVER DETAILS**


**WASHINGTON & FANNIN INTERSECTION  
PAVER DETAILS**

**PAVER NOTES:**

1. THE INTERLOCKING PAVING STONES SHALL BE SOLID CONCRETE, INTERLOCKING PAVERS AND SHALL BE IN CONFORMANCE WITH A.S.T.M. C936.
2. PAVERS SHALL BE BELGARD OR EQUAL. COLOR SHALL BE RED HOLLAND STONE.

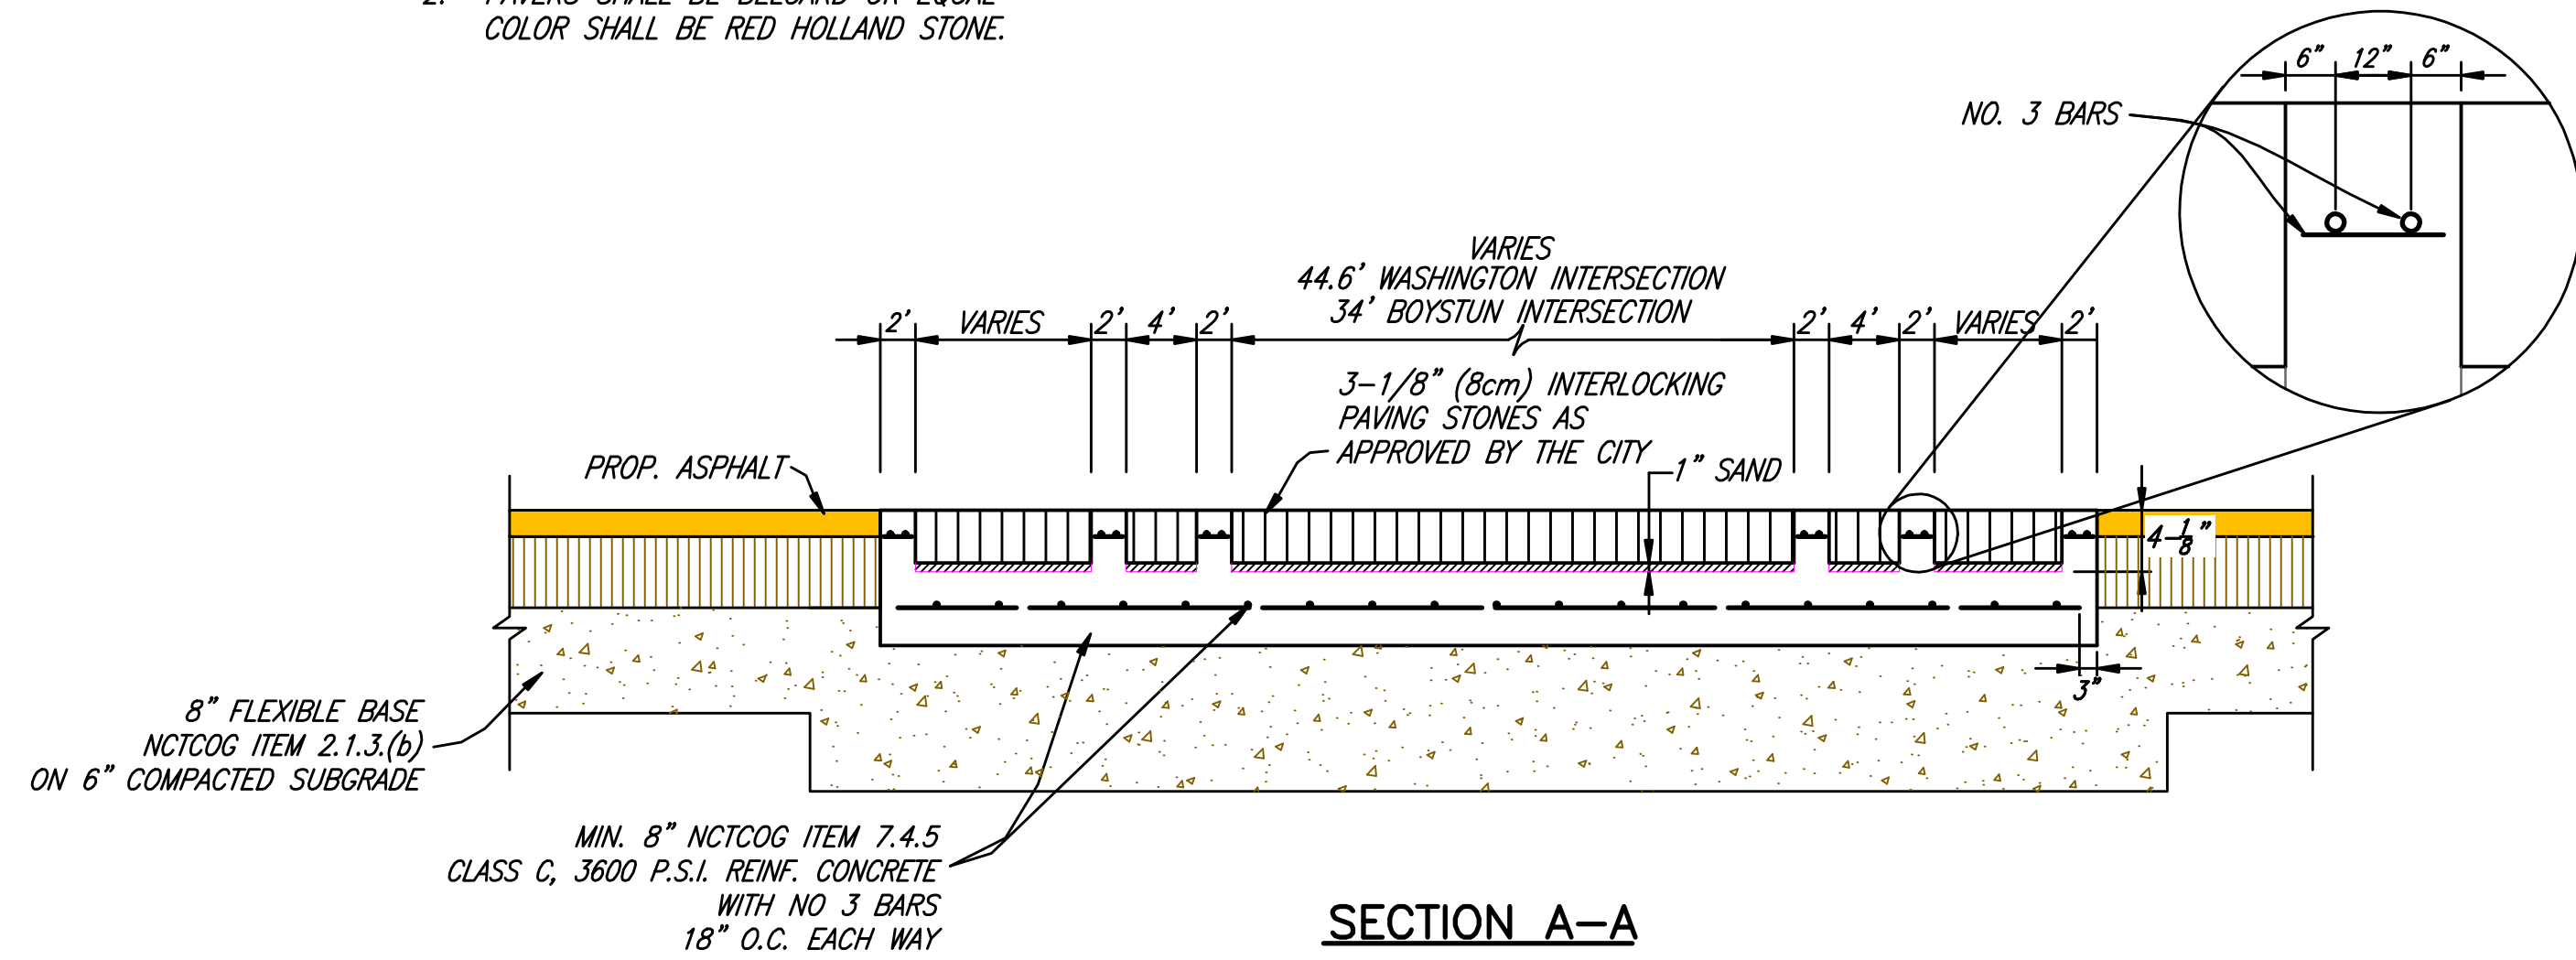

**SECTION A-A  
PAVERS INTERSECTION-SECTION "A"**  
NO SCALE

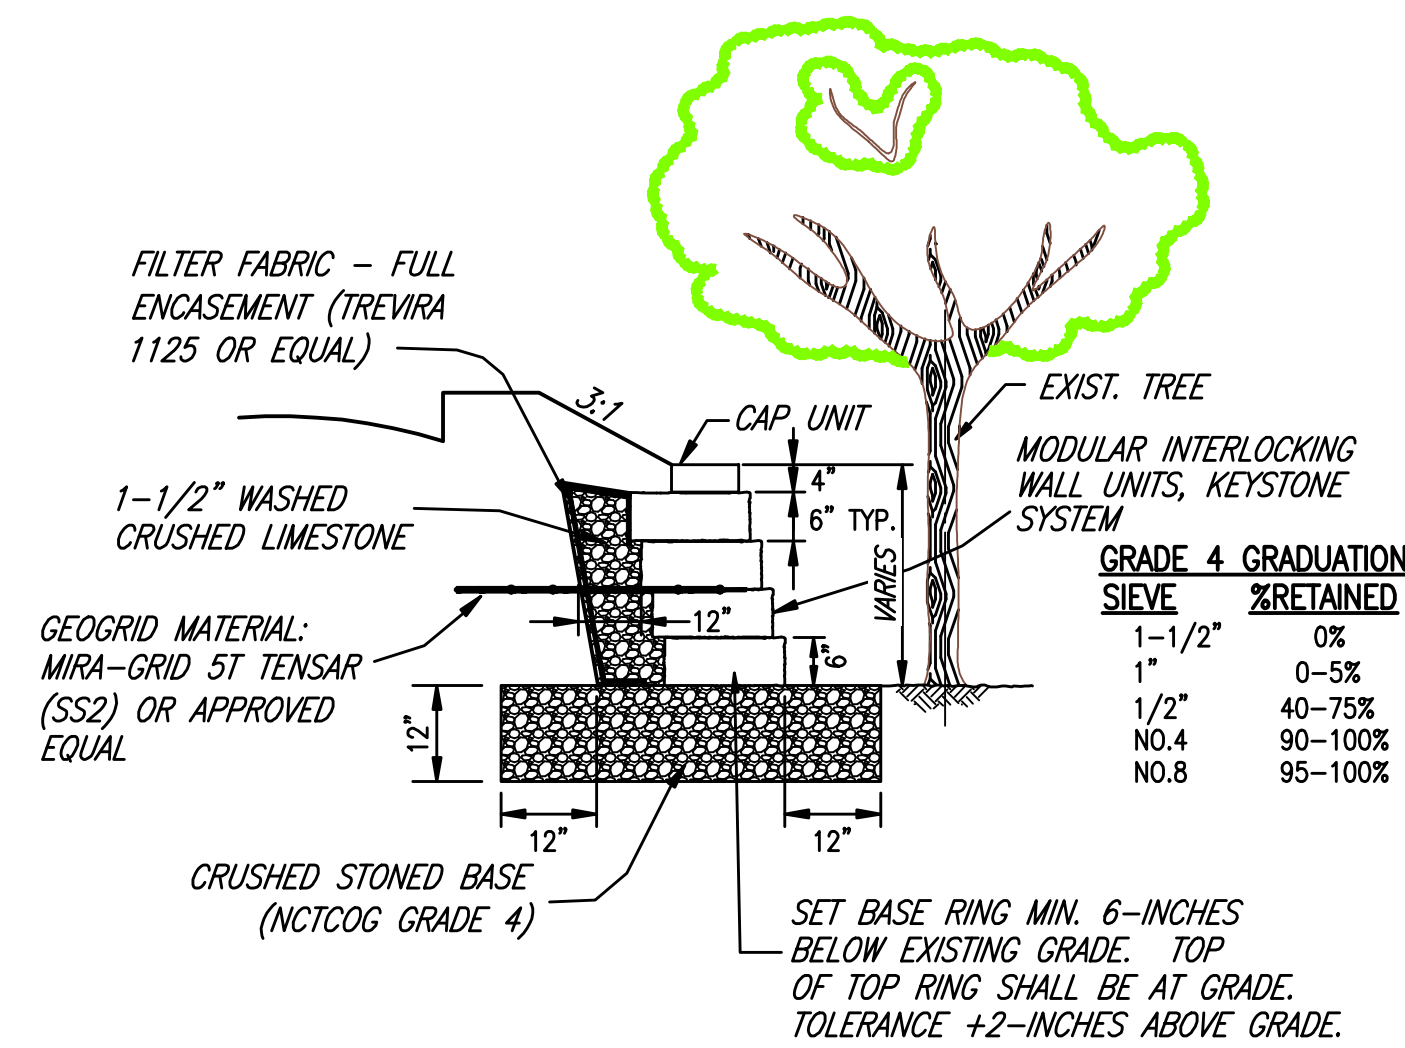

**PROPOSED MODULAR WALL**  
N.T.S.

GRADE 4 GRADUATION	
SIEVE	% RETAINED
1-1/2"	0%
1"	0-5%
1/2"	40-75%
NO.4	90-100%
NO.8	95-100%


These plans and related specifications were prepared for construction of this specific project only. Reuse of these documents is not permitted without written authorization of Birkhoff, Hendricks, & Conway, L.L.P.

This record drawing is a compilation of the sealed engineering drawing for this project, modified by addenda, change orders and information furnished by the contractor. The information shown on the record drawings that was provided by the contractor or others not associated with the design engineer cannot be verified for accuracy or completeness. This original sealed drawings are on file at the offices of Birkhoff, Hendricks & Conway, L.L.P.

BY MH DATE 4/25/09

THESE DOCUMENTS ARE FOR BIDDING, CONSTRUCTION, AND PERMIT PURPOSES.

DATE: 01/19/06

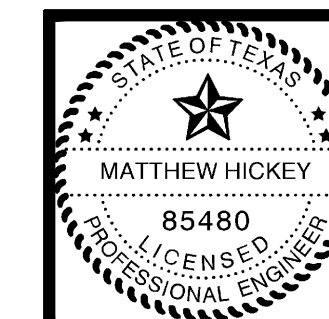

<b>CITY OF ROCKWALL, TEXAS</b>	
<b>FANNIN STREET IMPROVEMENTS PAVER DETAILS</b>	
<b>BIRKHOFF, HENDRICKS &amp; CONWAY, L.L.P.</b> CONSULTING ENGINEERS Dallas, Texas	
DESIGNED BY: <u>M.H.</u>	PROJECT: <u>2005-111</u>
DRAWN BY: <u>M.V.O.</u>	DATE: <u>MAY, 2006</u>
SHEET NO. <b>109</b>	