


# CITY OF ROCKWALL, TEXAS

## CONSTRUCTION PLANS FOR

# FANNIN STREET PAVING, DRAINAGE, AND UTILITY IMPROVEMENTS BOYDSTUN AVENUE TO WASHINGTON STREET

# RE-BID

CONTRACTOR: NORTH TEXAS CONTRACTING, INC.  
 PHONE: 817-430-9500  
 ORIGINAL CONTRACT AMOUNT: \$12,997,935.00  
 FINAL CONTRACT AMOUNT: \$13,036,863.55  
 COMPLETED: APRIL 2009

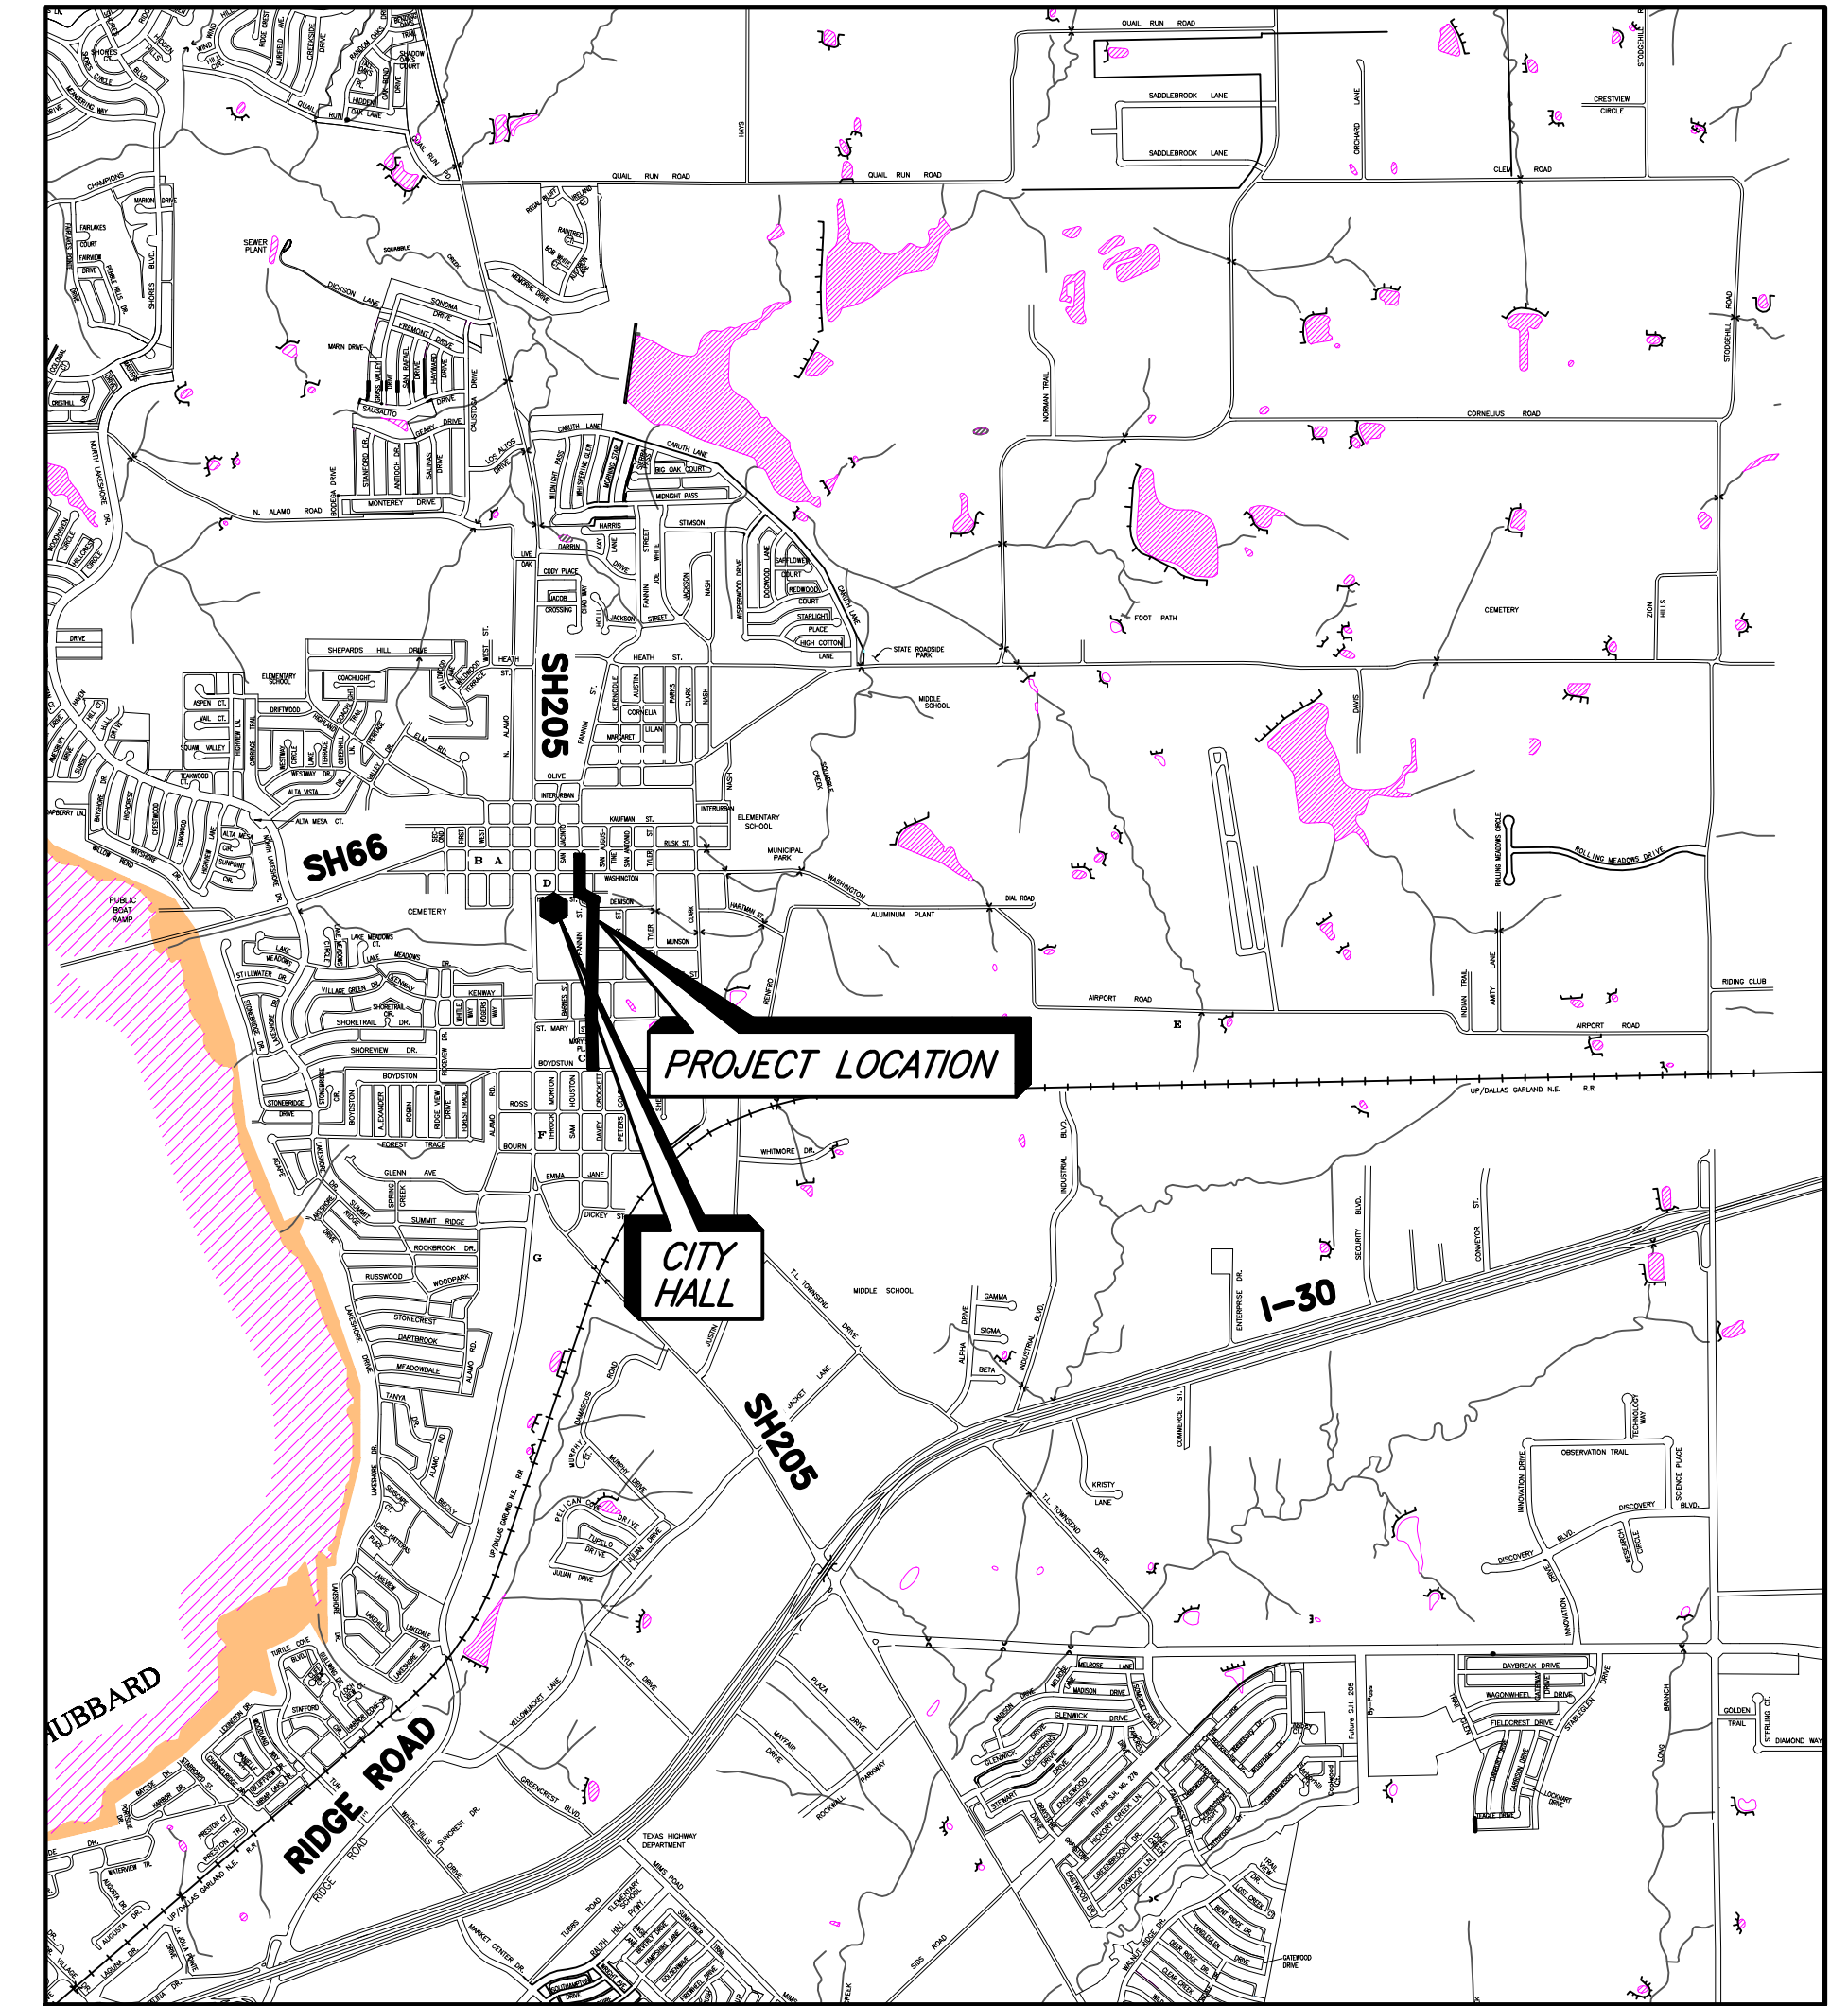


**LOCATION MAP**

**SHEET INDEX**

| SHEET NO. | SHEET DESCRIPTION                                 |
|-----------|---|
| 1         | COVER SHEET                                       |
| 2         | GENERAL NOTES                                     |
| 3         | TYPICAL PAVING SECTIONS                           |
| 04-10     | COORDINATE/DIMENSION PLAN                         |
| 11-22     | PAVING PLAN/PROFILE                               |
| 23-26     | RETAINING WALL PLAN/PROFILE                       |
| 27-32     | WATER LINE PLAN                                   |
| 33-41     | SANITARY SEWER PLAN/PROFILE                       |
| 42-47     | DRAINAGE AREA MAP & CALCULATIONS                  |
| 48-55     | STORM SEWER PLAN PROFILES                         |
| 56-58     | STORM SEWER LATERAL PROFILES                      |
| 59-59A    | PAVEMENTS MARKINGS                                |
| 60-62     | STREET LIGHT & SIGNAL LIGHT CONDUIT PLAN          |
| 63-64     | PAVEMENT REMOVAL                                  |
| 65-72     | STORM WATER POLLUTION PREVENTION PLAN AND DETAILS |
| 73-74     | SUGGESTED CONSTRUCTION PHASING & DETOUR PLAN      |
| 75-96     | FANNIN STREET CROSS-SECTIONS                      |
| 97        | GRADING PLAN                                      |
| 98-103    | FANNIN STREET DRIVEWAY PROFILES                   |
| 104-110   | INTERSECTION & MISCELLANEOUS DETAILS              |
| -         | TxDOT STANDARD DETAILS                            |

*This record drawing is a compilation of the sealed engineering drawing for this project, modified by addenda, change orders and information furnished by the contractor. The information shown on the record drawings that was provided by the contractor or others not associated with the design engineer cannot be verified for accuracy or completeness. This original sealed drawings are on file at the offices of Birkhoff, Hendricks & Conway, L.L.P.*  
 BY MH DATE 4/25/09

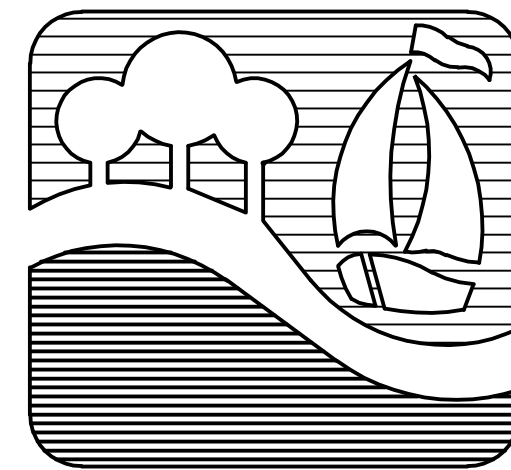

**BIRKHOFF, HENDRICKS & CONWAY, L.L.P.**  
 CONSULTING ENGINEERS  
 Dallas, Texas



THESE DOCUMENTS ARE FOR  
 BIDDING, CONSTRUCTION,  
 AND PERMIT PURPOSES.  
 DATE: 4/19/09

FEBRUARY, 2007

**COUNCIL MEMBERS**

- BILL CECIL, MAYOR
- BOB COTTI, MAYOR PRO-TEM
- STEPHEN STRAUGHAN
- TIM McCALLUM
- JOHN KING
- MATT SCOTT
- MARGO NIELSEN

**CITY MANAGER**

JULIE COUCH

**ASSISTANT CITY MANAGER**

RICHARD CROWLEY

**CITY ENGINEER**

CHUCK TODD, P.E.