



REVISED: 4/24/09 - GDAVIS  
 PLOT SCALE: 1:20  
 PLOT STYLE: 22X34.ctb  
 PLOTTED BY: GDAVIS ON 4/30/2009  
 C:\Acad\_Jobs\Rockwall\2005111\Sheets\2005111-015\_PFS.dwg

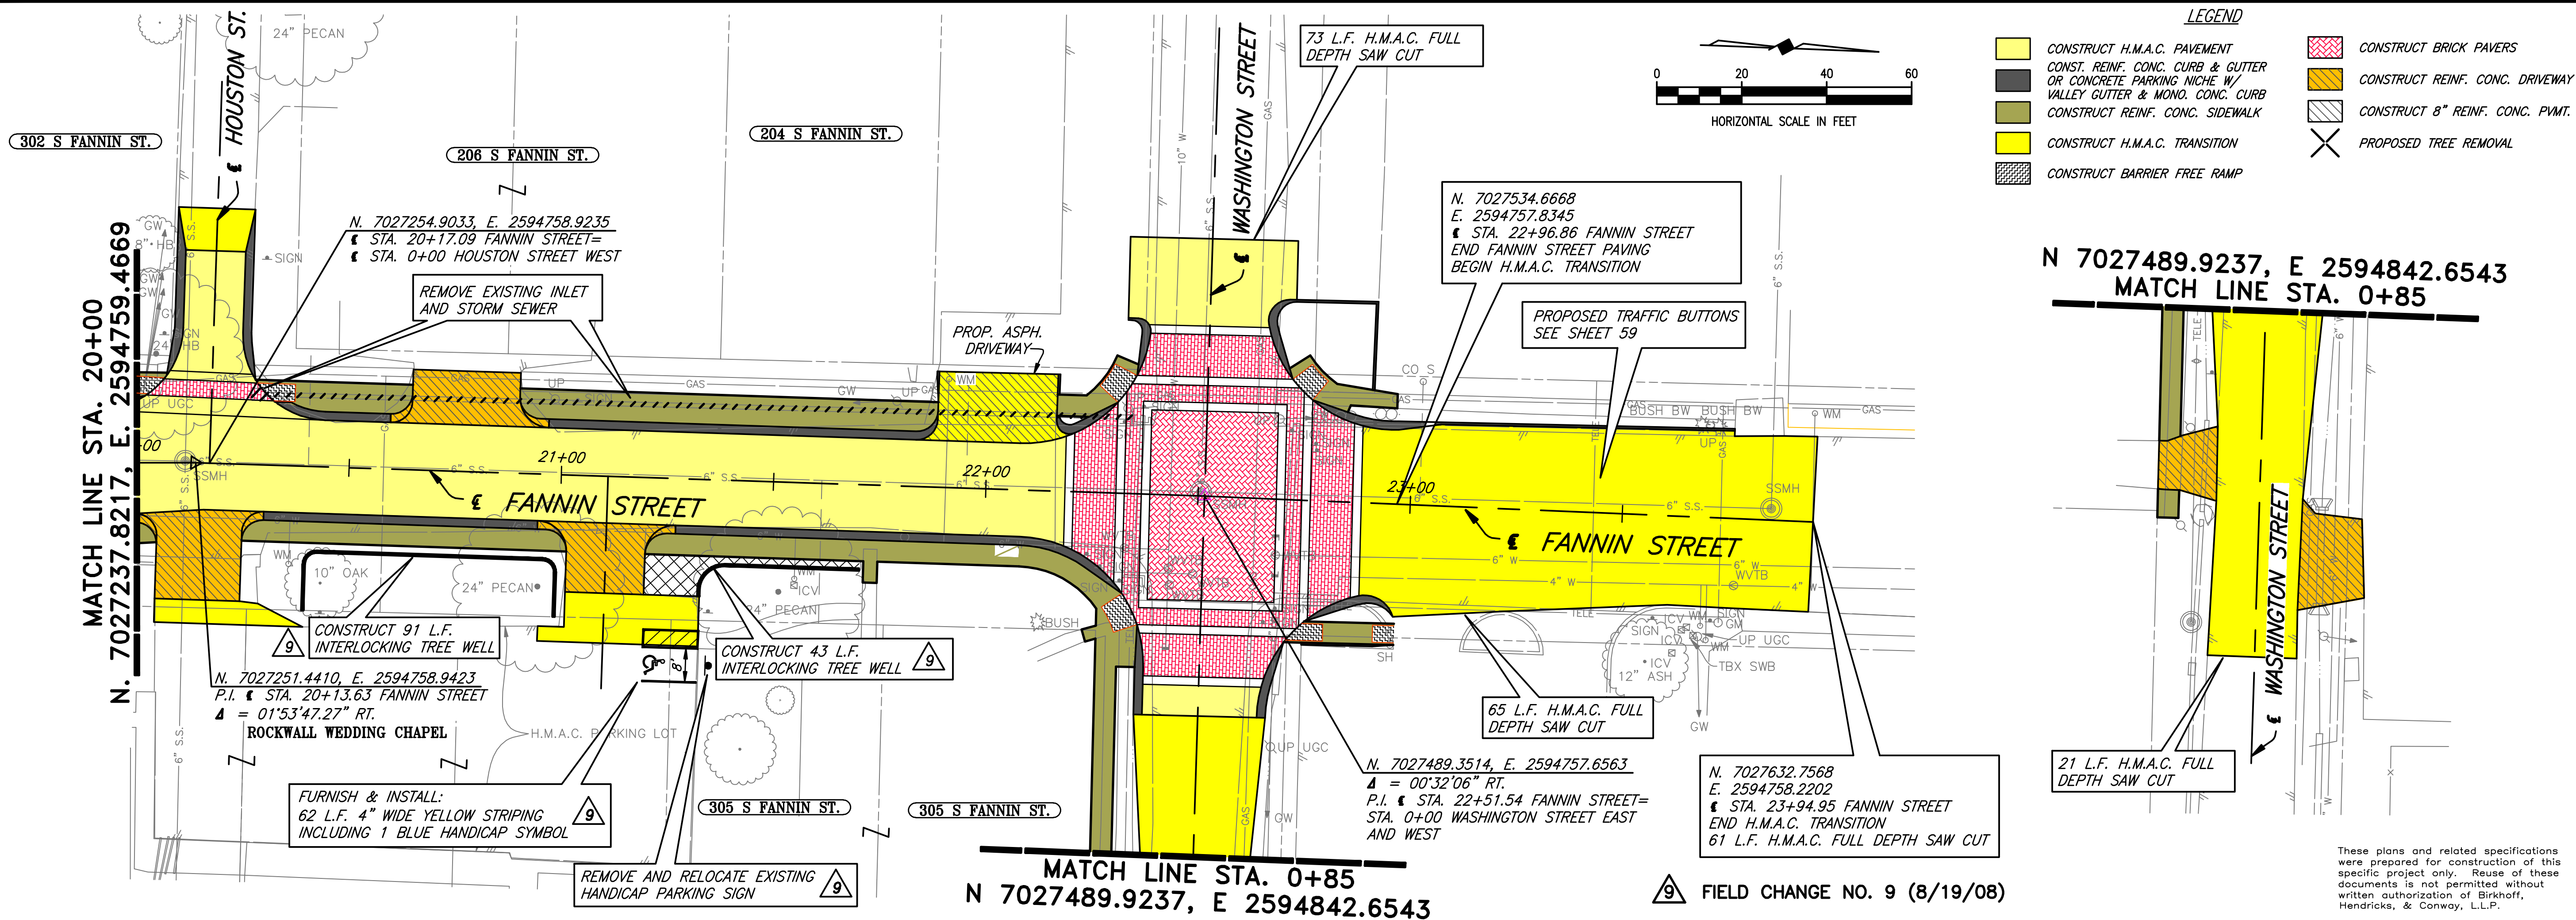

- LEGEND**
- CONSTRUCT H.M.A.C. PAVEMENT
  - CONST. REINF. CONC. CURB & GUTTER OR CONCRETE PARKING NICHE W/ VALLEY GUTTER & MONO. CONC. CURB
  - CONSTRUCT REINF. CONC. SIDEWALK
  - CONSTRUCT H.M.A.C. TRANSITION
  - CONSTRUCT BARRIER FREE RAMP
  - CONSTRUCT BRICK PAVERS
  - CONSTRUCT REINF. CONC. DRIVEWAY
  - CONSTRUCT 8" REINF. CONC. PVMT.
  - PROPOSED TREE REMOVAL

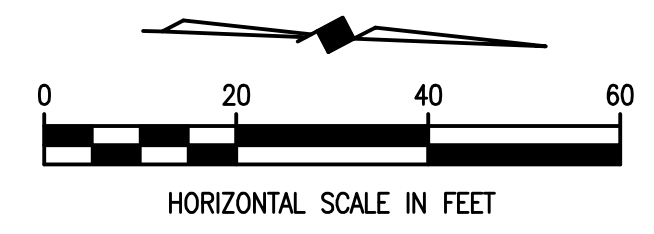


N 7027489.9237, E 2594842.6543  
 MATCH LINE STA. 0+85

MATCH LINE STA. 0+85  
 N 7027489.9237, E 2594842.6543

FIELD CHANGE NO. 9 (8/19/08)

These plans and related specifications were prepared for construction of this specific project only. Reuse of these documents is not permitted without written authorization of Birkhoff, Hendricks, & Conway, L.L.P.

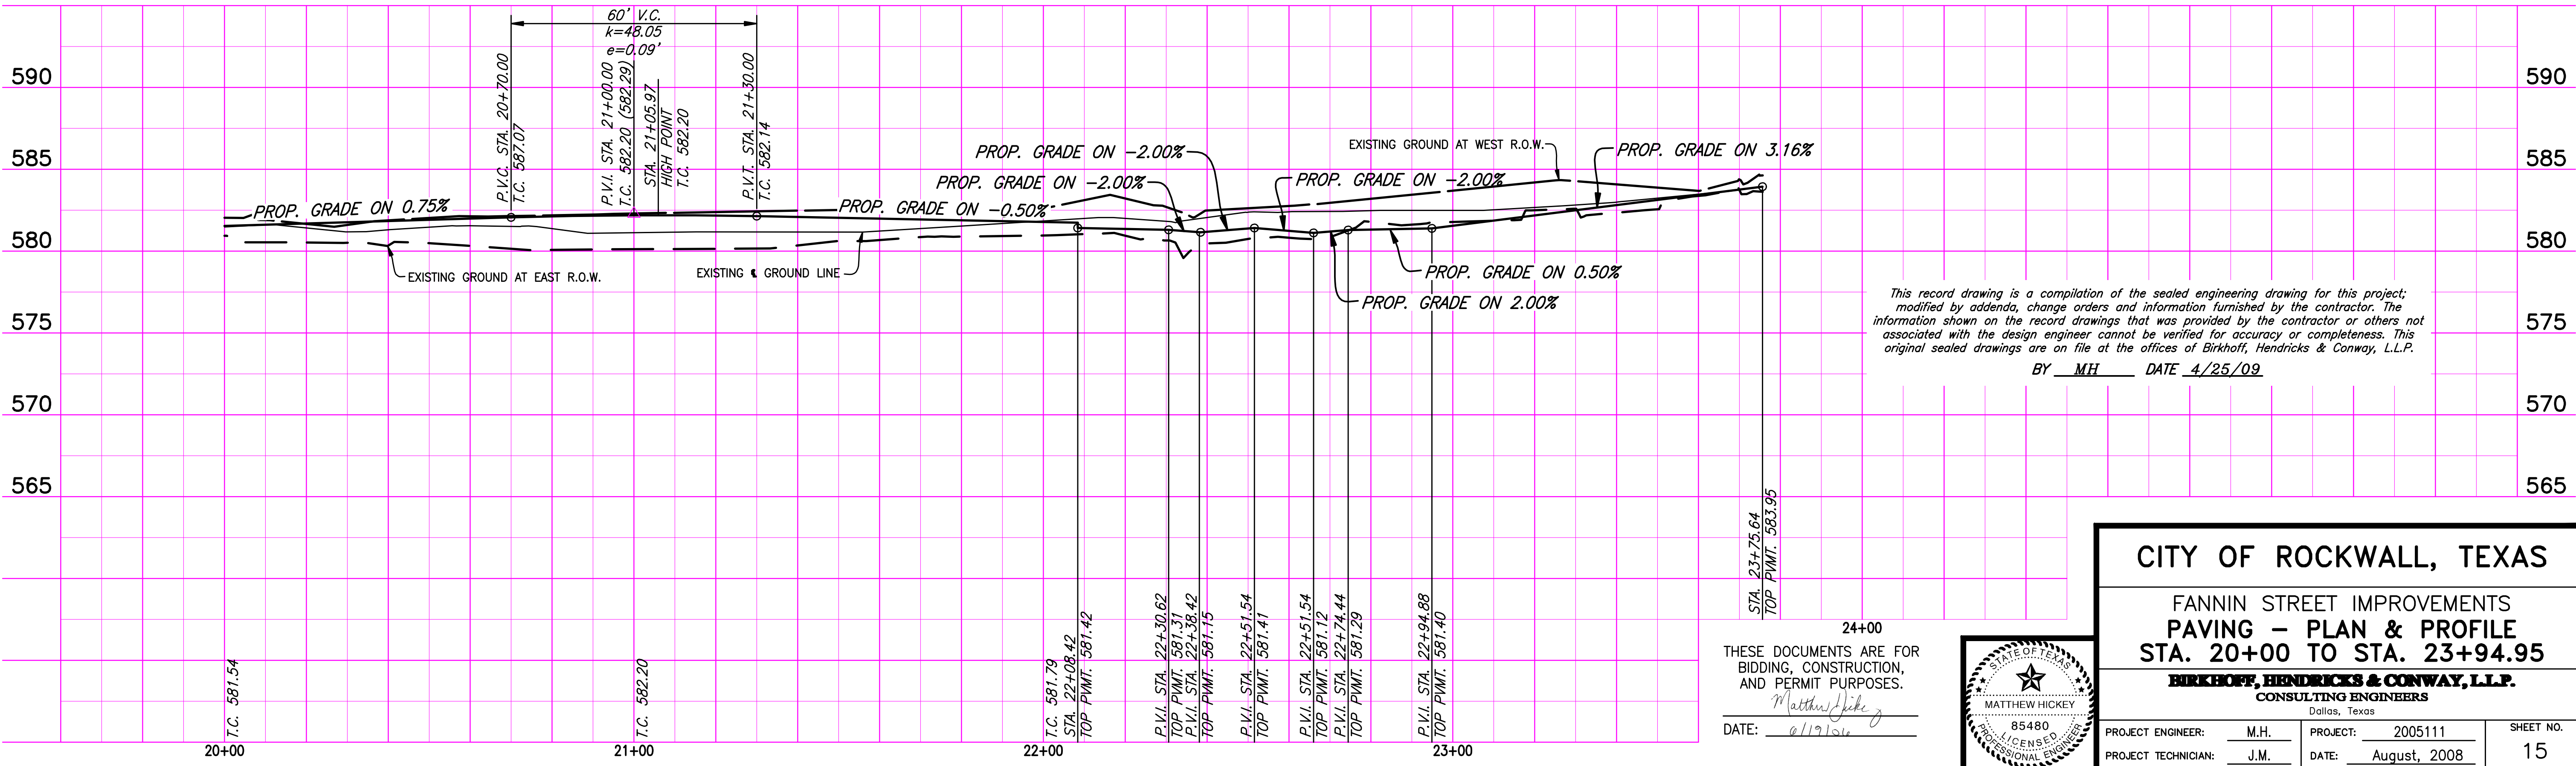

This record drawing is a compilation of the sealed engineering drawing for this project; modified by addenda, change orders and information furnished by the contractor. The information shown on the record drawings that was provided by the contractor or others not associated with the design engineer cannot be verified for accuracy or completeness. This original sealed drawings are on file at the offices of Birkhoff, Hendricks & Conway, L.L.P.  
 BY MH DATE 4/25/09

**CITY OF ROCKWALL, TEXAS**

FANNIN STREET IMPROVEMENTS  
 PAVING - PLAN & PROFILE  
 STA. 20+00 TO STA. 23+94.95

**BIRKHOFF, HENDRICKS & CONWAY, L.L.P.**  
 CONSULTING ENGINEERS  
 Dallas, Texas

PROJECT ENGINEER: M.H.	PROJECT: 2005111
PROJECT TECHNICIAN: J.M.	DATE: August, 2008
SHEET NO. 15	

