

REVISION: 4/29/09 - IWO
 C:\Acad_Jobs\Rockwall\2005111\Sheets\2005111-041_SANSEWB-SERV.dwg
 PLOT SCALE: 1:20
 PLOT STYLE: 22x34.ctb
 PLOTTED BY: GDMVIS ON 4/30/2009

PROPOSED FANNIN STREET SAN. SEW. SERVICES
STA. 0+00 TO STA. 5+00

LOCATION	PROPOSED 1 INCH SERVICE
S.S. STA. 0+98.24	35 L.F. (RT.)
S.S. STA. 1+58.86	35 L.F. (RT.)
S.S. STA. 2+37.16	35 L.F. (RT.)
S.S. STA. 2+80.26	35 L.F. (RT.)
S.S. STA. 3+38.98	35 L.F. (RT.)
S.S. STA. 3+85.03	35 L.F. (RT.)
S.S. STA. 4+42.03	35 L.F. (RT.)
S.S. STA. 4+82.30	35 L.F. (RT.)

TOTAL: 280 L.F.

PROPOSED LINE D SAN. SEW. SERVICE

S.S. STA. 0+27.78	5 L.F. (RT.)
S.S. STA. 0+35.22	45 L.F. (RT.)

TOTAL: 50 L.F.

FURNISH & INSTALL: (TYPICAL)
 1 - 8" X 4" WYE
 1 - DOUBLE CLEANOUT (IF REQUIRED)
 1 - 4" PLUG
 CONNECT TO EXIST. SANITARY SEWER SERVICE
 PAYMENT FOR TRANSFER OF SANITARY SEWER SERVICE SHALL BE PAID ON A PER EACH BASIS & SHALL INCLUDE THE FURNISH & INSTALL ITEMS NOTED ABOVE. PROP. 4 INCH P.V.C. SERVICE SHALL BE A SEPARATE PAY ITEM.

PROPOSED FANNIN STREET SAN. SEW. SERVICES
STA. 5+00 TO STA. 10+00

LOCATION	PROPOSED 1 INCH SERVICE
S.S. STA. 6+42.48	15 L.F. (LT.)
S.S. STA. 7+32.33	10 L.F. (LT.)
S.S. STA. 7+34.44	10 L.F. (LT.)
S.S. STA. 8+36.08	20 L.F. (LT.)
S.S. STA. 8+38.08	20 L.F. (LT.)
S.S. STA. 8+88.08	35 L.F. (RT.)
S.S. STA. 9+19.02	20 L.F. (LT.)

TOTAL: 130 L.F.

FURNISH & INSTALL: (TYPICAL)

1 - 8" X 4" WYE
 1 - DOUBLE CLEANOUT (IF REQUIRED)
 1 - 4" PLUG
 CONNECT TO EXIST. SANITARY SEWER SERVICE
 PAYMENT FOR TRANSFER OF SANITARY SEWER SERVICE SHALL BE PAID ON A PER EACH BASIS & SHALL INCLUDE THE FURNISH & INSTALL ITEMS NOTED ABOVE. PROP. 4 INCH P.V.C. SERVICE SHALL BE A SEPARATE PAY ITEM.

PROPOSED FANNIN STREET SAN. SEW. SERVICES
STA. 10+00 TO STA. 15+00

LOCATION	PROPOSED 1 INCH SERVICE
S.S. STA. 10+55.96	30 L.F. (RT.)
S.S. STA. 10+91.31	20 L.F. (LT.)
S.S. STA. 11+04.66	30 L.F. (RT.)
S.S. STA. 11+18.40	20 L.F. (LT.)
S.S. STA. 11+62.52	35 L.F. (RT.)
S.S. STA. 11+78.52	20 L.F. (LT.)
S.S. STA. 12+06.91	20 L.F. (LT.)
S.S. STA. 12+47.11	35 L.F. (RT.)
S.S. STA. 12+68.35	20 L.F. (LT.)
S.S. STA. 12+98.94	20 L.F. (LT.)
S.S. STA. 13+51.87	35 L.F. (RT.)
S.S. STA. 13+59.83	20 L.F. (LT.)
S.S. STA. 13+88.82	20 L.F. (LT.)
S.S. STA. 14+26.15	35 L.F. (RT.)

TOTAL: 360 L.F.

FURNISH & INSTALL: (TYPICAL)

1 - 8" X 4" WYE
 1 - DOUBLE CLEANOUT (IF REQUIRED)
 1 - 4" PLUG
 CONNECT TO EXIST. SANITARY SEWER SERVICE
 PAYMENT FOR TRANSFER OF SANITARY SEWER SERVICE SHALL BE PAID ON A PER EACH BASIS & SHALL INCLUDE THE FURNISH & INSTALL ITEMS NOTED ABOVE. PROP. 4 INCH P.V.C. SERVICE SHALL BE A SEPARATE PAY ITEM.

PROPOSED FANNIN STREET SAN. SEW. SERVICES
STA. 15+00 TO STA. 20+00

LOCATION	PROPOSED 1 INCH SERVICE
S.S. STA. 15+17.15	35 L.F. (RT.)
S.S. STA. 15+84.06	35 L.F. (RT.)
S.S. STA. 16+11.12	30 L.F. (RT.)
S.S. STA. 17+32.08	30 L.F. (RT.)
S.S. STA. 18+05.90	15 L.F. (RT.)
S.S. STA. 18+43.78	50 L.F. (LT.)
S.S. STA. 19+11.42	70 L.F. (LT.)
S.S. STA. 19+19.34	20 L.F. (LT.)
S.S. STA. 19+38.38	15 L.F. (LT.)

TOTAL: 300 L.F.

FURNISH & INSTALL: (TYPICAL)

1 - 8" X 4" WYE
 1 - DOUBLE CLEANOUT (IF REQUIRED)
 1 - 4" PLUG
 CONNECT TO EXIST. SANITARY SEWER SERVICE
 PAYMENT FOR TRANSFER OF SANITARY SEWER SERVICE SHALL BE PAID ON A PER EACH BASIS & SHALL INCLUDE THE FURNISH & INSTALL ITEMS NOTED ABOVE. PROP. 4 INCH P.V.C. SERVICE SHALL BE A SEPARATE PAY ITEM.

PROPOSED FANNIN STREET SAN. SEW. SERVICES
STA. 20+00 TO STA. 24+09.86

LOCATION	PROPOSED 1 INCH SERVICE
S.S. STA. 20+14.21	35 L.F. (RT.)
S.S. STA. 20+63.33	20 L.F. (LT.)
S.S. STA. 21+84.30	40 L.F. (RT.)
S.S. STA. 22+11.38	25 L.F. (LT.)
S.S. STA. 23+25.06	25 L.F. (LT.)
S.S. STA. 23+85±	32 L.F. (LT.)

TOTAL: 177 L.F.

FURNISH & INSTALL: (TYPICAL)
 1 - 8" X 4" WYE
 1 - DOUBLE CLEANOUT (IF REQUIRED)
 1 - 4" PLUG
 CONNECT TO EXIST. SANITARY SEWER SERVICE
 PAYMENT FOR TRANSFER OF SANITARY SEWER SERVICE SHALL BE PAID ON A PER EACH BASIS & SHALL INCLUDE THE FURNISH & INSTALL ITEMS NOTED ABOVE. PROP. 4 INCH P.V.C. SERVICE SHALL BE A SEPARATE PAY ITEM.

PROPOSED STORRS STREET SAN. SEW. SERVICES
STA. -0+75.62 TO STA. 1+35.56

LOCATION	PROPOSED 1 INCH SERVICE
S.S. STA. -0+61.17	25 L.F. (LT.)
S.S. STA. 0+87.44	25 L.F. (LT.)
S.S. STA. 1+12.21	20 L.F. (RT.)
S.S. STA. 1+13.70	20 L.F. (RT.)

TOTAL: 90 L.F.

FURNISH & INSTALL: (TYPICAL)

1 - 8" X 4" WYE
 1 - DOUBLE CLEANOUT (IF REQUIRED)
 1 - 4" PLUG
 CONNECT TO EXIST. SANITARY SEWER SERVICE
 PAYMENT FOR TRANSFER OF SANITARY SEWER SERVICE SHALL BE PAID ON A PER EACH BASIS & SHALL INCLUDE THE FURNISH & INSTALL ITEMS NOTED ABOVE. PROP. 4 INCH P.V.C. SERVICE SHALL BE A SEPARATE PAY ITEM.


These plans and related specifications were prepared for construction of this specific project only. Reuse of these documents is not permitted without written authorization of Birkhoff, Hendricks, & Conway, L.L.P.

This record drawing is a compilation of the sealed engineering drawing for this project; modified by addenda, change orders and information furnished by the contractor. The information shown on the record drawings that was provided by the contractor or others not associated with the design engineer cannot be verified for accuracy or completeness. This original sealed drawings are on file at the offices of Birkhoff, Hendricks & Conway, L.L.P.

BY MH DATE 4/25/09

THESE DOCUMENTS ARE FOR BIDDING, CONSTRUCTION, AND PERMIT PURPOSES.

DATE: 4/19/09

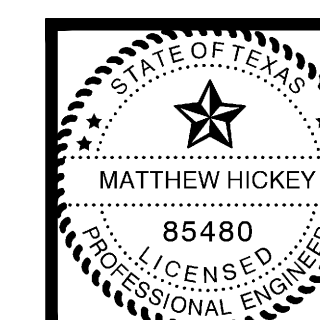

CITY OF ROCKWALL, TEXAS

**FANNIN STREET IMPROVEMENTS
SANITARY SEWER - PLAN & PROFILE
STA. 5+00 TO STA. 10+00**

BIRKHOFF, HENDRICKS & CONWAY, L.L.P.
CONSULTING ENGINEERS
Dallas, Texas

PROJECT ENGINEER: M.H.	PROJECT: 2005111	SHEET NO. 41
PROJECT TECHNICIAN: MVO	DATE: June, 2006	