


C:\Acad_Jobs\Rockwall\2005111\Sheets\2005111-067_SW3P2.dwg
 PLOT SCALE: 1:40
 PLOT STYLE: 22X34.ctb
 PLOTTED BY: GDAVIS ON 4/30/2009
 REVISED: 4/23/09 - GDAVIS

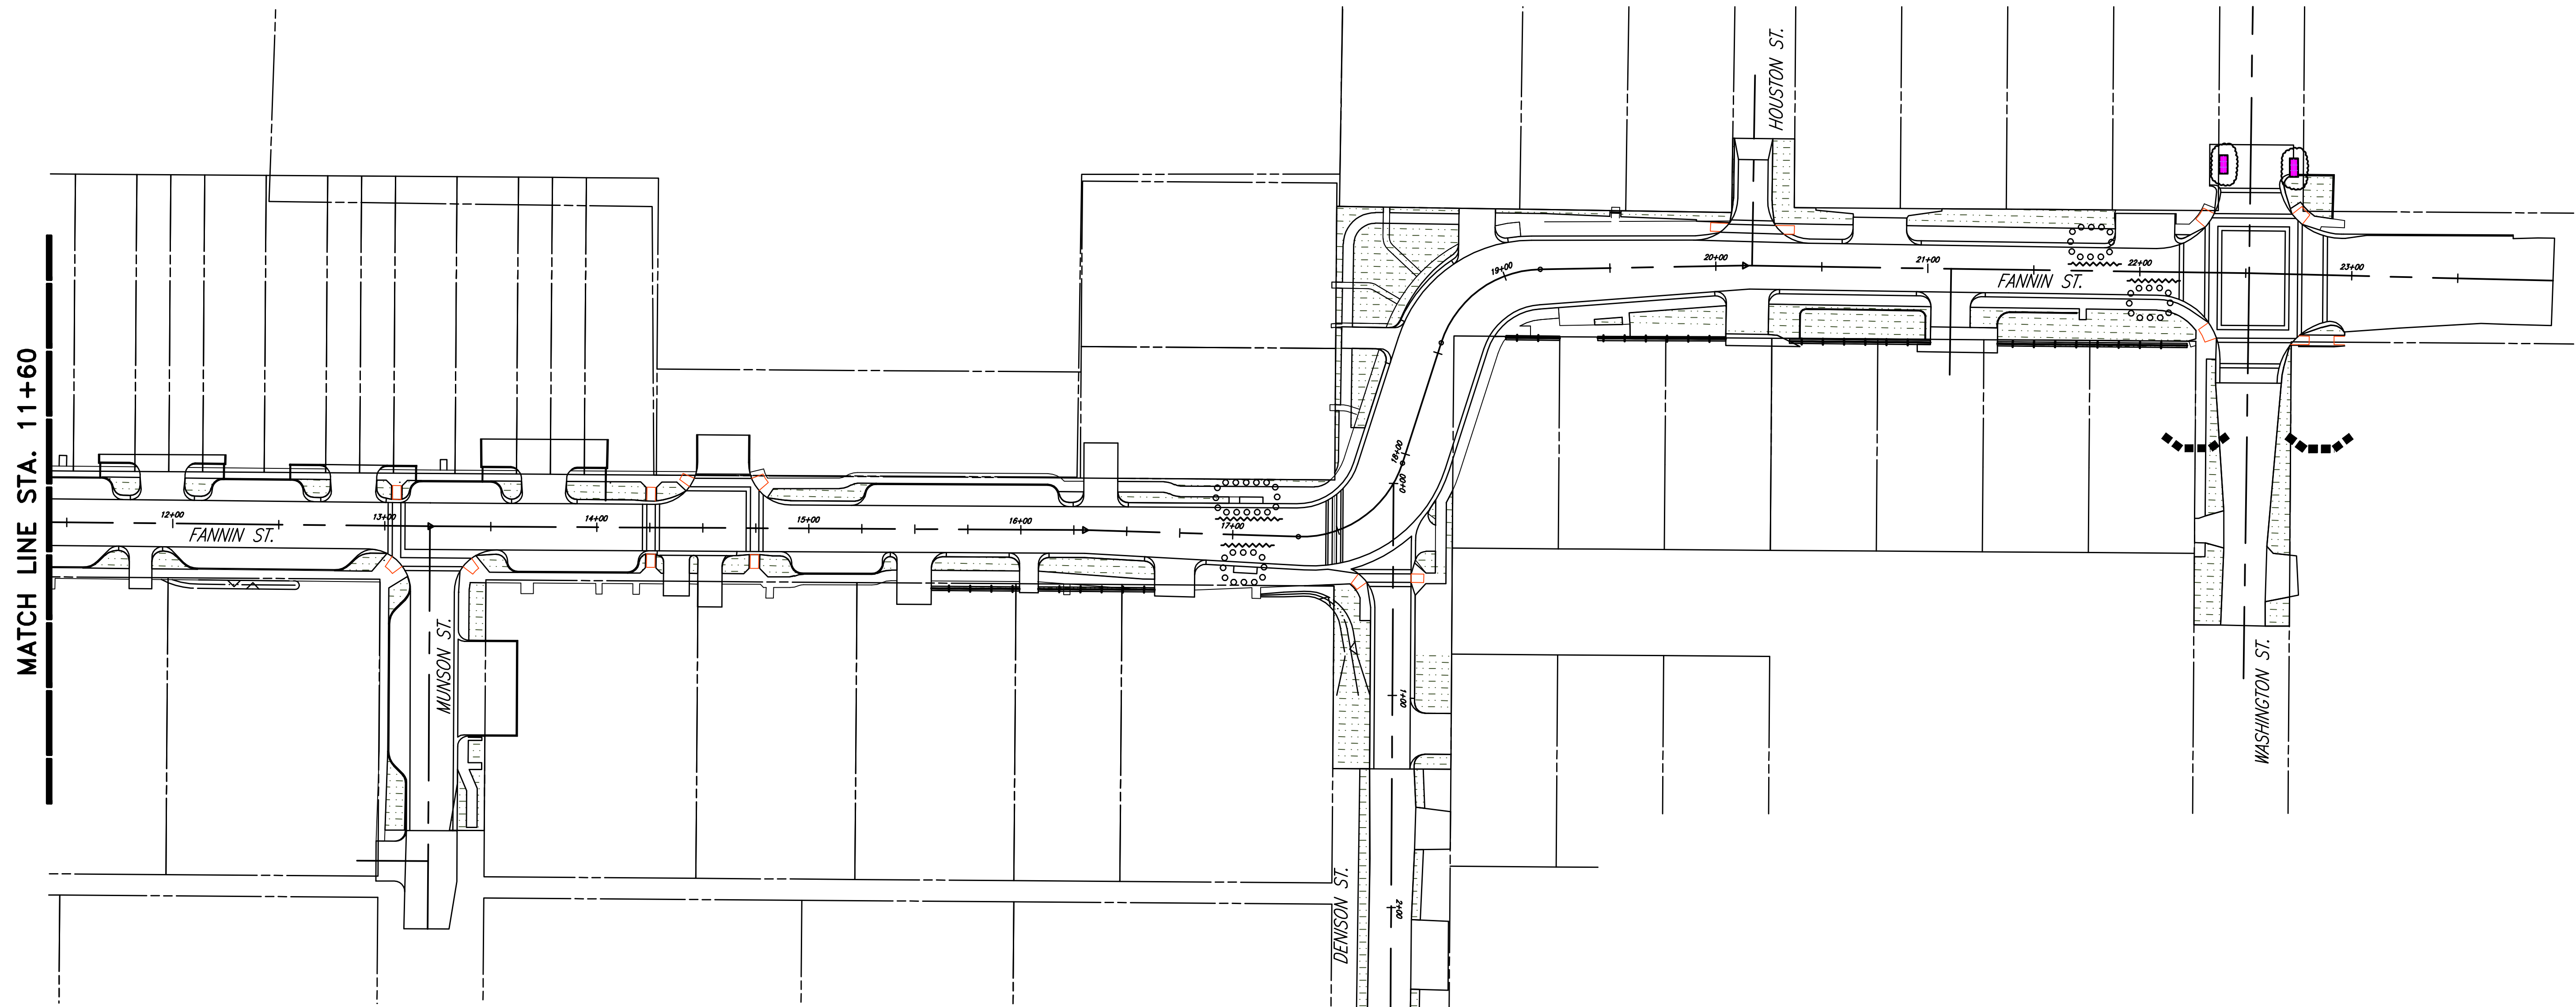


LEGEND

- SILT FENCE (339 L.F.)
- EXCAVATED INLET PROTECTION
- STONE OUTLET SEDIMENT TRAP
- STD. INLET PROTECTION
- PIPE PROTECTION
- DROP/GRATE INLET PROTECTION
- DIRECTION OF FLOW
- SOLID SOD (2266 S.Y.)

GENERAL NOTES:

1. UNLESS OTHERWISE EROSION CONTROL DEVICES ALONG ROADWAY SHALL BE A MINIMUM 3 FEET OFF THE BACK OF CURB.
2. ALL NON-PAVED AREAS SHALL HAVE GRASS COVER ESTABLISHED BY BLOCK SOD AND FERTILIZER .
3. CONTRACTOR SHALL CONSTRUCT ALL DEVICES AS QUICKLY AS IS PRACTICAL FOR PROPOSED STRUCTURES AND SHALL MAINTAIN THROUGHOUT CONSTRUCTION.
4. REFER TO STORM DRAINAGE PLAN FOR ADDITIONAL INFORMATION REGARDING LOCATION OF PROPOSED CHANNELS AND INLETS.
5. REFER TO STORM DRAINAGE PROFILES AND CROSS-SECTIONS FOR ADDITIONAL INFORMATION REGARDING VERTICAL CONTROL FOR PROPOSED CHANNELS AND INLETS.
6. 40 L.F. SEDIMENT CONTROL FENCE ALLOWED IN ESTIMATED QUANTITY FOR EACH INLET EROSION CONTROL DEVICE SHOWN.
7. AFTER CONSTRUCTION OF ROADWAY, BACKFILL BEHIND CURB WITH TOPSOIL AND PLACE SOLID SOD END TO END AND SIDE TO THE R.O.W.
8. ALL DEVICES, FENCING AND OUTLETS FOR POLLUTION PREVENTION SHALL BE REMOVED AFTER PROJECT HAS BEEN OFFICIALLY COMPLETED.

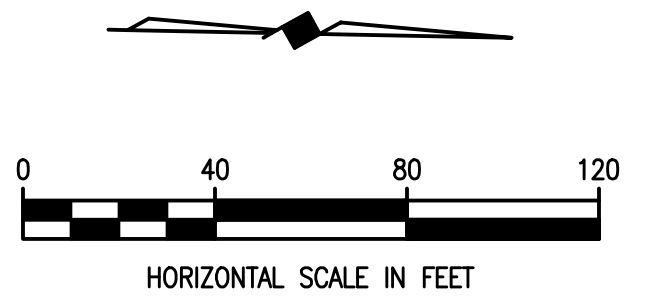

This record drawing is a compilation of the sealed engineering drawing for this project; modified by addenda, change orders and information furnished by the contractor. The information shown on the record drawings that was provided by the contractor or others not associated with the design engineer cannot be verified for accuracy or completeness. This original sealed drawings are on file at the offices of Birkhoff, Hendricks & Conway, L.L.P.
 BY MH DATE 4/25/09

These plans and related specifications were prepared for construction of this specific project only. Reuse of these documents is not permitted without written authorization of Birkhoff, Hendricks, & Conway, L.L.P.

THESE DOCUMENTS ARE FOR BIDDING, CONSTRUCTION, AND PERMIT PURPOSES.
 Matthew Hickey
 DATE: 6/19/09



CITY OF ROCKWALL, TEXAS			
FANNIN STREET IMPROVEMENTS			
STORM WATER POLLUTION PREVENTION PLAN			
STA. 11+60 TO STA. 23+22			
BIRKHOFF, HENDRICKS & CONWAY, L.L.P.			
<small>CONSULTING ENGINEERS Dallas, Texas</small>			
PROJECT ENGINEER:	M.H.	PROJECT:	2005111
PROJECT TECHNICIAN:	MVO	DATE:	June, 2006
			SHEET NO. 67