
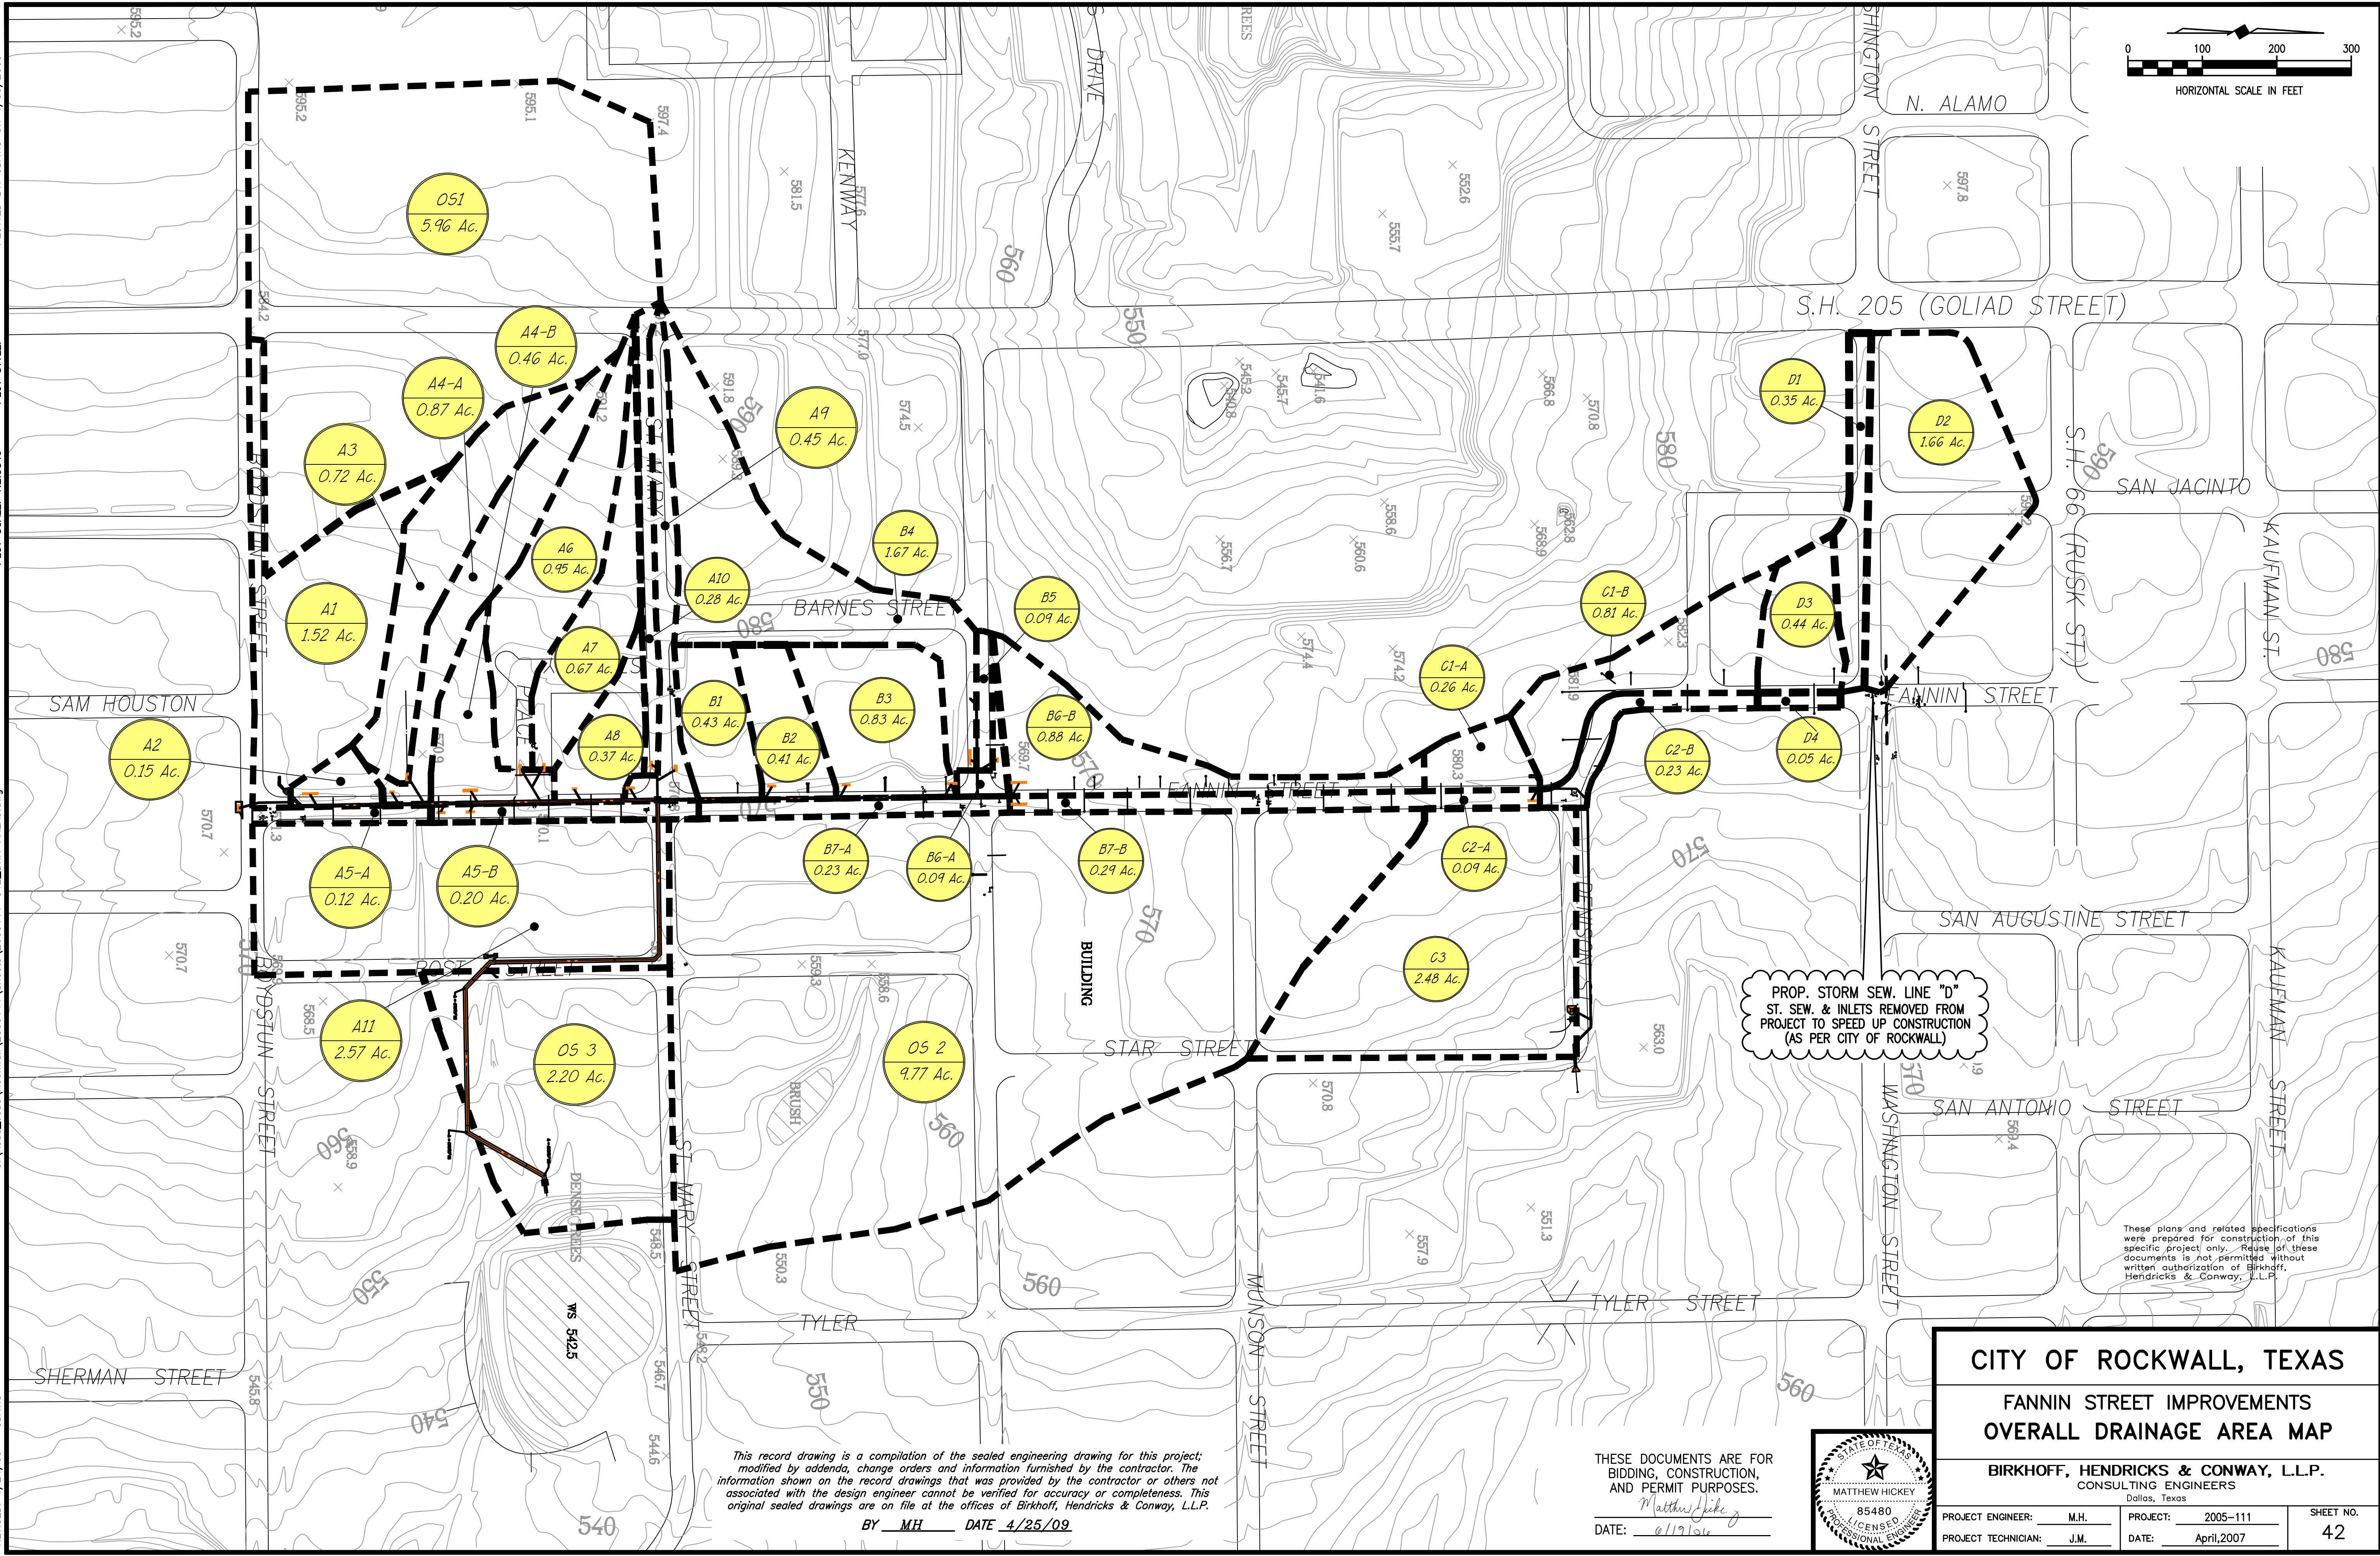


PLOTTED BY: GDAVIS ON 4/30/2009

PLOT SCALE: 1:2,5849

C:\Acad\_Jobs\Rockwall\2005111\Sheets\2005111-042\_DRN-AREA3.dwg

REVISED: 4/24/09 - GDAVIS

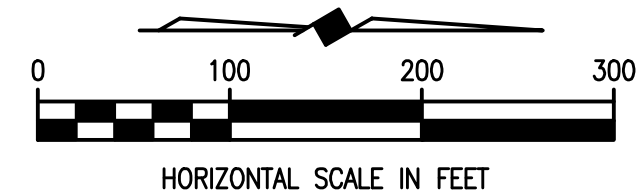

PROP. STORM SEW. LINE "D"  
ST. SEW. & INLETS REMOVED FROM  
PROJECT TO SPEED UP CONSTRUCTION  
(AS PER CITY OF ROCKWALL)

These plans and related specifications were prepared for construction of this specific project only. Reuse of these documents is not permitted without written authorization of Birkhoff, Hendricks & Conway, L.L.P.

This record drawing is a compilation of the sealed engineering drawing for this project; modified by addenda, change orders and information furnished by the contractor. The information shown on the record drawings that was provided by the contractor or others not associated with the design engineer cannot be verified for accuracy or completeness. This original sealed drawings are on file at the offices of Birkhoff, Hendricks & Conway, L.L.P.

BY MH DATE 4/25/09

THESE DOCUMENTS ARE FOR BIDDING, CONSTRUCTION, AND PERMIT PURPOSES.  
*Matthew Hickey*  
DATE: 4/19/09



**CITY OF ROCKWALL, TEXAS**  
**FANNIN STREET IMPROVEMENTS**  
**OVERALL DRAINAGE AREA MAP**

**BIRKHOFF, HENDRICKS & CONWAY, L.L.P.**  
CONSULTING ENGINEERS  
Dallas, Texas

PROJECT ENGINEER: <u>M.H.</u>	PROJECT: <u>2005-111</u>	SHEET NO. <u>42</u>
PROJECT TECHNICIAN: <u>J.M.</u>	DATE: <u>April, 2007</u>	