
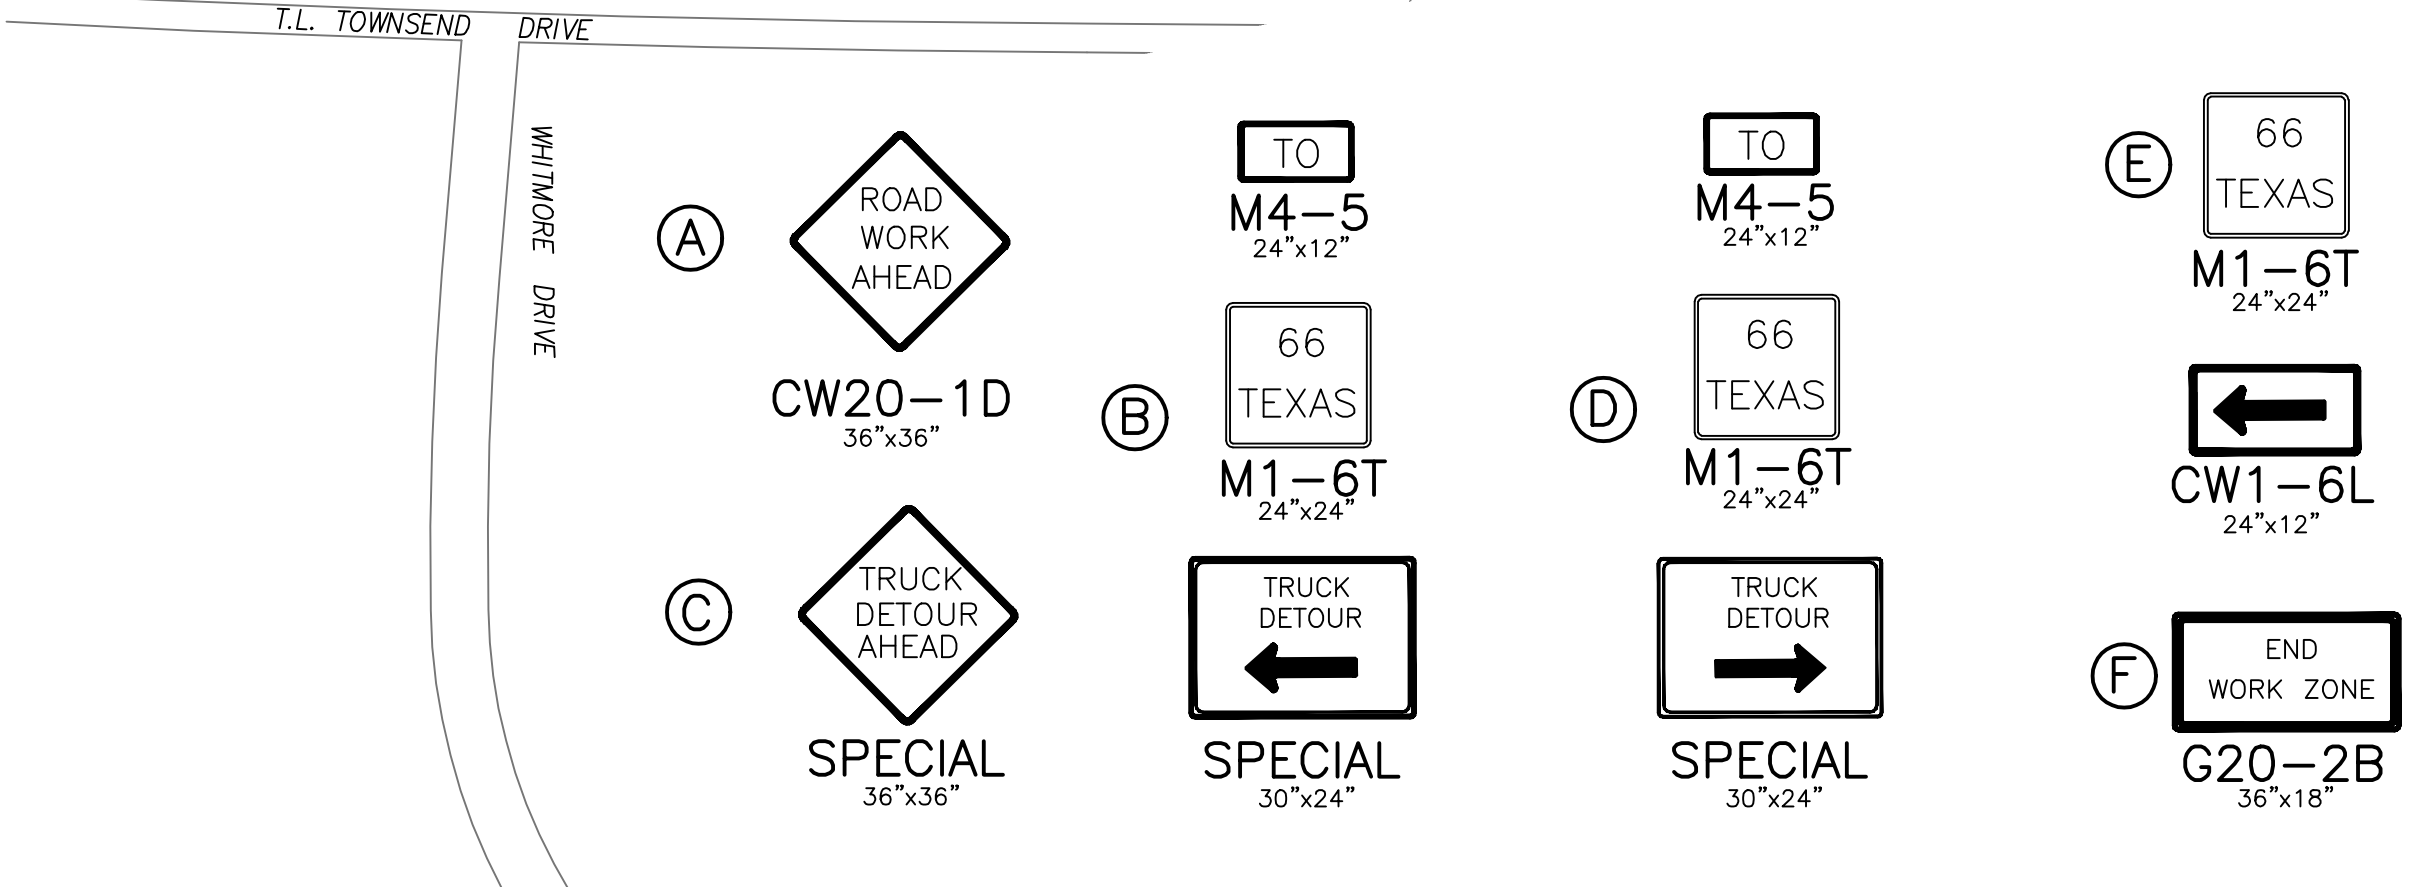


REVISD: 6/18/08 - JGRAJEWSKI PLOTTED BY: JGRAJEWSKI ON 8/18/2008
 C:\Acad_Jobs\Rockwall\2005111\Sheets\2005111-073_DET-1.dwg PLOT STYLE: 22X34.ctb PLOT SCALE: 1:200

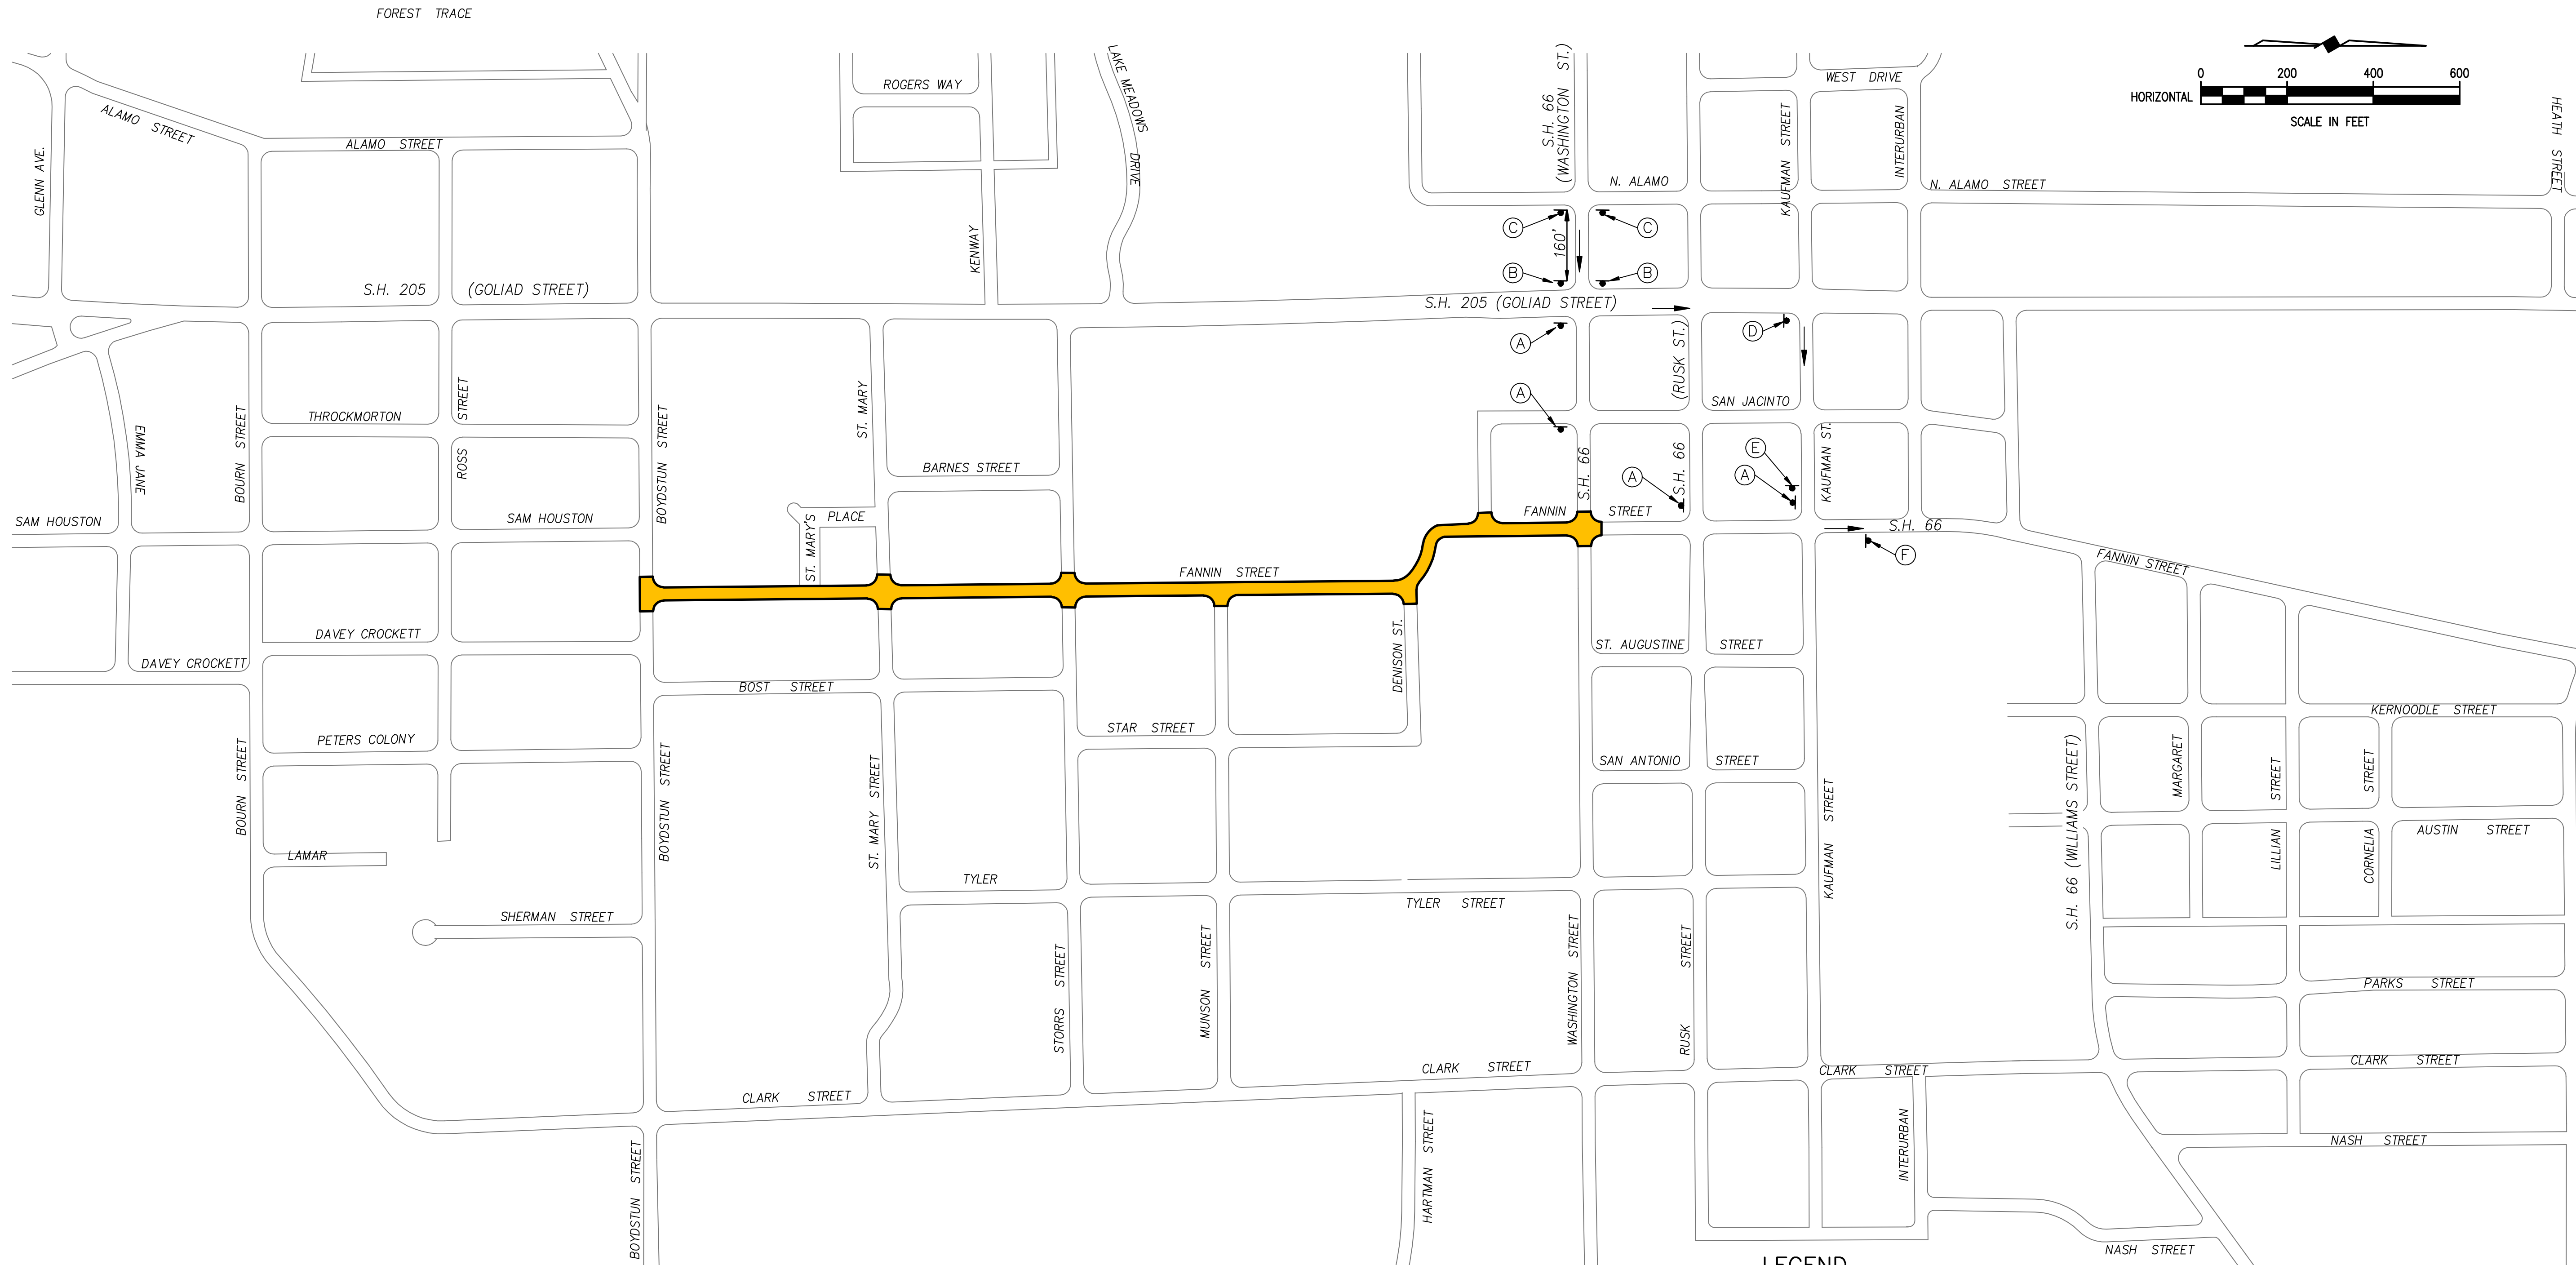

This record drawing is a compilation of the sealed engineering drawing for this project, modified by addenda, change orders and information furnished by the contractor. The information shown on the record drawings that was provided by the contractor or others not associated with the design engineer cannot be verified for accuracy or completeness. This original sealed drawings are on file at the offices of Birkhoff, Hendricks & Conway, L.L.P.

BY MH DATE 4/25/09

THESE DOCUMENTS ARE FOR BIDDING, CONSTRUCTION, AND PERMIT PURPOSES.

Matthew Hickey
 DATE: 6/19/09



CITY OF ROCKWALL, TEXAS

FANNIN STREET-WASHINGTON STREET INTERSECTION

S.H. 66 TRUCK DETOUR PLAN

BIRKHOFF, HENDRICKS & CONWAY, L.L.P.
 CONSULTING ENGINEERS
 Dallas, Texas

| | | |
|--------------------------|--------------------------|---------------------|
| DESIGNED BY: <u>M.H.</u> | PROJECT: <u>2005-111</u> | SHEET NO. <u>73</u> |
| DRAWN BY: <u>J.M.</u> | DATE: <u>MAY, 2006</u> | |