

PROBATION OFFICE

This record drawing is a compilation of the sealed engineering drawing for this project; modified by addenda, change orders and information furnished by the contractor. The information shown on the record drawings that was provided by the contractor or others not associated with the design engineer cannot be verified for accuracy or completeness. This original sealed drawings are on file at the offices of Birkhoff, Hendricks & Conway, L.L.P.

BY MH DATE 4/25/09

CONSTRUCT 39 L.F.
6" CONCRETE CURB



CONTRACTOR TO PROVIDE
41 S.Y. 4" TOPSOIL AND
SOLID SOD

PARKING LOT

WASHINGTON ST.

TAPESTRY

SCALE: 1" = 20'

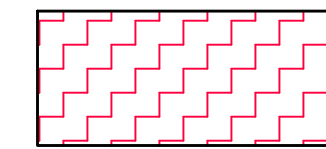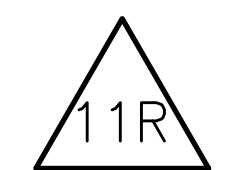

TRANSITION FROM CROWN
TO CROSS SLOPE

11 FIELD CHANGE NO. 11-REVISED (8/22/2008)


These plans and related specifications were prepared for construction of this specific project only. Reuse of these documents is not permitted without written authorization of Birkhoff, Hendricks, & Conway, L.L.P.

THESE DOCUMENTS ARE FOR
BIDDING, CONSTRUCTION,
AND PERMIT PURPOSES.

DATE: 01/19/06
Matthew Hickey

PAVING STA. 21+50
T.C. 582.04

PAVING STA. 21+50
T.C. 582.04

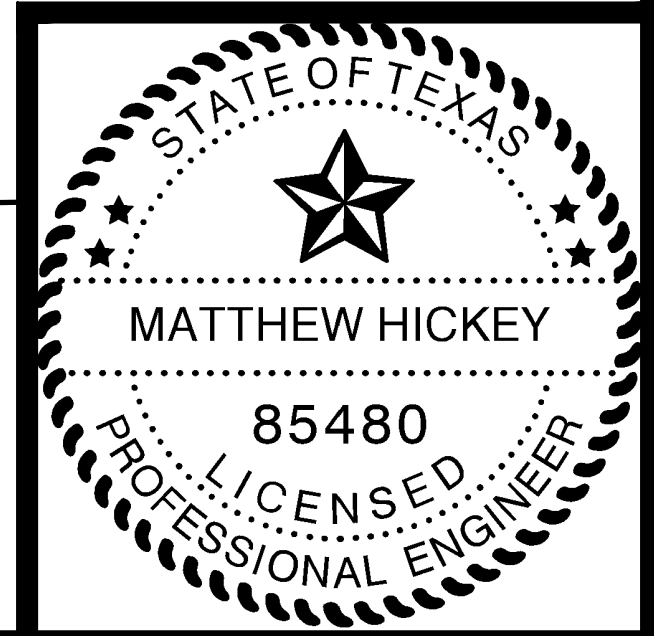

CITY OF ROCKWALL, TEXAS

FANNIN STREET IMPROVEMENTS
INTERSECTION SPOT ELEVATIONS
AT WASHINGTON STREET

BIRKHOFF, HENDRICKS & CONWAY, L.L.P.
CONSULTING ENGINEERS
Dallas, Texas

PROJECT ENGINEER: <u>M.H.</u>	PROJECT: <u>2005111</u>	SHEET NO.
PROJECT TECHNICIAN: <u>J.M.</u>	DATE: <u>AUG. 2008</u>	<u>97A</u>

C:\Acad_Jobs\Rockwall\2005111\Sheets\2005111-097A_Wash-Fannin_Spotdrain.dwg

REVISED: 4/22/09 - GDAVIS