


10/9/09 - JUAN MORALES
PLOTED BY: JUAN MORALES ON 10/9/2009
PLOT STYLE: 11x17.ctb
PLOT SCALE: 1:2
H:\Projects\Rockwall\2008116\Sheets\2008116-LIGHTING-FANNIN-COVER.dwg

CITY OF ROCKWALL, TEXAS

CONSTRUCTION PLANS FOR

INSTALLATION OF FANNIN STREET LIGHTS (BOYDSTUN TO WASHINGTON)

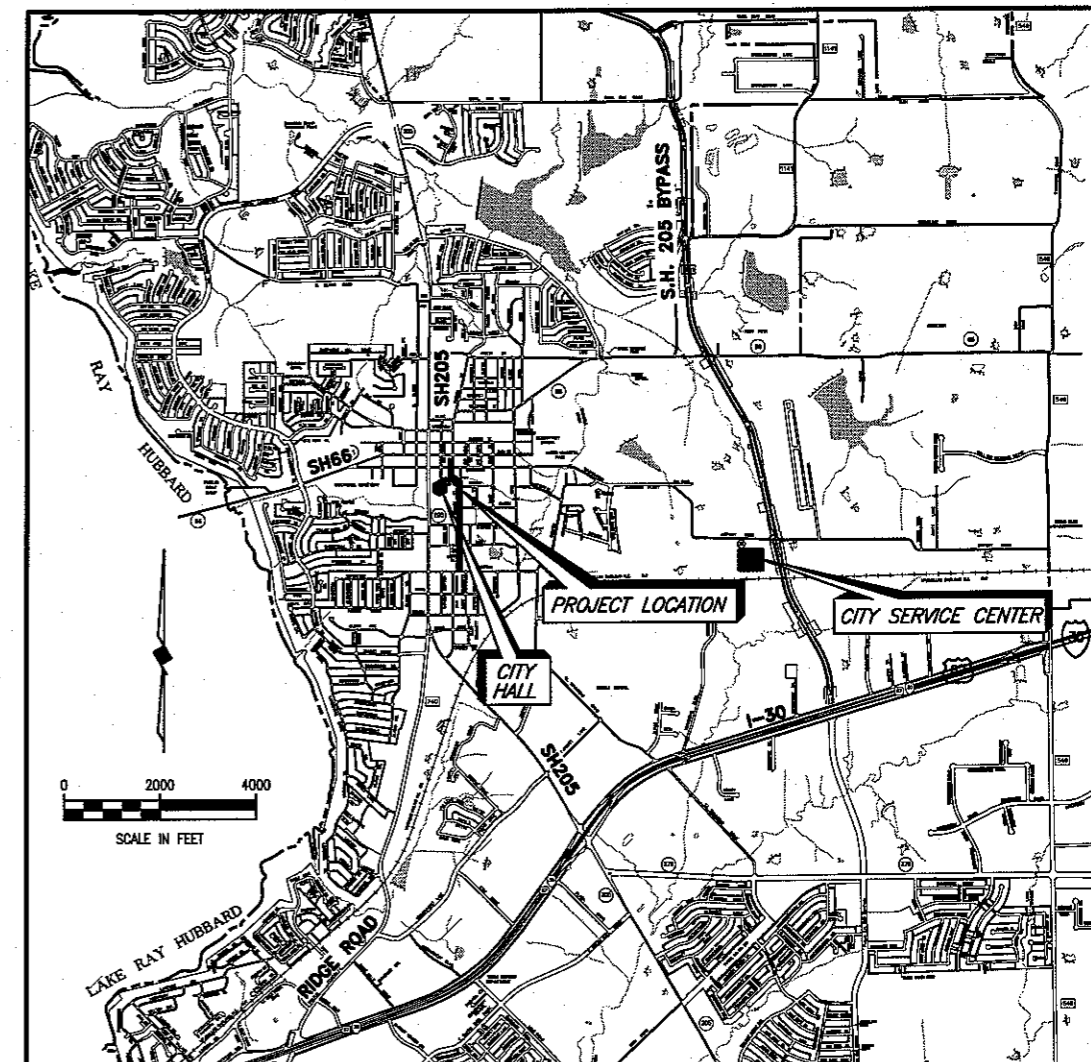

LOCATION MAP

SHEET INDEX

<u>SHEET NO.</u>	<u>SHEET DESCRIPTION</u>
1	COVER SHEET
C1	POLE LOCATIONS
C2	POLE LOCATIONS
C3	POLE LOCATIONS / GENERAL NOTES
E1	ELECTRICAL SITE PLAN
E2	ELECTRICAL ONE LINE DIAGRAM & SCHEMATICS
E3	ELECTRICAL DETAILS SHEET I
E4	ELECTRICAL DETAILS SHEET II

COUNCIL MEMBERS

BILL CECIL, MAYOR
CLIFF SEVIER, MAYOR PRO-TEM
DAVID SWEET
GLEN FARRIS
MARK RUSSO
MATT SCOTT
MARGO NIELSON

CITY MANAGER

JULIE COUCH

ASSISTANT CITY MANAGER

RICHARD CROWLEY

CITY ENGINEER

CHUCK TODD, P.E.



BIRKHOFF, HENDRICKS & CONWAY, L.L.P.
PROFESSIONAL ENGINEERS
Texas Firm F526
Dallas, Texas



APRIL, 2009




Handwritten signature and date: 4/17/09

This record drawing is a compilation of the sealed engineering drawing for this project; modified by addenda, change orders and information furnished by the contractor. The information shown on the record drawings that was provided by the contractor or others not associated with the design engineer cannot be verified for accuracy or completeness. This original sealed drawings are on file at the offices of Birkhoff, Hendricks & Conway, L.L.P.
BY P.A.C. DATE 10/09/09

NOTE:
 1. PRIOR TO CONSTRUCTION, CONTRACTOR SHALL VERIFY IF INSTALLED PULL BOXES ARE FIBER OPTIC OR ELECTRICAL. FIBER OPTIC PULL BOXES WILL HAVE 4" CONDUIT AND ELECTRICAL PULL BOXES WILL HAVE 2" CONDUIT.
 2. IF ADDITIONAL PULL BOXES ARE REQUIRED BETWEEN EXISTING POLE BASES TO INSTALL STREET LIGHT WIRE, THE WORK SHALL BE APPROVED BY THE CITY PRIOR TO INSTALLATION. PAYMENT FOR ADDITIONAL ELECTRICAL PULL BOXES SHALL BE PAID UNDER PAY ITEM 7 AND SHALL INCLUDE RESTORATION OF PARKWAY, UNDERCUT OF EXISTING CURB & GUTTER, 2" CONDUIT AND SWEEPS IN CEMENT STABILIZED BACKFILL UNDER CUT AREA. ADDITIONAL PULL BOXES SHALL BE QUAZITE 17" x 30" x 30" OR APPROVED EQUAL AND BE IN ACCORDANCE WITH TxDOT TYPE "D" PULL BOXES.

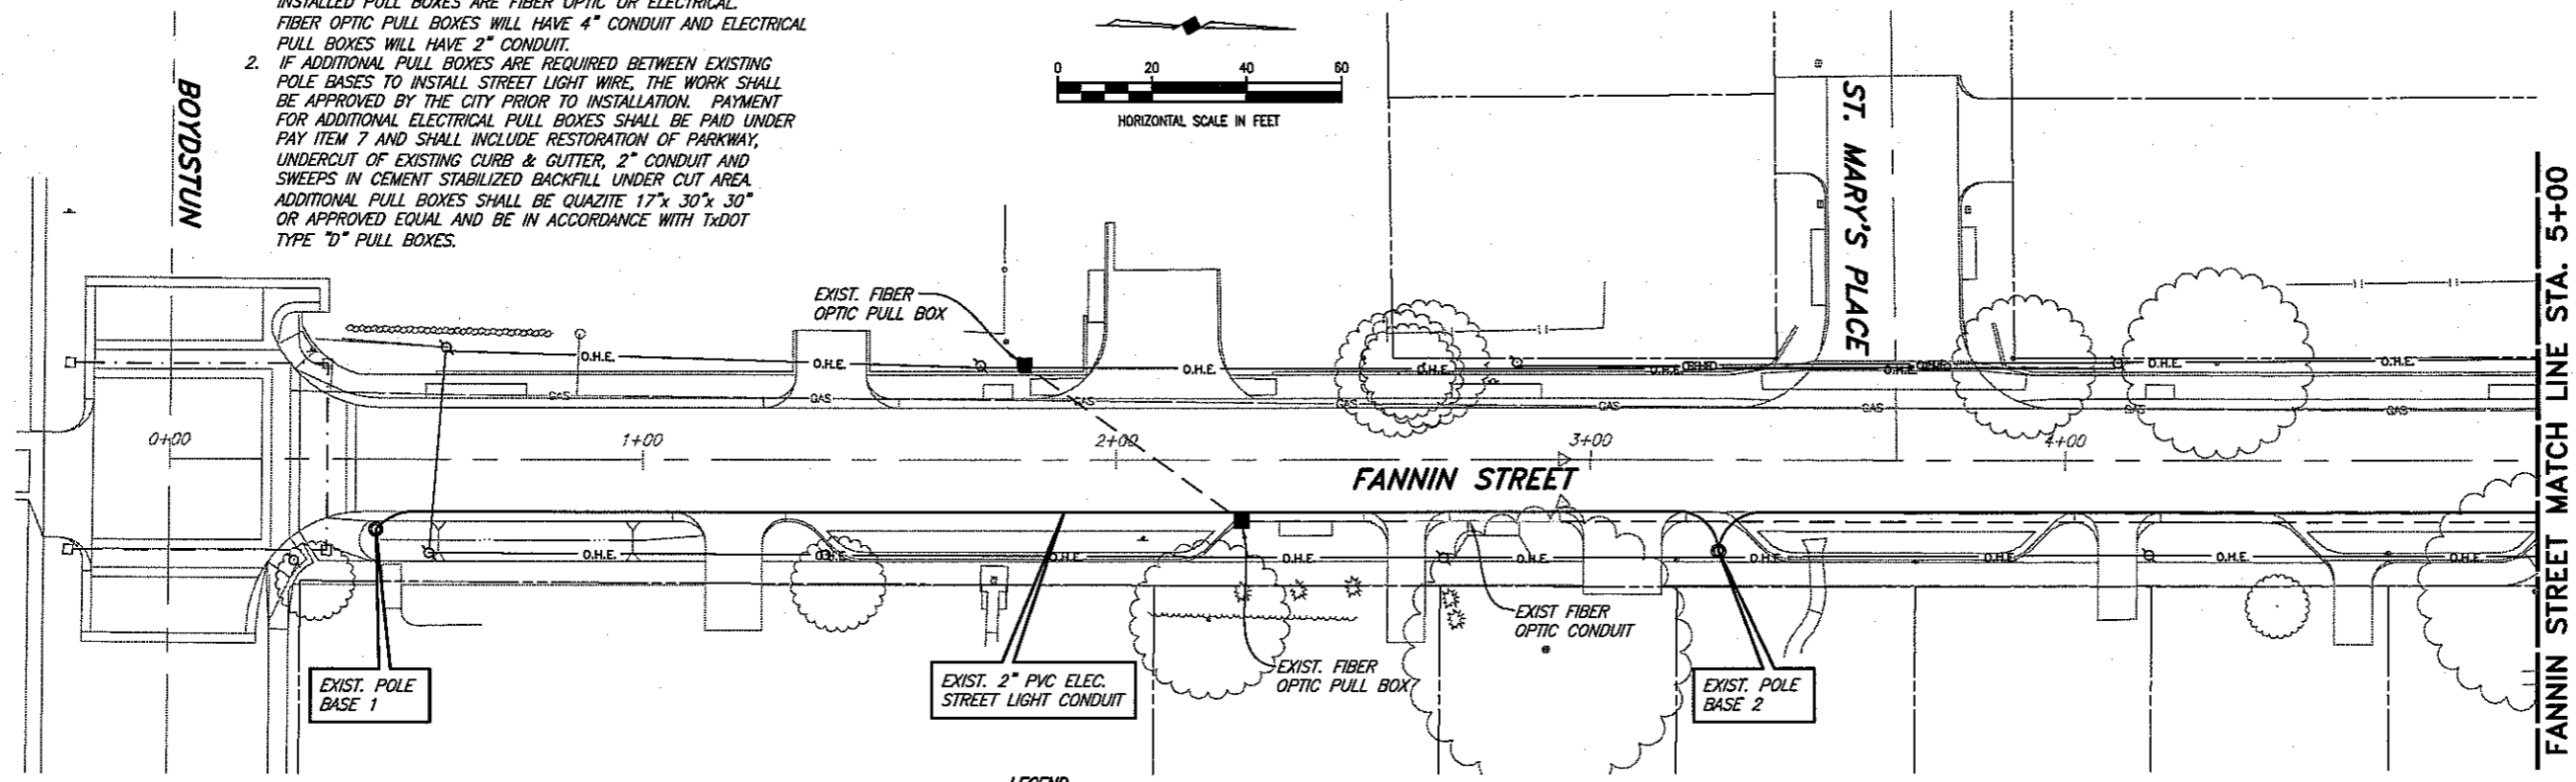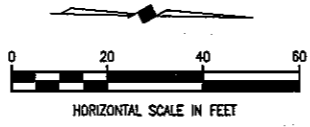


- LEGEND**
- EXISTING PULL BOX FIBER/ELEC.
 - EXISTING STREET LIGHT BASE
 - EXISTING 2" STREET LIGHT CONDUIT
 - - - EXISTING 4" FIBER OPTIC CONDUIT
 - - - EXISTING SIGNAL LIGHT CONDUIT

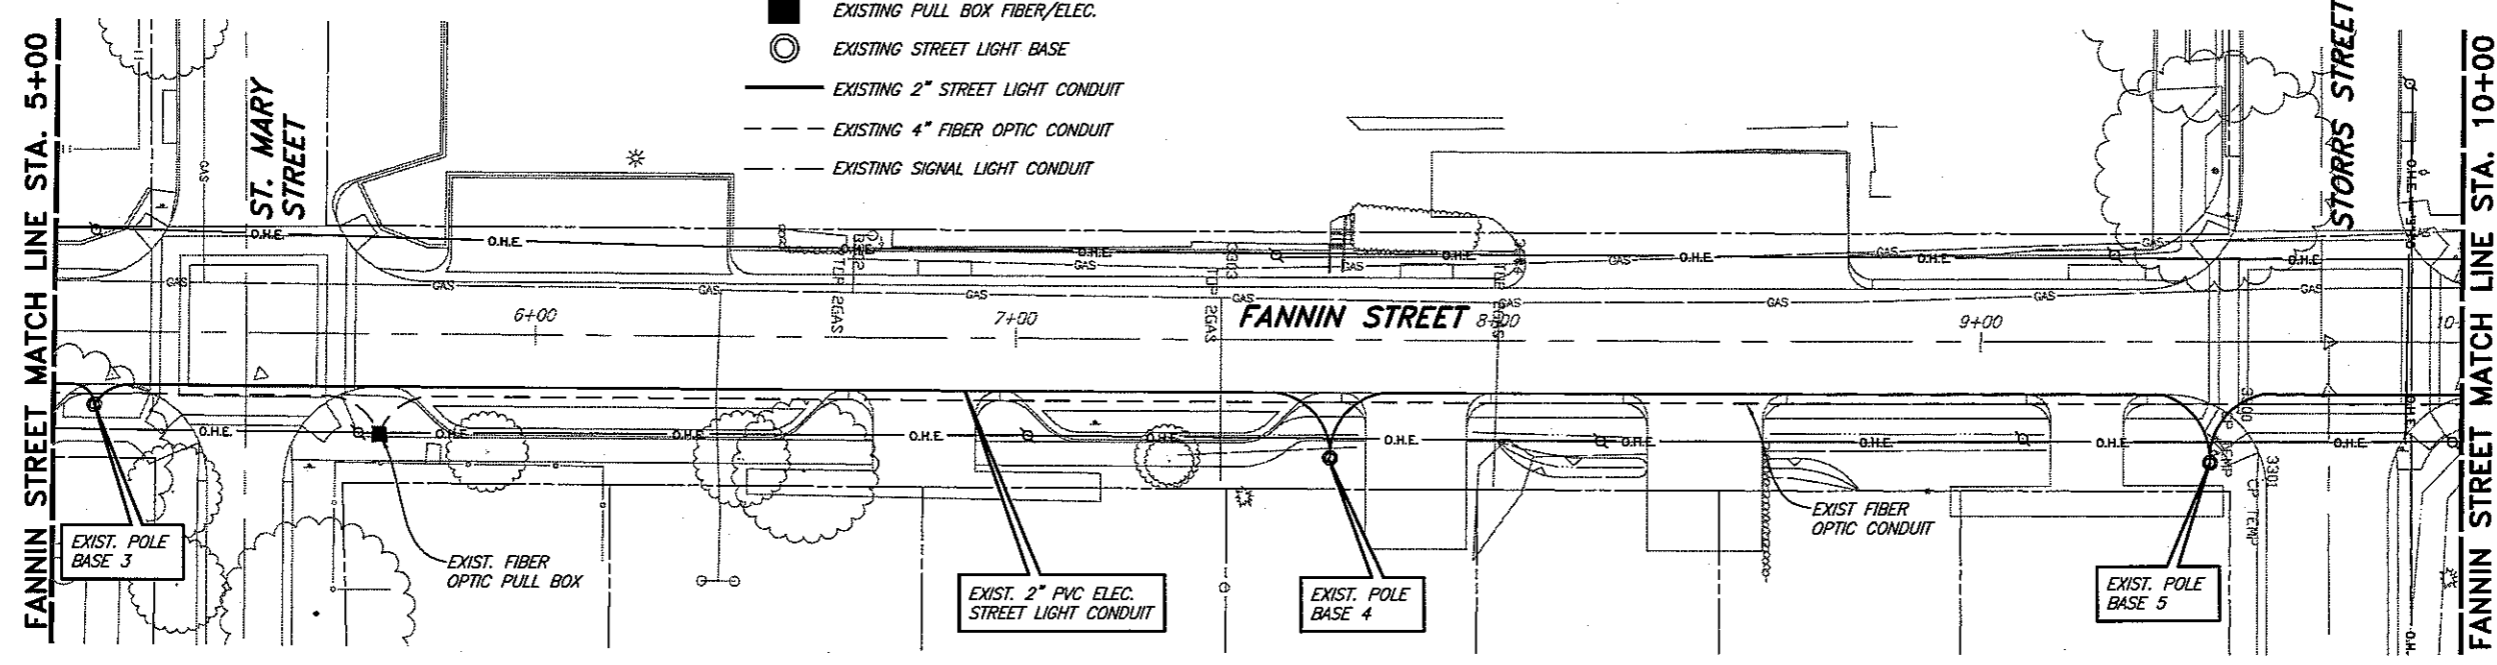

This record drawing is a compilation of the sealed engineering drawing for this project, modified by addenda, change orders and information furnished by the contractor. The information shown on the record drawings that was provided by the contractor or others not associated with the design engineer cannot be verified for accuracy or completeness. This original sealed drawings are on file at the offices of Birkhoff, Hendricks & Conway, L.L.P.
 BY P.A.C. DATE 10/09/09

BIRKHOFF, HENDRICKS & CONWAY, L.L.P.
 PROFESSIONAL ENGINEERS
 Texas Firm F526
 11910 Greenville Ave., Suite 600
 Dallas, Texas 75243 (214) 361-7900

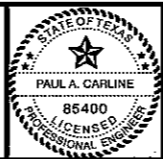



Handwritten signature and initials: 4/7/09

CITY OF ROCKWALL, TEXAS
 FANNIN STREET LIGHTS
 POLE & CONDUIT LOCATIONS

BHC PROJECT NO. 2008-116
 April, 2009
 SHEET NO. C1

These plans and related specifications were prepared for construction of this specific project only. Reuse of these documents is not permitted without written authorization of Birkhoff, Hendricks, & Conway, L.L.P.


These plans and related specifications were prepared for construction of this specific project only. Reuse of these documents is not permitted without written authorization of Birkhoff, Hendricks, & Conway, L.L.P.

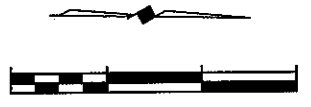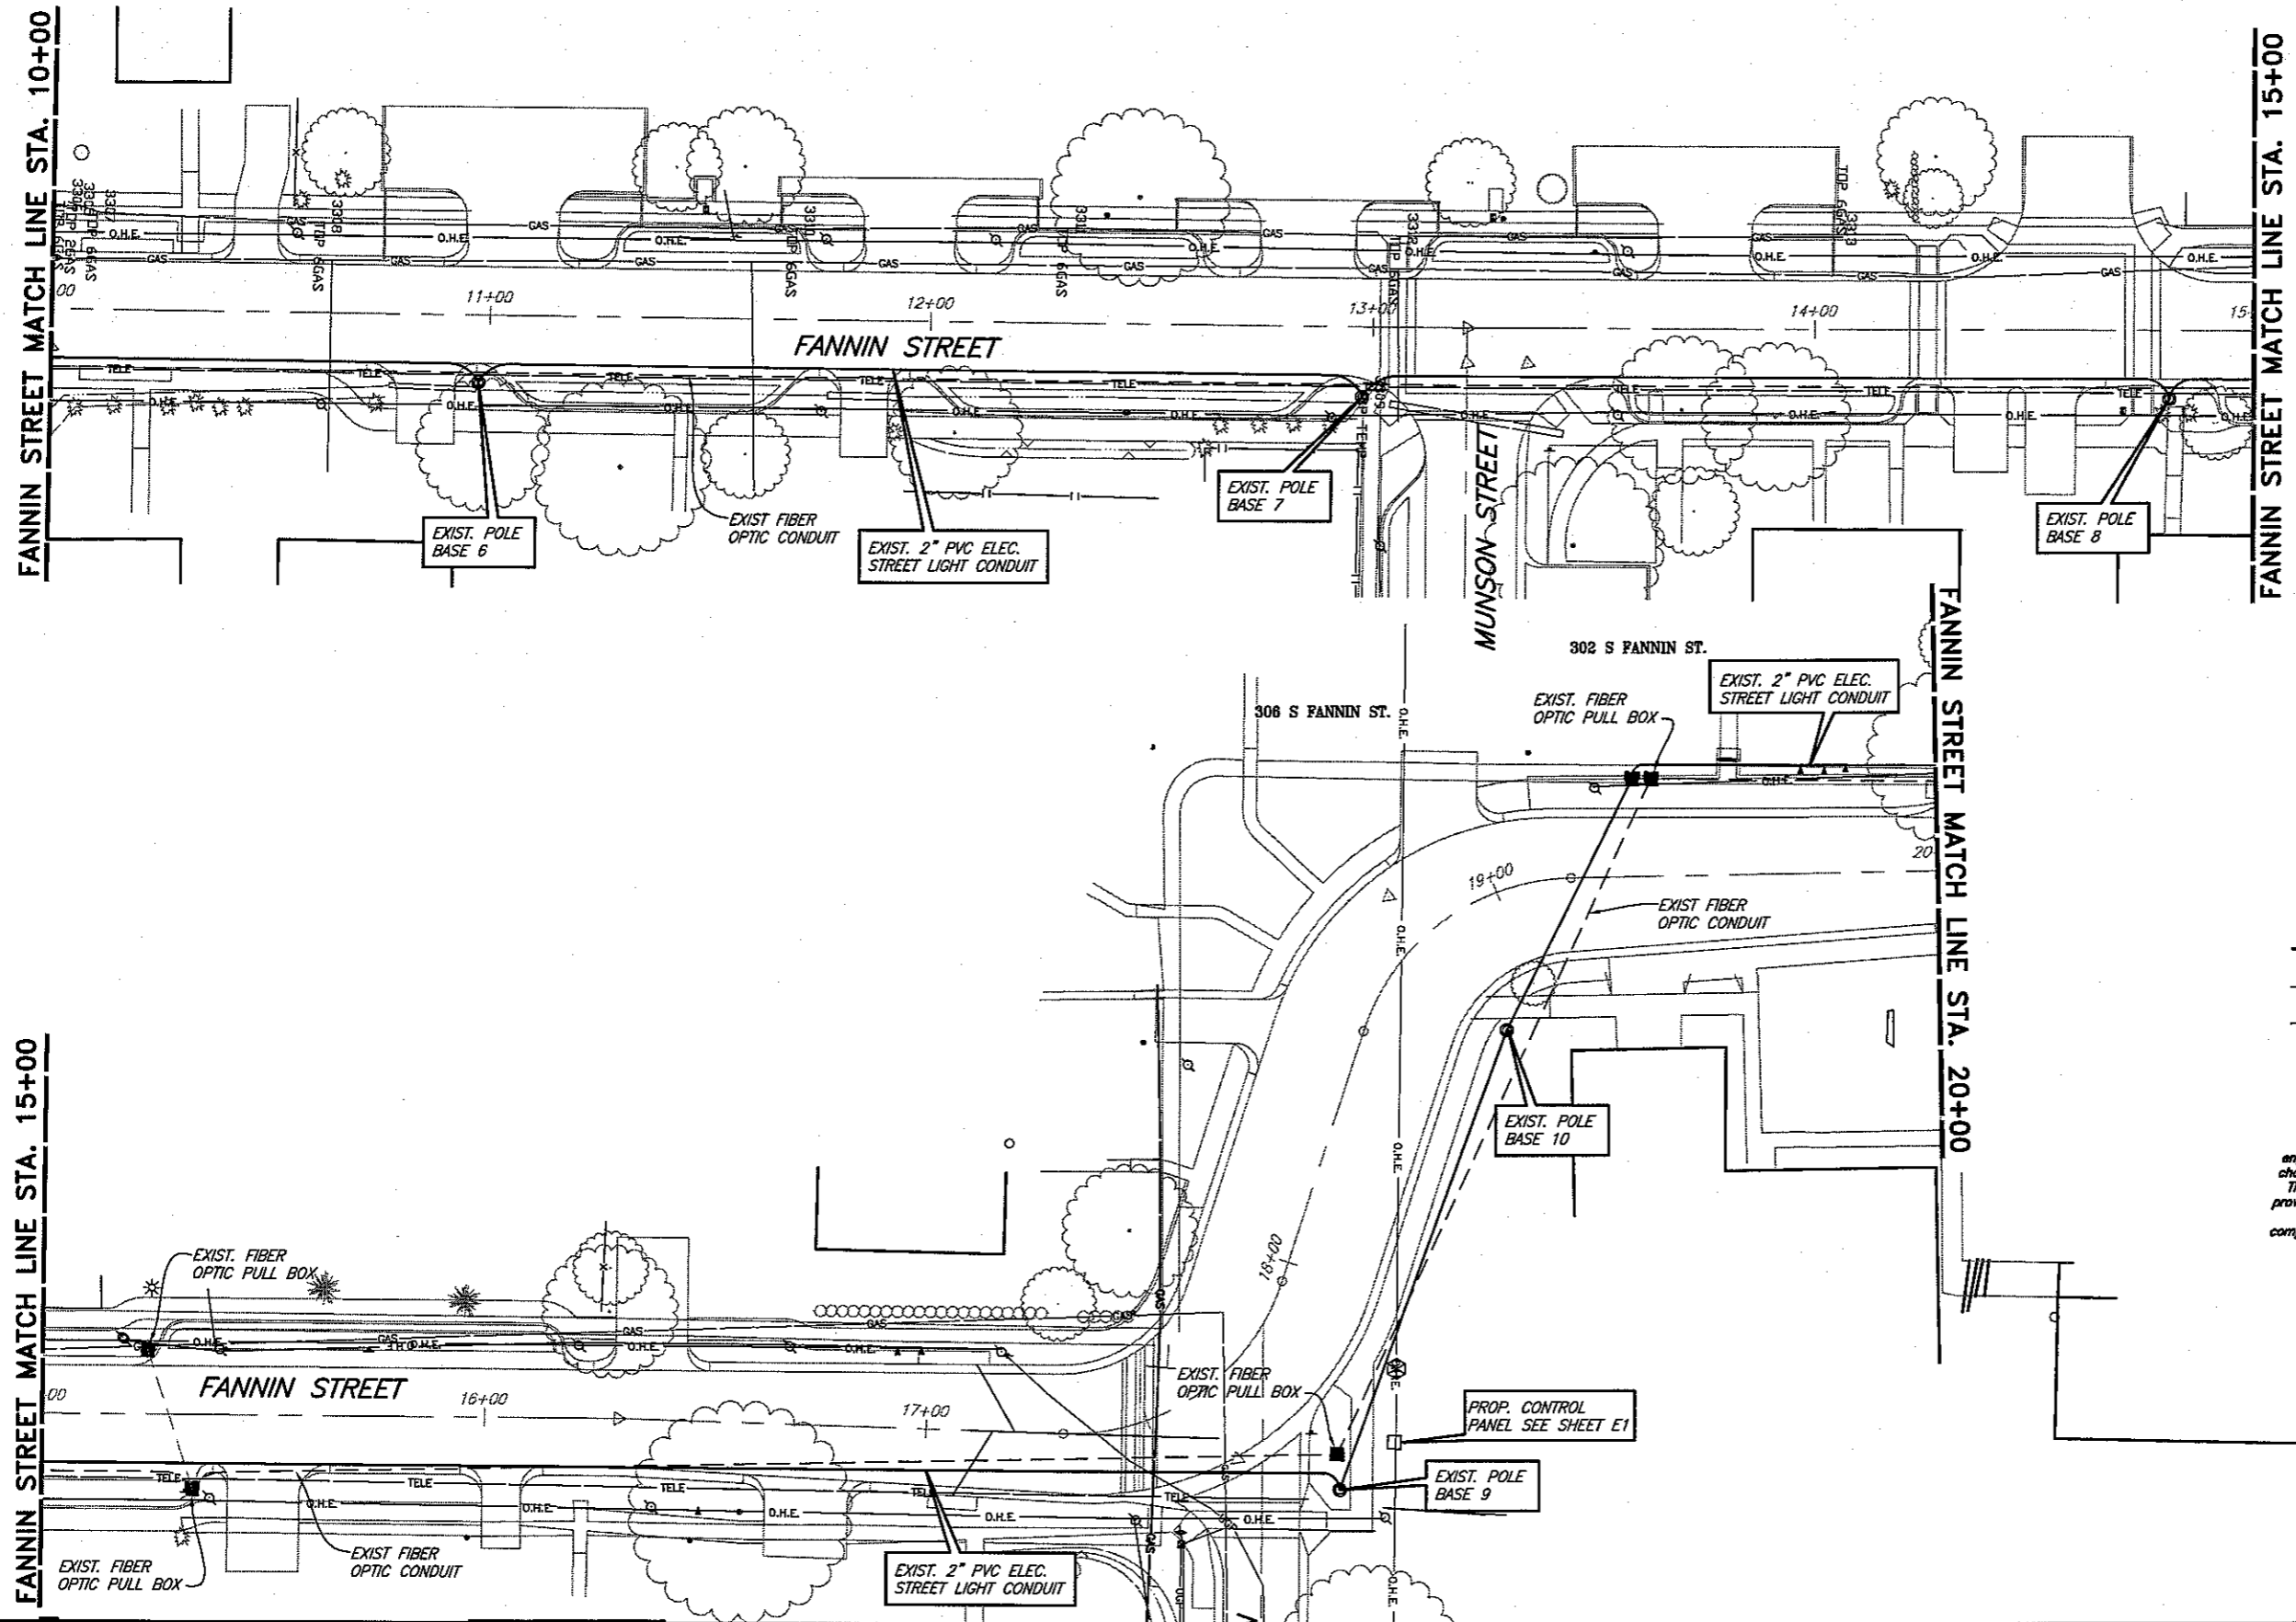

- LEGEND**
- EXISTING PULL BOX FIBER/ELEC.
 - EXISTING STREET LIGHT BASE
 - EXISTING 2" STREET LIGHT CONDUIT
 - - - EXISTING 4" FIBER OPTIC CONDUIT
 - - - EXISTING SIGNAL LIGHT CONDUIT

This record drawing is a compilation of the sealed engineering drawing for this project, modified by addenda, change orders and information furnished by the contractor. The information shown on the record drawings that was provided by the contractor or others not associated with the design engineer cannot be verified for accuracy or completeness. This original sealed drawings are on file at the offices of Birkhoff, Hendricks & Conway, L.L.P.
 BY P.A.C. DATE 10/09/09

BIRKHOFF, HENDRICKS & CONWAY, L.L.P.
 PROFESSIONAL ENGINEERS
 Texas Firm F526
 11910 Greenville Ave., Suite 600
 Dallas, Texas 75243 (214) 361-7900

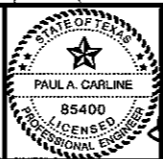


[Handwritten Signature]
 4/17/09

CITY OF ROCKWALL, TEXAS
 FANNIN STREET LIGHTS
 POLE & CONDUIT LOCATIONS


BHC
 PROJECT NO.
 2008-116
 April, 2009

SHEET NO.
C2

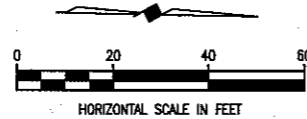

GENERAL NOTES:

- ALL CONSTRUCTION SHALL CONFORM TO THE REQUIREMENTS OF THE "STANDARD SPECIFICATIONS FOR PUBLIC WORKS CONSTRUCTION" BY THE NORTH TEXAS CENTRAL COUNCIL OF GOVERNMENTS, 3rd EDITION AS AMENDED BY THE CITY OF ROCKWALL. THE CONTRACTOR SHALL REFERENCE THE LATEST CITY OF ROCKWALL STANDARD DETAILS PROVIDED IN THE ROCKWALL PUBLIC WORKS DEPARTMENT'S "STANDARDS OF DESIGN AND CONSTRUCTION" MANUAL FOR DETAILS NOT PROVIDED IN THESE PLANS. THE CONTRACTOR SHALL POSSESS ONE SET OF THE NCTCOG STANDARD SPECIFICATIONS AND DETAILS AND THE CITY OF ROCKWALL'S "STANDARDS OF DESIGN AND CONSTRUCTION" MANUAL ON THE PROJECT SITE AT ALL TIMES.
- REASONABLE EFFORT HAS BEEN MADE TO SHOW THE LOCATION OF ALL KNOWN UNDERGROUND UTILITIES AND SERVICE LINES. HOWEVER, THE OWNER & ENGINEER ASSUMES NO RESPONSIBILITY FOR FAILURE TO SHOW ANY OR ALL EXISTING SUBSURFACE UTILITIES OR UTILITY LINES, OR TO SHOW THEM IN THEIR EXACT LOCATION. THE CONTRACTOR SHALL BE RESPONSIBLE FOR THE PROTECTION OF ALL EXISTING UTILITIES, SERVICE LINES OR THE LIKE, WHICH ARE CROSSED OR EXPOSED BY THE CONSTRUCTION OPERATION.
- THE CONTRACTOR SHALL BE RESPONSIBLE FOR THE PROTECTION OF ALL EXISTING SERVICE LINES CROSSED OR EXPOSED BY CONSTRUCTION OPERATIONS. WHERE EXISTING SERVICE LINES ARE CUT, BROKEN OR DAMAGED, THE CONTRACTOR SHALL IMMEDIATELY REPLACE THE SERVICE LINE WITH SAME TYPE OF ORIGINAL CONSTRUCTION OR BETTER.
- CONTRACTOR SHALL SUPPORT UTILITIES WHERE CROSSING WITH PROPOSED STORM SEWERS, WATER LINES AND SANITARY SEWERS. METHOD OF SUPPORT SHALL BE PROVIDED TO THE OWNER 24 HOURS PRIOR TO CROSSING.
- THE LOCATION OF ALL ATMOS GAS LINES, SBC AND TXU ELETRIC UNDERGROUND PHONE LINES IN THESE PLANS ARE APPROXIMATE. THE CONTRACTOR SHALL CONTACT ATMOS, TXU AND SBC TO VERIFY LOCATION AND DEPTH OF ALL EXISTING GAS, ELETRIC AND PHONE LINES PRIOR TO CONSTRUCTION.
- THE CONTRACTOR SHALL REPLACE ALL SHRUBS, PLANTS, TREES ETC. THAT ARE REMOVED FOR CONVENIENCE OF CONSTRUCTION AT HIS EXPENSE. NEW SHRUBS, PLANTS, TREES, ETC. SHALL BE EQUAL TO OR BETTER THAN THE EXISTING ONES OR MEET THE NEEDS AND APPROVAL OF THE PROPERTY OWNER AND THE CITY.
- THE CONTRACTOR SHALL PROTECT ALL UNDERGROUND SPRINKLER SYSTEMS. AN IRRIGATOR LICENSED IN THE STATE OF TEXAS SHALL REPAIR ALL DAMAGE CAUSED BY CONSTRUCTION WITHIN 48 HOURS. ALL COSTS SHALL BE BORNE BY THE CONTRACTOR.
- THE CONTRACTOR SHALL NOT DISPOSE OF WASTE AND ANY MATERIALS INTO STREAMS OR WATERWAYS. THE CONTRACTOR SHALL SECURE ALL EXCAVATION AT THE END OF EACH DAY AND DISPOSE OF ALL EXCESS MATERIALS. DISPOSAL SITE SHALL BE DOCUMENTED AND PROVIDED TO THE CITY.
- CONTRACTOR SHALL GRADE GROUND DISTURBED BY CONSTRUCTION TO PREVENT PONDING OF STORM WATER RUNOFF. TOPSOIL SHALL BE REPLACED TO A MINIMUM DEPTH OF TOPSOIL SHALL BE STOCKPILED AND REPLACED TO A MINIMUM DEPTH OF 6-INCHES AND DISC HARROWED TO A MINIMUM DEPTH OF 4-INCHES (NO PAY ITEM). CONTRACTOR SHALL REPLACE GRASS AREAS DISTURBED BY CONSTRUCTION ACTIVITIES WITH SOLID SOD. SODDED AREAS SHALL BE WATERED AND MAINTAINED FOR A PERIOD OF NO LESS THAN 72 HOURS. EACH DAY THE CONTRACTOR SHALL WATER THE AREAS UNTIL THE PROPERTY OWNER ASSUMES RESPONSIBILITY OF SODDED AREAS. THE CONTRACTOR SHALL NOTIFY THE PROPERTY OWNER IN WRITING WITH A COPY SENT TO THE CITY OF ROCKWALL THAT THEY ARE TO ASSUME RESPONSIBILITY OF MAINTENANCE OF THE SODDED AREAS AT A SPECIFIED TIME AND DATE.
- CONTRACTOR SHALL REPLACE ANY TREES REMOVED OR DESTROYED THAT ARE NOT SHOWN IN THESE PLANS TO BE REMOVED OR SHALL PAY FAIR MARKET VALUE TO OWNER AS DETERMINED BY THE OWNER.
- THE CONTRACTOR SHALL FURNISH, INSTALL, MAINTAIN AND REMOVE ALL NECESSARY TRAFFIC CONTROL DEVICES IN CONFORMANCE WITH THE TEXAS MANUAL ON UNIFORM TRAFFIC CONTROL DEVICES (PART IV).
- THE CONTRACTOR SHALL PROVIDE ACCESS AT ALL TIMES DURING EACH PHASE OF CONSTRUCTION TO ALL LOCAL RESIDENTS, BUSINESSES, MAIL SERVICE AND TRASH PICK UP.
- THE CONTRACTOR SHALL PROVIDE 4 INCHES OF TOP SOIL IN ALL PARKWAYS THAT ARE TO BE SODDED. TOP SOIL SHALL BE APPROVED BY THE CITY IN WRITING. TOPSOIL SHALL BE SUBSIDIARY TO PLACEMENT OF GRASS.
- CONTRACTOR SHALL CONTACT THE CITY OF ROCKWALL TO LOCATE ALL WATER AND SANITARY SEWER LINES AND SERVICES PRIOR TO CONSTRUCTION.
- CONTRACTOR SHALL BE RESPONSIBLE FOR ADJUSTING ANCHOR BOLTS ON EXISTING POLE BASES AND PROVIDING ALL REQUIRED HARDWARE TO SECURE THE PRE-PURCHASED POLES TO THE EXISTING POLE BASES. (NO PAY ITEMS)

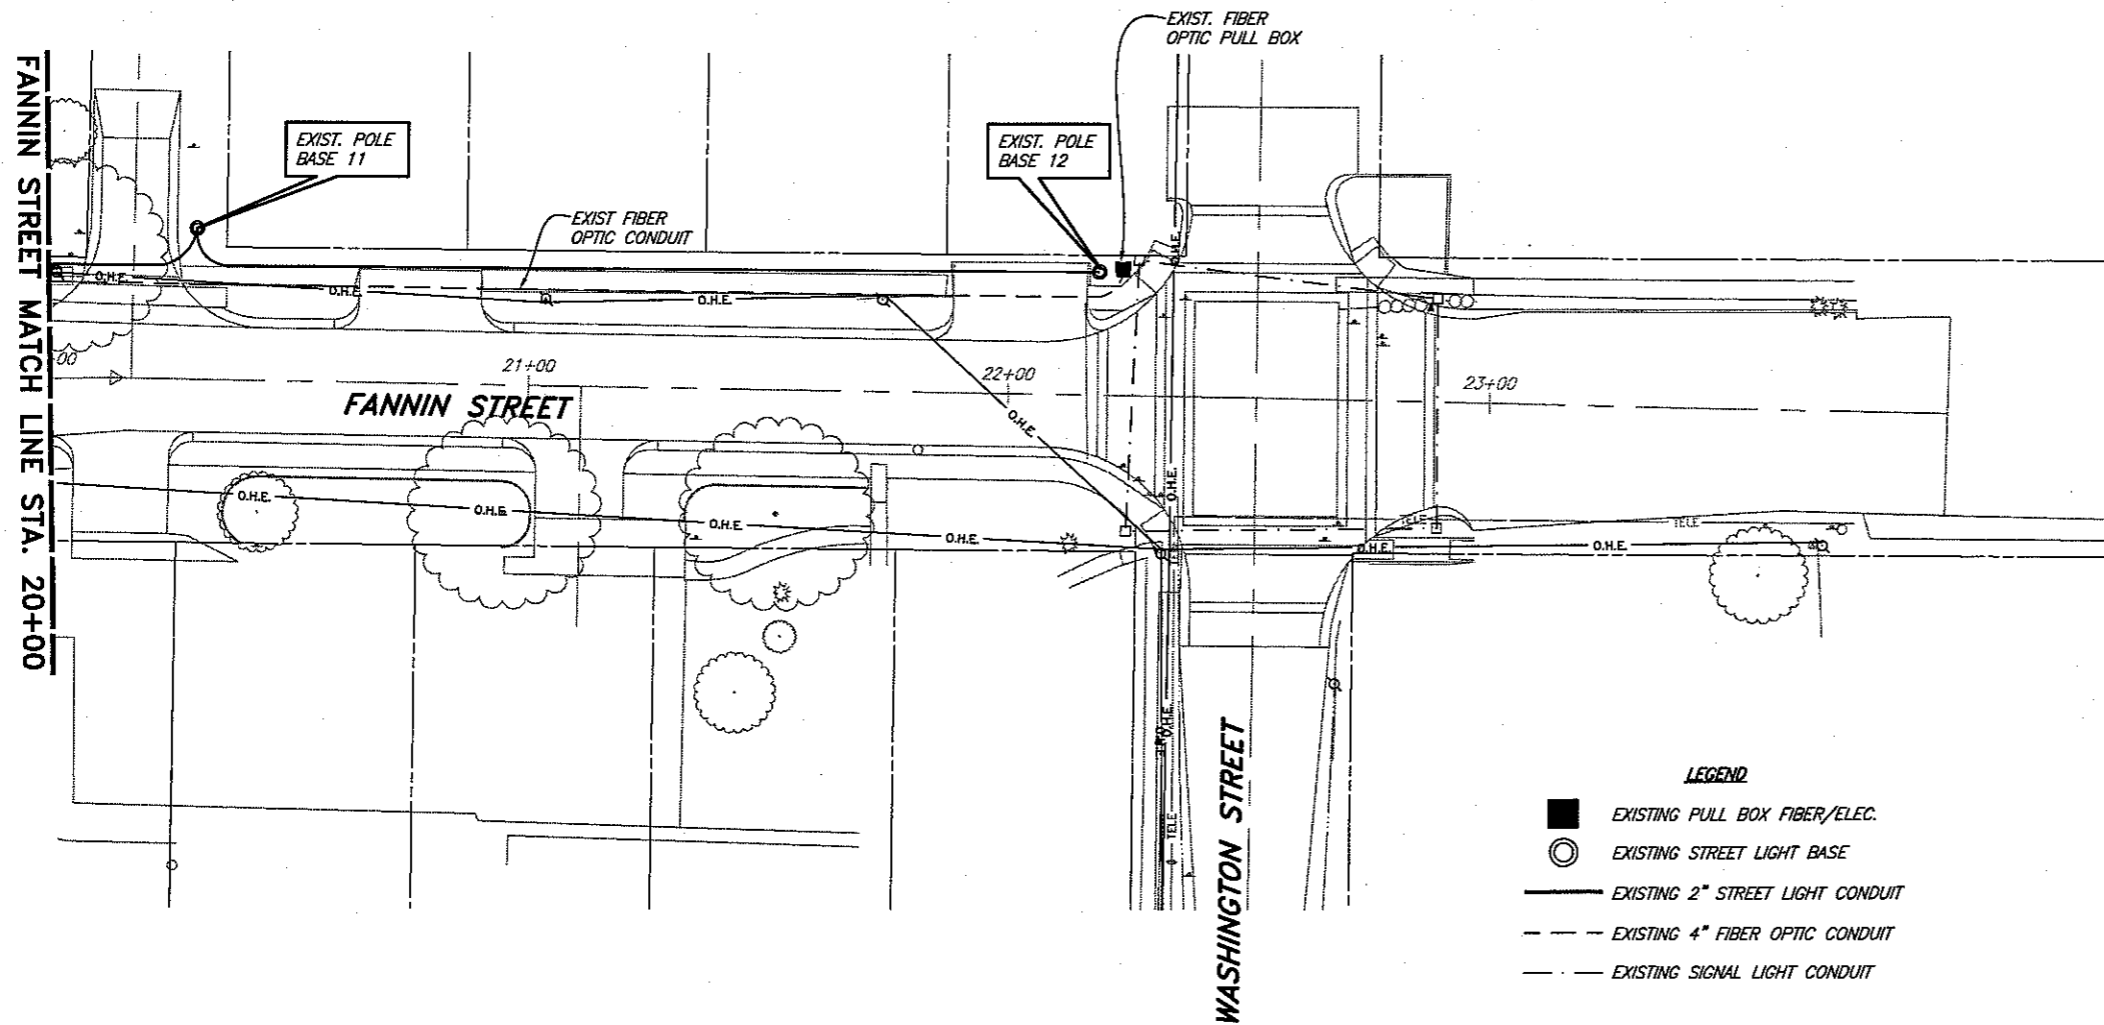

LEGEND


- EXISTING PULL BOX FIBER/ELEC.
- EXISTING STREET LIGHT BASE
- EXISTING 2" STREET LIGHT CONDUIT
- - - EXISTING 4" FIBER OPTIC CONDUIT
- - - EXISTING SIGNAL LIGHT CONDUIT

NOTE:
EXISTING POLE BASE 12 HAD DAMAGED MOUNTING BOLTS. THESE BOLTS WERE REMOVED AND REPLACED WITH NEW BOLTS DRILLED & EPOXIED INTO POLE BASE.

This record drawing is a compilation of the sealed engineering drawing for this project; modified by addenda, change orders and information furnished by the contractor. The information shown on the record drawings that was provided by the contractor or others not associated with the design engineer cannot be verified for accuracy or completeness. This original sealed drawings are on file at the offices of Birkhoff, Hendricks & Conway, L.L.P.
BY P.A.C. DATE 10/09/09

These plans and related specifications were prepared for construction of this specific project only. Reuse of these documents is not permitted without written authorization of Birkhoff, Hendricks, & Conway, L.L.P.

BIRKHOFF, HENDRICKS & CONWAY, L.L.P.
PROFESSIONAL ENGINEERS
Texas Firm F526
11910 Greenville Ave., Suite 600
Dallas, Texas 75243 (214) 361-7900

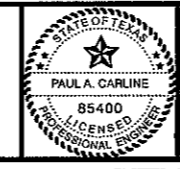



[Signature]
10/9/09

CITY OF ROCKWALL, TEXAS
FANNIN STREET LIGHTS
POLE & CONDUIT LOCATIONS

BHC
PROJECT NO.
2008-116
April, 2009

SHEET NO.
C3

These plans and related specifications were prepared for construction of this specific project only. Reuse of these documents is not permitted without written authorization of Birkhoff, Hendricks, & Conway, L.L.P.

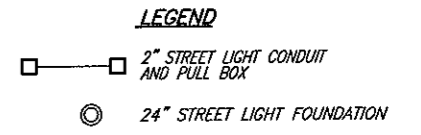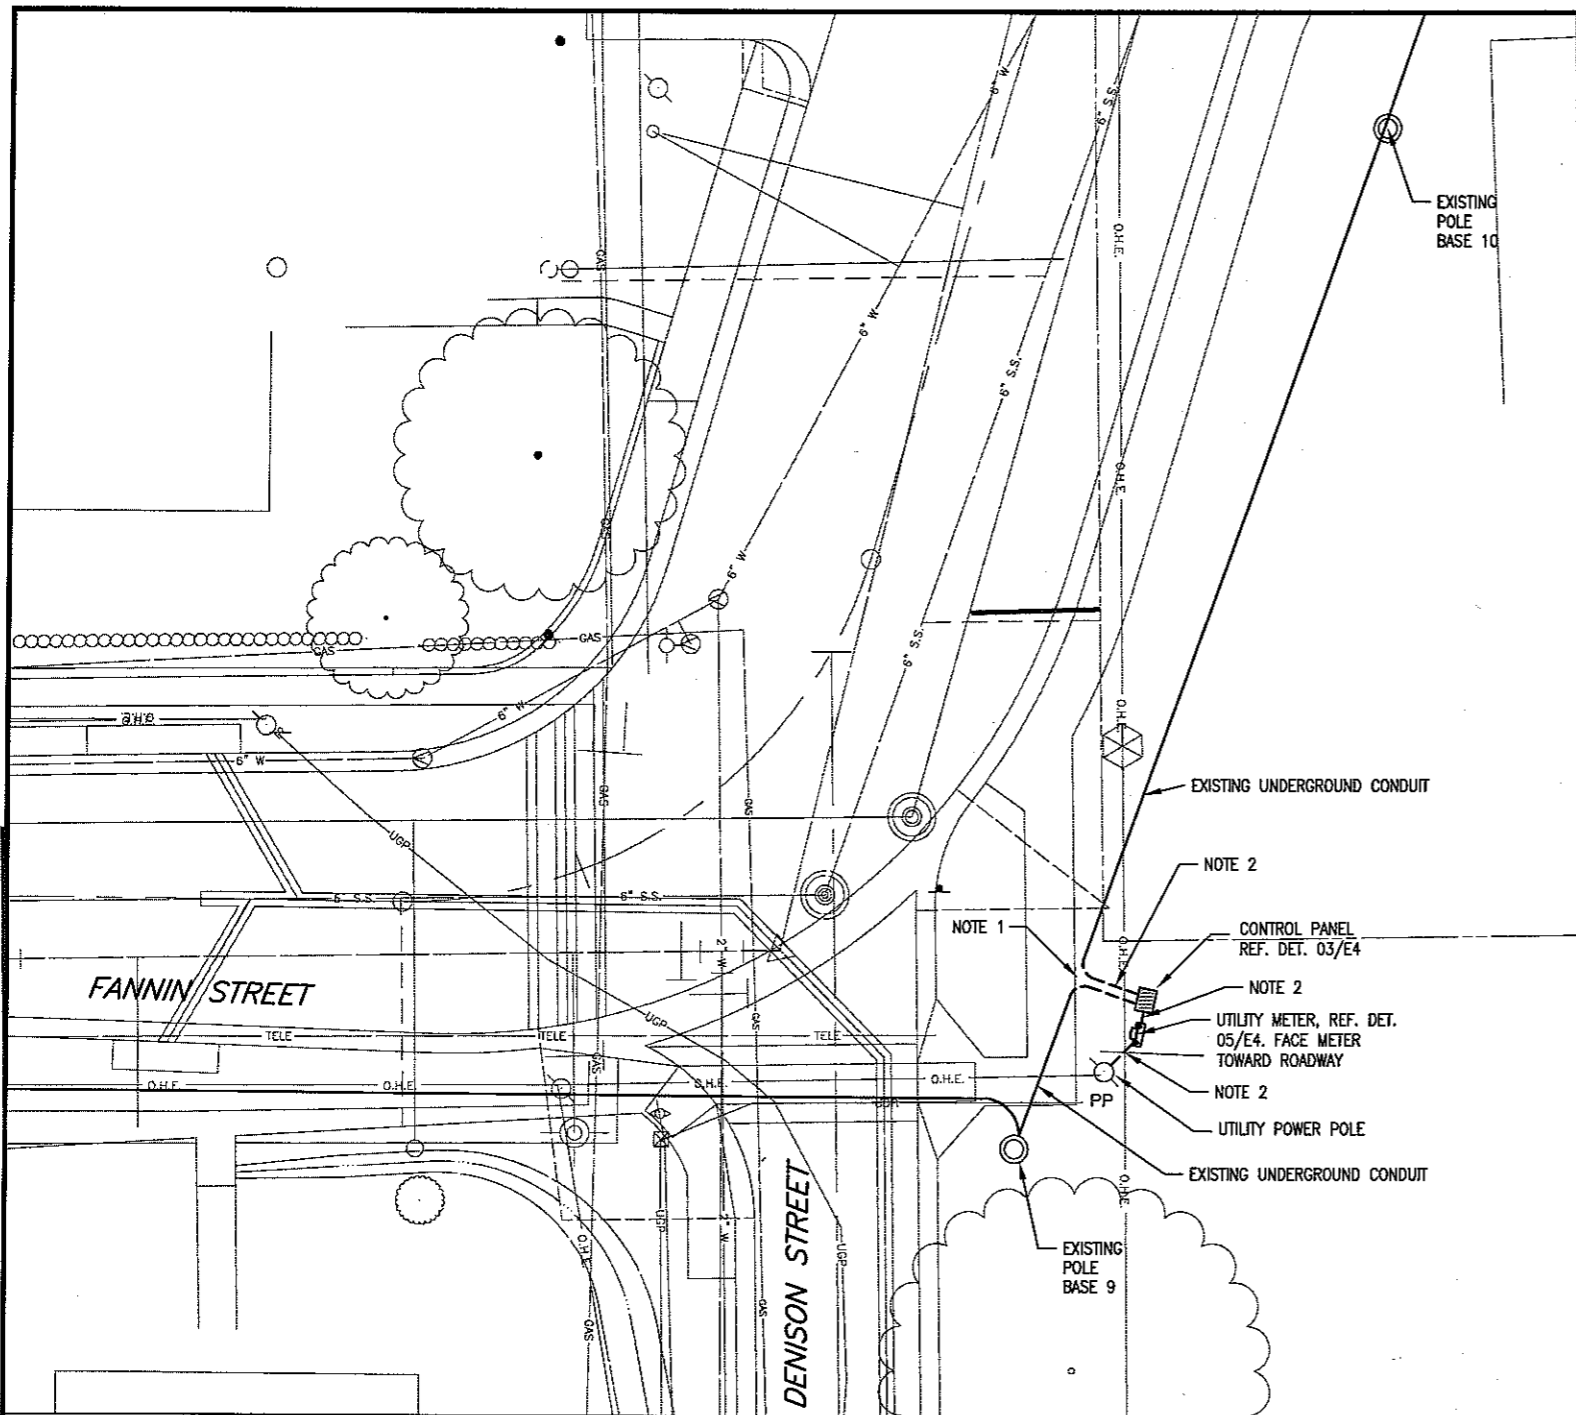

NOTE 1

NOTE 2

CONTROL PANEL
REF. DET. 03/E4

NOTE 2


UTILITY METER, REF. DET.
05/E4. FACE METER
TOWARD ROADWAY

NOTE 2

UTILITY POWER POLE

EXISTING UNDERGROUND CONDUIT

- NOTES:**
1. INTERCEPT EXISTING UNDERGROUND CONDUIT AND PROVIDE NEW CONDUIT TO CONTROL PANEL AS SHOWN. REF. CONDUIT AND CABLE SCHEDULE. REPAIR DAMAGE TO EXISTING SIDEWALK AND CURB.
 2. NEW UNDERGROUND CONDUIT & WIRING. REF. CONDUIT & CABLE SCHEDULE.

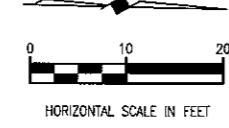

This record drawing is a compilation of the sealed engineering drawing for this project, modified by addenda, change orders and information furnished by the contractor. The information shown on the record drawings that was provided by the contractor or others not associated with the design engineer cannot be verified for accuracy or completeness. This original sealed drawings are on file at the offices of Birkhoff, Hendricks & Conway, L.L.P.

BY P.A.C. DATE 10/09/09

BIRKHOFF, HENDRICKS & CONWAY, L.L.P.
CONSULTING ENGINEERS
11910 Greenville Ave., Suite 600
Dallas, Texas
(214) 361-7900



THESE DOCUMENTS ARE FOR BIDDING, CONSTRUCTION, AND PERMIT PURPOSES.

DATE: 4-7-09

McCREARY & ASSOCIATES, INC.
Consulting Engineers
Dallas, Texas FIRM No. E-338



CITY OF ROCKWALL, TEXAS
FANNIN STREET

ELECTRICAL
SITE PLAN

BHC
PROJECT NO.
2008-116

April, 2009


SHEET NO.
E1

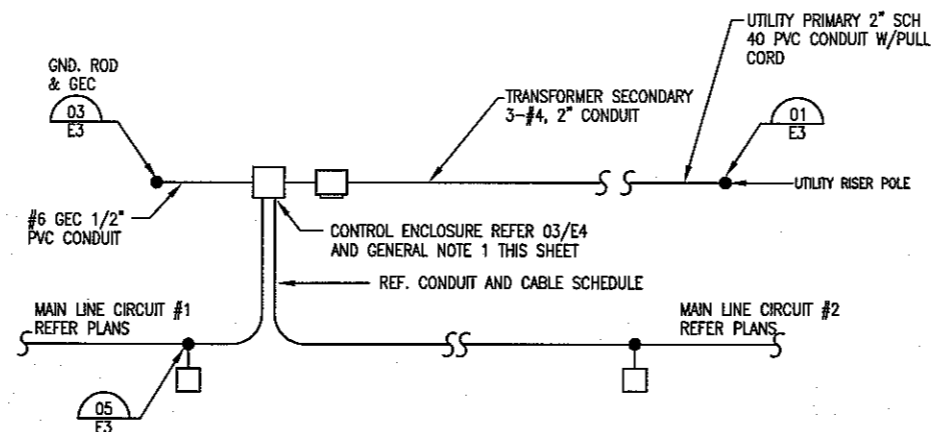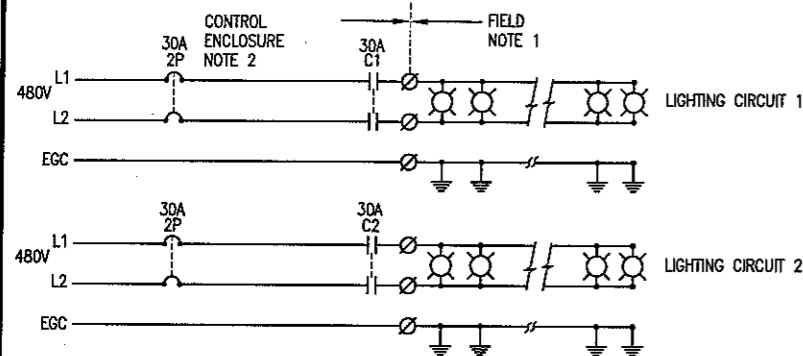

PLAN-TYPICAL STREET LIGHT POWER & CONTROL
NOT TO SCALE


GENERAL NOTES

- ALUMINUM CONTROL ENCLOSURE SPECIFICATIONS AS FOLLOWS:
 - UL508A LABEL, SERVICE ENTRANCE CERTIFIED.
 - ALUMINUM NEMA 3R FREE STANDING, UL LISTED.
 - PHOTO CELL MOUNTED INSIDE CONTROL CABINET.
 - PROVIDE TWO POLE, 650 VOLT LIGHTNING ARRESTOR.
 - PANEL BY ELECTROL SYSTEMS, INC., SAN ANTONIO OR APPROVED EQUAL.
- THE CONTRACTOR SHALL MOVE AND/OR ADJUST OR SHIELD THE PHOTOCELL FROM STRAY OR AMBIENT NIGHTTIME LIGHT OR SHALL MAKE ANY OTHER ADJUSTMENTS REQUIRED FOR PROPER OPERATION. UNLESS OTHERWISE SHOWN ON THE PLANS, THE PHOTOCELL SHALL TURN ON THE ILLUMINATION SYSTEM AT 1.0 ±0.5 FOOTCANDLE AND TURN OFF THE ILLUMINATION SYSTEM AT TWO FOOTCANDLES HIGHER THAN TURN ON.

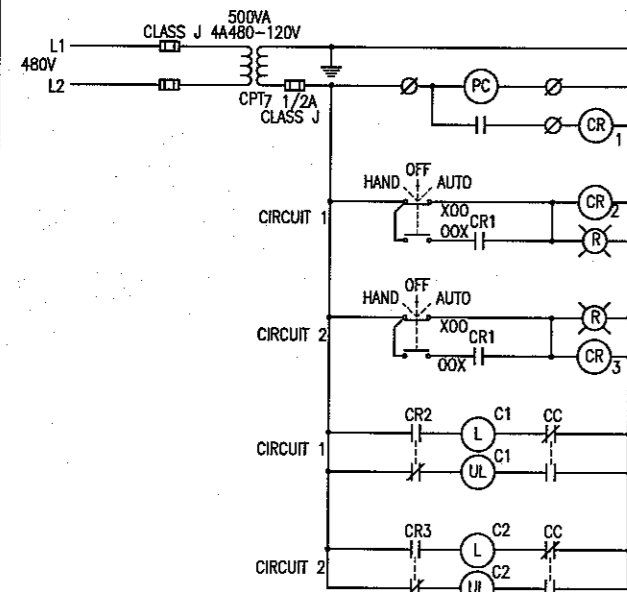

- NOTES:
- REFER TO PLANS FOR FIELD WIRE SIZES.
 - REFER TO ONE LINE DIAGRAM.

SCHEMATIC-DISTRIBUTION AND CONTROL ENCLOSURE
NOT TO SCALE

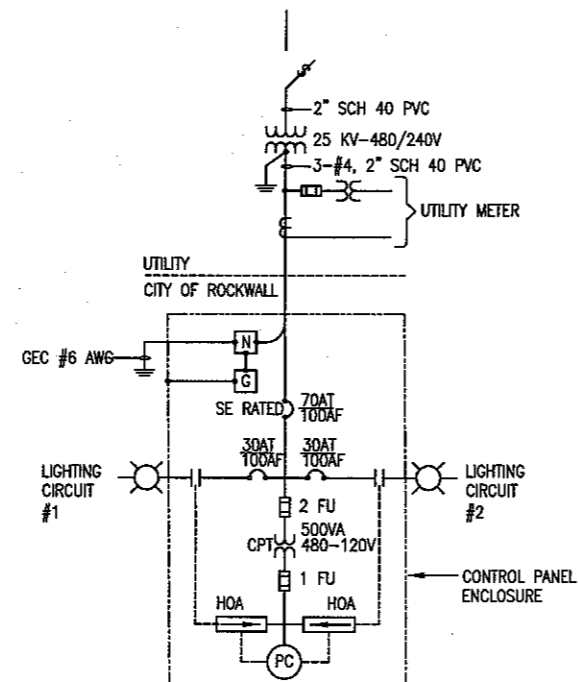

ONELINE DIAGRAM
NOT TO SCALE

TAG	WIRING	CONDUIT	SOURCE	DESTINATION	LENGTH IN FT.	COMMENTS
1000	3#4, #4G	2"	UTILITY XFMR	TRANSOCKET		
1000A	3#4, #4G	2"	TRANSOCKET	CONTROLLER ENCLOSURE		
1001	2#8, #8G	2"	POLE BASE 1	POLE BASE 2	305	
1002	2#8, #8G	2"	POLE BASE 2	POLE BASE 3	210	
1003	2#8, #8G	2"	POLE BASE 3	POLE BASE 4	285	
1004	2#8, #8G	2"	POLE BASE 4	POLE BASE 5	215	
1005	2#8, #8G	2"	POLE BASE 5	POLE BASE 6	166	
1006	2#8, #8G	2"	POLE BASE 6	POLE BASE 7	220	
1007	2#8, #8G	2"	POLE BASE 7	POLE BASE 8	200	
1008	2#8, #8G	2"	POLE BASE 8	POLE BASE 9	330	
1009	2#8, #8G	2"	POLE BASE 9	CONTROLLER ENCLOSURE	35	
1010	2#8, #8G	2"	CONTROLLER ENCLOSURE	POLE BASE 10	115	
1011	2#8, #8G	2"	POLE BASE 10	POLE BASE 11	200	
1012	2#8, #8G	2"	POLE BASE 11	POLE BASE 12	230	

- NOTES:
- DISTANCES INDICATED REFLECT APPROXIMATE DISTANCE FROM POLE BASE TO POLE BASE. WIRING FROM POLE BASE TO FIXTURE IS NOT INCLUDED IN THIS TABLE.
 - CONDUIT IS EXISTING UNLESS OTHERWISE NOTED ON SHEET E1. ALL WIRE AND CABLE SHALL BE FURNISHED UNDER THIS CONTRACT. REFER TO CIVIL DRAWINGS C1, C2 & C3 FOR LOCATIONS OF POLE BASES AND EXISTING CONDUIT.

This record drawing is a compilation of the sealed engineering drawing for this project, modified by addenda, change orders and information furnished by the contractor. The information shown on the record drawings that was provided by the contractor or others not associated with the design engineer cannot be verified for accuracy or completeness. This original sealed drawings are on file at the offices of Birkhoff, Hendricks & Conway, L.L.P.
BY P.A.C. DATE 10/09/09

BIRKHOFF, HENDRICKS & CONWAY, L.L.P.
CONSULTING ENGINEERS
11910 Greenville Ave., Suite 600
Dallas, Texas
(214) 361-7900




THESE DOCUMENTS ARE FOR BIDDING, CONSTRUCTION, AND PERMIT PURPOSES.
DATE: 4-7-09
McCreech & Associates, Inc.
Consulting Engineers
Dallas, Texas FIRM No. F-338


CITY OF ROCKWALL, TEXAS
FANNIN STREET
ELECTRICAL
ONE LINE DIAGRAM & SCHEMATICS

BHC
PROJECT NO.
2008-116
SHEET NO.
E2
April, 2009

These plans and related specifications were prepared for construction of this specific project only. Reuse of these documents is not permitted without written authorization of Birkhoff, Hendricks, & Conway, L.L.P.

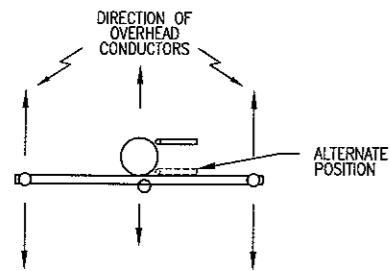


TOP VIEW

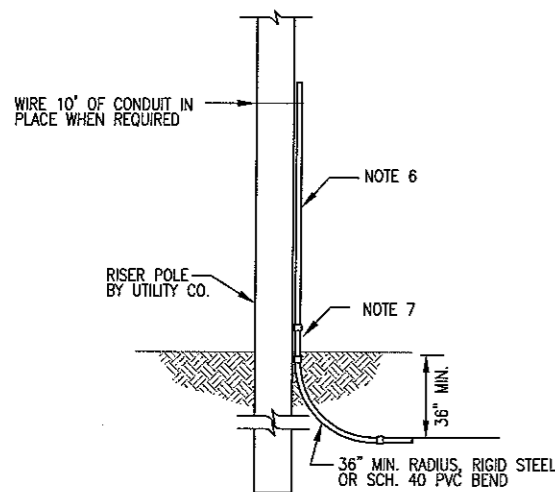

- NOTES:**
- CONTACT COMPANY REPRESENTATIVE FOR ROUTING OF CONDUIT LINE AND SIZE OF CONDUIT.
 - FOR INSTALLATIONS REQUIRING MORE THAN ONE RISER ON POLE, CONTACT COMPANY REPRESENTATIVE.
 - LIMIT RACEWAY TO THREE 90° BENDS. IF MORE THAN THREE 90° BENDS ARE REQUIRED, CONTACT COMPANY REPRESENTATIVE.
 - LIMIT DISTANCE BETWEEN 90° BENDS TO FIVE FEET WHEREVER POSSIBLE.
 - ALL HORIZONTAL AND VERTICAL BENDS TO BE LONG RADIUS.
 - EXTEND BEND WITH 10 FEET OF RIGID STEEL OR SCHEDULE 80 PVC CONDUIT FOR ALIGNMENT OF BEND.
 - INSTALL NIPPLE WHEN REQUIRED TO EXTEND BEND MIN. 8" ABOVE FINISHED GRADE.

01 TERMINATION OF SECONDARY CONDUIT AT RISER POLE
NOT TO SCALE

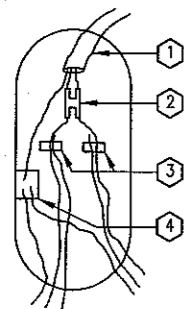

05 POLE HANDHOLE DETAIL
NOT TO SCALE



- XX NOTES**
- SO CABLE-3C#12
 - BUSSMAN DOUBLE POLE FUSE HOLDER "HEY" SERIES
HEY AC FOR #4 CONDUCTORS
HEY AD FOR #2 CONDUCTORS
EACH WITH 1A0512 HOLDER
PROVIDE 2-10A KTK-R FUSES FOR DUAL FIXTURES
PROVIDE 2-5A KTK-R FUSES FOR SINGLE FIXTURES
 - SPLIT BOLT-BURNNDY TYPE KS23 & SC2 SERVIC COVER (NOT SHOWN)
 - POLE GROUND LUG

- NOTES:**
- TRENCH ALIGNMENT SHALL BE AS STRAIGHT AS CONDITIONS PERMIT. ANY DEVIATIONS FROM PLANNED ALIGNMENT SHALL HAVE PRIOR APPROVAL BY THE PROJECT ENGINEER/INSPECTOR. ALL TRENCH CUTS SHALL BE IN ACCORDANCE WITH EXISTING SAFETY REGULATIONS IN EFFECT.
 - TRENCH BOTTOM SHALL BE UNDISTURBED, TAMPED OR RELATIVELY SMOOTH EARTH. WHERE EXCAVATION IS IN ROCK, THE CONDUIT SHALL BE LAID ON A LAYER OF CLEAN BACKFILL.
 - ALL BACKFILL SHOULD BE FREE OF DEBRIS OR OTHER MATERIAL THAT MAY DAMAGE THE CONDUIT SYSTEM OR CAUSE SETTLING. THE MATERIAL SHALL FILL THE VOIDS AROUND THE CONDUIT TO PREVENT HOT SPOTS & SETTLING.
 - BACKFILL SHALL BE ADEQUATELY COMPACTED. BACKFILL NOT UNDER PAVEMENT SHALL BE COMPACTED TO THE DENSITY OF THE SURROUNDING UNDISTURBED SOIL. BACKFILL UNDER PAVEMENT SHALL BE COMPACTED TO NOT LESS THAN 95% OF THE DENSITY OF UNDISTURBED SOIL AS DETERMINED BY ASTM DESIGNATION D-698.
 - EACH CONDUIT RUN SHALL BE CHECKED BY PULLING A MANDREL THROUGH THE ENTIRE LENGTH. A 1/8" NYLON PULLING CORD SHALL BE LEFT IN EACH CONDUIT. CONDUIT SHALL BE PLUGGED AT BOTH ENDS.
 - SUPPLY AND COMMUNICATION CONDUIT SEPARATIONS:
CONDUIT SYSTEMS TO BE OCCUPIED BY COMMUNICATIONS CONDUCTORS SHALL BE SEPARATED FROM CONDUIT SYSTEMS TO BE USED FOR SUPPLY SYSTEMS BY:
A. 3 INCHES OF CONCRETE
B. 4 INCHES OF MASONRY
C. 12 INCHES OF WELL COMPACTED EARTH
EXCEPTION: LESSER SEPARATIONS MAY BE USED WHERE THE PARTIES CONCUR.
 - VERTICAL CROSSING CLEARANCE FROM OTHER UTILITIES SHALL BE 12 INCHES. A 60 INCH LATERAL SEPARATION OF PARALLELING FOREIGN UTILITIES (EXCLUDING COMMUNICATIONS) SHALL BE REQUIRED. AN EXCEPTION WOULD BE TO ALLOW TELEPHONE AND/OR CATV IN THE SAME DITCH AS COMPANY CONDUIT SYSTEM PROVIDING THEIR CIRCUIT IS INSTALLED IN CONDUIT AND MEETS OR EXCEEDS NESC REQUIREMENTS FOR CONDUIT SEPARATION.
 - IT IS UNDERSTOOD THAT ONLY 12 INCH SEPARATION IS REQUIRED ON PUBLIC RIGHTS-OF-WAY. PERSONNEL INVOLVED IN EXCAVATION ON PUBLIC RIGHTS-OF-WAY ARE FULLY AWARE OF THE HAZARDS INVOLVED. HOWEVER, EXCAVATION ON PRIVATE PROPERTY CAN BE DONE BY INDIVIDUALS WHO ARE NOT LIKELY TO BE FULLY AWARE OF THE HAZARDS. THEREFORE, THE 60 INCH LATERAL SEPARATION IS REQUIRED TO HELP PREVENT INJURY TO PERSONNEL DOING EXCAVATION ON PRIVATE PROPERTY.


02 TRENCH REQUIREMENTS
NOT TO SCALE

Luminaire Schedule										
Symbol	Qty	Volt	Tag	Arr.	Lamp	Lumens	LLF	Mfg.	Description	Comment
⊕	11	480	B1	SINGLE	150W MH	12500	0.72	AAL	PRMSH2150PMHCHMDB	POLES 1 THROUGH 11
⊕	1	480	B2	SINGLE	250W MH	20500	0.82	AAL	PRM2H5250PMHDB	POLE 12

- NOTES:**
- PHOTOMETRIC DATA USED IS BASED ON ESTABLISHED IES PROCEDURES AND PUBLISHED LAMP RATINGS.
 - THE LIGHT LOSS FACTOR (LLF) IS BASED ON LAMP MANUFACTURER'S PUBLISHED MEAN LUMEN RATINGS.
 - FIELD PERFORMANCE WILL DEPEND ON ACTUAL LAMP, BALLAST, ELECTRICAL AND SITE CHARACTERISTICS.
 - SAME AS A1 EXCEPT WITH THE OPTIONAL BPS - FIXTURE STRUTS FINISHED IN A BRASS COLORED POWDER.

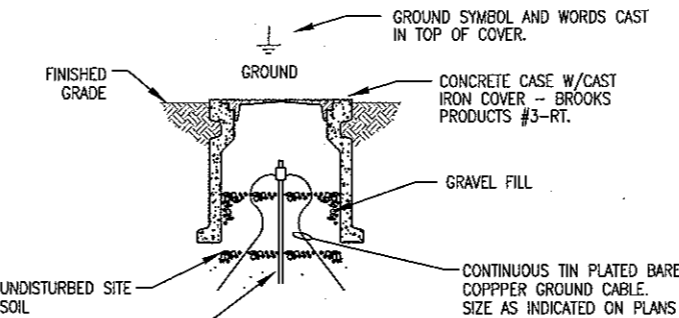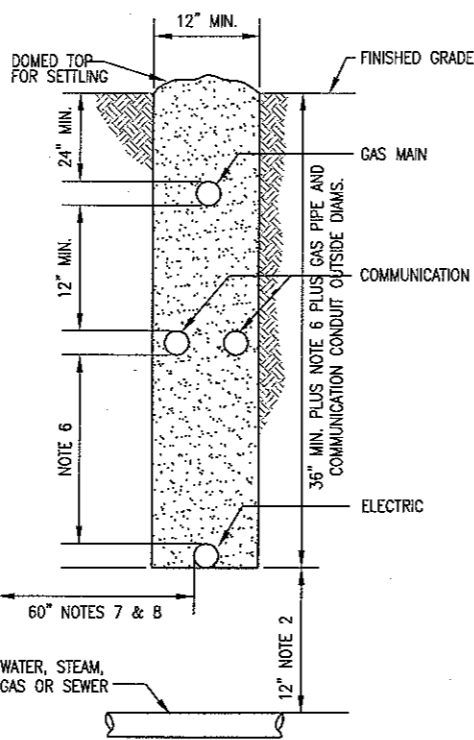


03 GROUND ROD & WELL
NOT TO SCALE

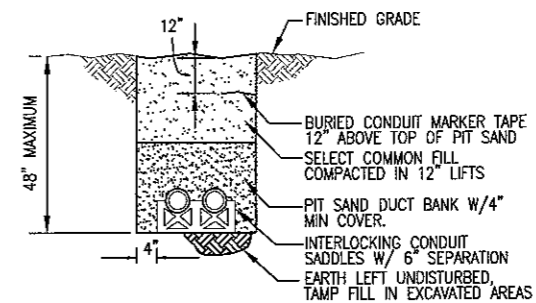

- NOTES:**
- NUMBER AND SIZE OF CONDUITS SHALL BE AS SHOWN ON THE PLANS.
 - TOP OF PIT SAND ENCASUREMENT SHALL BE A MINIMUM OF 24" FROM FINISHED GRADE.
 - USE THIS DETAIL FOR OTHER THAN VEHICULAR TRAFFIC AREAS.

04 DETAIL - PIT SAND ENCASED UNDERGROUND DUCTBANK
NOT TO SCALE

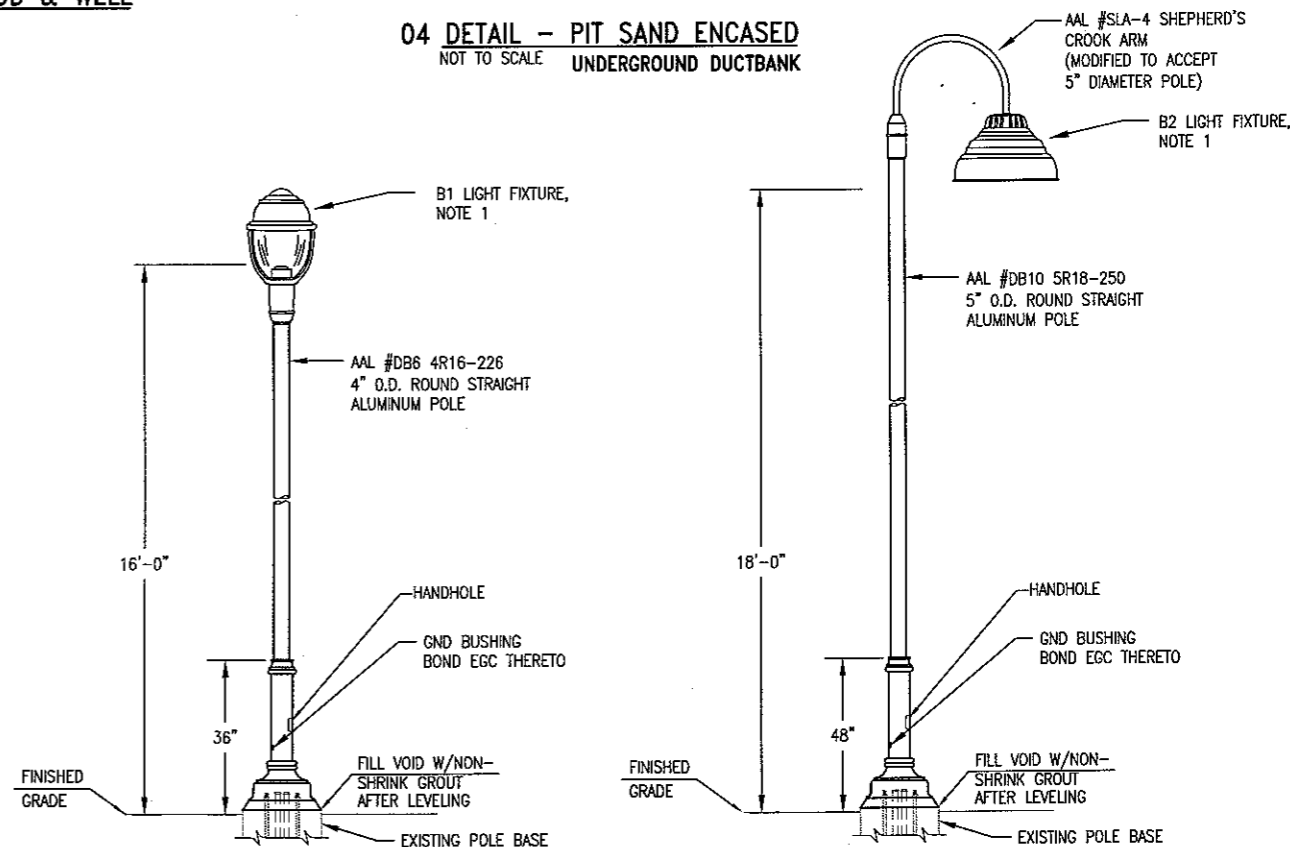


- NOTES:**
- REFERENCE TABLE THIS SHEET FOR LIGHT FIXTURE DATA.
 - THE POLES, FIXTURES AND LAMPS WILL BE PROVIDED BY THE OWNER AND INSTALLED BY THE CONTRACTOR.

05 LIGHTING FIXTURE AND POLE INSTALLATION
NOT TO SCALE

This record drawing is a compilation of the sealed engineering drawing for this project, modified by addenda, change orders and information furnished by the contractor. The information shown on the record drawings that was provided by the contractor or others not associated with the design engineer cannot be verified for accuracy or completeness. This original sealed drawings are on file at the offices of Birkhoff, Hendricks & Conway, L.L.P.
By P.A.C. DATE 10/09/09

BIRKHOFF, HENDRICKS & CONWAY, L.L.P.
CONSULTING ENGINEERS
11910 Greenville Ave., Suite 600
Dallas, Texas
(214) 361-7900



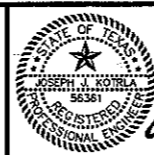


THESE DOCUMENTS ARE FOR BIDDING, CONSTRUCTION, AND PERMIT PURPOSES.
DATE: 4-7-09
McCREARY & ASSOCIATES, INC.
Consulting Engineers
Dallas, Texas FIRM No. F-338

CITY OF ROCKWALL, TEXAS
FANNIN STREET
ELECTRICAL
DETAILS SHEET 1

BHC
PROJECT NO.
2008-116
April, 2009
SHEET NO.
E3

These plans and related specifications were prepared for construction of this specific project only. Reuse of these documents is not permitted without written authorization of Birkhoff, Hendricks, & Conway, L.L.P.

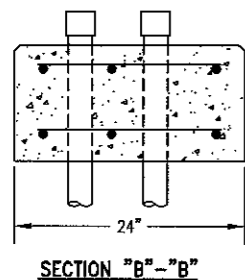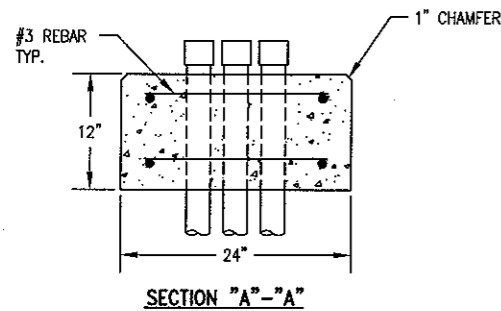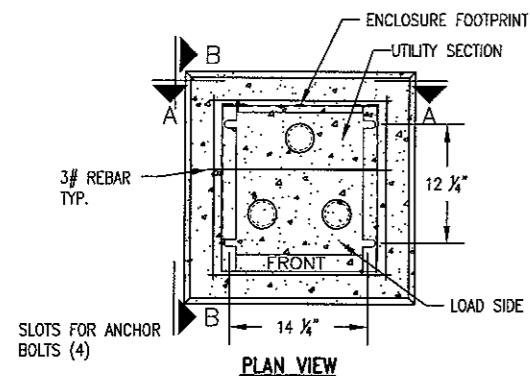


01 CONTROL ENCLOSURE PANEL PAD DETAIL


PANEL SD						240/480V, 1P-3W, MAIN						65A, 10KAIC @ 480V					
LOAD	COND.	WIRE	LOAD SERVED	BRKR	CKT	CKT	BRKR	LOAD SERVED	WIRE	COND.	LOAD	CKT	BRKR	LOAD SERVED	WIRE	COND.	LOAD
8.6 KVA	2"	NOTE 1	STREET LIGHTS CIRCUIT 1	30/2	1	2	30/2	STREET LIGHTS CIRCUIT 2	NOTE 1	2"	8.6 KVA						
0.5 KVA	---	12	CPT		NOTE 2	M	70/2	MAIN	NOTE 1	2"	---						

CONTROL ENCLOSURE SCHEDULE

- NOTES:
1. REFER TO PLANS FOR WIRE SIZES.
2. REFER TO POLE HANDHOLE DETAIL 02/E6 FOR FUSE SIZES.

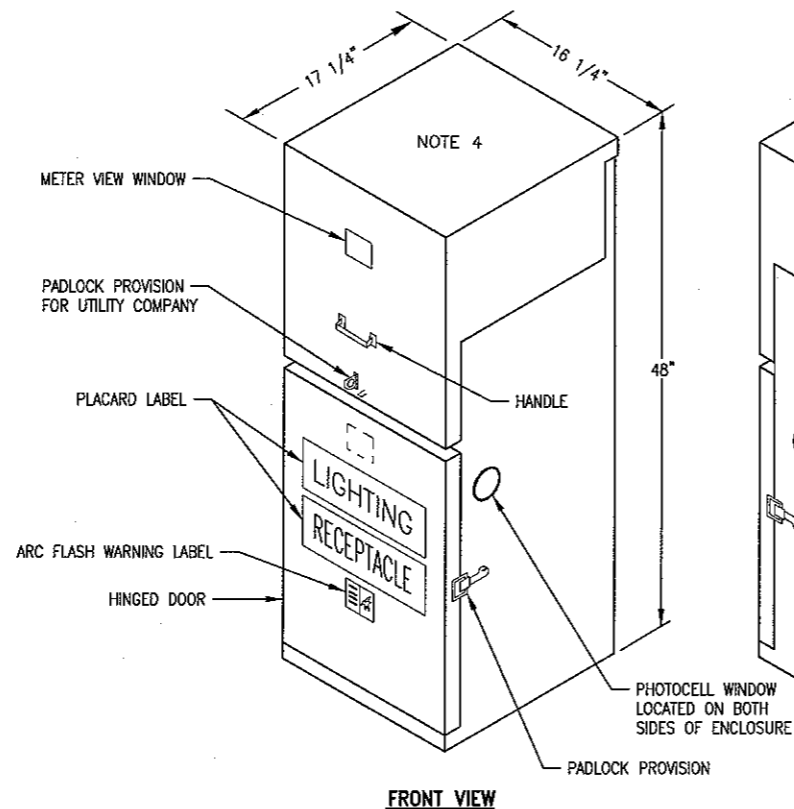


FRONT VIEW

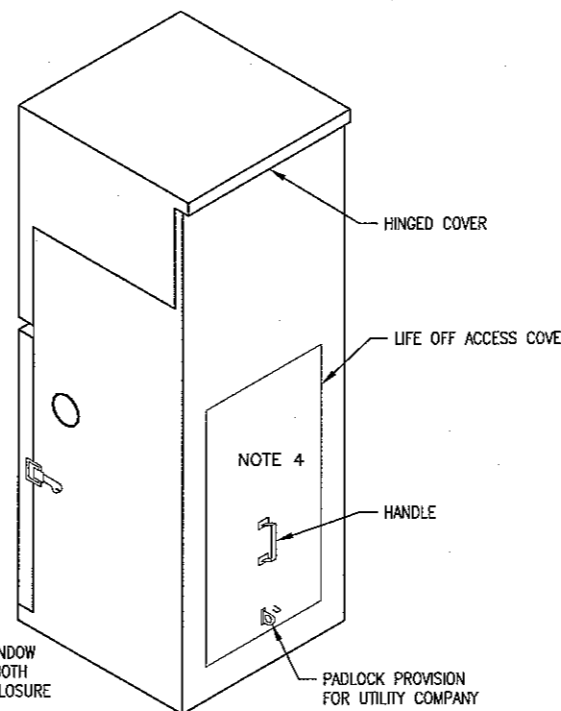

REAR VIEW


- NOTES:
1. CABINET INTERIOR WITH DOOR REMOVED, DEAD FRONT CONSTRUCTION.
2. CIRCUIT BREAKERS AND FUSES - REFER TO SCHEMATIC.
3. UL LISTED ASSEMBLY. REFER TO GENERAL NOTE 1 SHEET E3 FOR SPECIFICATIONS.
4. FOR UTILITY COMPANY ACCESS ONLY.

03 CONTROL ENCLOSURE PANEL SD
NOT TO SCALE

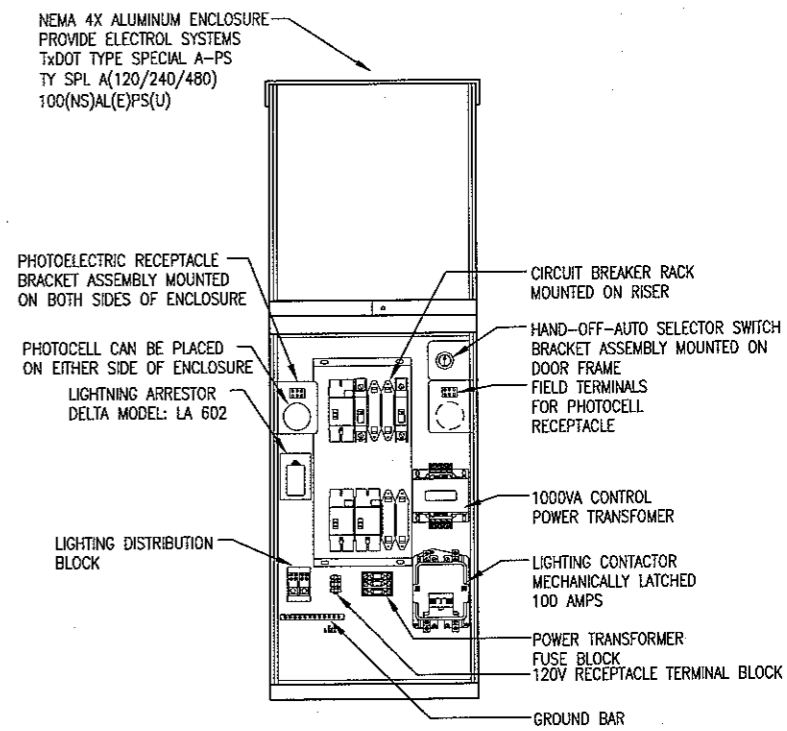

INTERIOR VIEW


04 CONTROL ENCLOSURE PANEL SD
NOT TO SCALE

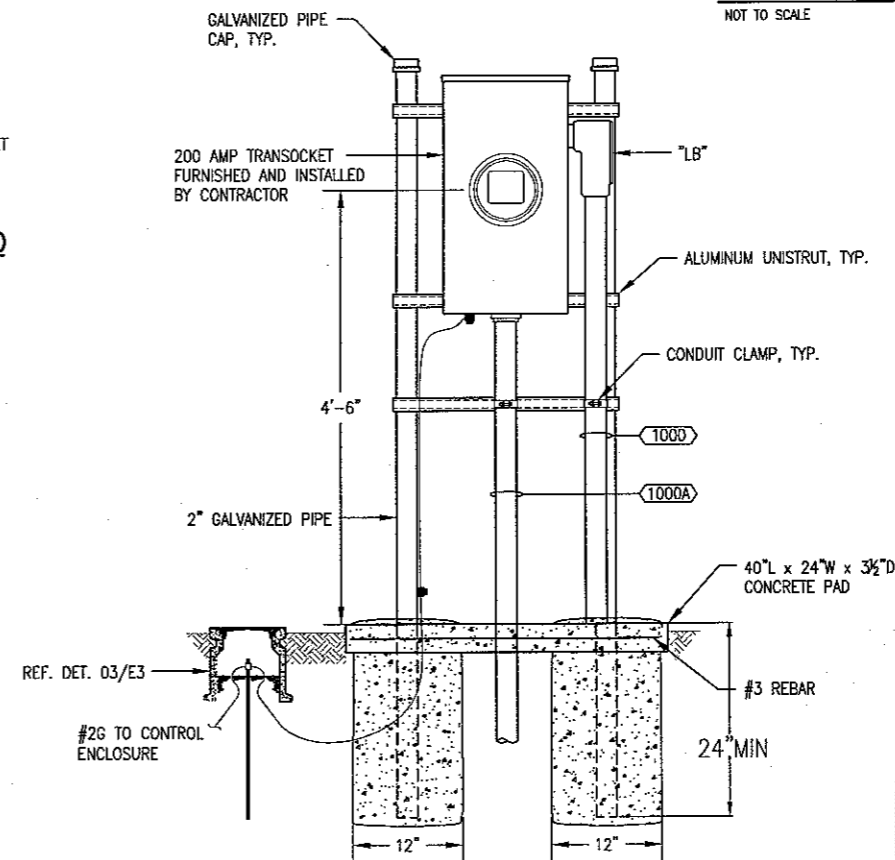

05 METERING EQUIPMENT STAND
NOT TO SCALE

This record drawing is a compilation of the sealed engineering drawing for this project; modified by addenda, change orders and information furnished by the contractor. The information shown on the record drawings that was provided by the contractor or others not associated with the design engineer cannot be verified for accuracy or completeness. This original sealed drawings are on file at the offices of Birkhoff, Hendricks & Conway, L.L.P.
BY P.A.C. DATE 10/09/09

BIRKHOFF, HENDRICKS & CONWAY, L.L.P.
CONSULTING ENGINEERS
11910 Greenville Ave., Suite 600
Dallas, Texas
(214) 361-7900

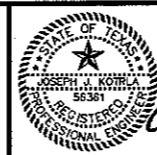

THESE DOCUMENTS ARE FOR BIDDING, CONSTRUCTION, AND PERMIT PURPOSES.
DATE: 4-7-09
McCREARY & ASSOCIATES, INC.
Consulting Engineers
Dallas, Texas
FIRM No. F-338

CITY OF ROCKWALL, TEXAS
FANNIN STREET
ELECTRICAL
DETAILS SHEET II

BHC
PROJECT NO.
2008-116
April, 2009

SHEET NO.
E4