



REVISION: 4/29/09 - GDAVIS
C:\Acad_Jobs\Rockwall\2005111\Sheets\2005111-034_SANSEW2.dwg
PLOT SCALE: 1:20
PLOT STYLE: 22X34.ctb
PLOTTED BY: GDAVIS ON 4/30/2009

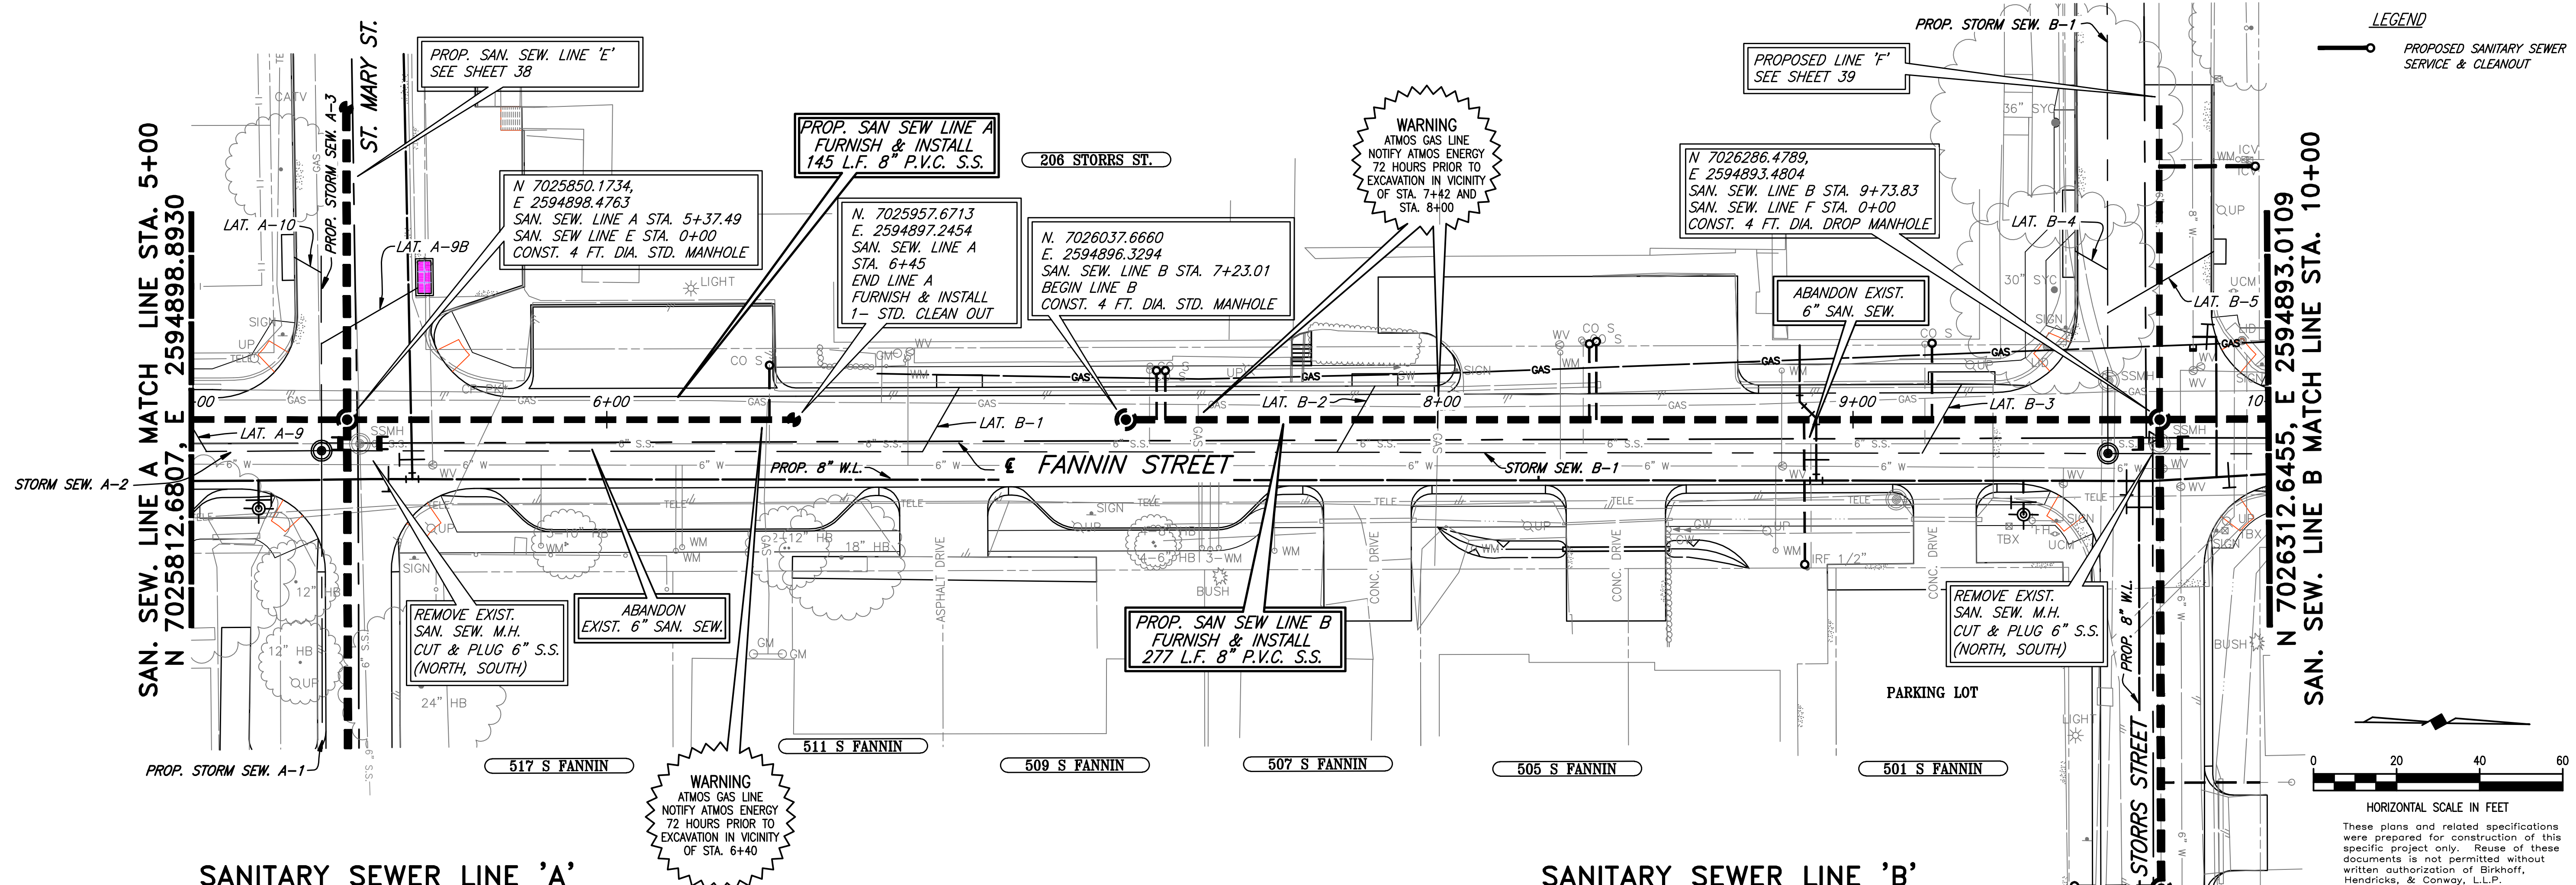

SANITARY SEWER LINE 'A'

SANITARY SEWER LINE 'B'

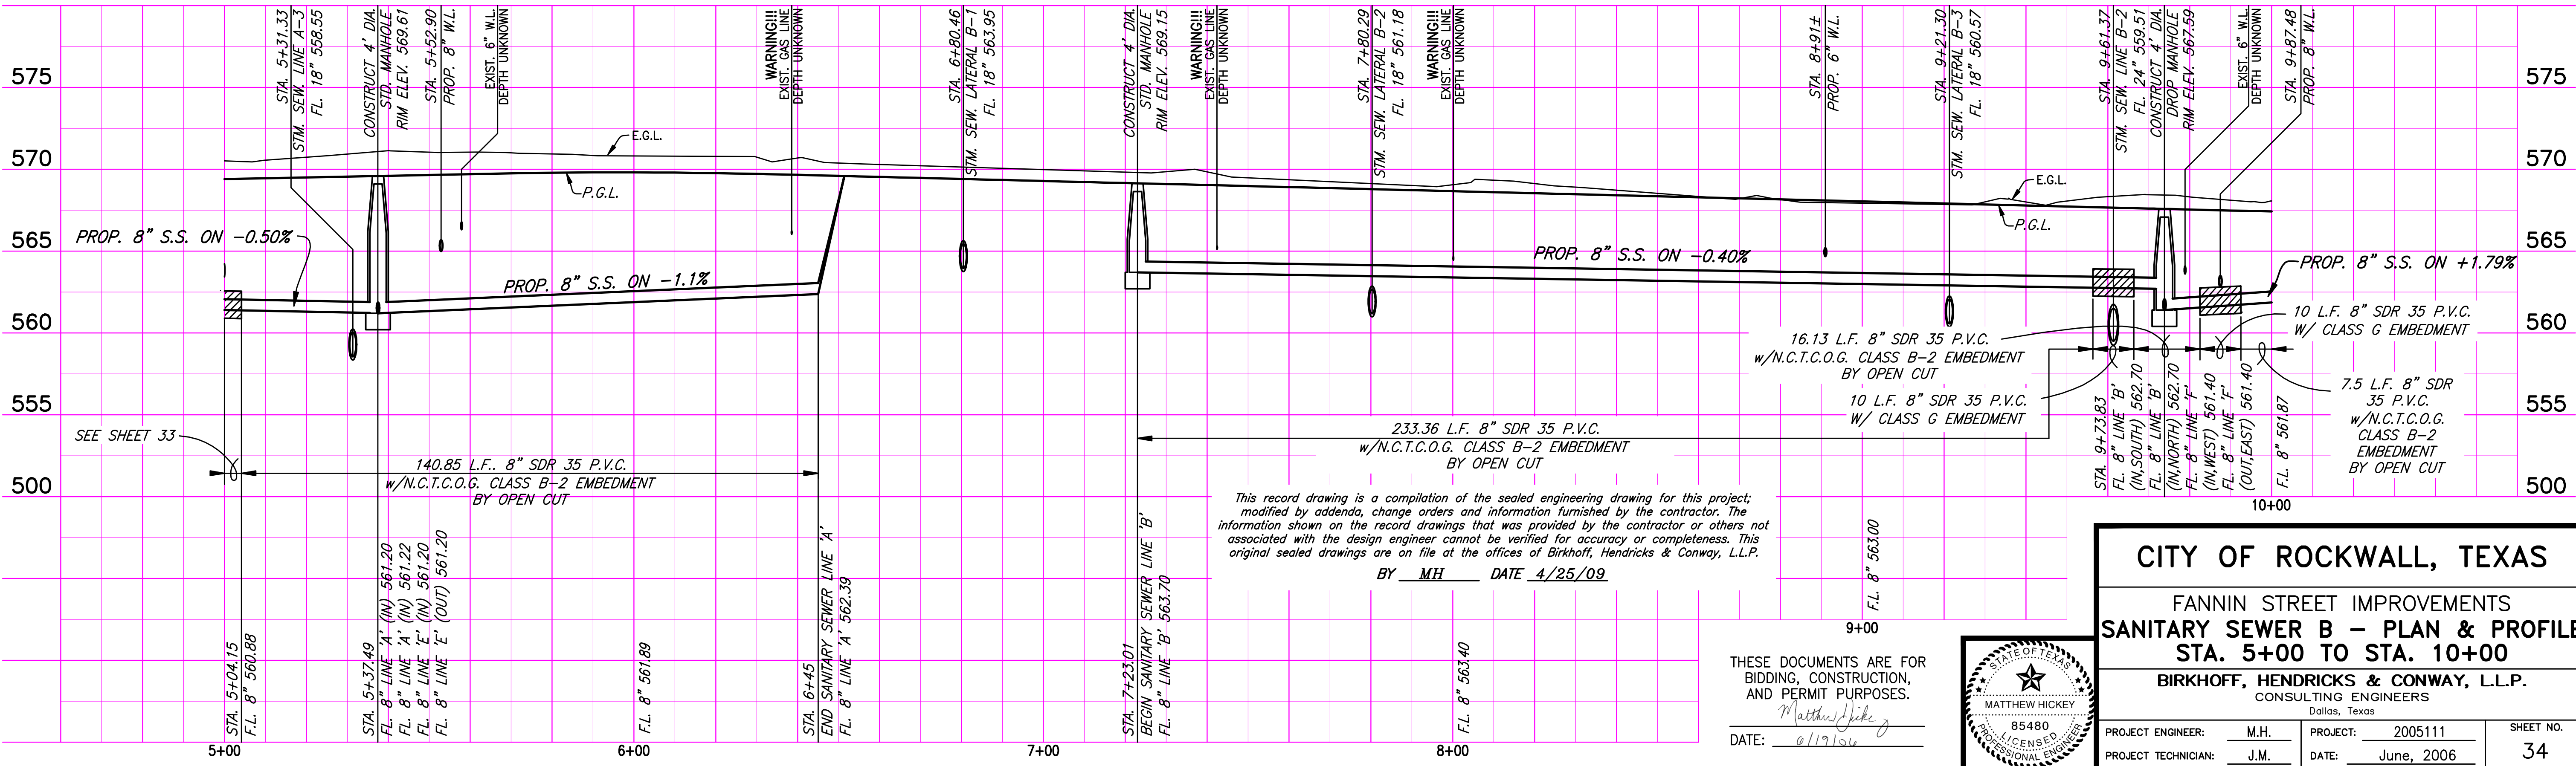

CITY OF ROCKWALL, TEXAS
FANNIN STREET IMPROVEMENTS
SANITARY SEWER B - PLAN & PROFILE
STA. 5+00 TO STA. 10+00
BIRKHOFF, HENDRICKS & CONWAY, L.L.P.
CONSULTING ENGINEERS
Dallas, Texas

PROJECT ENGINEER:	M.H.	PROJECT:	2005111	SHEET NO.	34
PROJECT TECHNICIAN:	J.M.	DATE:	June, 2006		



THESE DOCUMENTS ARE FOR BIDDING, CONSTRUCTION, AND PERMIT PURPOSES.
DATE: 6/17/06