



**LEGEND**  
 PROPOSED SANITARY SEWER SERVICE & CLEANOUT

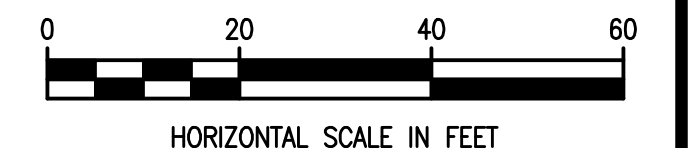

These plans and related specifications were prepared for construction of this specific project only. Reuse of these documents is not permitted without written authorization of Birkhoff, Hendricks, & Conway, L.L.P.

**SANITARY SEWER LINE 'B'**

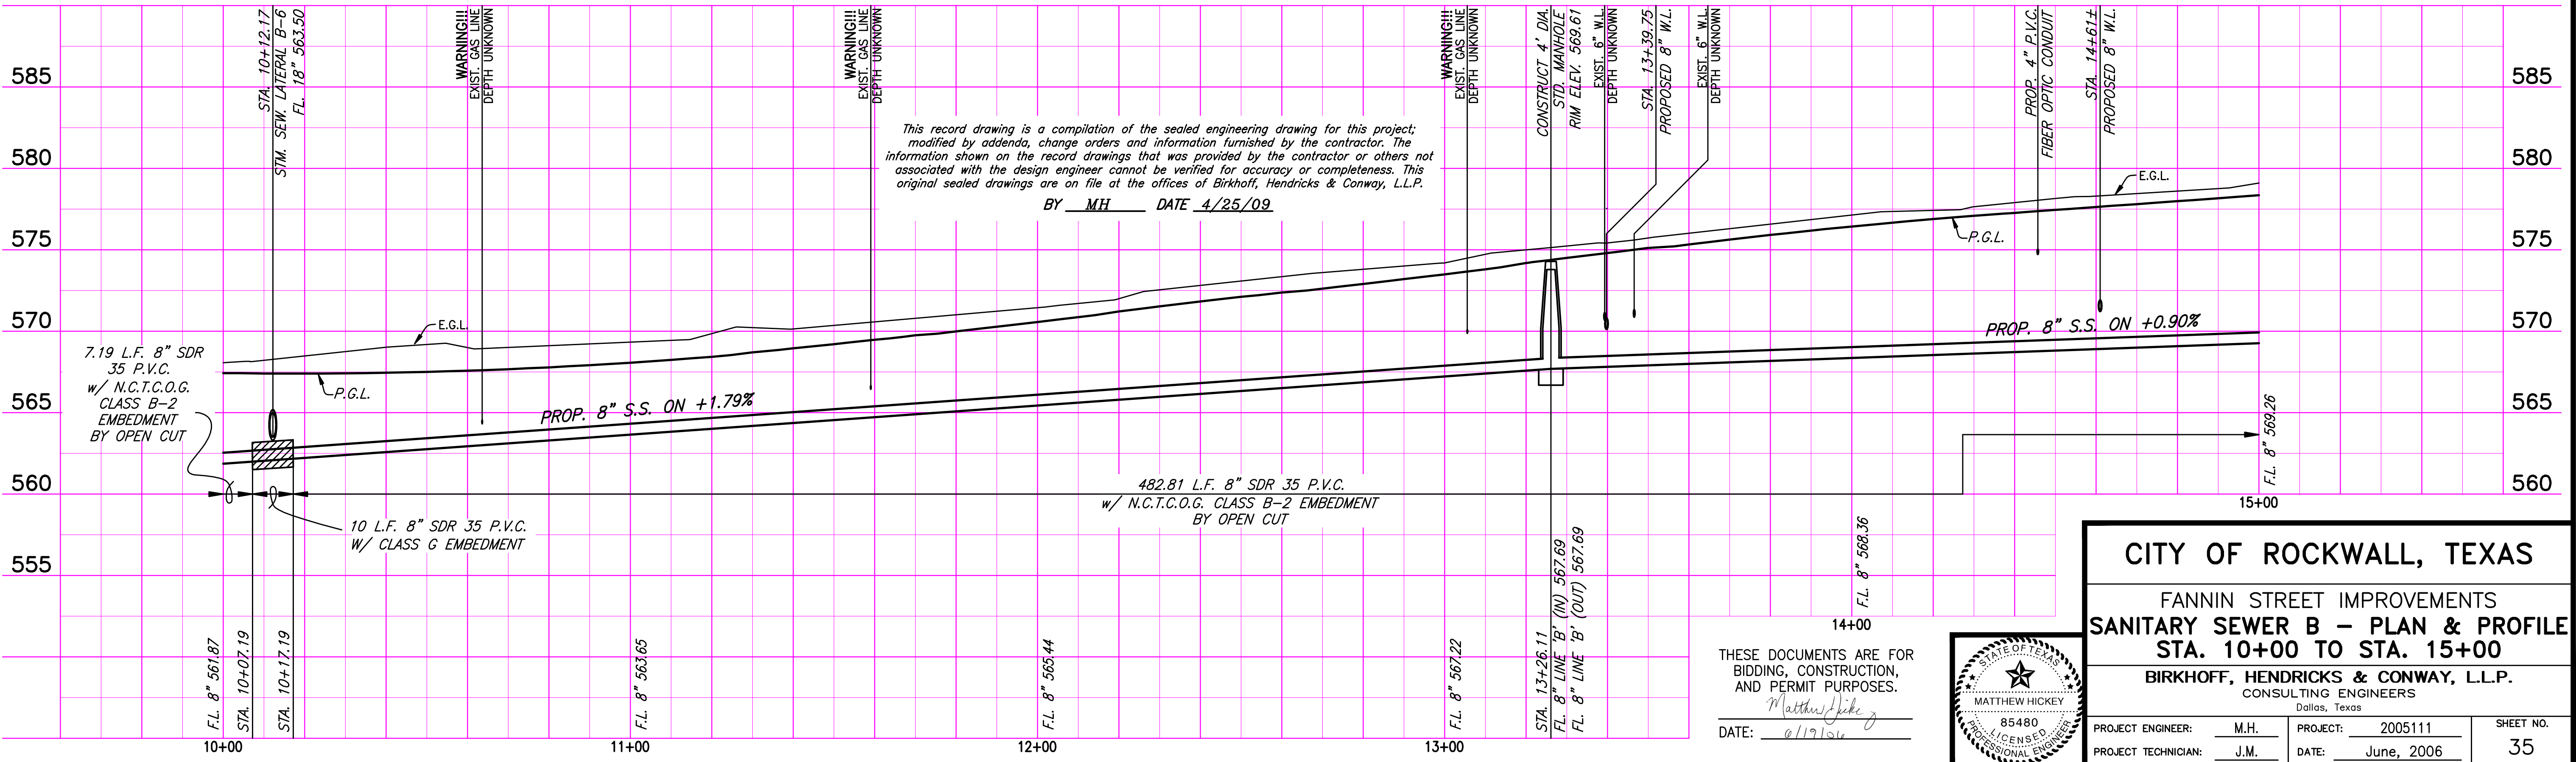

This record drawing is a compilation of the sealed engineering drawing for this project, modified by addenda, change orders and information furnished by the contractor. The information shown on the record drawings that was provided by the contractor or others not associated with the design engineer cannot be verified for accuracy or completeness. This original sealed drawings are on file at the offices of Birkhoff, Hendricks & Conway, L.L.P.  
 BY MH DATE 4/25/09

**CITY OF ROCKWALL, TEXAS**

FANNIN STREET IMPROVEMENTS  
 SANITARY SEWER B - PLAN & PROFILE  
 STA. 10+00 TO STA. 15+00

**BIRKHOFF, HENDRICKS & CONWAY, L.L.P.**  
 CONSULTING ENGINEERS  
 Dallas, Texas

PROJECT ENGINEER: M.H. PROJECT: 2005111 SHEET NO. 35  
 PROJECT TECHNICIAN: J.M. DATE: June, 2006



THESE DOCUMENTS ARE FOR BIDDING, CONSTRUCTION, AND PERMIT PURPOSES.  
 Matthew Hickey  
 DATE: 6/19/06