



REVISED: 4/29/09 - GDAVIS
C:\Acad_jobs\Rockwall\2005111\Sheets\200511-036_SANSEW4.dwg
PLOT SCALE: 1:20
PLOT STYLE: 22X34.ctb
PLOTTED BY: GDAVIS ON 4/30/2009

LEGEND
—○— PROPOSED SANITARY SEWER SERVICE & CLEANOUT

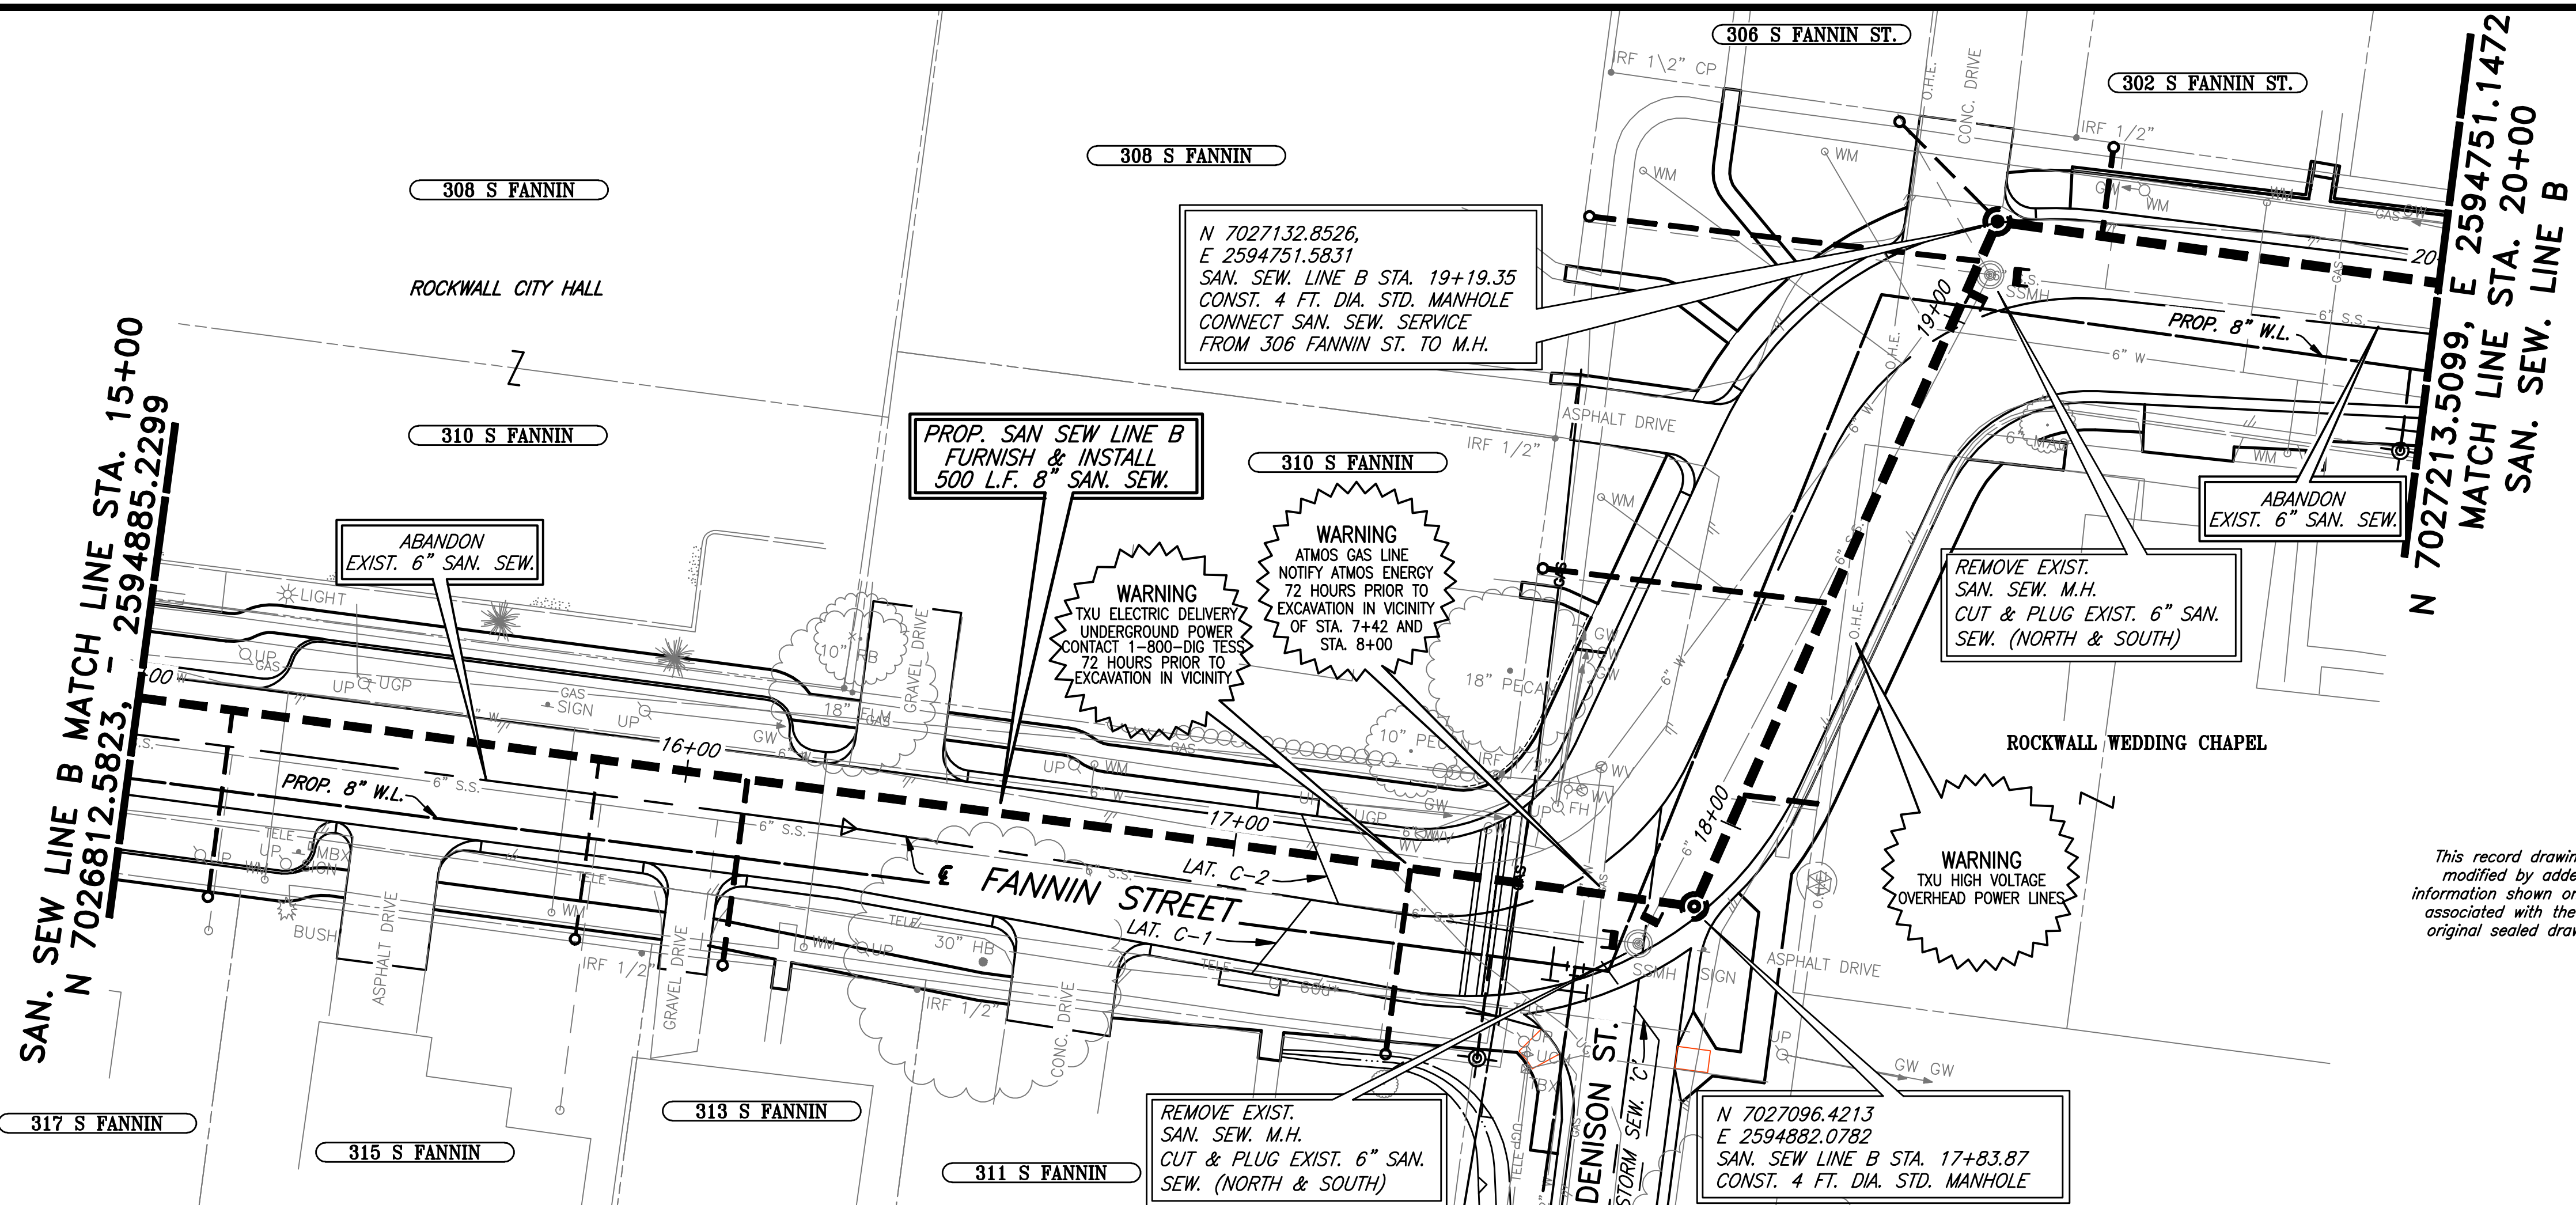


This record drawing is a compilation of the sealed engineering drawing for this project, modified by addenda, change orders and information furnished by the contractor. The information shown on the record drawings that was provided by the contractor or others not associated with the design engineer cannot be verified for accuracy or completeness. This original sealed drawings are on file at the offices of Birkhoff, Hendricks & Conway, L.L.P.
BY MH DATE 4/25/09

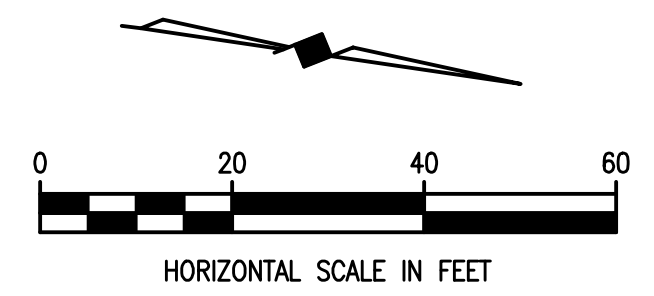


These plans and related specifications were prepared for construction of this specific project only. Reuse of these documents is not permitted without written authorization of Birkhoff, Hendricks, & Conway, L.L.P.

SANITARY SEWER LINE 'B'

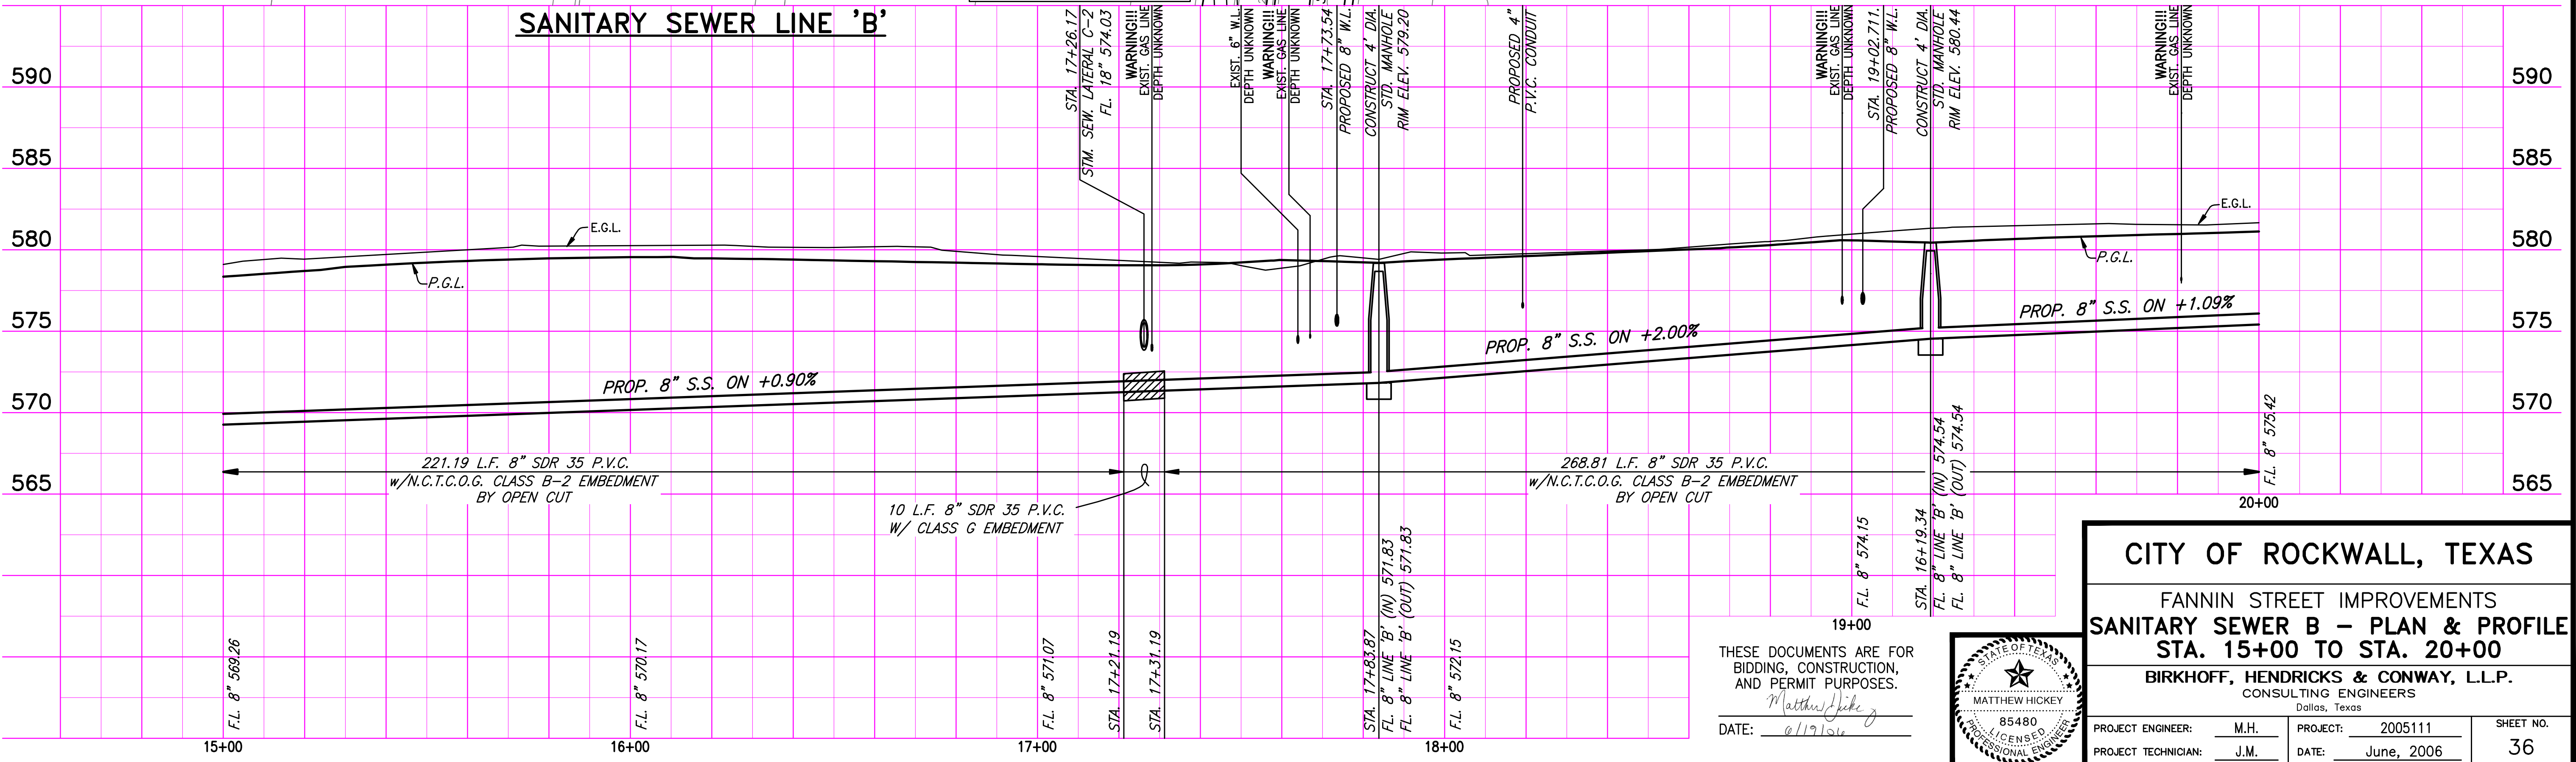

THESE DOCUMENTS ARE FOR BIDDING, CONSTRUCTION, AND PERMIT PURPOSES.
Matthew Hickey
DATE: 4/19/09

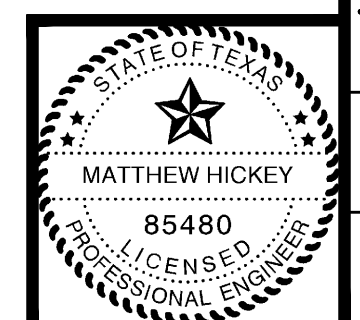

CITY OF ROCKWALL, TEXAS			
FANNIN STREET IMPROVEMENTS			
SANITARY SEWER B - PLAN & PROFILE			
STA. 15+00 TO STA. 20+00			
BIRKHOFF, HENDRICKS & CONWAY, L.L.P.			
CONSULTING ENGINEERS			
Dallas, Texas			
PROJECT ENGINEER:	M.H.	PROJECT:	2005111
PROJECT TECHNICIAN:	J.M.	DATE:	June, 2006
			SHEET NO.
			36