


C:\Acad\_Jobs\Rockwall\2005111\Sheets\2005111-031\_WL-05.dwg  
 PLOTTED BY: GDAVIS ON 4/30/2009  
 PLOT STYLE: 22X34.ctb  
 PLOT SCALE: 1:20  
 REVISED: 4/29/09 - GDAVIS

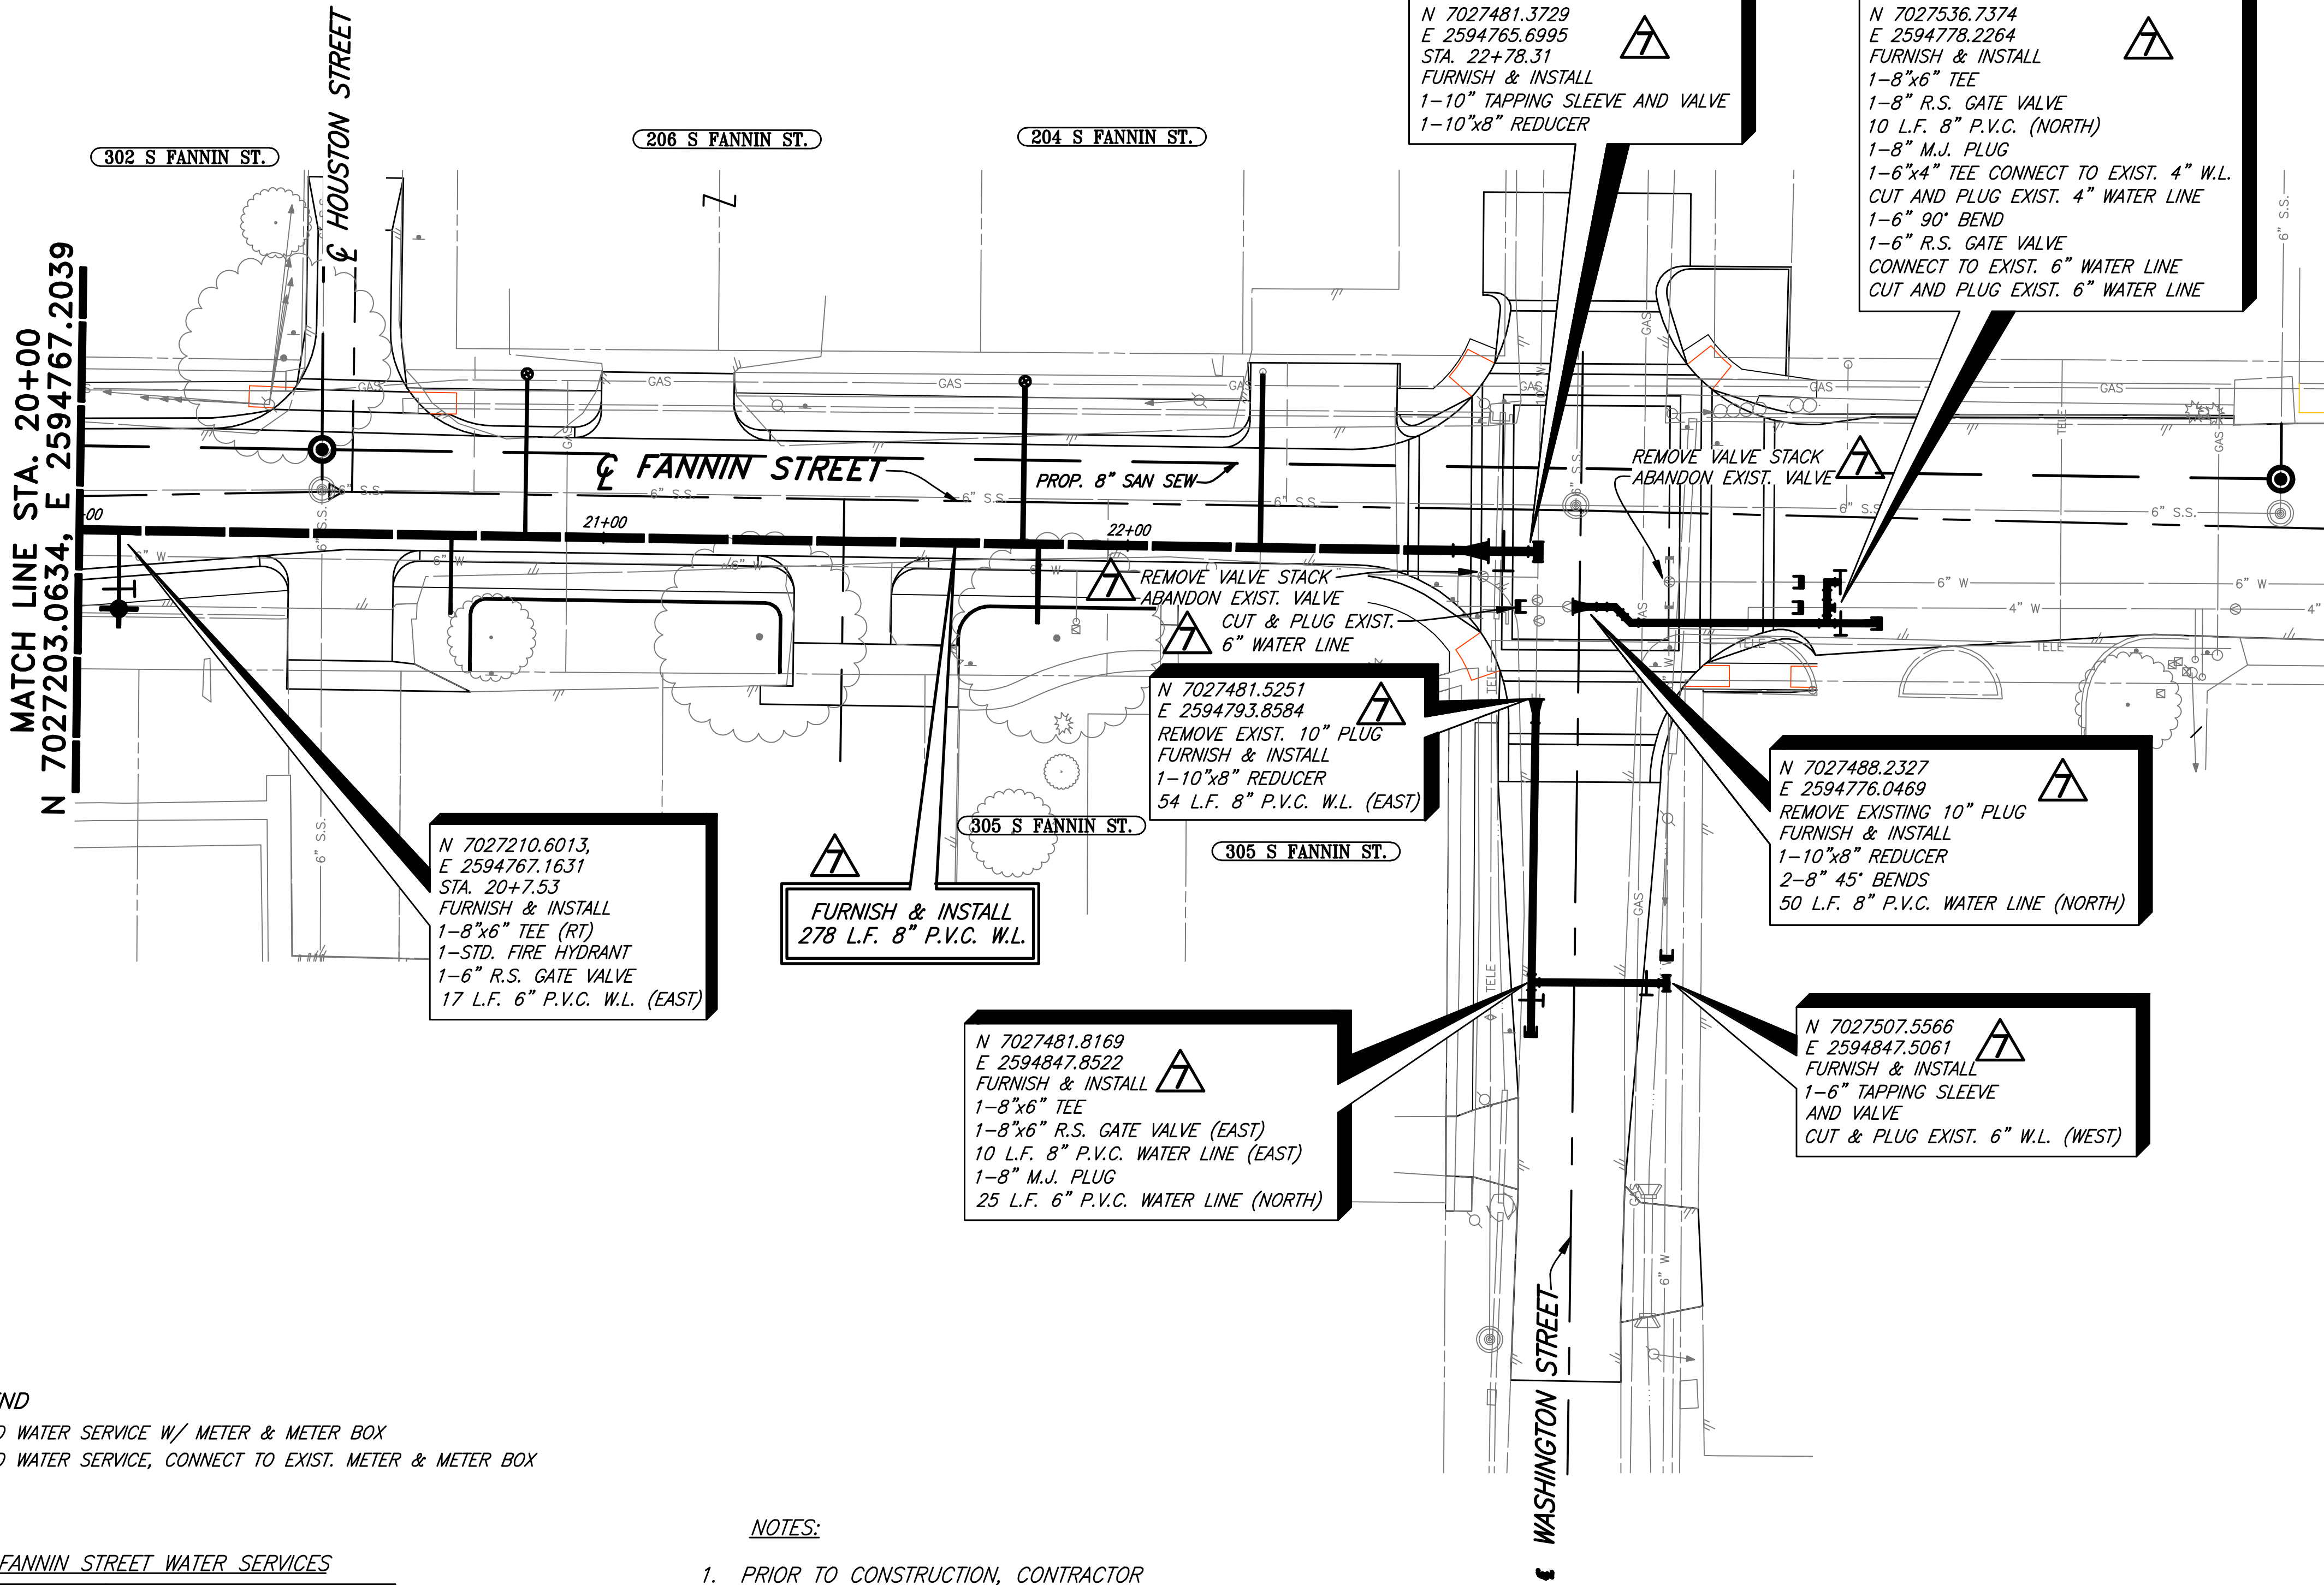

**LEGEND**

PROPOSED WATER SERVICE W/ METER & METER BOX  
 PROPOSED WATER SERVICE, CONNECT TO EXIST. METER & METER BOX

**PROPOSED FANNIN STREET WATER SERVICES**

LOCATION	PROPOSED 1 INCH SERVICE
W.L. STA. 20+71	15 L.F. (RT.)
W.L. STA. 20+85	30 L.F. (LT.)
W.L. STA. 21+80	30 L.F. (LT.)
W.L. STA. 21+90	15 L.F. (RT.)
W.L. STA. 22+25	35 L.F. (LT.)
TOTAL: 125 L.F.	

FURNISH & INSTALL PROP. 1" OUTLET AND NEW 1" SDR-9 (POLYTUBE) WATER SERVICE. TRANSFER OF WATER SERVICE SHALL INCLUDE FITTINGS, 1" SERVICE SADDLE, CONNECTION TO EXISTING SERVICE. METER AND METER BOX SHALL BE PAID ON A PER EACH BASIS.

**NOTES:**


1. PRIOR TO CONSTRUCTION, CONTRACTOR SHALL VERIFY HORIZONTAL & VERTICAL LOCATION OF EXISTING WATER LINES IN THE FANNIN & WASHINGTON INTERSECTION. EXISTING WATER LINES ARE PRE-1946

This record drawing is a compilation of the sealed engineering drawing for this project; modified by addenda, change orders and information furnished by the contractor. The information shown on the record drawings that was provided by the contractor or others not associated with the design engineer cannot be verified for accuracy or completeness. This original sealed drawings are on file at the offices of Birkhoff, Hendricks & Conway, L.L.P.

BY MH DATE 4/25/09

THESE DOCUMENTS ARE FOR BIDDING, CONSTRUCTION, AND PERMIT PURPOSES.

DATE: 4/25/09

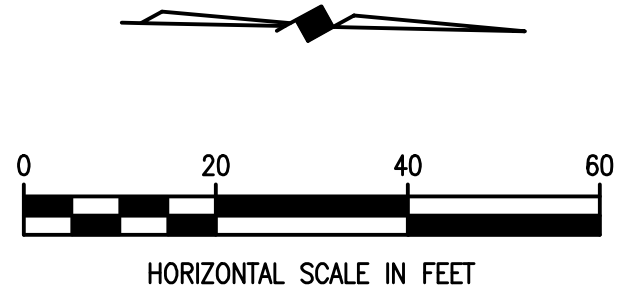

**FIELD CHANGE NO. 7 (7/23/2008)**

These plans and related specifications were prepared for construction of this specific project only. Reuse of these documents is not permitted without written authorization of Birkhoff, Hendricks, & Conway, L.L.P.

**CITY OF ROCKWALL, TEXAS**

**FANNIN STREET IMPROVEMENTS**  
**WATER LINE - PLAN**  
**STA. 20+00 TO STA. 22+78.31**

**BIRKHOFF, HENDRICKS & CONWAY, L.L.P.**  
 CONSULTING ENGINEERS  
 Dallas, Texas

PROJECT ENGINEER: <u>M.H.</u>	PROJECT: <u>2005111</u>	SHEET NO. <u>31</u>
PROJECT TECHNICIAN: <u>MVO</u>	DATE: <u>July, 2008</u>	