


C:\Acad_Jobs\Rockwall\2005111\Sheets\2005111-032_WL-06.dwg
 PLOTTED BY: GDAVIS ON 4/30/2009
 PLOT STYLE: 22X34.ctb
 PLOT SCALE: 1:20
 REVISED: 4/29/09 - GDAVIS

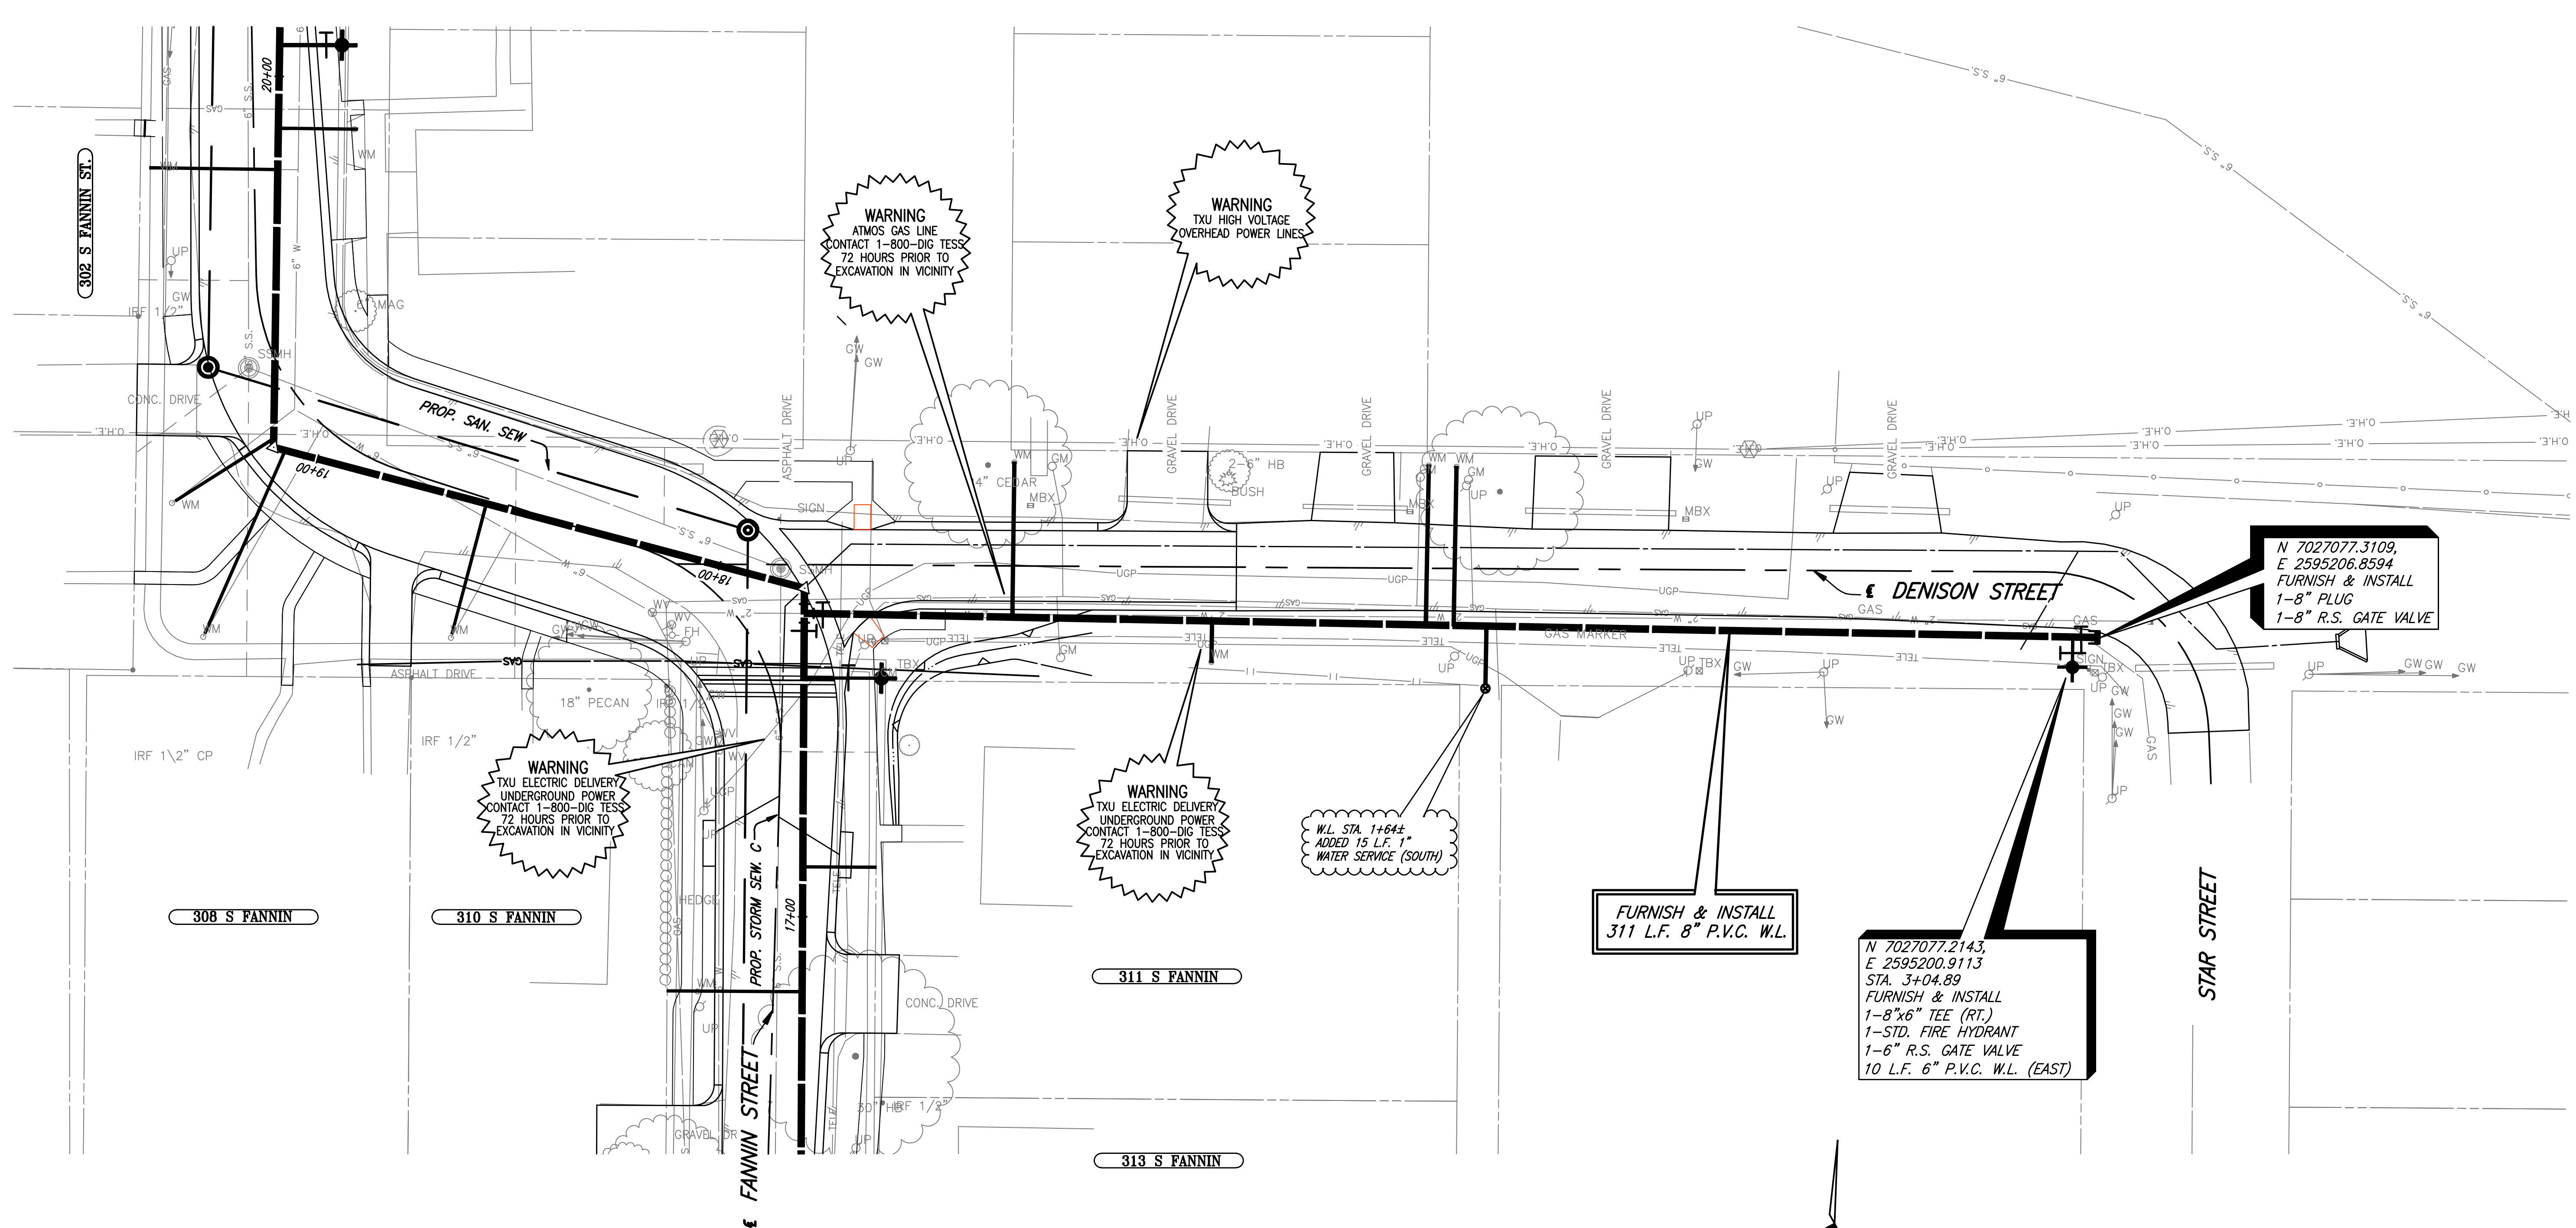

WARNING
 TXU ELECTRIC DELIVERY
 UNDERGROUND POWER
 CONTACT 1-800-DIG TESS
 72 HOURS PRIOR TO
 EXCAVATION IN VICINITY

WARNING
 ATMOS GAS LINE
 CONTACT 1-800-DIG TESS
 72 HOURS PRIOR TO
 EXCAVATION IN VICINITY

WARNING
 TXU HIGH VOLTAGE
 OVERHEAD POWER LINES

WARNING
 TXU ELECTRIC DELIVERY
 UNDERGROUND POWER
 CONTACT 1-800-DIG TESS
 72 HOURS PRIOR TO
 EXCAVATION IN VICINITY

W.L. STA. 1+64±
 ADDED 15 L.F. 1"
 WATER SERVICE (SOUTH)

FURNISH & INSTALL
 311 L.F. 8" P.V.C. W.L.


N 7027077.2143,
 E 2595200.9113
 STA. 3+04.89
FURNISH & INSTALL
 1-8"x6" TEE (RT.)
 1-STD. FIRE HYDRANT
 1-6" R.S. GATE VALVE
 10 L.F. 6" P.V.C. W.L. (EAST)

N 7027077.3109,
 E 2595206.8594
FURNISH & INSTALL
 1-8" PLUG
 1-8" R.S. GATE VALVE

LEGEND
 PROPOSED WATER SERVICE W/ METER & METER BOX
 PROPOSED WATER SERVICE, CONNECT TO EXIST. METER & METER BOX

PROPOSED DENISON STREET WATER SERVICES	
LOCATION	PROPOSED 1 INCH SERVICE
W.L. STA. 0+50	35 L.F. (RT.)
W.L. STA. 0+98	10 L.F. (RT.)
W.L. STA. 1+49	38 L.F. (RT.)
W.L. STA. 1+56	38 L.F. (RT.)
W.L. STA. 1+64±	15 L.F. (RT.)
TOTAL: 136 L.F.	
FURNISH & INSTALL PROP. 1" OUTLET AND NEW 1" SDR-9 (POLYTUBE) WATER SERVICE. TRANSFER OF WATER SERVICE SHALL INCLUDE FITTINGS, 1" SERVICE SADDLE, CONNECTION TO EXISTING SERVICE. METER AND METER BOX SHALL BE PAID ON A PER EACH BASIS.	

This record drawing is a compilation of the sealed engineering drawing for this project; modified by addenda, change orders and information furnished by the contractor. The information shown on the record drawings that was provided by the contractor or others not associated with the design engineer cannot be verified for accuracy or completeness. This original sealed drawings are on file at the offices of Birkhoff, Hendricks & Conway, L.L.P.
 BY MH DATE 4/25/09

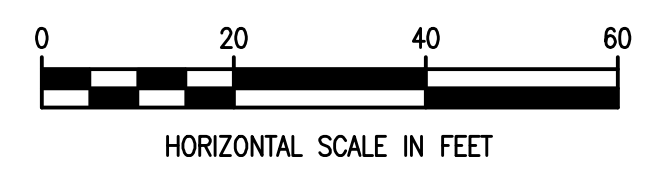

THESE DOCUMENTS ARE FOR
 BIDDING, CONSTRUCTION,
 AND PERMIT PURPOSES.
 Matthew Hickey
 DATE: 6/19/09



CITY OF ROCKWALL, TEXAS

**FANNIN STREET IMPROVEMENTS
 WATER LINE - PLAN
 STA. 0+00 TO STA. 5+00**

BIRKHOFF, HENDRICKS & CONWAY, L.L.P.
 CONSULTING ENGINEERS
 Dallas, Texas

PROJECT ENGINEER: M.H.	PROJECT: 2005111	SHEET NO. 32
PROJECT TECHNICIAN: MVO	DATE: June, 2006	

These plans and related specifications were prepared for construction of this specific project only. Reuse of these documents is not permitted without written authorization of Birkhoff, Hendricks, & Conway, L.L.P.