


Location_	Location_#	Sta_#	Depth	Note
Driveway, East side		1 0+00	*	HH by Animal Center
*		2 0+14	3'	14' off of edge of drive
*		3 0+42	4'6"	Turn at road
Airport Rd.		4 0+67	2'3"	Middle of drive
*		5 1+01	2'7"	Under drive
*		6 1+27	5'	Edge of drive
*		7 1+52	4'1"	3' off edge of curb
*		8 1+81	3'4"	3' off edge of curb
*		9 2+08	3'9"	2' off edge of curb
*		10 2+38	3'10"	Marker post, 4' off of edge of curb
*		11 2+72	4'	5' off of edge of curb
*		12 3+01	3'10"	6' off of edge of curb
*		13 3+32	3'11"	7' off of edge of curb
*		14 3+65	4'	7' off of edge of curb
*		15 3+99	4'10"	2 ft off of edge of curb
*		16 4+27	7'1"	3' off edge of curb
*		17 4+45	8'3"	4' off of edge of curb
*		18 4+88	3'	Edge of curb
*		19 5+03	1'9"	Edge of curb
*		20 5+35	4'7"	2' off edge of curb
*		21 5+75	2'4"	3' off edge of curb
*		22 6+09	2'7"	3' off edge of curb
*		23 6+41	5'2"	3' off edge of curb
*		24 6+73	4'5"	3' off edge of curb
*		25 7+00	2'8"	4' off of edge of curb
*		26 7+31	1'10"	4' off of edge of curb
*		27 7+60	2'	3' off edge of curb
*		28 7+88	4'7"	Edge of curb
*		29 8+38	2'	Edge of curb
*		30 8+93	3'1"	Edge of curb
*		31 9+27	7'8"	4' in road from curb
*		32 9+63	6'8"	4' in road from curb
*		33 9+88	7'	5' in road from curb
*		34 1+017	6'10"	6' in road from curb, Gate
*		35 1+052	7'6"	6' in road from curb
*		36 1+085	7'10"	8' in road from curb
*		37 1+112	6'7"	8' in road from curb
*		38 1+134	8'8"	8' in road from curb
*		39 1+171	8'9"	6' in road from curb
*		40 1+183	8'5"	3' in road from curb
Drive		41 1+211	8'	1' in road from curb
*		42 1+246	8'	2' off edge of curb
Airport Rd.		43 1+272	4'	8' off edge of curb
*		44 1+278	*	HH by Airport to Service Center
*		45 1+286	3'7"	17' from edge of curb
*		46 1+347	2'5"	20' from of curb
*		47 1+381	2'	17' from edge of curb
*		48 1+417	2'10"	18' from edge of curb
*		49 1+449	2'3"	17' from edge of curb
*		50 1+480	2'7"	16' from edge of curb
*		51 1+507	7'	14' from edge of curb, runway
*		52 1+541	11'10"	14' from edge of curb, runway
*		53 1+570	8'5"	17' from edge of curb
*		54 1+602	4'4"	17' from edge of curb
*		55 1+635	6'1"	17' from edge of curb
*		56 1+671	5'5"	17' from edge of curb
*		57 1+706	6'3"	17' from edge of curb
*		58 1+754	6'2"	18' from edge of curb
*		59 1+783	4'8"	16' from edge of curb
*		60 1+812	6'	18' from edge of curb
*		61 1+843	4'10"	14' from edge of curb
*		62 1+874	5'10"	15' from edge of curb
*		63 1+908	7'3"	12' from edge of curb
*		64 1+936	10'8"	12' from edge of curb
*		65 1+962	10'11"	9' from edge of curb
*		66 1+968	10'3"	9' from edge of curb
*		67 1+993	20'1"	10' from edge of curb
*		68 2+011	17'2"	12' from edge of curb
*		69 2+028	10'9"	12' from edge of curb
*		70 2+046	13'	12' from edge of curb
*		71 2+083	14'	15' from edge of curb
*		72 2+148	14'11"	12' from edge of curb
*		73 2+242	7'8"	17' from edge of curb
*		74 2+275	4'2"	17' from edge of curb
*		75 2+306	3'2"	13' from edge of curb
*		76 2+325/0+00	*	Hand hole (restation 0+00)
*		77 0+07	1'6"	Crossing Airport Rd.
*		78 0+27	5'7"	Middle of Airport Rd.
Service Center		79 0+53	7'8"	Between Airport Rd. and parking
*		80 0+93	4'11"	Parking lot
*		81 1+104	5'2"	Parking lot
*		82 1+18	*	HH @ building



Aerial photo Copyright 2005, North Central Council of Governments

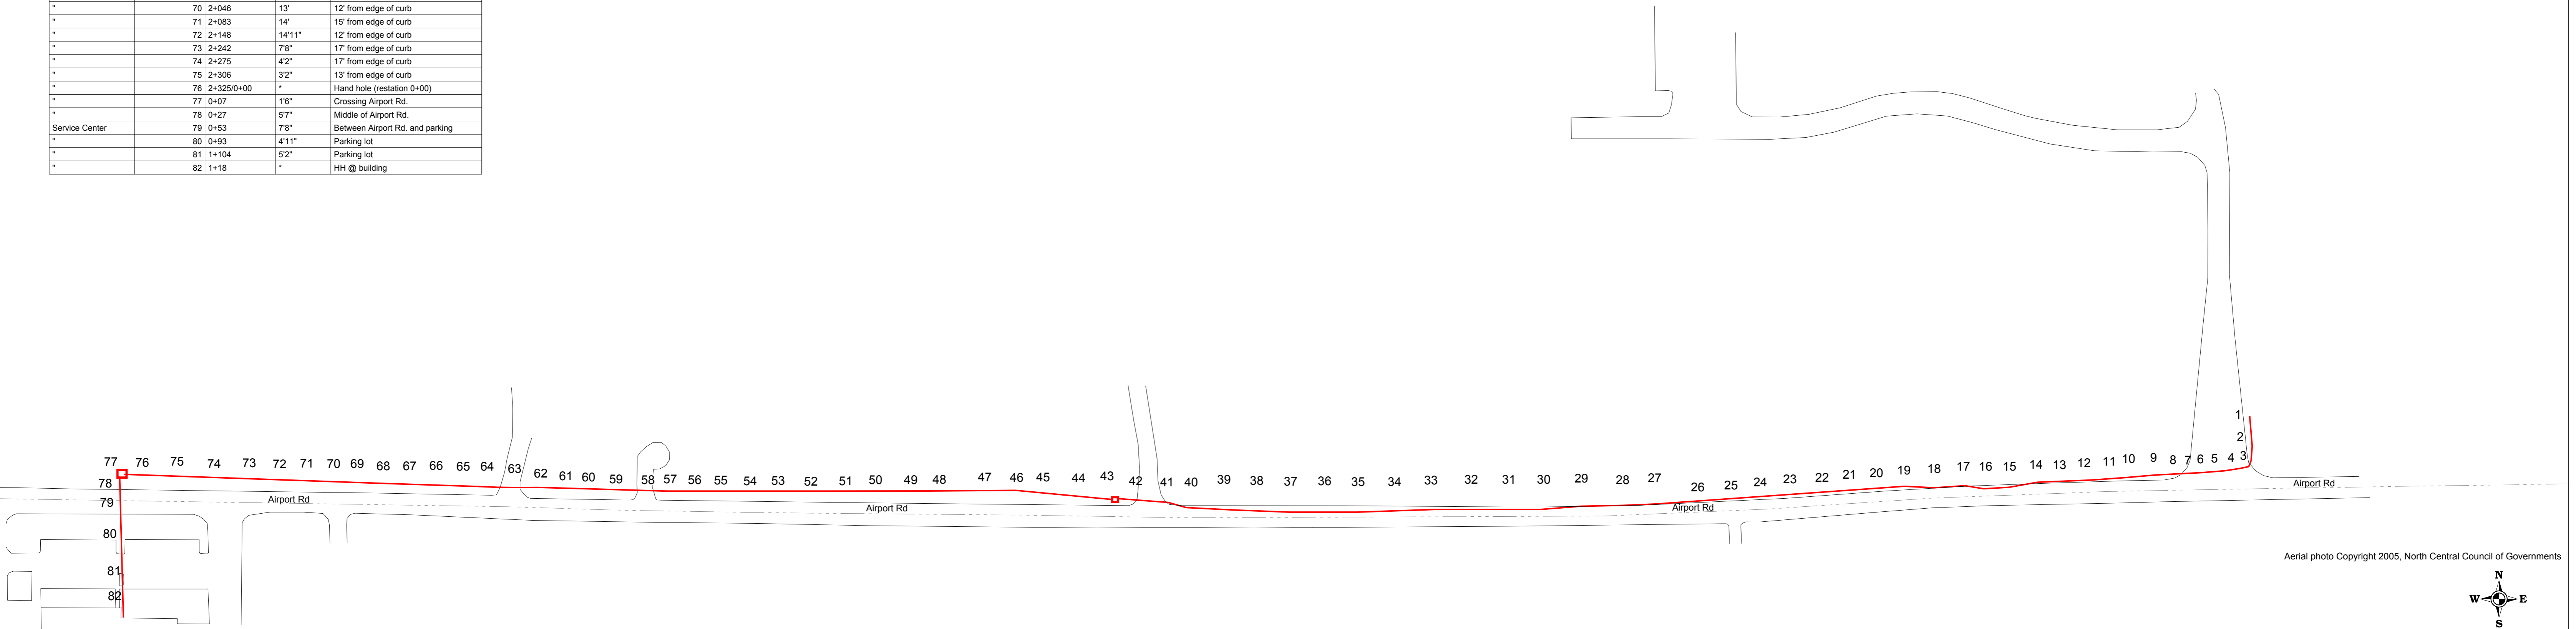

Based on Depths and Offsets provided by Joyn-Itt Communications, LLC. The map's maker holds no liability to the map's accuracy. Depths and offsets are approximates. Field verification is required prior to any and all excavation.