


NOTE:
 P-GRD ELEVATIONS
 REPRESENT TOP OF SOD.

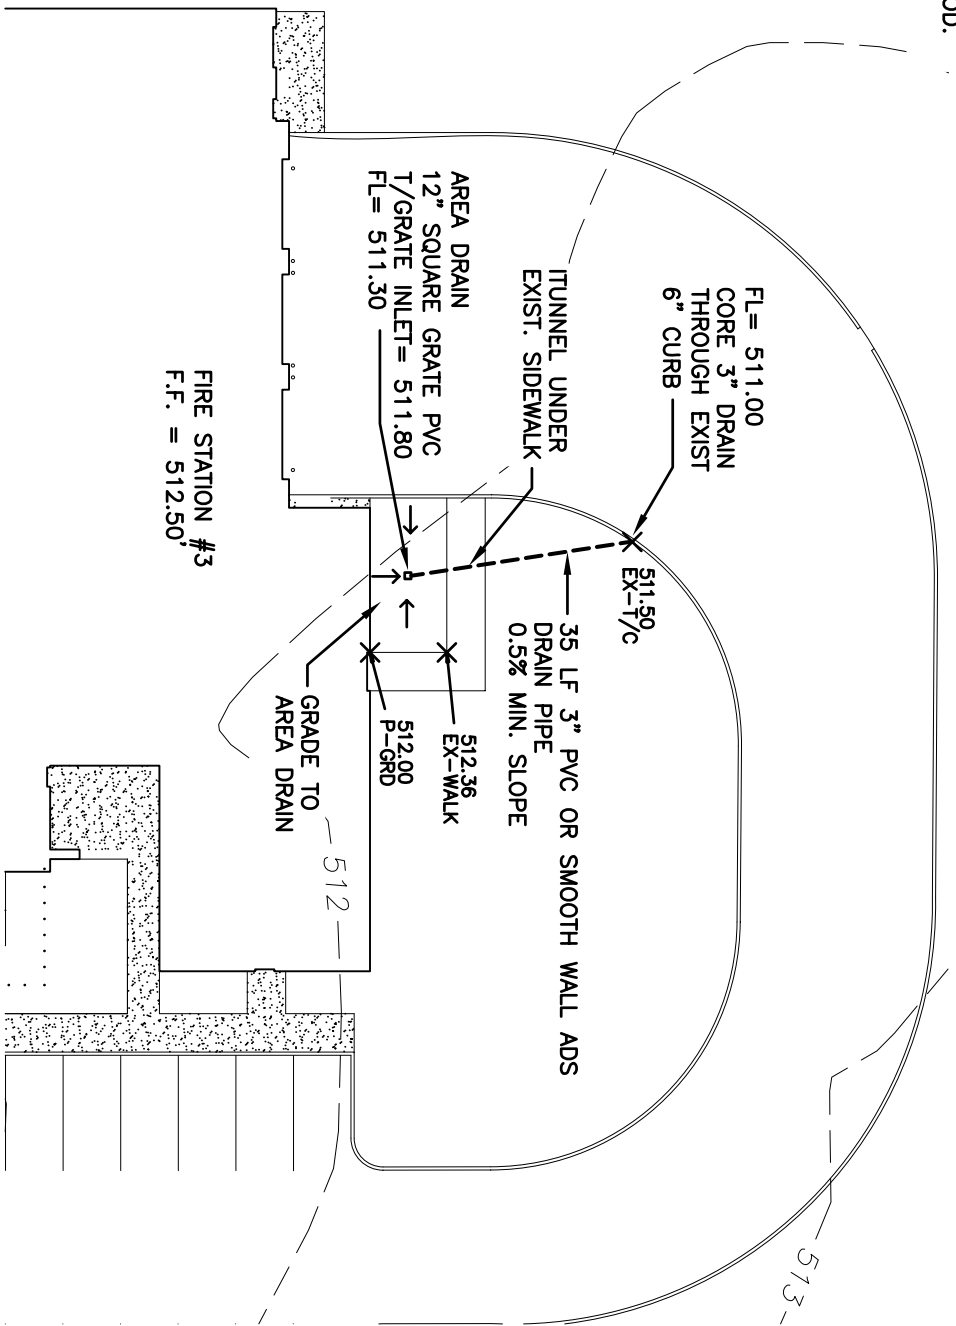

FIELD CHANGE #2-1

FIRE STATION #3



CITY OF ROCKWALL
 "THE NEW HORIZON"

SCALE
 1 inch = 30 ft.

DATE
 AUG 2009

DRAWING NAME