


**NOTE:**  
 P-GRD ELEVATIONS  
 REPRESENT TOP OF SOD.

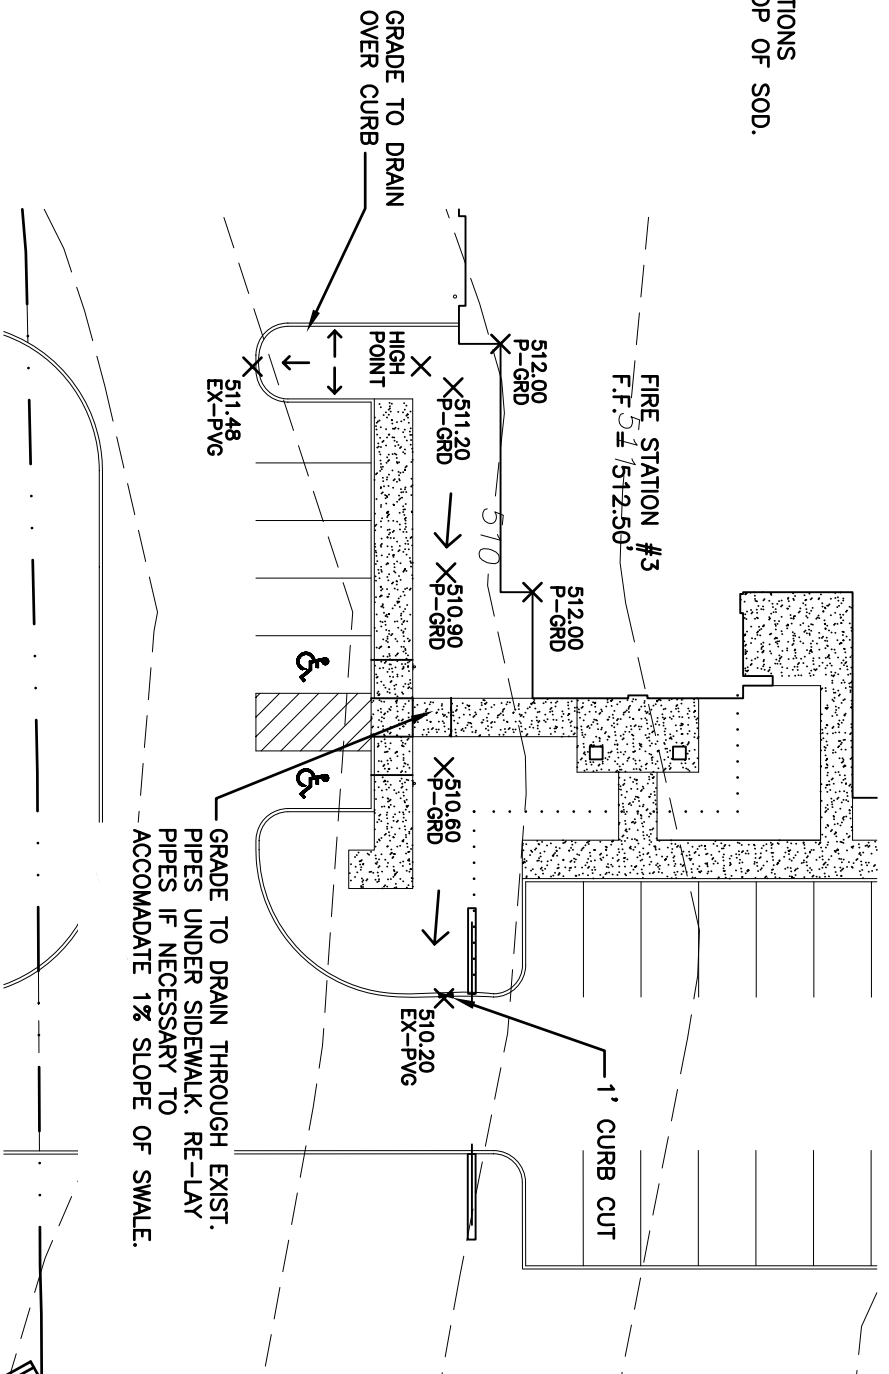

FIELD CHANGE #2-2

FIRE STATION #3



**CITY OF ROCKWALL**  
 "THE NEW HORIZON"

SCALE  
 1 inch = 30 ft.

DATE  
 AUG 2009

DRAWING NAME