
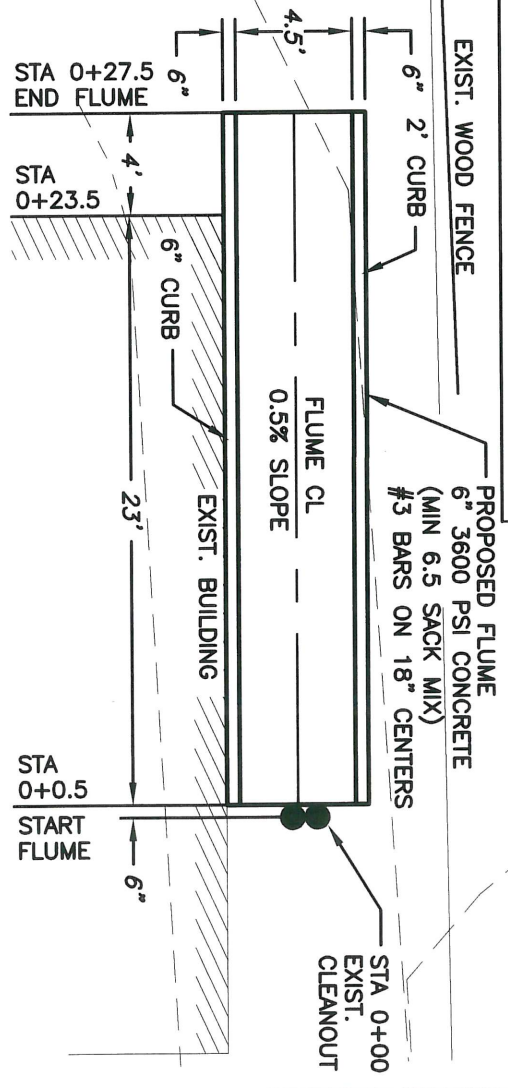
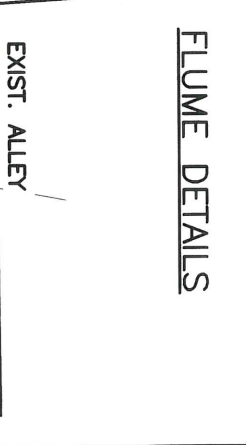
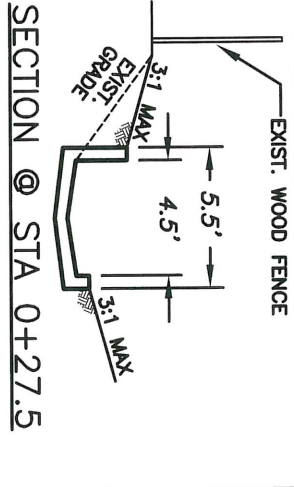
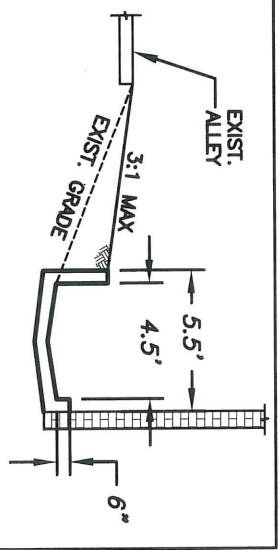


K. Lappen
 08-12-09

REVISED GRADING AT FLUME

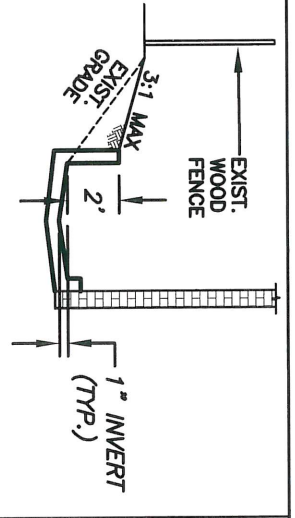

FIELD CHANGE #2-3

FIRE STATION #4



CITY OF ROCKWALL
 "THE NEW HORIZON"

SCALE
 NTS

DATE
 AUG 2009

DRAWING NAME