


# CONSTRUCTION PLANS FOR GLENN AVENUE UTILITY REHABILITATION CITY OF ROCKWALL, TEXAS

**MAYOR:**  
DAVID SWEET

**CITY MANAGER:**  
RICK CROWLEY

**COUNCIL MEMBERS:**

- DAVID WHITE, MAYOR PRO TEM, PLACE 1
- JIM PRUITT, PLACE 2
- BENNIE DANIELS, PLACE 3
- DENNIS LEWIS, PLACE 4
- SCOTT MILDER, PLACE 5
- MIKE TOWNSEND, PLACE 6

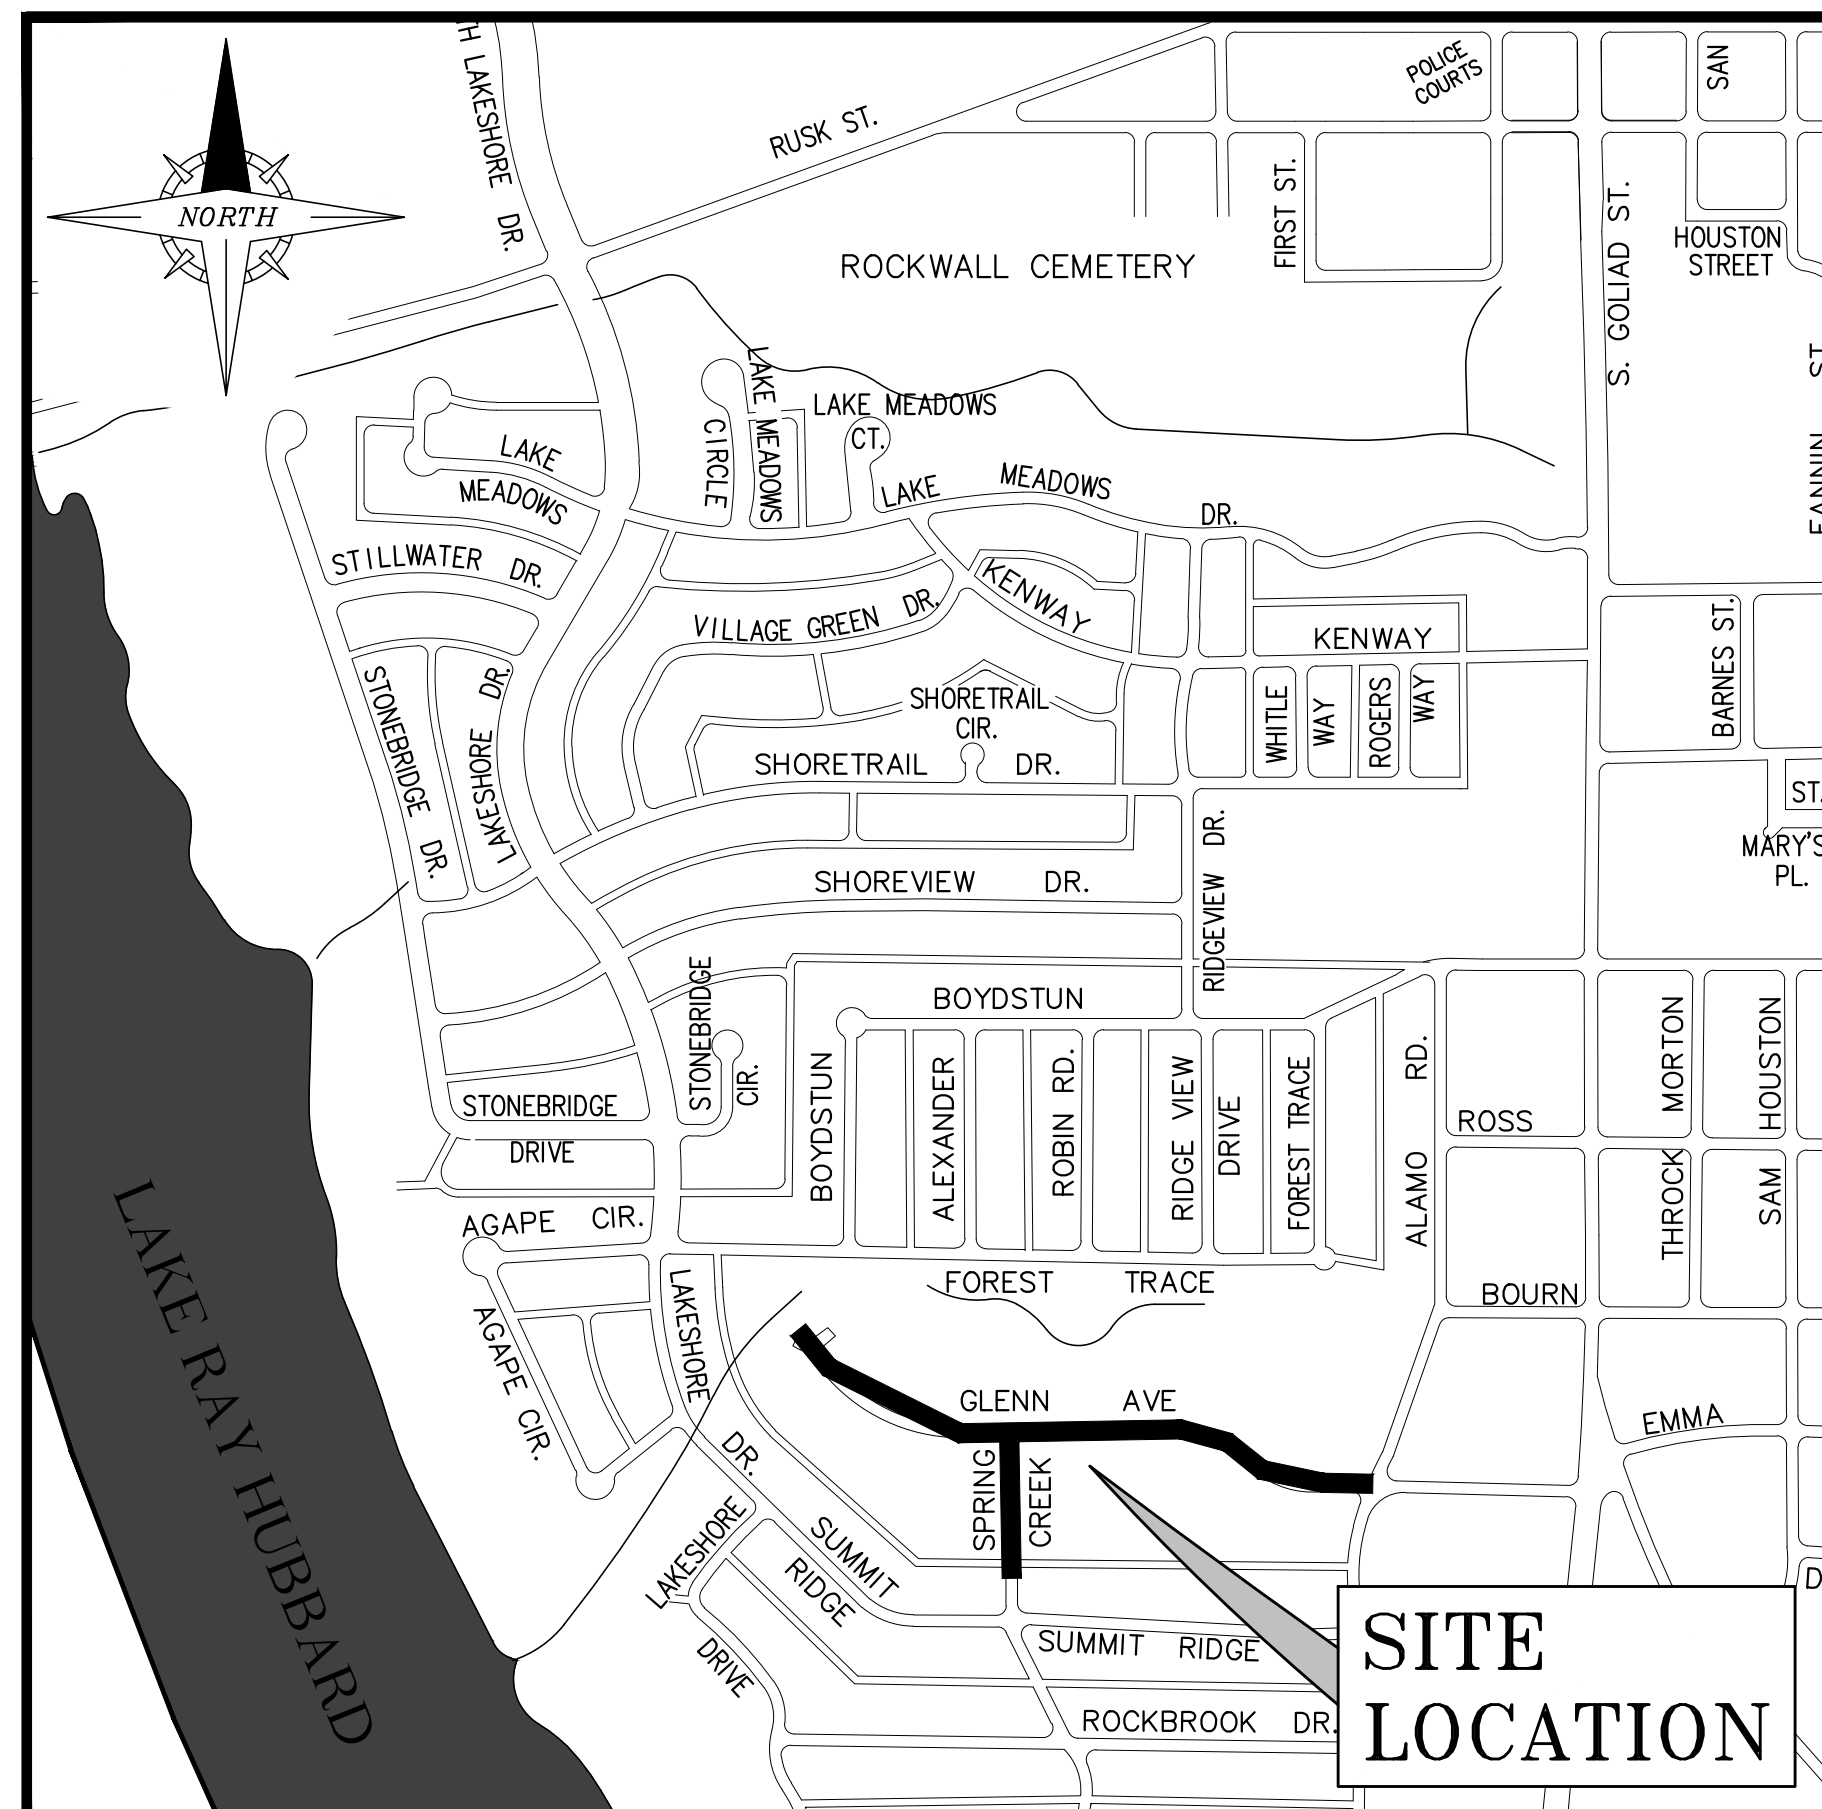

VICINITY MAP  
N.T.S.

INDEX OF SHEETS

- 1 COVER SHEET
- 2 GENERAL NOTES
- 3 PROJECT LAYOUT
- 4 PAVING PLAN
- 5 DRAINAGE AREA MAP & COMPUTATIONS
- 6 STORM SEWER PLAN & PROFILE
- 7-10 SAN. SEWER PLAN & PROFILE
- 11-15 WATER PLAN

NOTE: ALL CONSTRUCTION SHALL COMPLY WITH THE LATEST CITY OF ROCKWALL DESIGN STANDARDS AND NCTCOG 3<sup>RD</sup> EDITION SPECIFICATIONS.

**RECORD DRAWINGS**

THESE PLANS ARE A RECORD SET OF THE CONSTRUCTED PROJECT, AND REFLECT REVISIONS AND CONSTRUCTION-RELATED CHANGES AS MADE BY THE CONTRACTOR. CHANGES MADE FROM THE ORIGINAL CONSTRUCTION DOCUMENTS DO NOT DEPICT ENGINEERING AND ARE NOT THE RESPONSIBILITY OF VERDUNITY, INC. OR THE ENGINEER ON RECORD ON THE ORIGINAL DOCUMENTS. ORIGINAL PLANS RELEASED FOR CONSTRUCTION WERE SEALED BY KEVIN M. SHEPHERD, PE NO. 88642



**City of Rockwall**  
*The New Horizon*

CITY OF ROCKWALL  
ENGINEERING DEPARTMENT  
385 S. GOLIAD STREET  
ROCKWALL, TX 75087

## RECORD DRAWINGS

Engineer:



VERDUNITY, INC.  
17000 PRESTON ROAD, SUITE 110  
DALLAS, TEXAS 75248  
TEXAS FIRM NO. 13496  
www.verdunity.com  
(214) 425-6720