

BENCHMARKS

BENCHMARK #1
 SQUARE CUT ON TOP OF CURB NEAR
 SOUTHWEST CORNER OF 310 GLENN
 AVENUE.
ELEVATION=484.21

BENCHMARK #2
 SQUARE CUT ON TOP OF CURB AT THE
 SOUTHEAST CORNER OF THE INTERSECTION
 OF GLENN AVENUE AND SPRING CREEK
 DRIVE.
ELEVATION=513.68

BENCHMARK #3
 SQUARE CUT ON TOP OF CURB AT THE
 SOUTHEAST CORNER OF THE INTERSECTION
 OF GLENN AVENUE AND SOUTH ALAMO
 ROAD.
ELEVATION=584.00

VERDUNITY
A better future, by design.


17000 Preston Road, Suite 110, Dallas TX. 75248
 (214)425-6720
 www.verdunity.com
 Texas P.E. Firm Registration No. F-13496

**RECORD
 DRAWINGS**

ISSUE	DATE	DESCRIPTION
1	12/17/14	RECORD DRAWINGS

DESIGNED BY: E. MAGEE
 DRAWN BY: E. MAGEE
 CHECKED BY: K. SHEPHERD
 DATE: 12/16/2014
 JOB NUMBER: 004-002

RECORD DRAWINGS
 THESE PLANS ARE A RECORD SET OF THE CONSTRUCTED PROJECT, AND REFLECT REVISIONS AND CONSTRUCTION-RELATED CHANGES AS MADE BY THE CONTRACTOR. CHANGES MADE FROM THE ORIGINAL CONSTRUCTION DOCUMENTS DO NOT DEPICT ENGINEERING AND ARE NOT THE RESPONSIBILITY OF VERDUNITY, INC. OR THE ENGINEER ON RECORD ON THE ORIGINAL DOCUMENTS. ORIGINAL PLANS RELEASED FOR CONSTRUCTION WERE SEALED BY KEVIN M. SHEPHERD, PE NO. 88642

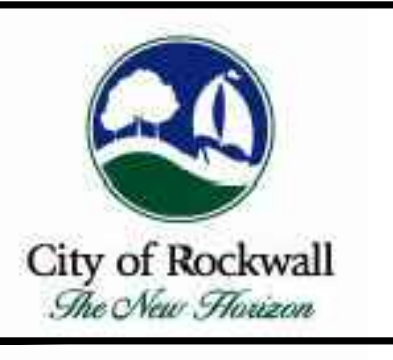

**GLENN AVE.
 UTILITY
 REHABILITATION**

**STORM SEWER PLAN AND
 PROFILE**

0 20' 40'

SHEET **06**