
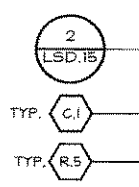


MATCHLINE LM.12


LAKE RAY HUBBARD

MATCHLINE LM.04


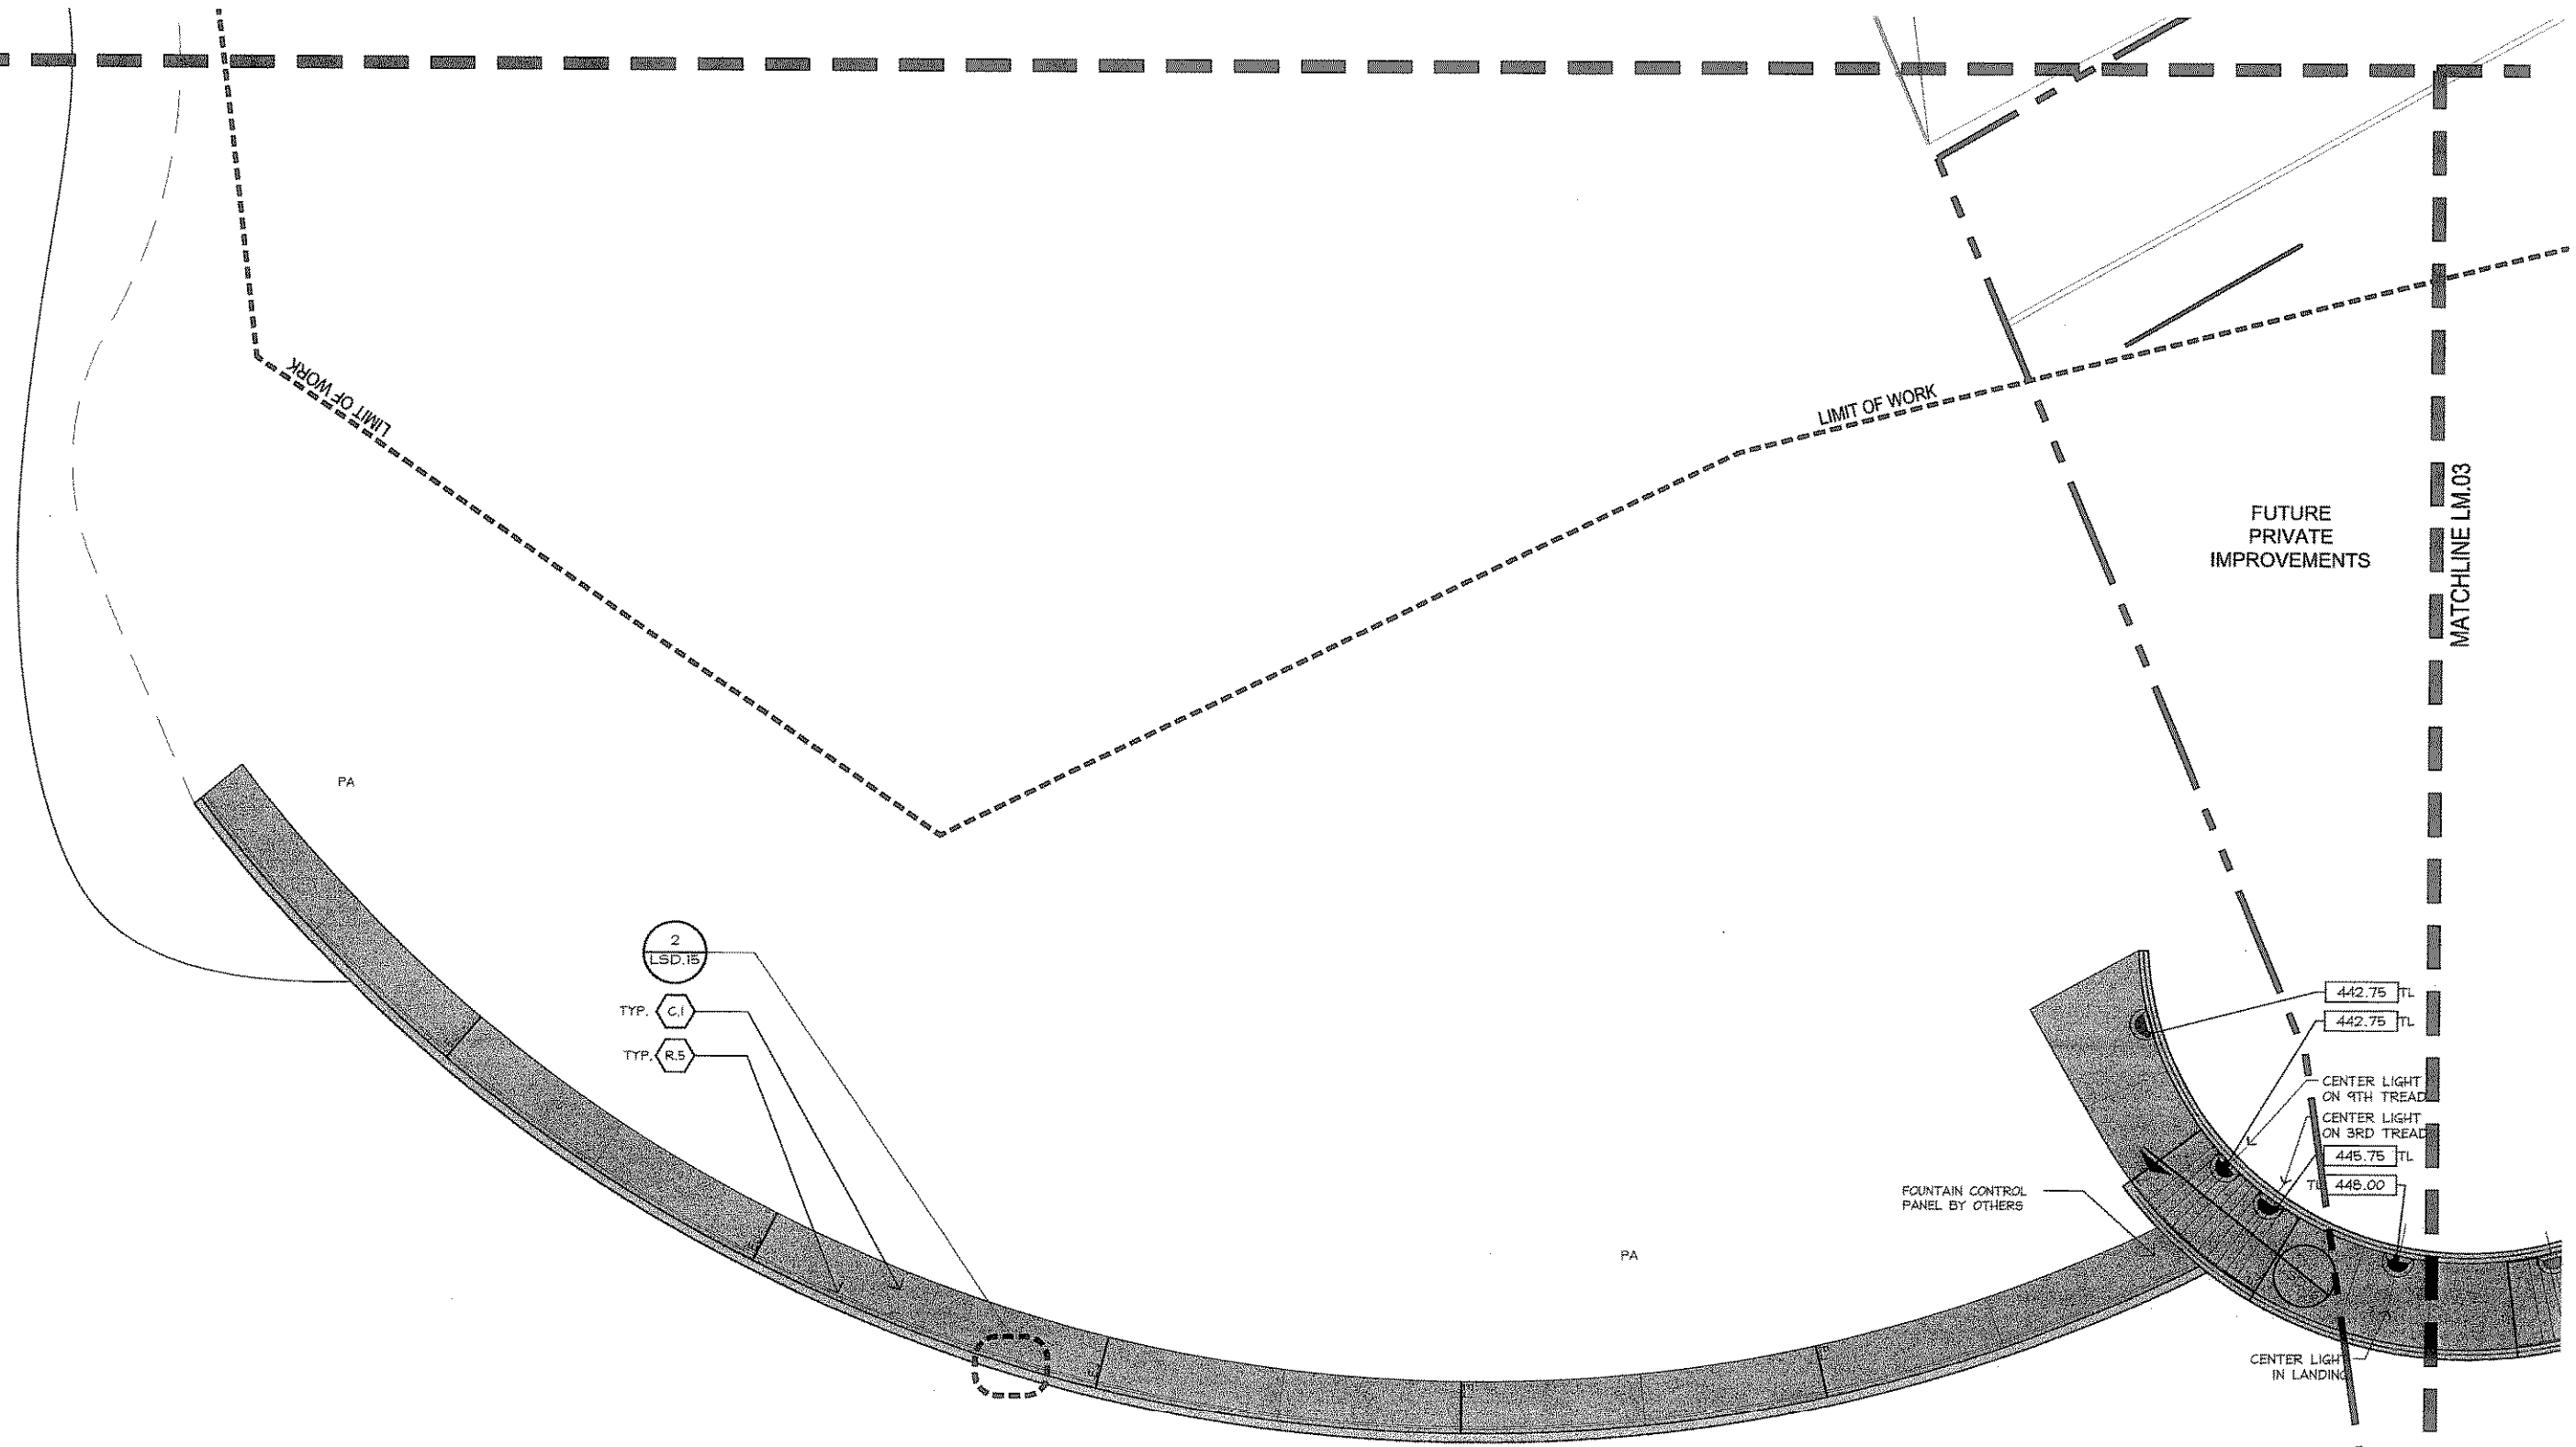


LIGHTING LEGEND

	A POLE TOP - 1 LUMINAIRE (SIDE MOUNT)		H POLE TOP - WALL MOUNT
	B WALL LIGHT		I IN-GRADE PATH LIGHT
	C STEP LIGHT		L BOLLARD
	D TREE UP-LIGHT		K BOLLARD - LUMINAIRE ONLY
	E WALL LIGHT		J IN-GRADE JUNCTION BOX
	F POLE TOP - 1 LUMINAIRE		M POLE
	G POLE LIGHT - 2 LUMINAIRES		TL PROPOSED TOP OF LIGHT ELEVATION

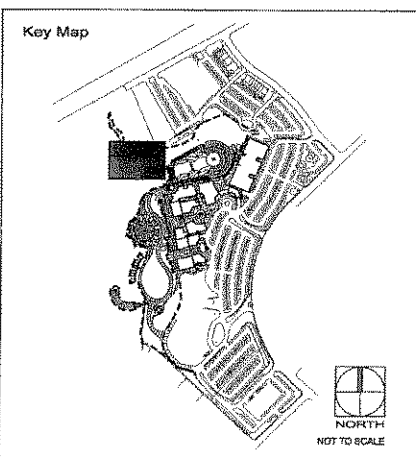

APPROVED FOR CONSTRUCTION
 DEC 15 2005
 City of Rockwall Engineering Dept.
 City Engineer: _____

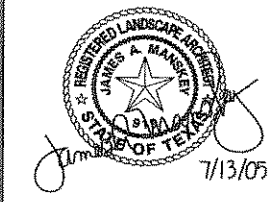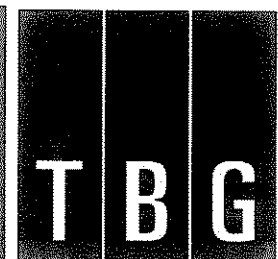

Landscape Architects • Planners
 302 North Market, Suite 450
 Dallas, Texas 75202
 214/744-0757 Fax: 214/744-6705
 Austin • Dallas • Houston • McAllen

Project:
City of Rockwall

**The Harbor
 Phase I
 Public Improvements**

Rockwall, Texas

Project Number:
D03991

Designed: **tbp**

Drawn: **bb**

Reviewed: **jm, kh**

Date Issued:
 13 July 2005

Revisions:

Sheet Title:
**Landscape Materials-
 South Passive
 Recreation Area**

Sheet Number:
LM. 11