



EX. 10 FORCE MAIN  
ELEVATION UNKNOWN

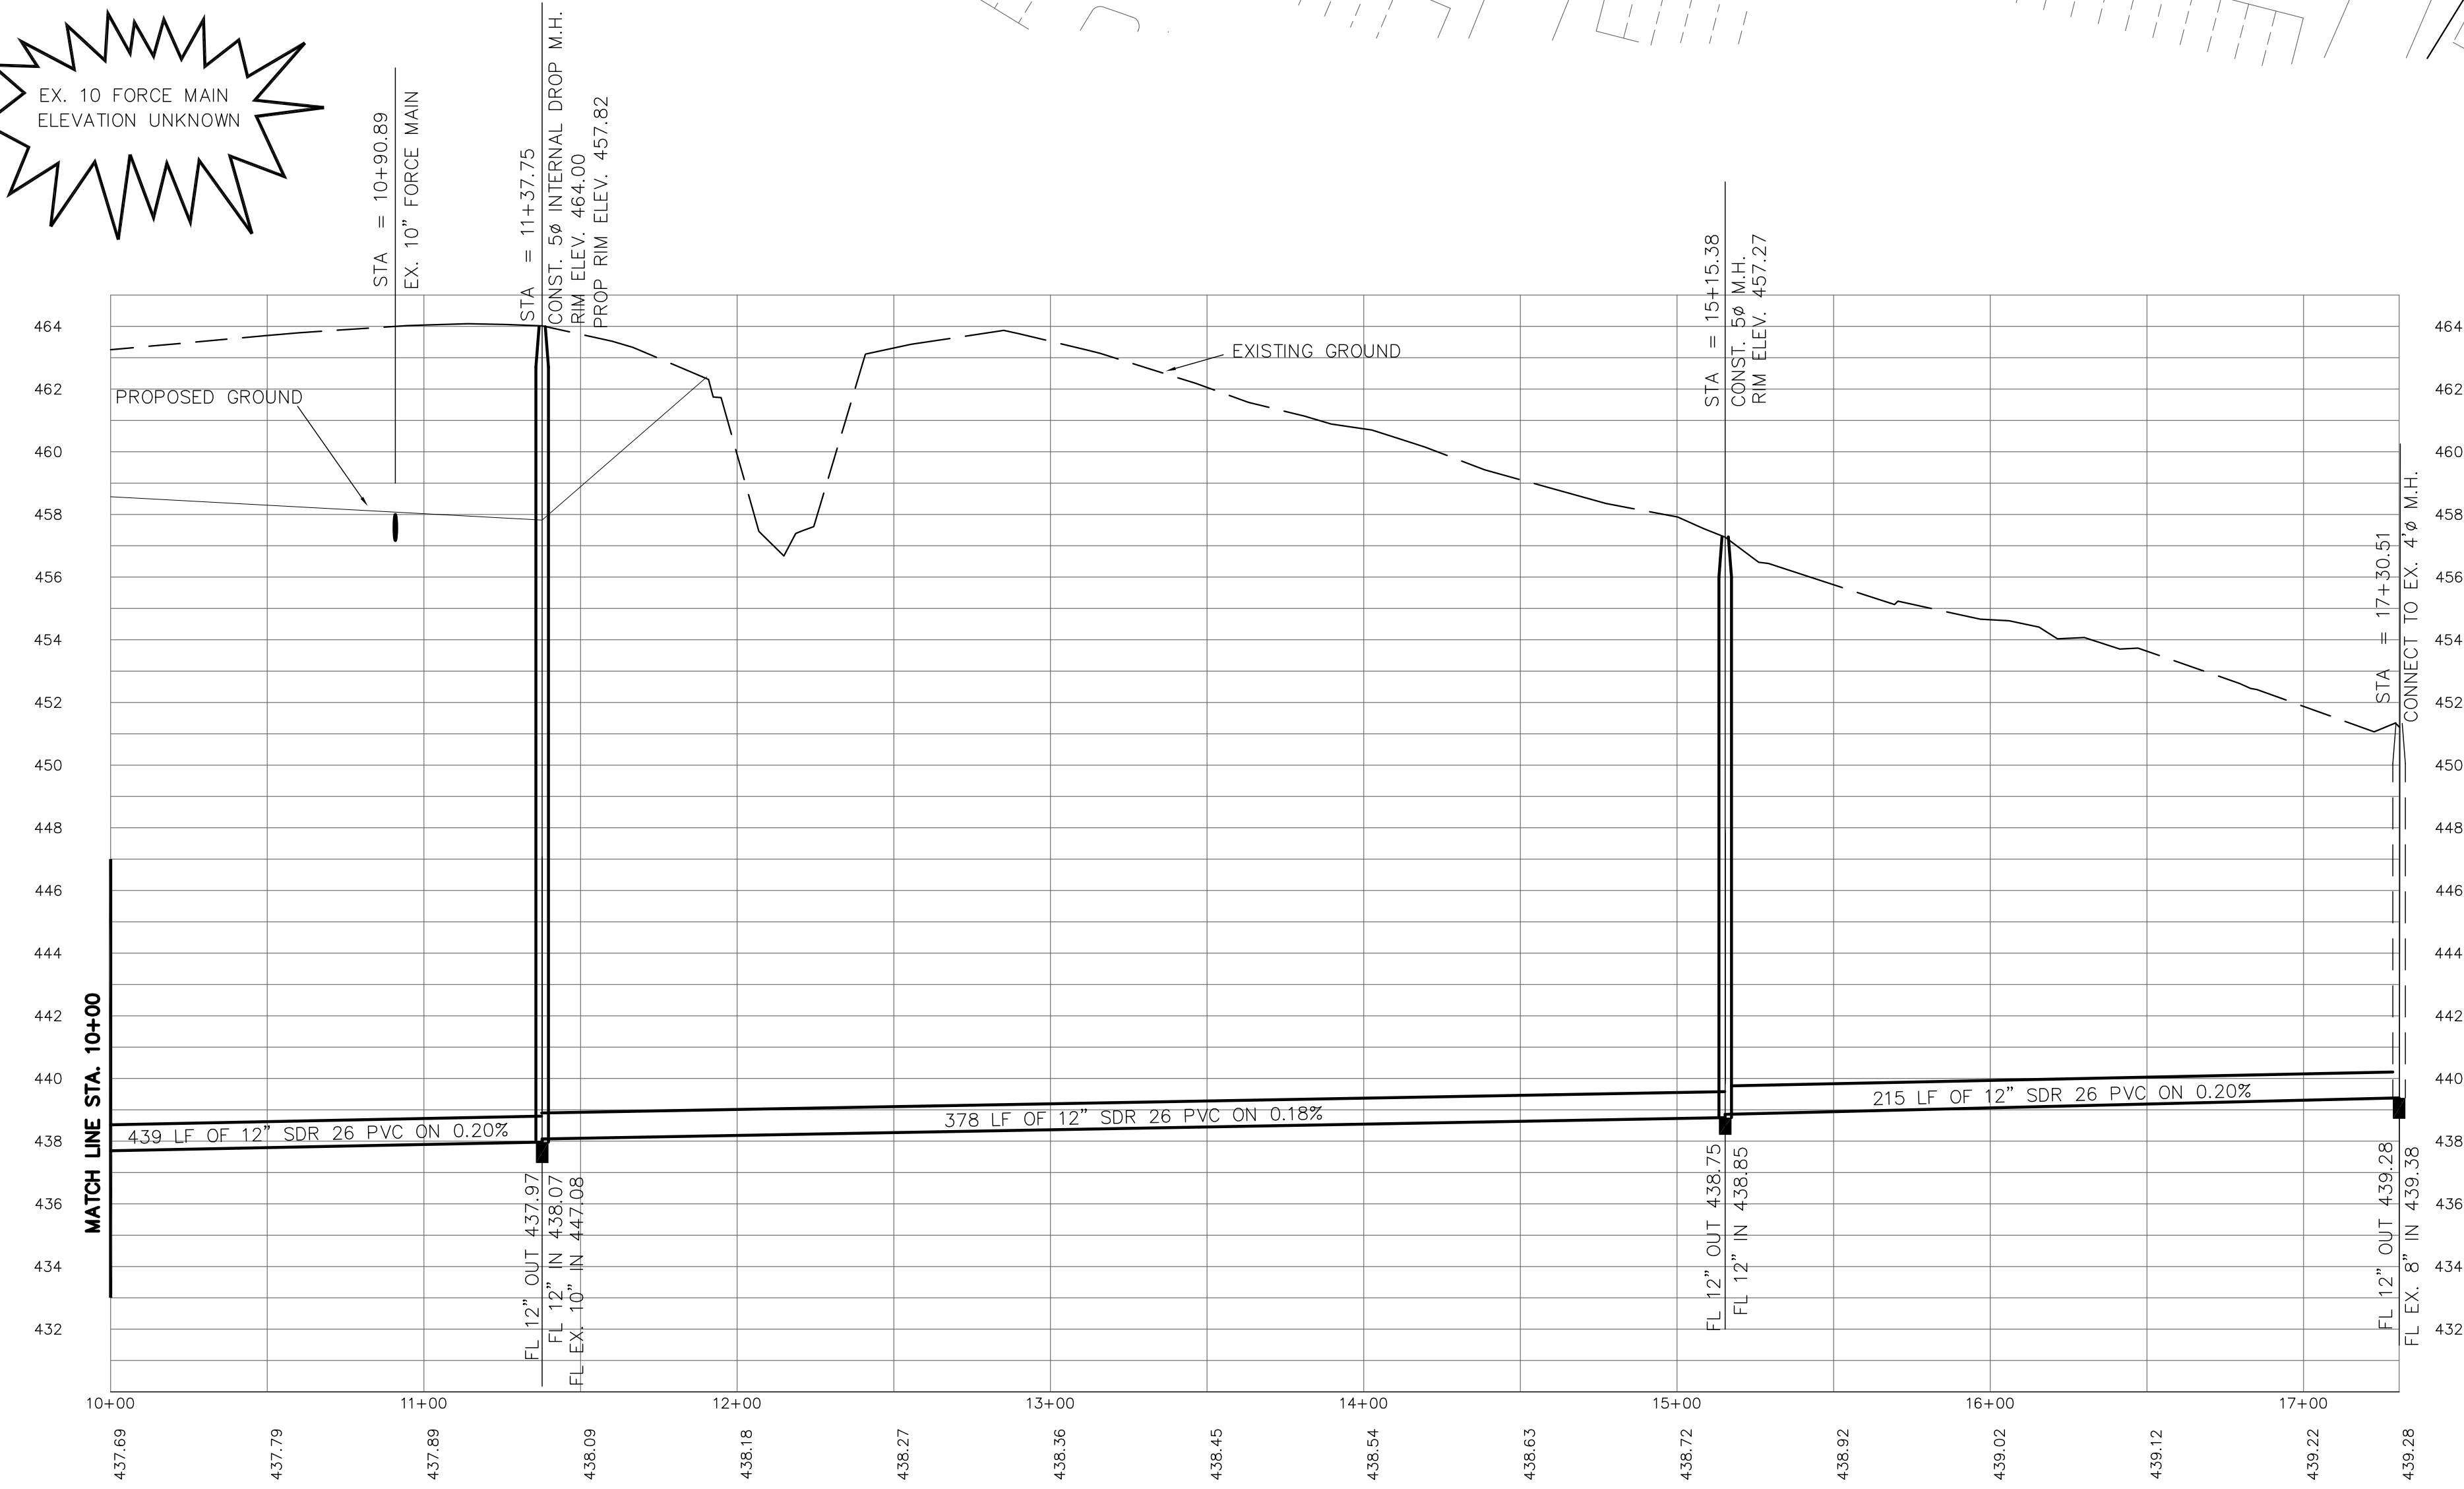

- NOTES:
1. ALL MANHOLES TO BE ADJUSTED TO FINAL GRADE BY OTHERS AT TIME OF DEVELOPMENT.
  2. INSTALL GREEN EMS DISK EVERY 100', CHANGE IN DIRECTION, MANHOLES, SERVICES, AND CLEANOUT SUBSIDIARY TO COST OF PIPE.
  3. USE MODIFIED CLASS B-2 (ROCK ALL AROUND PIPE) EMBEDMENT FOR GRAVITY LINE.
  4. USE CLASS B-3 (SAND ALL AROUND PIPE) EMBEDMENT FOR FORCE MAIN.

REVISION NO.	REMARKS	DATE

THE HARBORS 12" SANITARY SEWER  
STA. 13+00 TO 17+30.51  
ROCKWALL, TEXAS



CITY OF ROCKWALL  
"THE NEW HORIZON"

DESIGNED: A.J.W.	THE SEAL APPEARING ON THIS DOCUMENT WAS AUTHORIZED BY CHARLES A. TODD TEXAS P.E. NO. 55647 ON
DRAWN: ACAD	
DATE: 12/12/03	

SHEET NO. 3

