



**G** PIPE SUPPORTS  
DETAIL

SCALE: N.T.S.

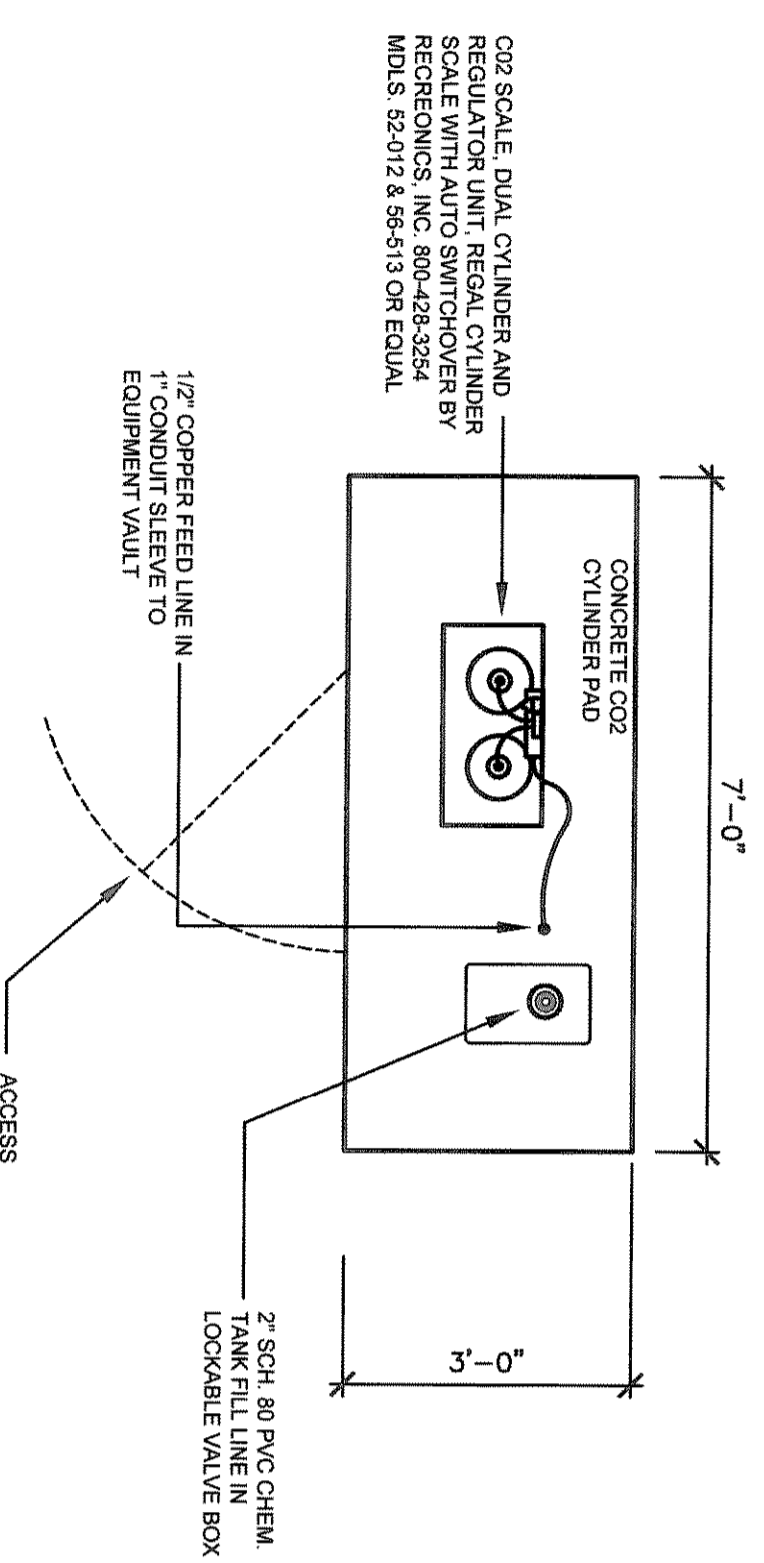

**F** HVAC / CO2 MOUNTING PAD  
PLAN

SCALE: N.T.S.

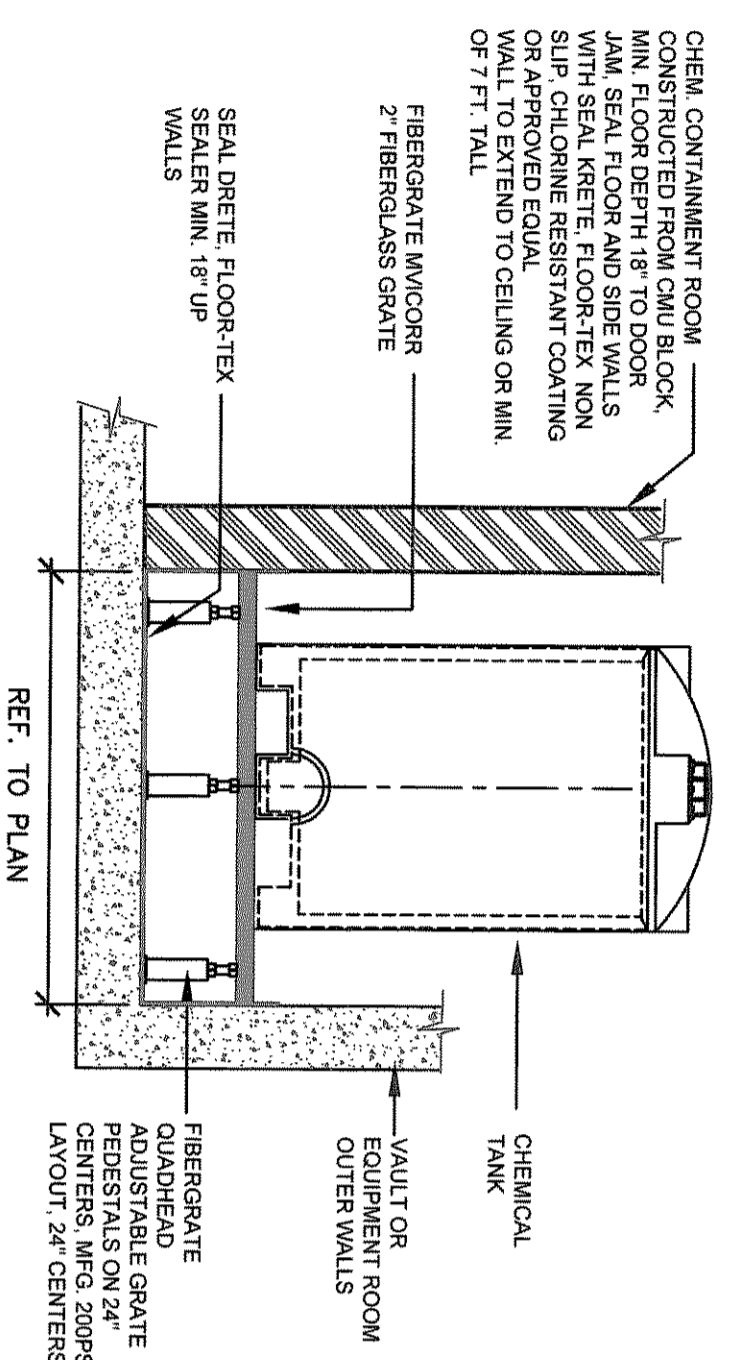

**E** TYPICAL VAULT AIR HANDLING UNIT MOUNTING  
ELEVATION

SCALE: N.T.S.

**DELETED**

**D** TYPICAL CHLORINE TANK CATCH BASIN DETAIL  
ELEVATION

SCALE: 1/2" = 1'-0"


**DELETED**

**C** PLAZA VAULT TTA-120B CONDENSING UNIT  
DETAIL

SCALE: NONE

**B** PLAZA VAULT TWE-120 AIR HANDLER  
DETAIL

SCALE: NONE

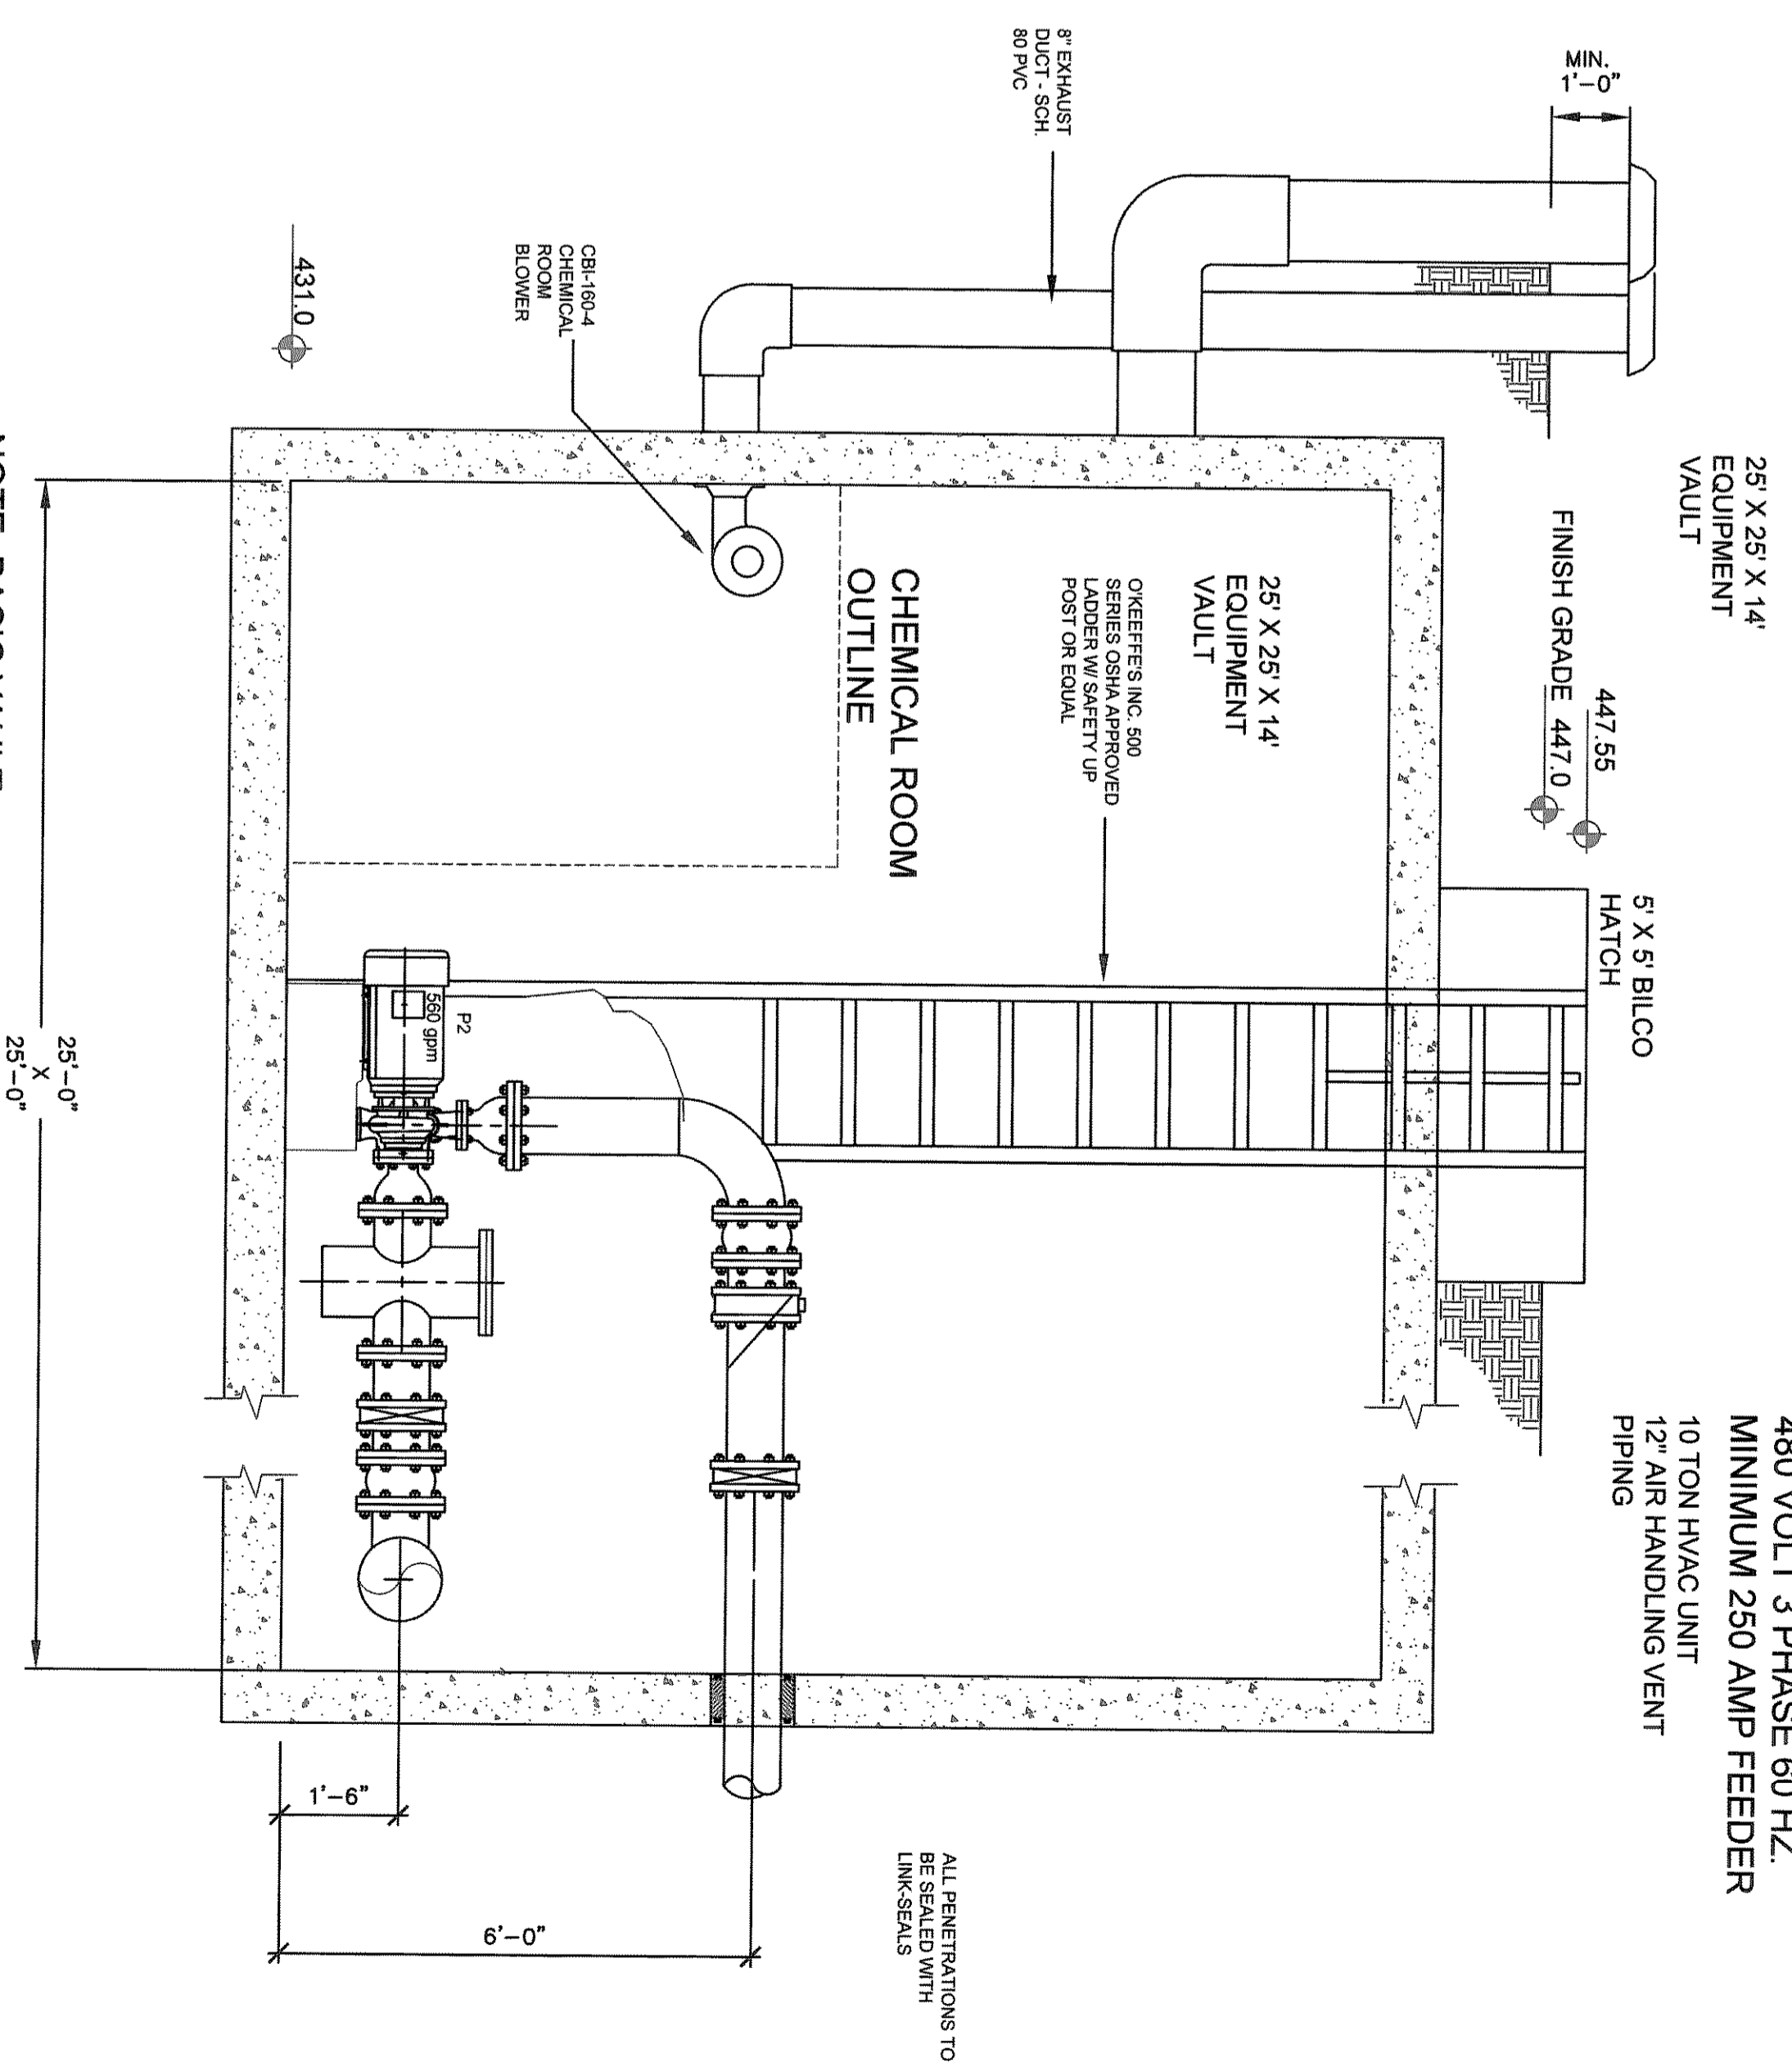

**A** PLAZA VAULT TYPICAL PUMP INSTALLATION  
ELEVATION

SCALE: 1/2" = 1'-0"

NOTE: BASIC VAULT ELEVATIONS REF. TO STRUCTURAL PLANS FOR CONSTRUCTION

**T B G**

**PARTNERS**  
Landscape Architects • Planners  
302 North Market, Suite 450  
Dallas, Texas 75202  
214/744-0757 Fax: 214/744-6785  
Austin • Dallas • Houston • McAllen

**Greenwave**  
Pump Services, Inc.

• DESIGN • CONSULTING • CONTRACTING •  
• SALES • SERVICE •  
Headquarters  
1425 Whitlock, Suite 108  
Cameron, Texas 77006  
Ph: 872-446-0301 Fax: 872-446-0313

© 2008 GREENWAVE PUMP SERVICES, INC.

THE HARBOR  
ROCKWALL, TEXAS

REGISTRATION

NO.	DESCRIPTION	DATE
1	DESIGN	07/17/08
2	AS BUILT	11/16/09

SHEET TITLE

LAKE SIDE  
EQUIPMENT VAULT  
PLAN

JOB NO. 4830  
DATE 12, 2008  
DRAWN BY: GJR  
FILE: 4830\_TTHEARBOR\_ASBUILT\_110708  
SHEET NUMBER

LW.12B