

# THE HARBOR ROCKWALL, TEXAS


REVISIONS

| NO. | DESCRIPTION       | DATE     |
|-----|-------------------|----------|
| 1   | POST BID ADDENDUM | 01/17/08 |
| 2   | AS BUILT          | 11/10/08 |


SHEET TITLE  
**LAKE SIDE  
 EQUIPMENT VAULT  
 PLAN**

JOB NO. 4830  
 DATE 12/28/05  
 DESIGNED BY: JLS  
 FILE: 4830 THEHARBOR\_ASBUILT\_110708  
 SHEET NUMBER

**LW.12C**

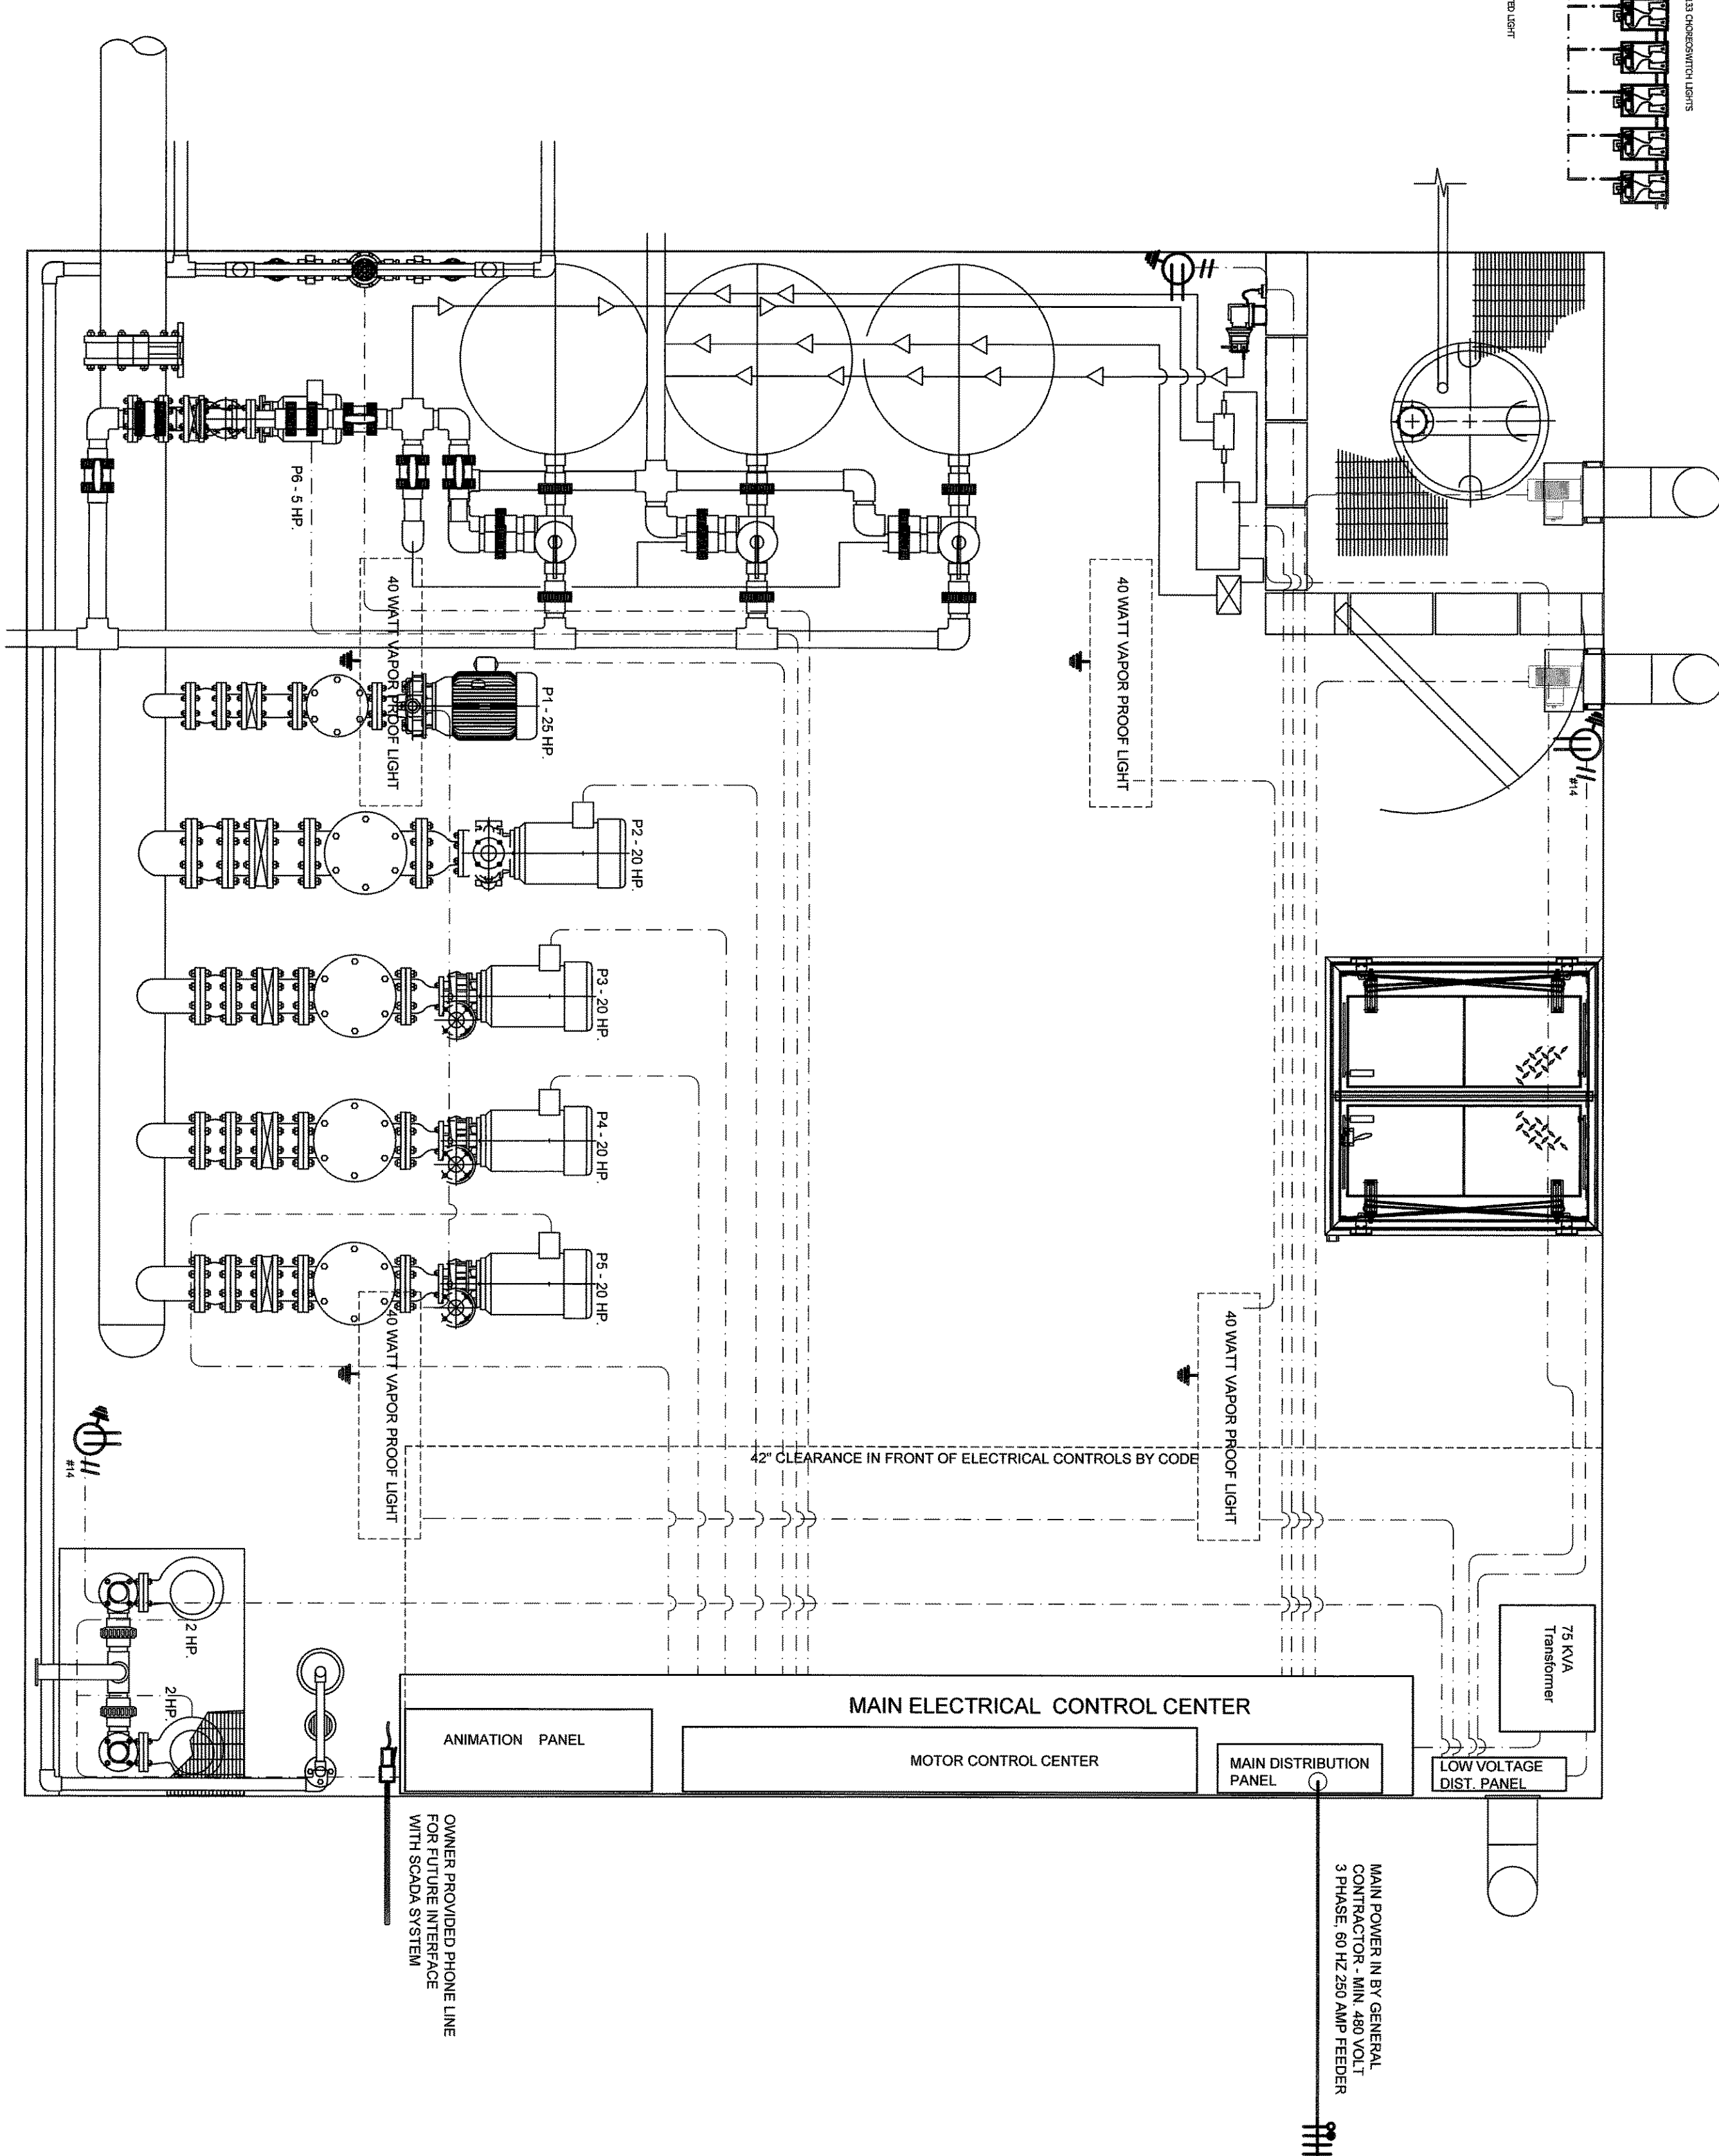

**A** PLAZA FEATURE VAULT ELECTRICAL  
 SCALE: 1/2" = 1'-0"

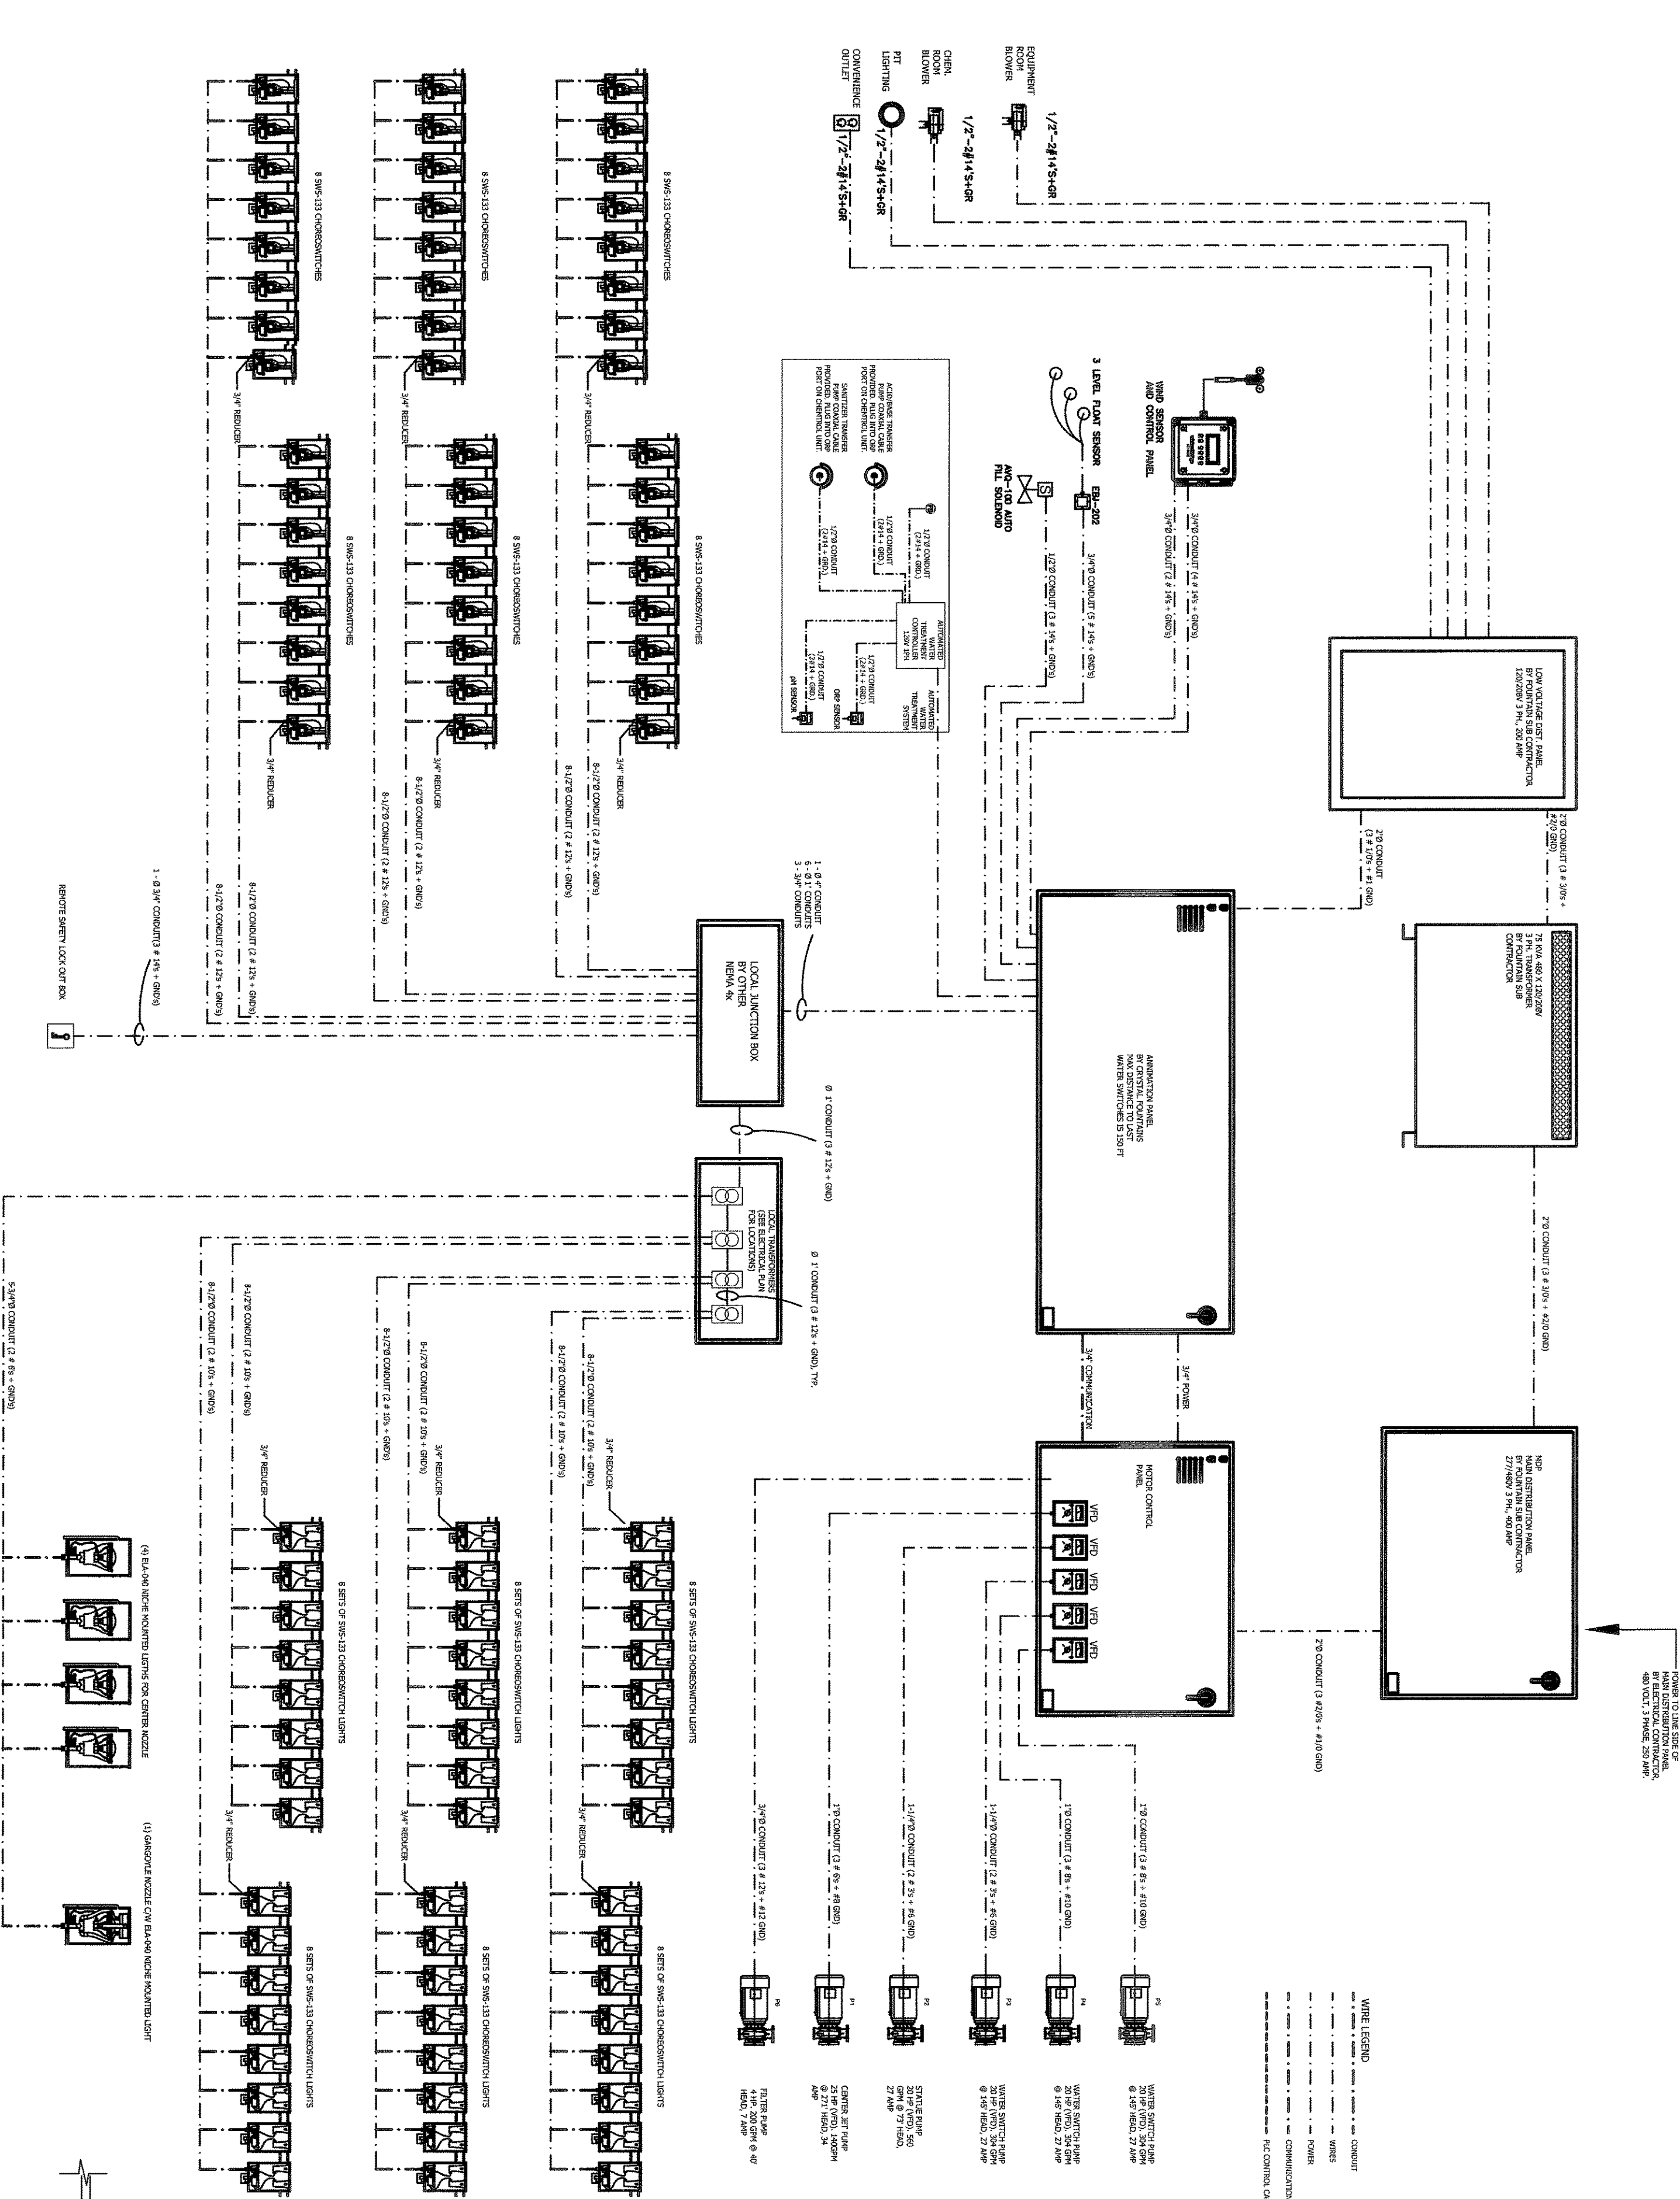

**B** PLAZA FEATURE OVERALL ELECTRICAL  
 SCHEMATIC  
 SCALE: NONE

IT SHALL BE THE FOUNTAIN SUB CONTRACTOR'S RESPONSIBILITY TO COORDINATE PLACEMENT OF ALL PIPING AND CONDUITS TO AVOID CONFLICTS WITH THE DRAINAGE SYSTEM SHOWN ON THE DR SERIES DRAWINGS.