

**THE HARBOR
 ROCKWALL, TEXAS**


REGISTRATION

No.	ISSUE/REVISIONS	DATE
1	POST-BID ADDENDUM	01/17/06
2	AS BUILT	11/20/06

SHEET NUMBER	SHEET TITLE
	PLAZA DISCHARGE PIPE ENLARGED PLAN

JOB NO. 4930
 DATE: REV. JULY 12, 2005 PK
 FILE: 4930_TTHEARBOR_CASBUILT_110706
 SHEET NUMBER

LW.09

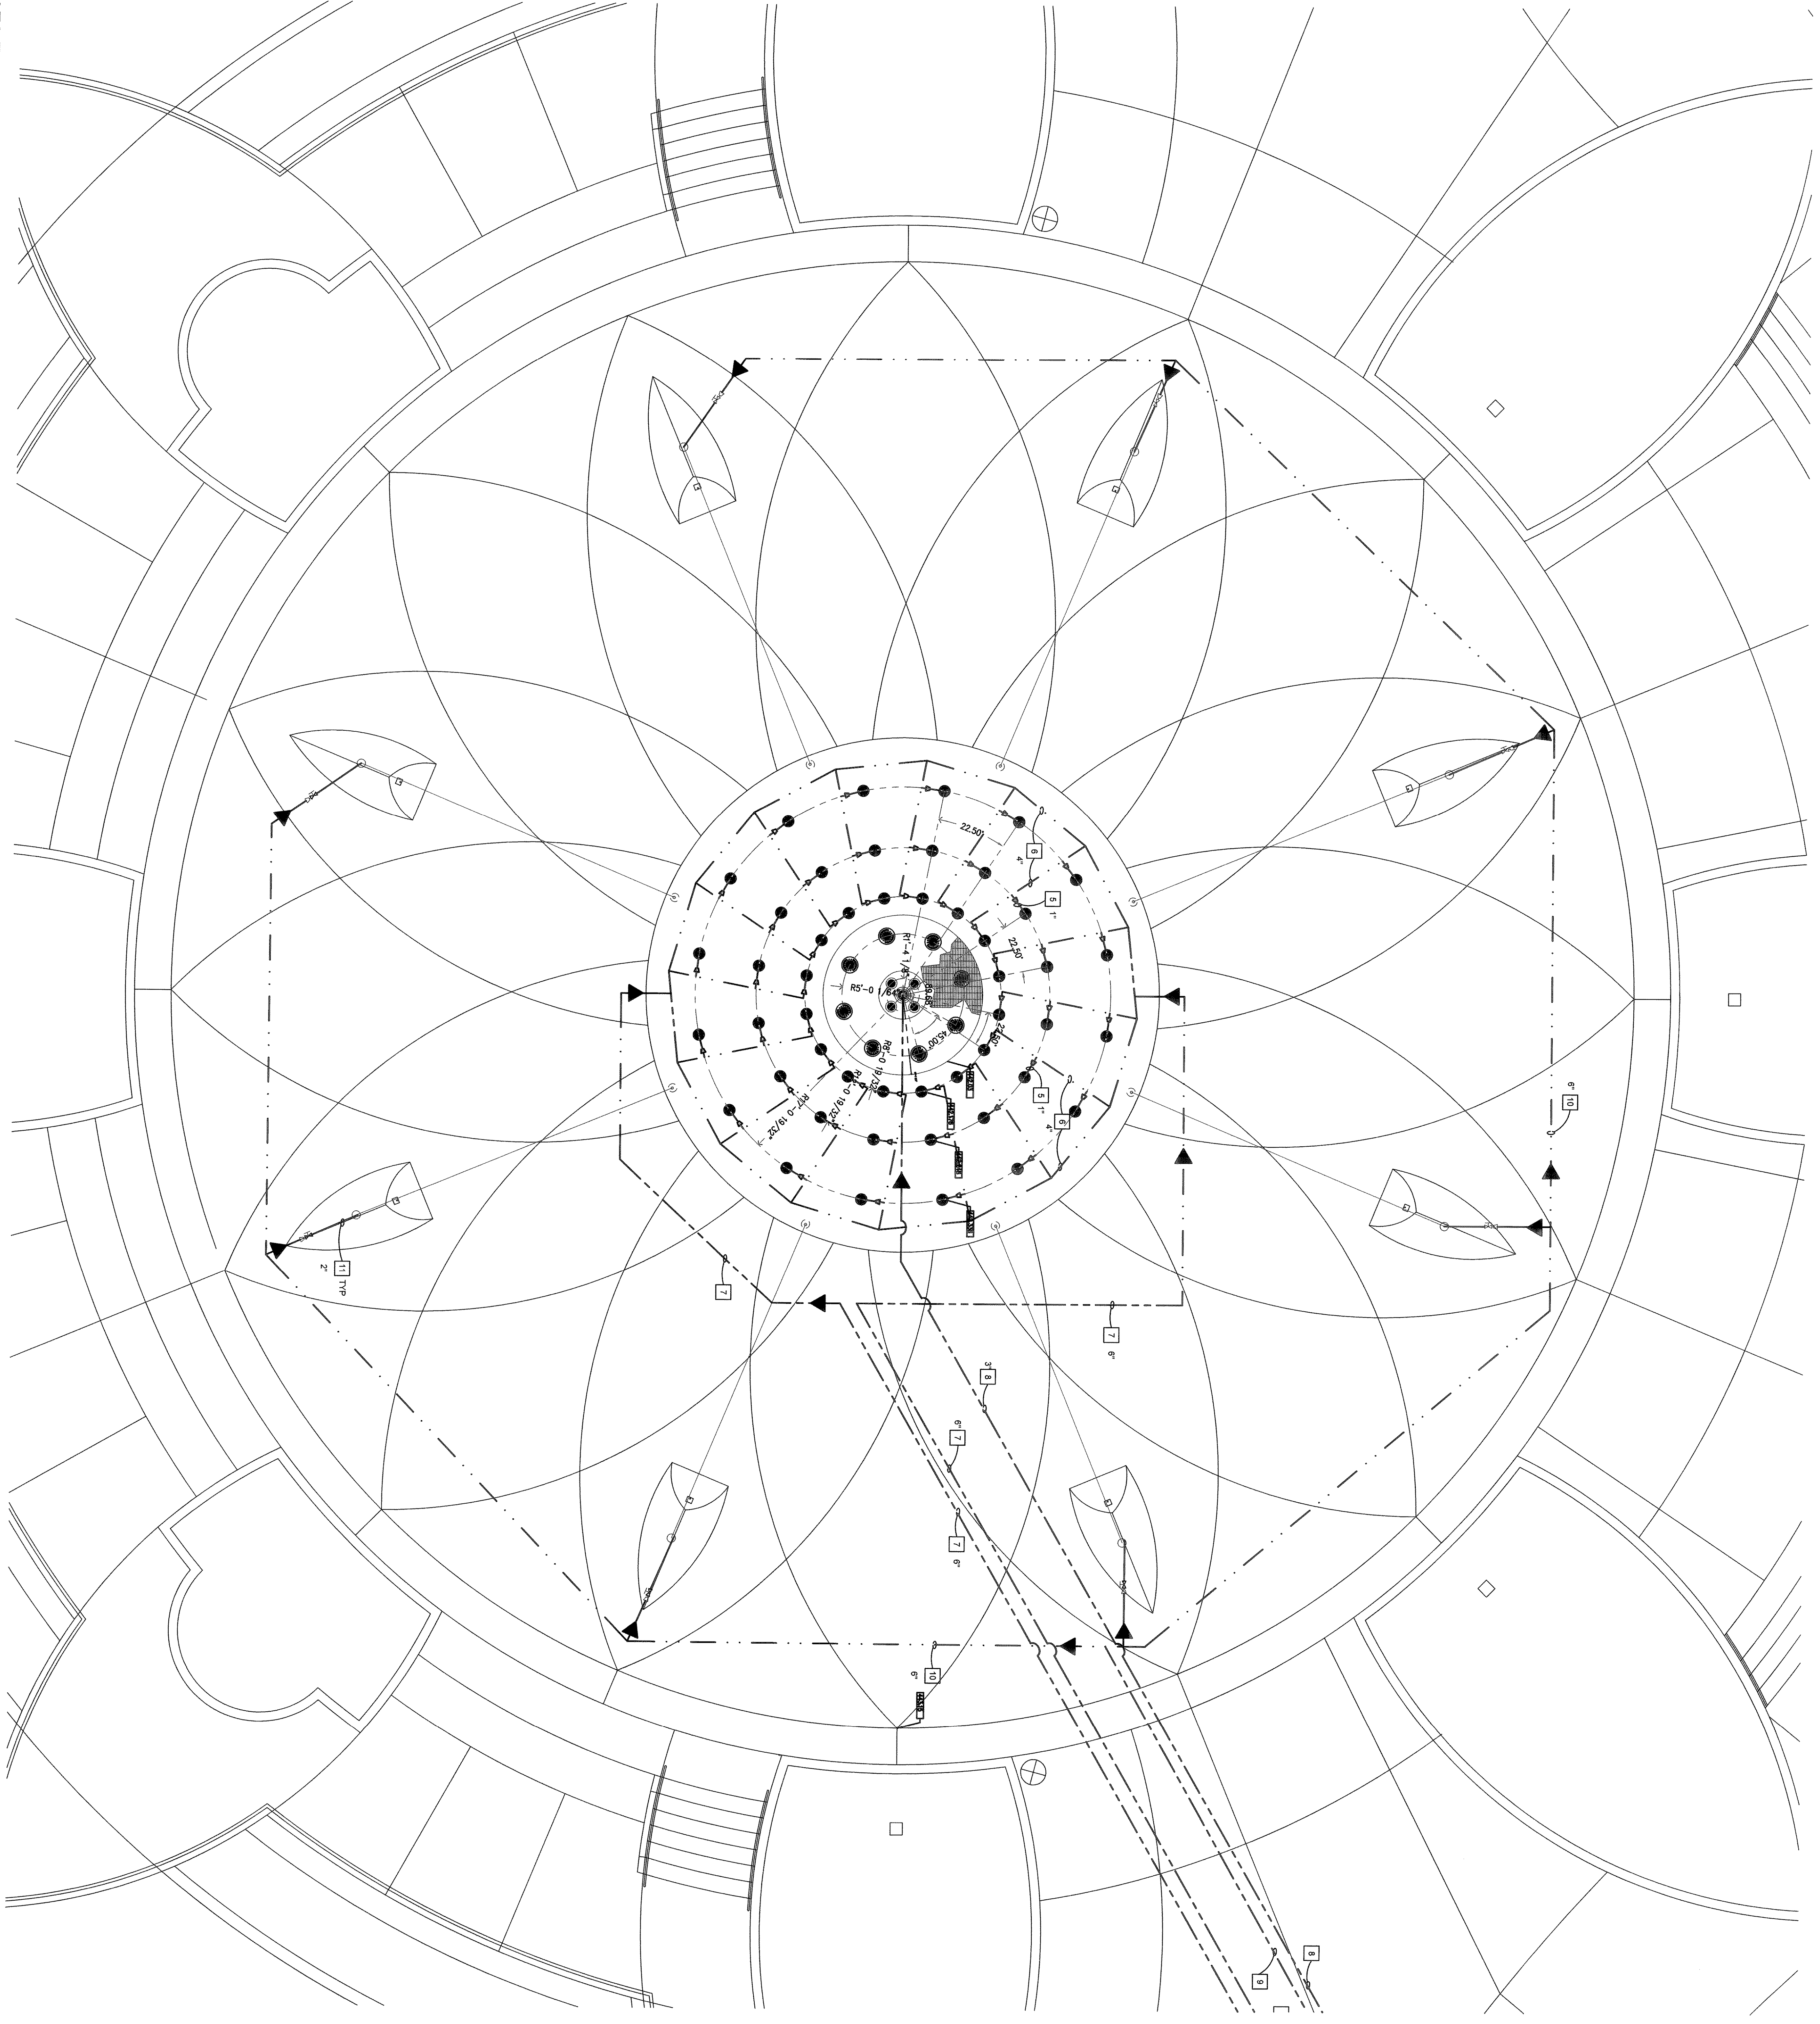

WATER FEATURE DISCHARGE PIPING LEGEND

SYM	SIZE	DESCRIPTION	#REQD
5	1"	SCH. 80 PVC WATERSWITCH SUPPLY AT FUTURE	48
6	4"	SCH. 80 PVC SUPPLY MANIFOLD PIPING TO WATERSWITCH SUPPLY	2
7	6"	SCH. 80 PVC MAIN SUPPLY TO 4" NOZZLE ASSEMBLY	2
8	3"	SCH. 80 PVC MAIN RETURN TO CENTER	1
8	6"	SCH. 80 PVC MAIN SUPPLY TO STATUE FEEDS	1
10	6"	SCH. 80 PVC LOOP SUPPLY TO STATUE FEEDS	2
11	2"	SCH. 80 PVC STATUE NOZZLE FEEDS	8

NOTE: REDUCE ALL PIPE SIZES AS NEAR AS POSSIBLE OR PENETRATIONS AS POSSIBLE.

PIPE SYSTEM, JOINT, FITTING, PIPING AND VALVE SCHEDULES SHALL BE AS SHOWN ON ONE'S ACTUAL ROUTING MAY VARY IN FIELD. SEE THE CONTRACTOR'S RESPONSIBILITY TO CORRECTIVE PLACEMENT OF THE MANIFOLD SYSTEM AND ON THE SERIES DOWNWARDS.

ELECTRICAL CONDUIT
 UNDERGROUND PIPING:
 UNDERWATER CABLE.

