

# CONSTRUCTION PLANS FOR **HIGHLAND DRIVE RECONSTRUCTION, PHASE I** **(DRIFTWOOD STREET TO BEDFORD FALLS LANE)** PAVING, DRAINAGE, WATER AND WASTEWATER IMPROVEMENTS CITY OF ROCKWALL, TEXAS SEPTEMBER 2018

**MAYOR**  
 JIM PRUITT

**MAYOR PRO-TEM**  
 KEVIN FOWLER (PLACE 3)

**COUNCIL MEMBERS**

<b>BENNIE DANIELS</b>	PLACE 1
<b>JOHN HOHENSHELT</b>	PLACE 2
<b>TRACE JOHANNESSEN</b>	PLACE 4
<b>DANA MACALIK</b>	PLACE 5
<b>PATRICK TROWBRIDGE</b>	PLACE 6

**CITY MANAGER**  
 RICK CROWLEY


**DIRECTOR OF PUBLIC WORKS/ CITY ENGINEER**  
 AMY WILLIAMS , P.E.

**PROJECT MANAGER**  
 JEREMY WHITE, P.E.



**OWNER**  
 CITY OF ROCKWALL  
 385 S GOLIAD ST.  
 ROCKWALL, TX, 75087  
 PH: (972) 771-7700

CITY CIP NO. : CIP-TR2018-001

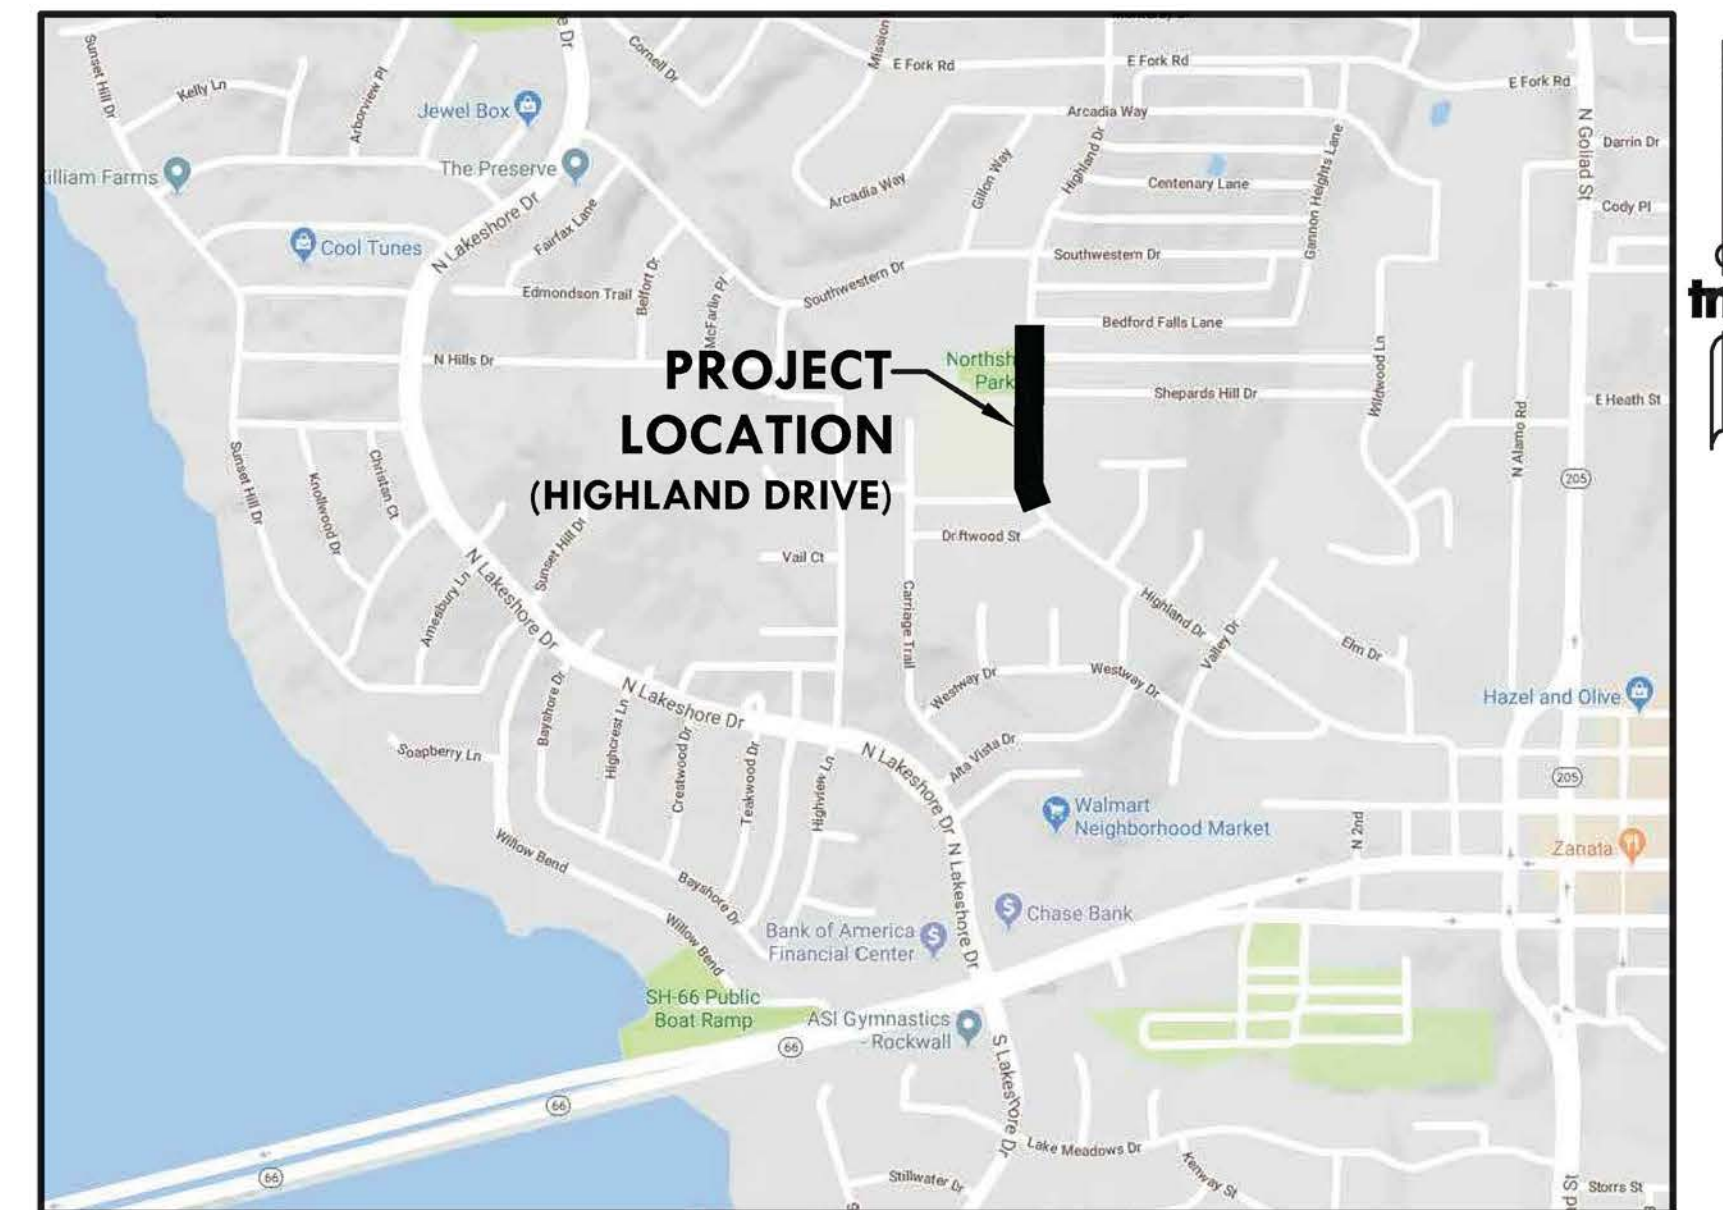

**LOCATION MAP**  
 NOT TO SCALE

**RECORD DOCUMENTS**

THESE PLANS ARE FOR THE OWNER'S USE AS RECORD SET OF THE CONSTRUCTED PROJECT, AND REFLECT REVISIONS AND CONSTRUCTION RELATED CHANGES AS RECORDED BY THE CONTRACTOR. CHANGES MADE FROM THE ORIGINAL CONSTRUCTION DOCUMENTS DO NOT DEPICT ENGINEERING AND ARE NOT THE RESPONSIBILITY OF TEAGUE MALL & PERKINS, INC. OR THE ENGINEER OF RECORD ON THE ORIGINAL DOCUMENTS. ORIGINAL PLANS RELEASED FOR CONSTRUCTION WERE SEALED BY GYANENDRA POKHREL, P.E. NO. 118159 ON 09/28/2018.

**SHEET LIST TABLE**

SHEET NUMBER	SHEET TITLE
00	COVER SHEET
01	GENERAL NOTES
02	GENERAL NOTES AND LEGEND
03	PROJECT CONTROL LAYOUT
04	QUANTITY SHEET
05	PAVEMENT TYPICAL SECTION
06	EXISTING CONDITIONS
07-09	EXISTING UTILITY PLAN
10	EROSION CONTROL PLAN
11-14	EROSION CONTROL DETAILS
15-14	TRAFFIC CONTROL PLAN
15	DEMOLITION PLAN
16	WATER LINE PLAN
17-21	WATER LINE DETAILS
22-23	WASTEWATER LINE PLAN
24-27	WASTEWATER LINE DETAILS
28	DRAINAGE AREA MAP
29	DRAINAGE AREA CALCS
30	STROM DRAIN PLAN & PROFILE
31-32	DRAINAGE DETAILS
33-41	PAVING PLAN & PROFILE
42-50	PAVING DETAILS
51-54	CROSS SECTIONS
55-56	SIGNAGE & STRIPING PLAN
57-58	SIGNAGE DETAILS



825 Watters Creek Blvd., Suite M300  
 Allen, Texas 75013  
 214.461.9867 ph 214.461.9864 fx  
 TBPE Firm No. F-230  
 TBPLS Firm No. 100116-00 / 100116-01  
 www.tnpsc.com