
## SUMMARY OF QUANTITIES

Item No.	I I a ta	None Description	Tatal Ou antitu	Plane Ot-		Sheet Number									
nem NO.	Unit	Item Description	Total Quantity	riuns wiy.	10	15	16	23	24	30	33	34	35	55	56
ENERAL, S	ITE PREP	PARATION AND DEMOLITION ITEMS													
1	LS	MOBILIZATION  TRAFFIC CONTROL PLAN, BARRICADES, SIGNS & RELATED DEVICES, IMPLEMENTATION &	1	1											
2	LS	MAINTENANCE	1	1											
3	EA	PROJECT SIGN	1	1											
4	SY	REMOVE AND DISPOSE OF CONCRETE PAVEMENT (INCLUDING CURB), DRIVEWAYS,	4,729			4729									
-	CV	ALLEYS (ALL DEPTHS AND TYPES)				2000									
6	SY	REMOVE AND DISPOSE OF CONCRETE SIDEWALK	3,000 291			3000 291									
7	EA	REMOVE AND DISPOSE OF TREES ( REGARDLESS OF SIZE)	7			7									
8	EA	REMOVE AND REINSTALL MAIL BOXES (POST STYLE)	1			1									
9	EA LF	REMOVE AND REINSTALL MAIL BOXES (BRICK TYPE)	6			6									
11	LF	REMOVE AND DISPOSE OF 18" STORM DRAIN PIPE (RCP) REMOVE AND DISPOSE OF 24" STORM DRAIN PIPE (RCP)	5	10	41	5							,		
12	EA	REMOVE AND DISPOSE OF 10' STD. CURB INLET	2			2									
WP3 AND E	ROSION	N CONTROL		P							1				
13	LS	STORMWATER POLLUTION PREVENTION PLAN & EROSION CONTROL (INSTALL, MAINTAIN AND REMOVE)	1		Ĩ										
14	SY	FURNISH AND INSTALL BLOCK SOD FOR DISTURBED AREA	1,100		1,100										
		NAGE ITEMS			r										
15 16		8" THICK REINFORCED CONCRETE STREET PAVEMENT INCL. CURB (3600 PSI) 6" THICK REINFORCED CONCRETE STREET PAVEMENT INCL. CURB (3600 PSI)	4,358 355				-				1530 272	1852 83	976		
17	ASSAC	6" THICK REINFORCED CONCRETE STREET FAVEMENT INCL. CORB (3800 FSI)	294								83	211			.6
18		7"- 5"-7" REINFORCED CONCRETE ALLEY	192	2	G.						75	75	42		
19	SY	REINFORCED CONCRETE SIDEWALK INCLUDING LEADWALK (4" THICK, 3000 PSI)	833								266	336	231		
20 21	SY LF	EXPOSED AGGREGATE CONCRETE LIDEWALK (4" THICK, 3000 PSI)  12" WALL INTEGRAL TO SIDEWALK W/ STONE VENEER (3000 PSI)	101	1					,		2	2	101		
22	SY	6" THICK FLEXBASE (COMPACT IN PLACE)	5,023								1955	1998	1070		
23	EA	BARRIER FREE RAMP- COR DIRECTIONAL CURB RAMP	4								2	2			
24	CONTRACTOR OF THE PROPERTY OF	BARRIER FREE RAMP- TXDOT TYPE 7	8								4	4			
25 26	EA EA	BARRIER FREE RAMP- TXDOT TYPE 10 BARRIER FREE RAMP- MIDBLOCK, TXDOT TYPE 2	2		44						1	2	2		
27	LF	CONSTRUCT STREET HEADER	37		21						37				
28	LF	CONSTRUCT LONGITUDINAL BUTT JOINT	525								173	262	90		
29	LF	STORM SEWER 18" RCP CLASS III	5							5					
30 31	EA	STORM SEWER 24" RCP CLASS III CONSRUCT 10' STD. CURB INLET	2							7 2					
32	LF	TRENCH SAFETY FOR SD PIPE INSTALLATION	12							12					
ATER ITEM	S						j								
33	LF	INSTALL 8" WATER LINE AWWA C900-DR14 PVC PIPE BY OPEN CUT	1,036				1036								
34	EA	INSTALL 8" AWWA C509 RESILIENT-SEATED GATE VALVE	13				13			à-					
35 36	EA EA	INSTALL 6" AWWA C509 RESILIENT-SEATED GATE VALVE INSTALL STD. FIRE HYDRANT ASSEMBLY AND LEAD	4				2								
37	EA	ABANDON WATER VALVE IN PLACE (REGARDLESS OF SIZE)	7				7								
38	EA	REMOVE AND REPLACE 1" SERVICE (SHORT SIDE)	1				1								
39	EA	REMOVE AND REPLACE 1" SERVICE (LONG SIDE)	6				6								
40 41	EA TON	REMOVE AND REPLACE 2" SERVICE LINE DUCTILE IRON FITTINGS	2.0	-			2.0							-	E 6
42	EA	CUT AND PLUG EXISTING 8" WATER LINE	5				5								
43	EA	CUT AND PLUG EXISTING 6" WATER LINE	1				1								
44	LF IF	12" WATER LINE CONCRETE ENCASEMENT (6" MINIMUM, 2,000PSI OR GREATER) TRENCH SAFETY DESIGN & IMPLEMENTATION FOR WATER LINE CONSTRUCTION	21				1036			21					
45 46	EA	REMOVE AND REPLACE WATER METER BOX	1,036				8								
47	EA	RELOCATE WATER METER	6				6								
48	EA	RECONNECT EX. FIRE HYDRANT INCLUDING LEAD	2				2	,							
49 50	EA LS	REMOVE AND SALVAGE FIRE HYDRANT AND RETURN TO CITY WATER LINE TESTING AND STERILIZATION	1				1 1								
30	LS	WATER LINE TESTING AND STERILIZATION					,								
ASTEWATE	ER ITEMS	s													
51	LF	REMOVE AND DISPOSE OF EXISTING 6" WASTEWATER PIPE INCL. TRENCH BACKFILL	55					,,,,,,	55						
52 53	EA EA	ABANDON CONCRETE MANHOLE  REMOVE/ABANDON AND DISPOSE OF WASTEWATER CLEANOUT	1 2					1 1	1						
54	LF	INSTALL 8" SDR-26 PVC WASTEWATER PIPE (INCL. EMBEDMENT)	745					502	243						
55	EA	INSTALL 4' DIA STD. CONCRETE MANHOLE	5		4			5							
56 57	EA	INSTALL STD. WASTEWATER CLEANOUT ON 8" MAIN	2					_	2						
<i>57</i> 58	EA EA	INSTALL 4" WASTEWATER SERVICE LINE (INCL. CLEANOUT) AND CONNECT TO EXISITNG CORE DRILL INTO EX. MANHOLE AND REBUILD INVERT	8					5	3					-	
ARARI Marina	F2/505							500	0.40	Ž.				*	-
59	LF	TRENCH SAFETY DESIGN & IMPLEMENTATION FOR WASTEWATER LINE CONSTRUCTION	745					502	243						
60	LF	VIDEO INSPECTION OF WASTEWATER LINES (PRE-, AND POST PROJECT)	745					502	243	C					
GNAGE AN	אואוכחי	REMOVE AND SALVAGE EXISTING SIGN AND RETURN TO CITY (REGARDLESS OF SIZE													
61	EA	AND TYPE)	8											7	1
62		REMOVE AND DISPOSE OF EXISTING FOUNDATION FOR FOR SCHOOL ZONE FLASHING	1												
	0.700	SIGN	OSSET-TET		-									1	
63	LF	INSTALL 24" PIANO BAR STYLE CROSSWALK THERMOPLASTIC STRIPING (W)	288 130											288	10
64	LF	INSTALL 12" SCHOOL ZONE THERMOPLASTIC STRIPING BAR (W) INSTALL TRAFFIC SIGN (INCL. POLE, HARDWARE AND FOUNDATION) (REGARDLESS OF		) (1	G.									26	10
65	EA	TYPE, NUMBER OF PLATES AND SIZE)	30											16	14
66	EA	REMOVE AND RELOCATE/REINSTALL EXISTING SIGN (REGARDLESS OF SIZE AND TYPE)	1											1	
67	EA	INSTALL SCHOOL ZONE FLASHING BEACON SIGN WITH SOLAR PANEL (INCL. POLE,	2												
~ .	LA	HARDWARE AND FOUNDATION)												2	
533															
LTERNATE	5888	10" THICK ELEVRASE (COMPACT IN DIACE)	E 000								1055	1000	1070		
59.1	SY	10" THICK FLEXBASE (COMPACT IN PLACE) UNCLASSIFIED STREET EXCAVATION	5,023 3,635	3635							1955	1998	1070		

by date revision

teague nall and perkins, inc 825 Watters Creek Blvd., Suite M300 Allen, Texas 75013 214.461.9867 ph 214.461.9864 fx www.tnpinc.com TBPE: F-230; TBPLS: 10011600, 10011601, 10194381



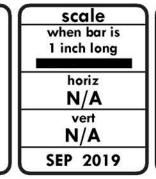



## RECORD DOCUMENTS THESE PLANS ARE FOR THE OWNER'S USE AS RECORD SET OF THE CONSTRUCTED PROJECT, AND REFLECT REVISIONS AND CONSTRUCTION RELATED CHANGES AS RECORDED BY THE CONTRACTOR. CHANGES MADE FROM THE ORIGINAL CONSTRUCTION DOCUMENTS DO NOT DEPICT ENGINEERING AND ARE NOT THE RESPONSIBILITY OF TEAGUE NALL & PERKINS, INC. OR THE ENGINEER OF RECORD ON THE ORIGINAL DOCUMENTS. ORIGINAL PLANS RELEASED FOR CONSTRUCTION WERE SEALED BY GYANENDRA POKHREL, P.E. NO. 118159 ON 09/28/2018. CITY OF ROCKWALL, TEXAS HIGHLAND DRIVE RECONSTRUCTION, PHASE I (DRIFTWOOD STREET TO BEDFORD FALLS LANE) QUANTITY SHEET

tnp project RWL18219 sheet