
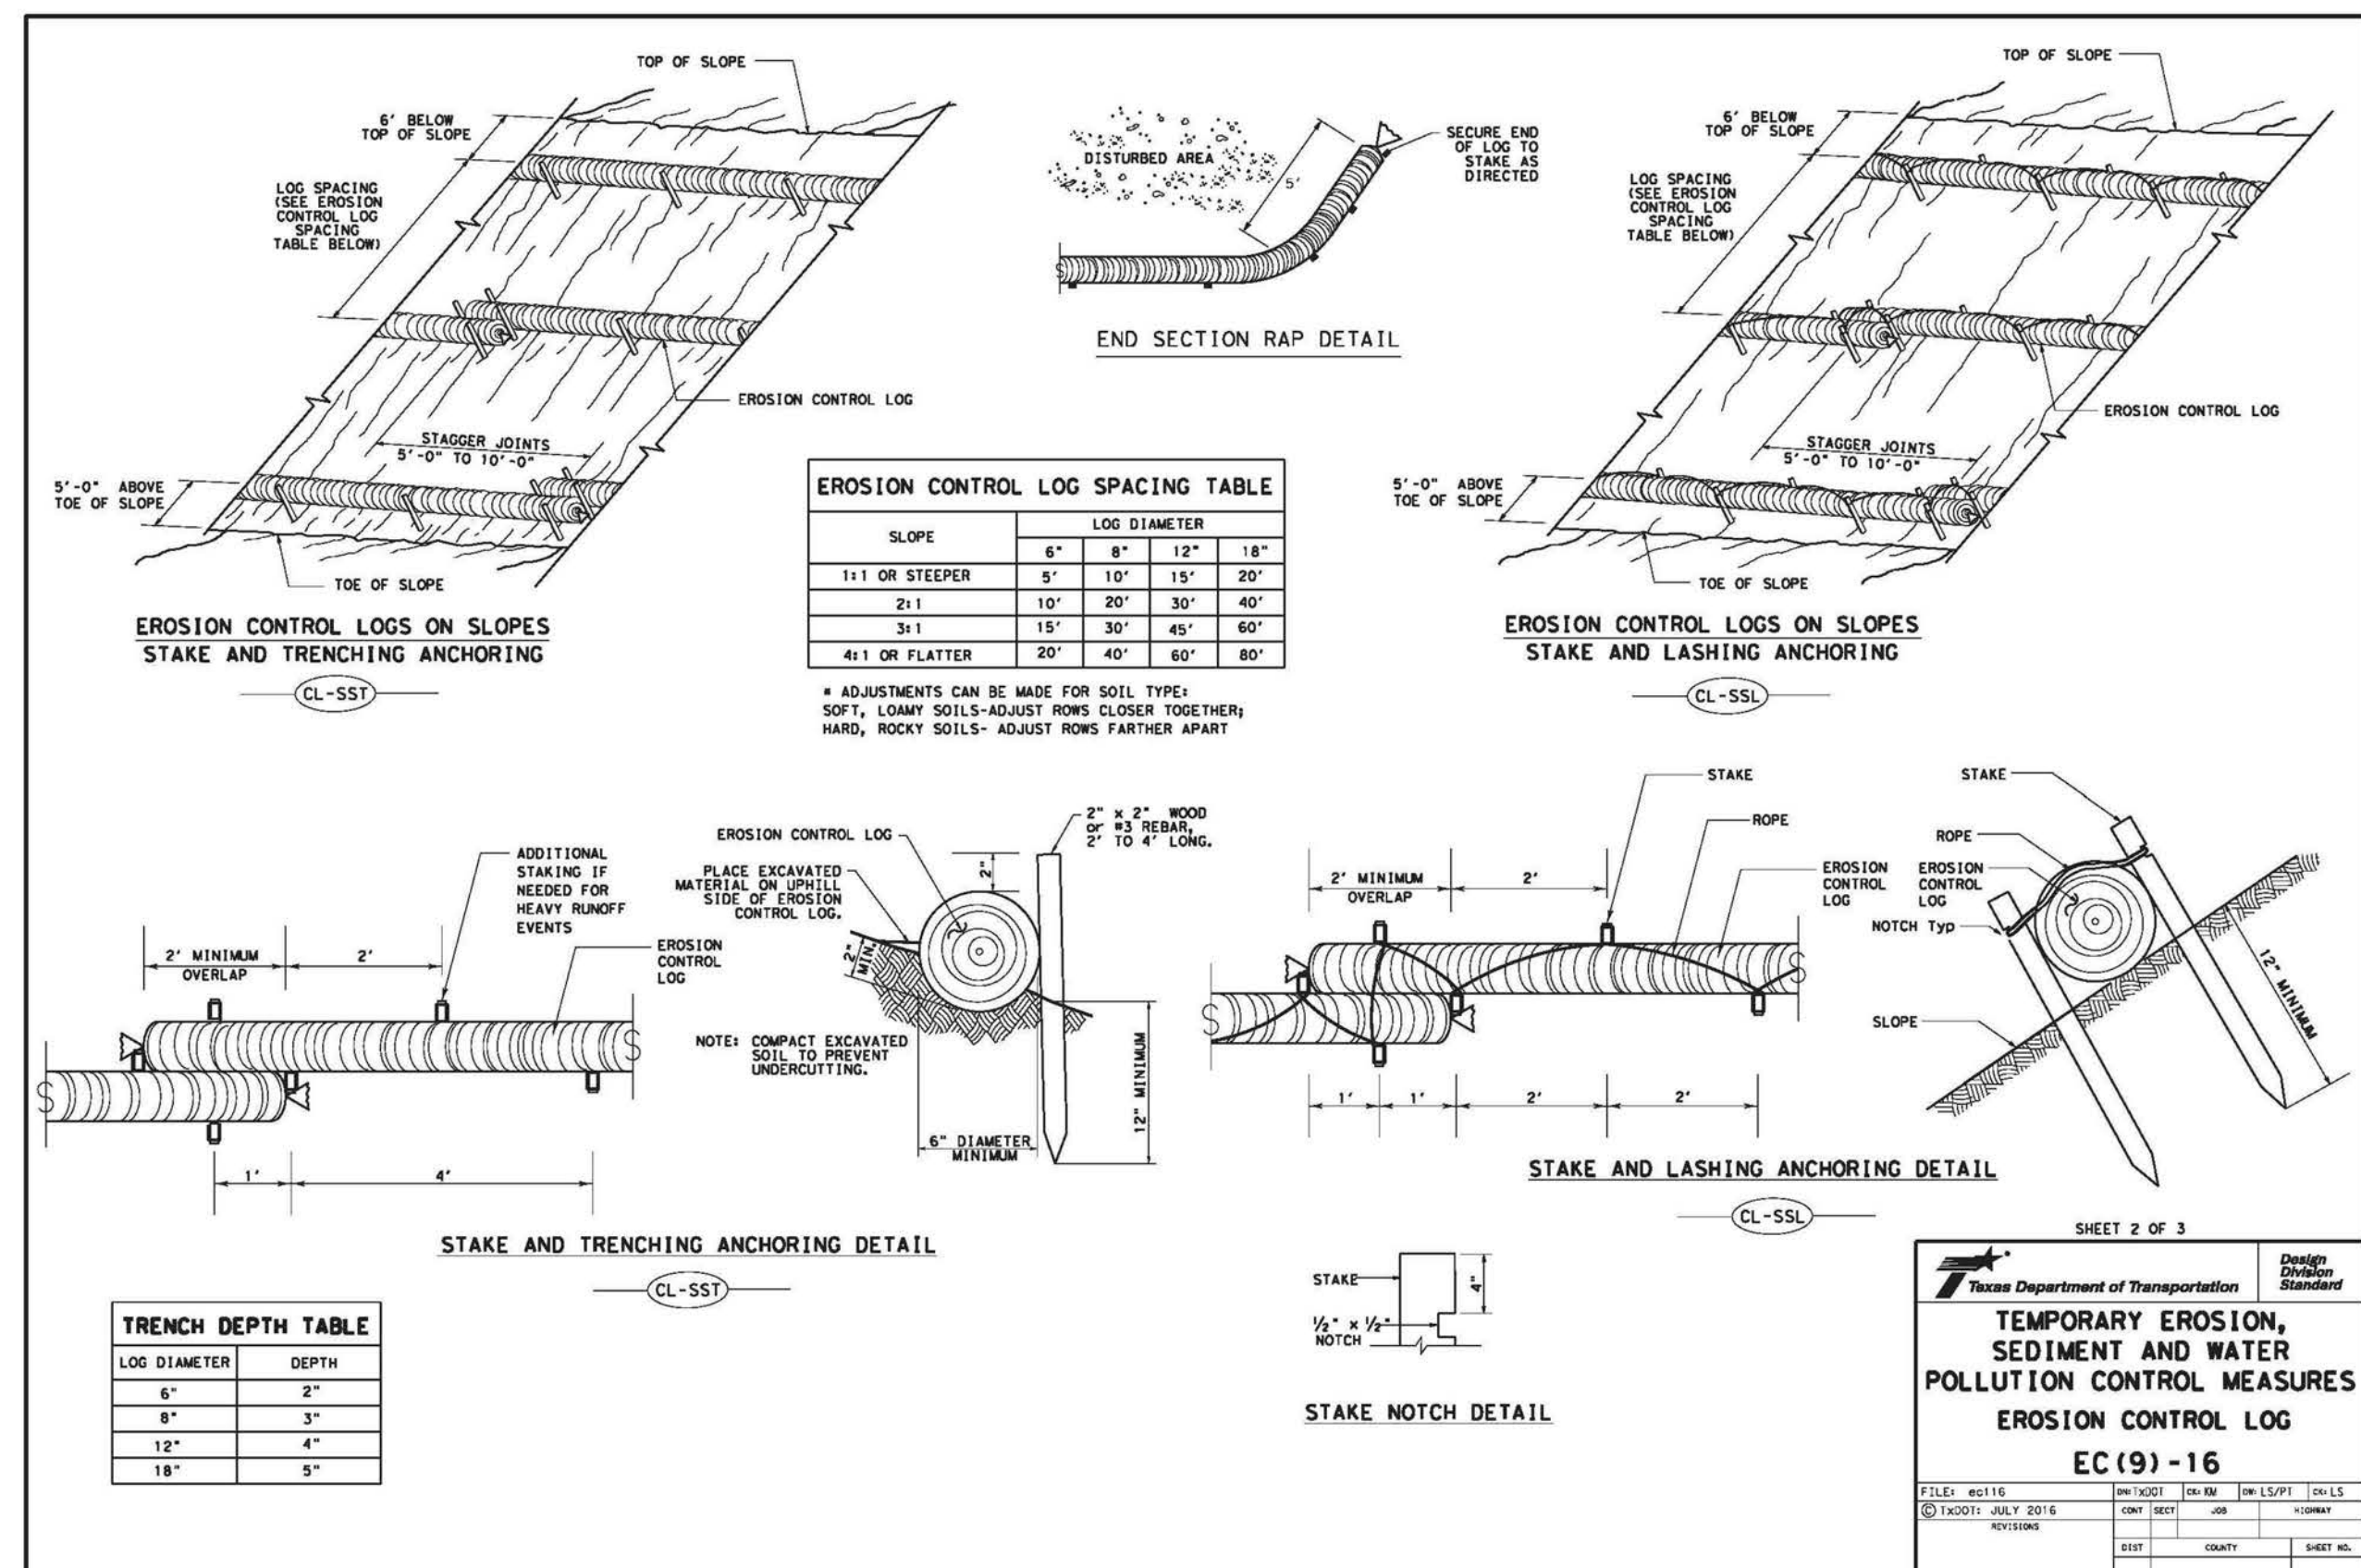


Drawing: PA PROJECTS\RM18219\01\Sheet\PHASE 1 - NORTH\8 EROSION DETAILS 2 OF 2.dwg at Sep 27, 2019 - 10:34am by jbealle
Layout: 8 EROSION DETAILS 1 OF 2
Artist: anderson.dwg

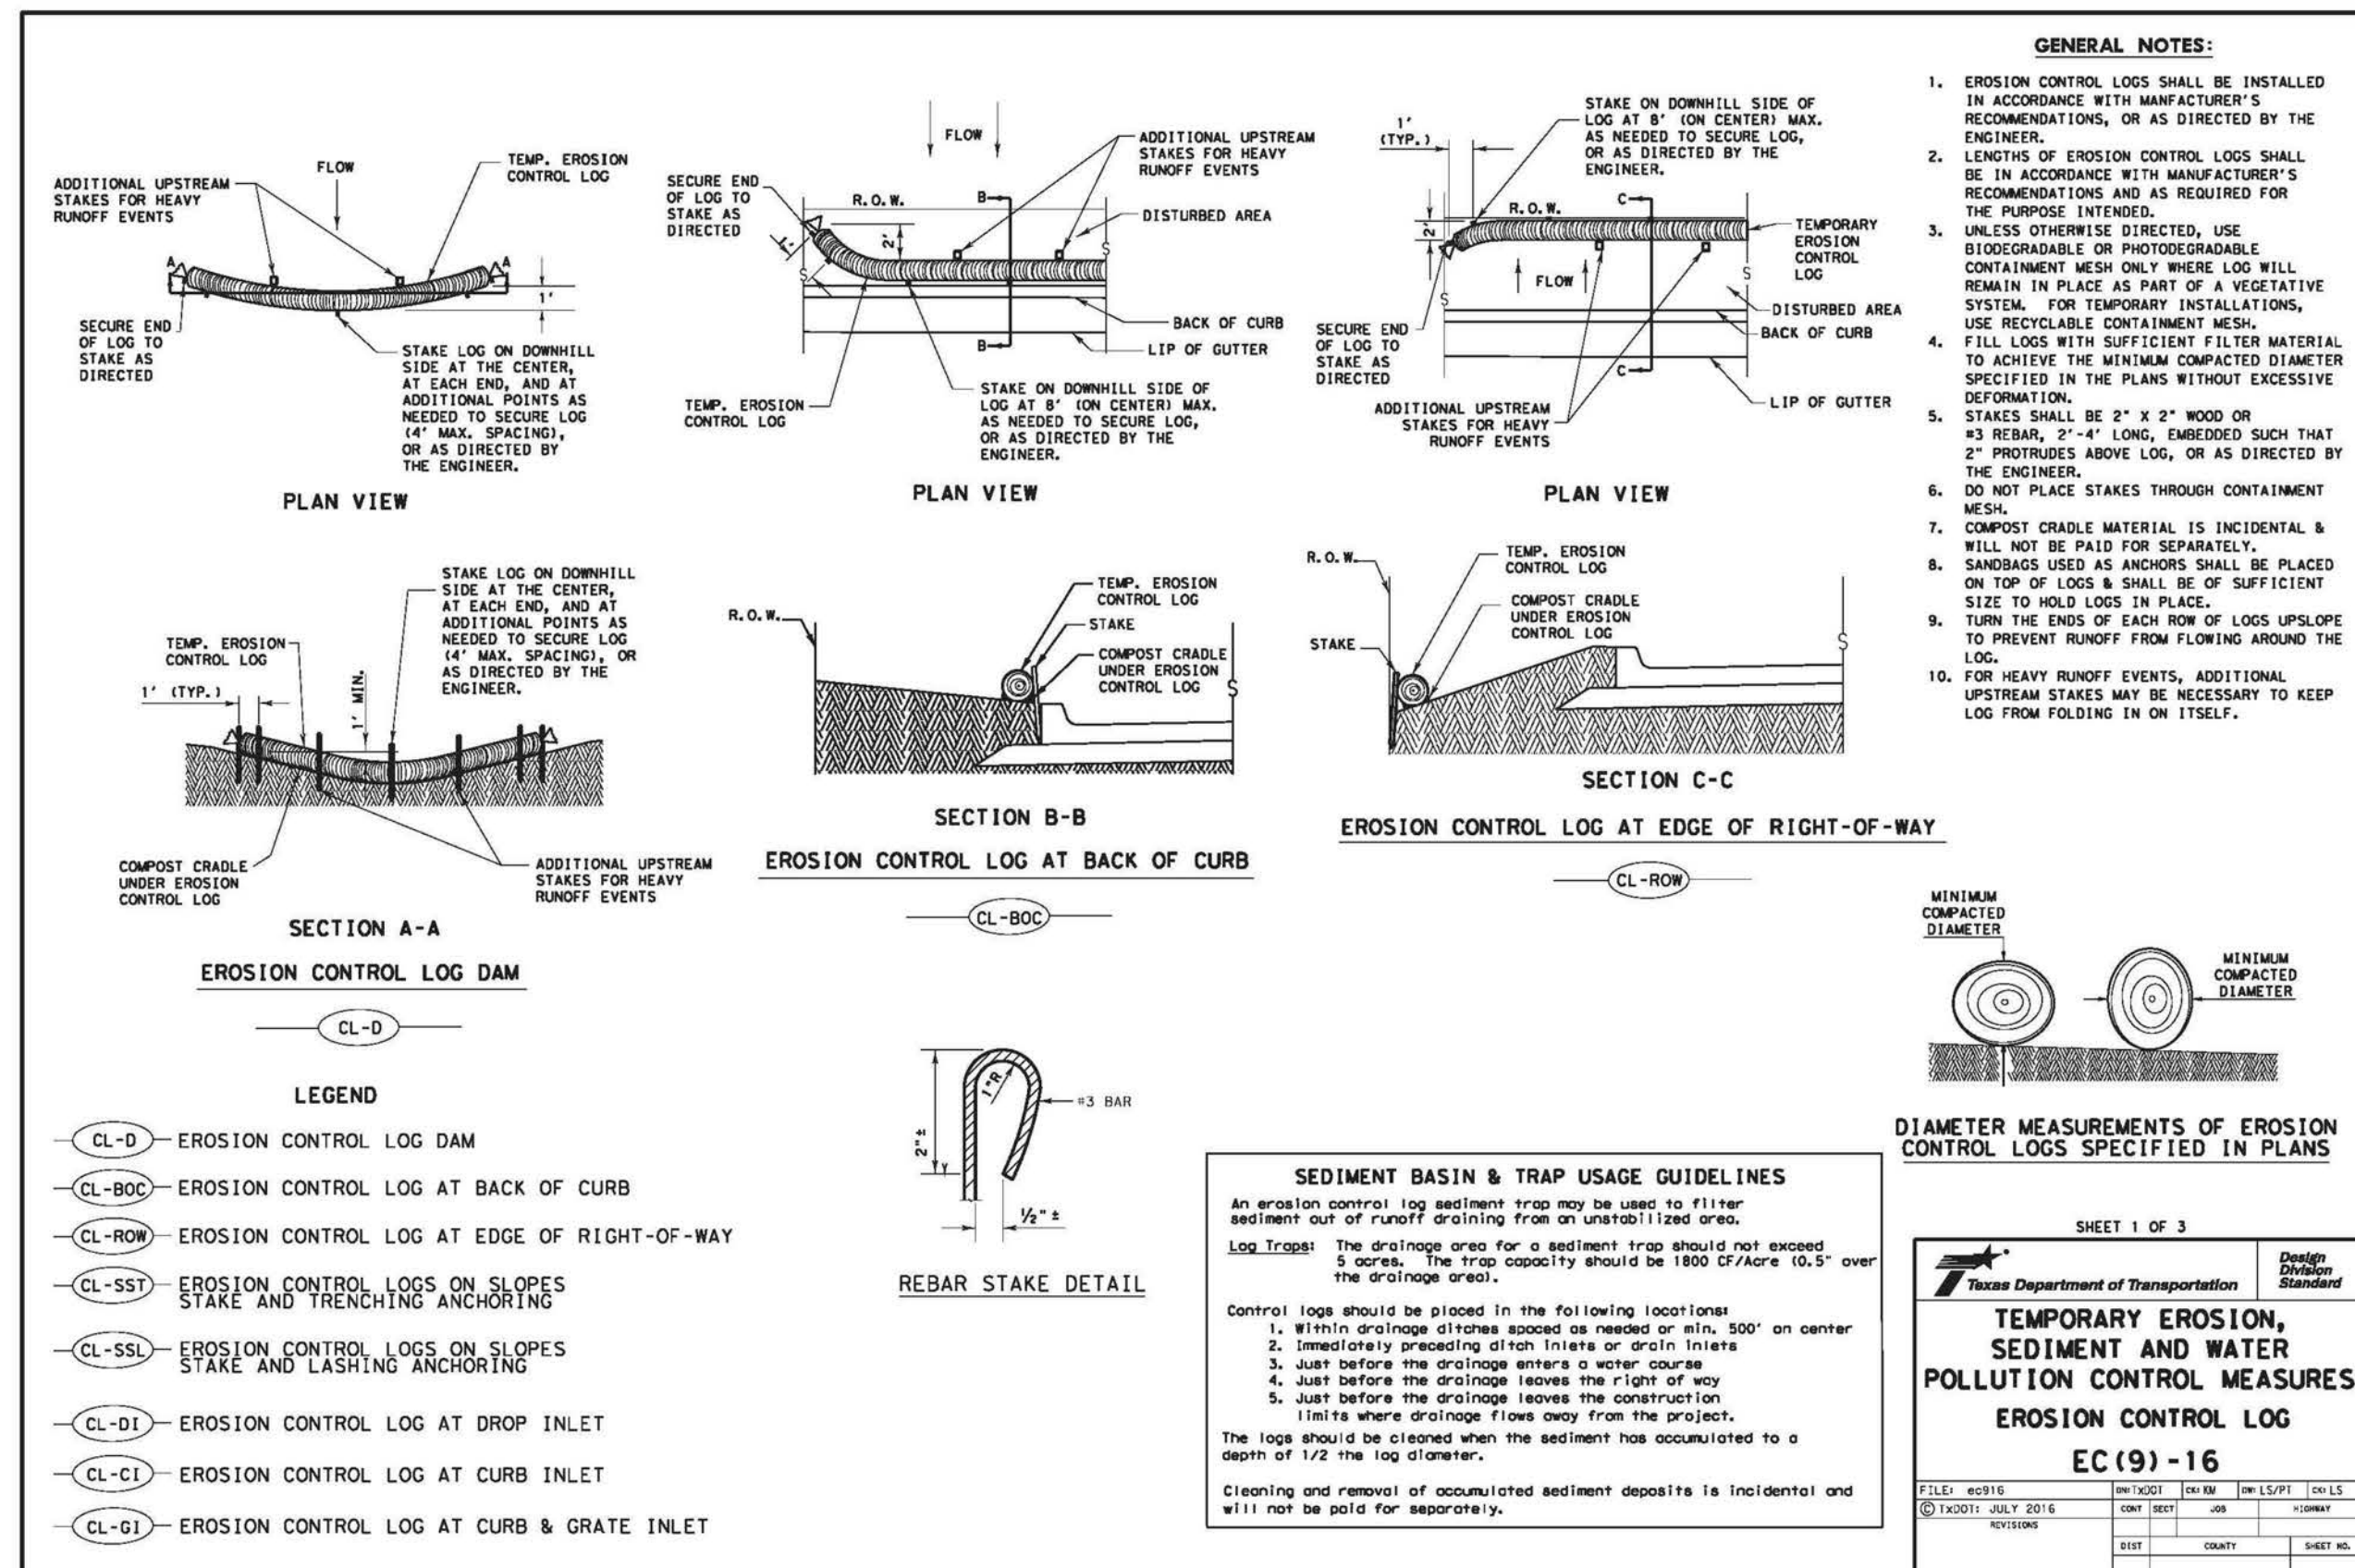

SHEET 1 OF 3

Texas Department of Transportation
Design Division
Standard

TEMPORARY EROSION, SEDIMENT AND WATER POLLUTION CONTROL MEASURES

EROSION CONTROL LOG

EC (9) - 16

FILED: 08/16/16
DATE: 08/16/16
BY: [Signature]
PROJECT: [Signature]

DATE: 08/16/16
BY: [Signature]
PROJECT: [Signature]

SHEET 2 OF 3

Texas Department of Transportation
Design Division
Standard

TEMPORARY EROSION, SEDIMENT AND WATER POLLUTION CONTROL MEASURES

EROSION CONTROL LOG

EC (9) - 16

FILED: 08/16/16
DATE: 08/16/16
BY: [Signature]
PROJECT: [Signature]

DATE: 08/16/16
BY: [Signature]
PROJECT: [Signature]

no.	revision	by	date

teague nall and perkins, inc

825 Watters Creek Blvd., Suite M300
Allen, Texas 75013
214.461.9867 ph 214.461.9864 fx
www.tnppinc.com

TBPE: F-230; TBPLS: 10011600, 10011601, 10194381

City of Rockwall
The New Horizon

scale
when bar is
1 inch long

horiz
N/A

vert
N/A

SEP 2019



RECORD DOCUMENTS

THESE PLANS ARE FOR THE OWNER'S USE AS RECORD SET OF THE CONSTRUCTED PROJECT, AND REFLECT REVISIONS AND CONSTRUCTION RELATED CHANGES AS RECORDED BY THE CONTRACTOR. CHANGES MADE FROM THE ORIGINAL CONSTRUCTION DOCUMENTS DO NOT DEPICT ENGINEERING AND ARE NOT THE RESPONSIBILITY OF TEAGUE NALL & PERKINS, INC. OR THE ENGINEER OF RECORD ON THE ORIGINAL DOCUMENTS. ORIGINAL PLANS RELEASED FOR CONSTRUCTION WERE SEALED BY GYANENDRA POKHREL, P.E. NO. 118159 ON 09/28/2018.

CITY OF ROCKWALL, TEXAS

HIGHLAND DRIVE RECONSTRUCTION, PHASE I
(DRIFTWOOD STREET TO BEDFORD FALLS LANE)

EROSION DETAILS 1 OF 2

tnp project
RWL18219

sheet
11