


DRIVEWAY DETAIL	CITY OF ROCKWALL	DATE	DRAWING NO.
RESIDENTIAL DRIVEWAY		OCT. '17	R-2150

MISCELLANEOUS DETAILS	CITY OF ROCKWALL	DATE	DRAWING NO.
CONSTRUCTION SIGN DETAIL		AUG. '15	R-7010

Drawing: P:\PROJECTS\RM\18219\CAD\Sheets\PHASE 1 - NORTH\22 PAVING DETAILS 4 OF 9.dwg at Sep 27, 2019 10:44am by jbedalle
Layout: 47 PAVING DETAILS 4 OF 9.dwg at Sep 27, 2019 10:44am by jbedalle

no.	revision	by	date

teague nall and perkins, inc
825 Watters Creek Blvd., Suite M300
Allen, Texas 75013
214.461.9867 ph 214.461.9864 fx
www.tnpsc.com
TBPE: F-230; TBPLS: 10011600, 10011601, 10194381

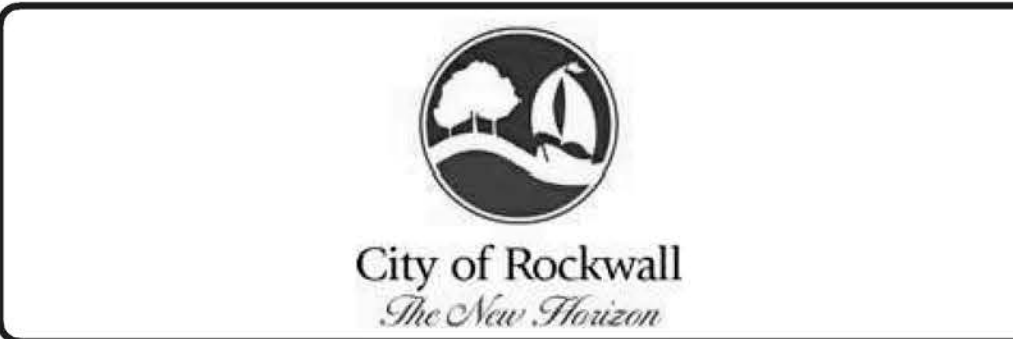

scale
when bar is
1 inch long

horiz
N/A

vert
N/A

SEP 2019



RECORD DOCUMENTS

THESE PLANS ARE FOR THE OWNER'S USE AS RECORD SET OF THE CONSTRUCTED PROJECT, AND REFLECT REVISIONS AND CONSTRUCTION RELATED CHANGES AS RECORDED BY THE CONTRACTOR. CHANGES MADE FROM THE ORIGINAL CONSTRUCTION DOCUMENTS DO NOT DEPICT ENGINEERING AND ARE NOT THE RESPONSIBILITY OF TEAGUE NALL & PERKINS, INC. OR THE ENGINEER OF RECORD ON THE ORIGINAL DOCUMENTS. ORIGINAL PLANS RELEASED FOR CONSTRUCTION WERE SEALED BY GYANENDRA POKHREL, P.E. NO. 118159 ON 09/28/2018.

CITY OF ROCKWALL, TEXAS
HIGHLAND DRIVE RECONSTRUCTION, PHASE I
(DRIFTWOOD STREET TO BEDFORD FALLS LANE)

PAVING DETAILS 4 OF 9

tnp project
RWL18219
sheet
45