
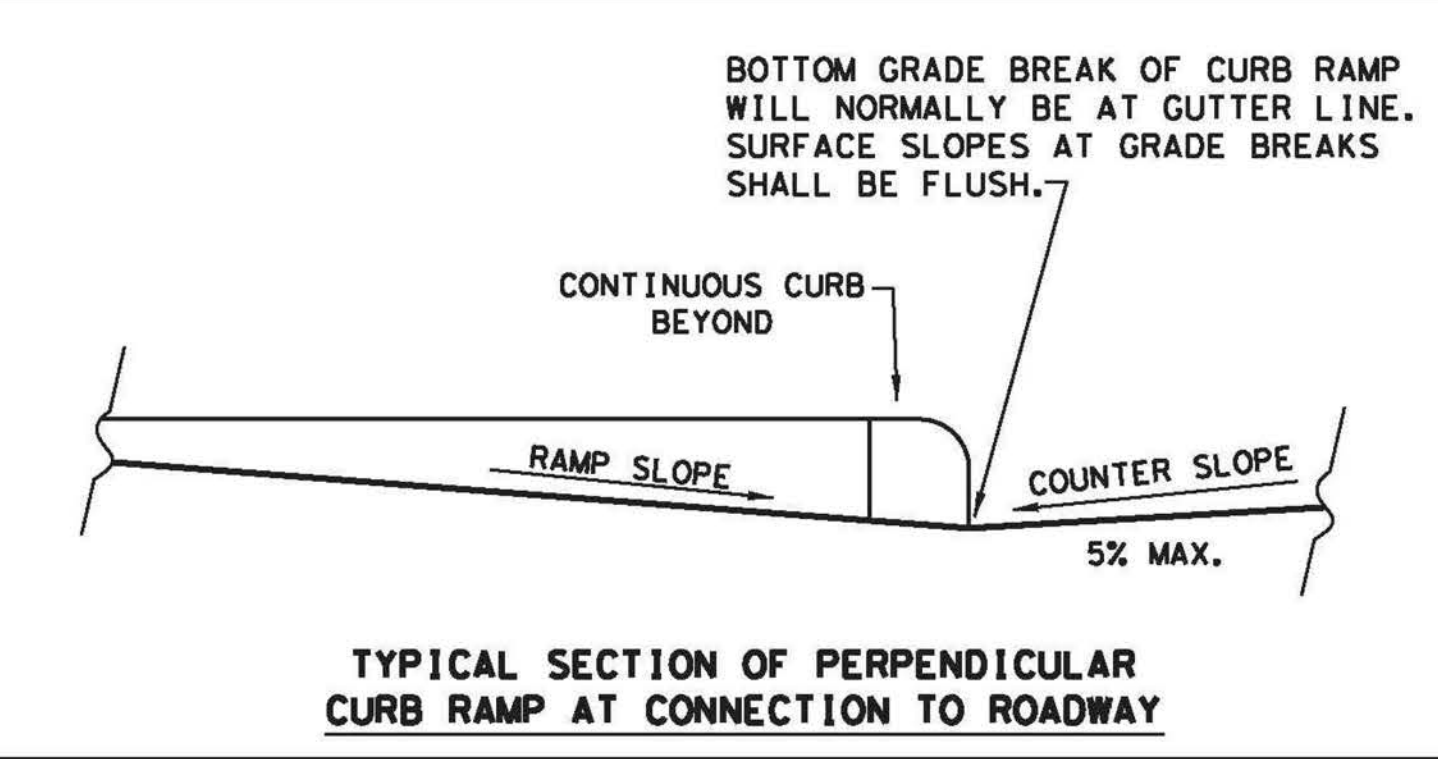
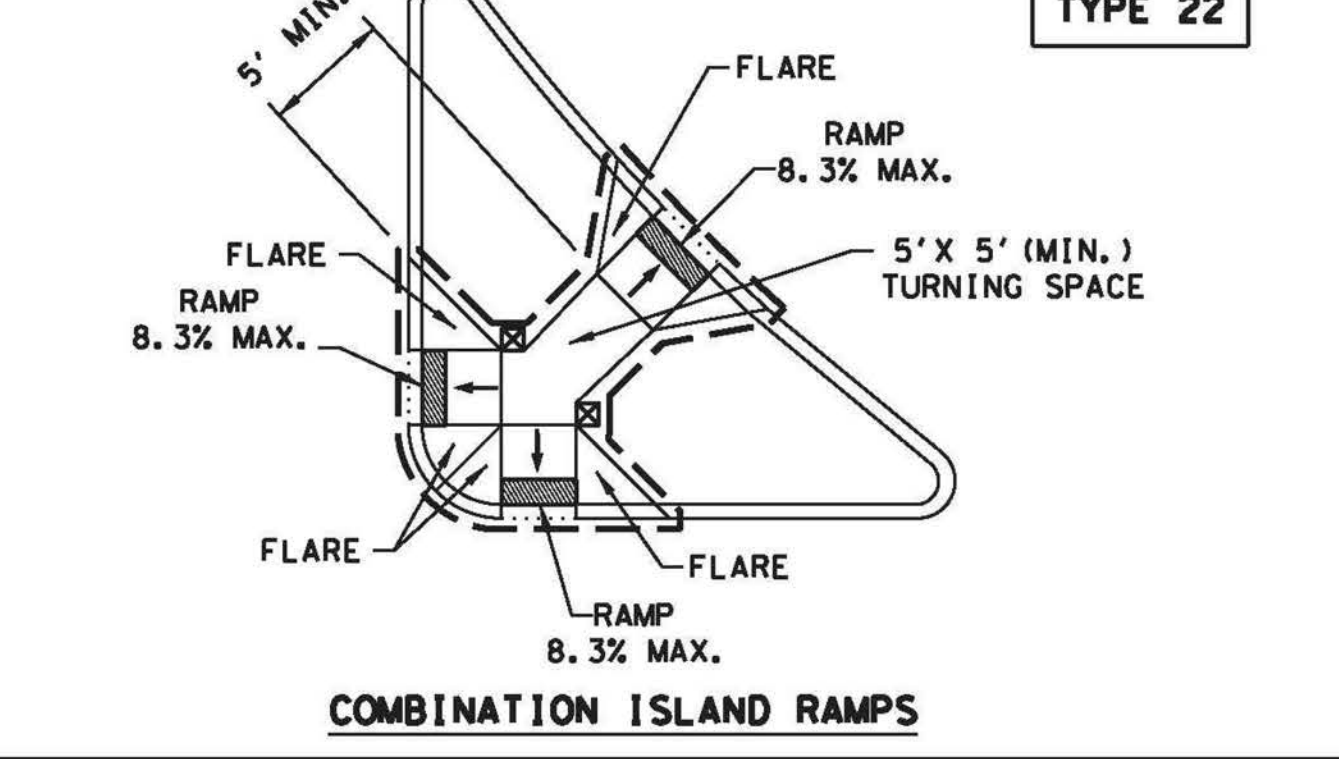
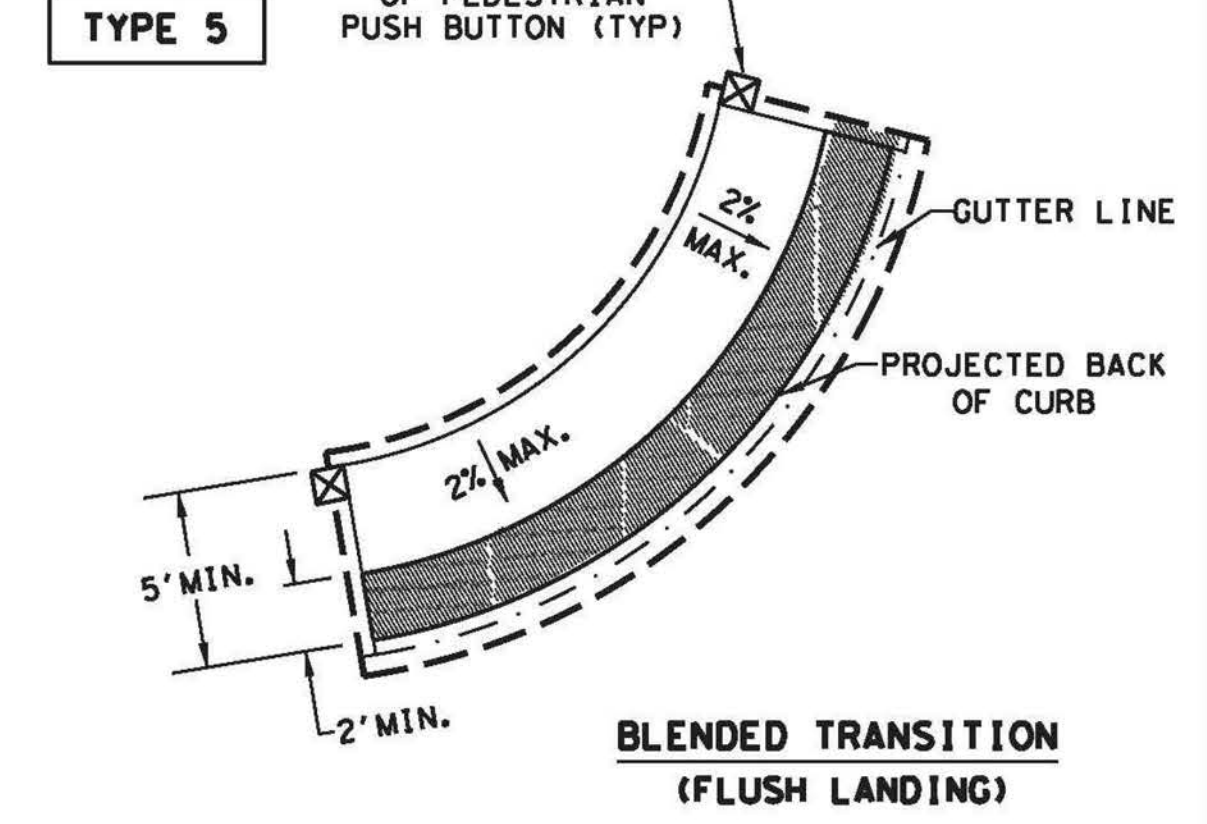
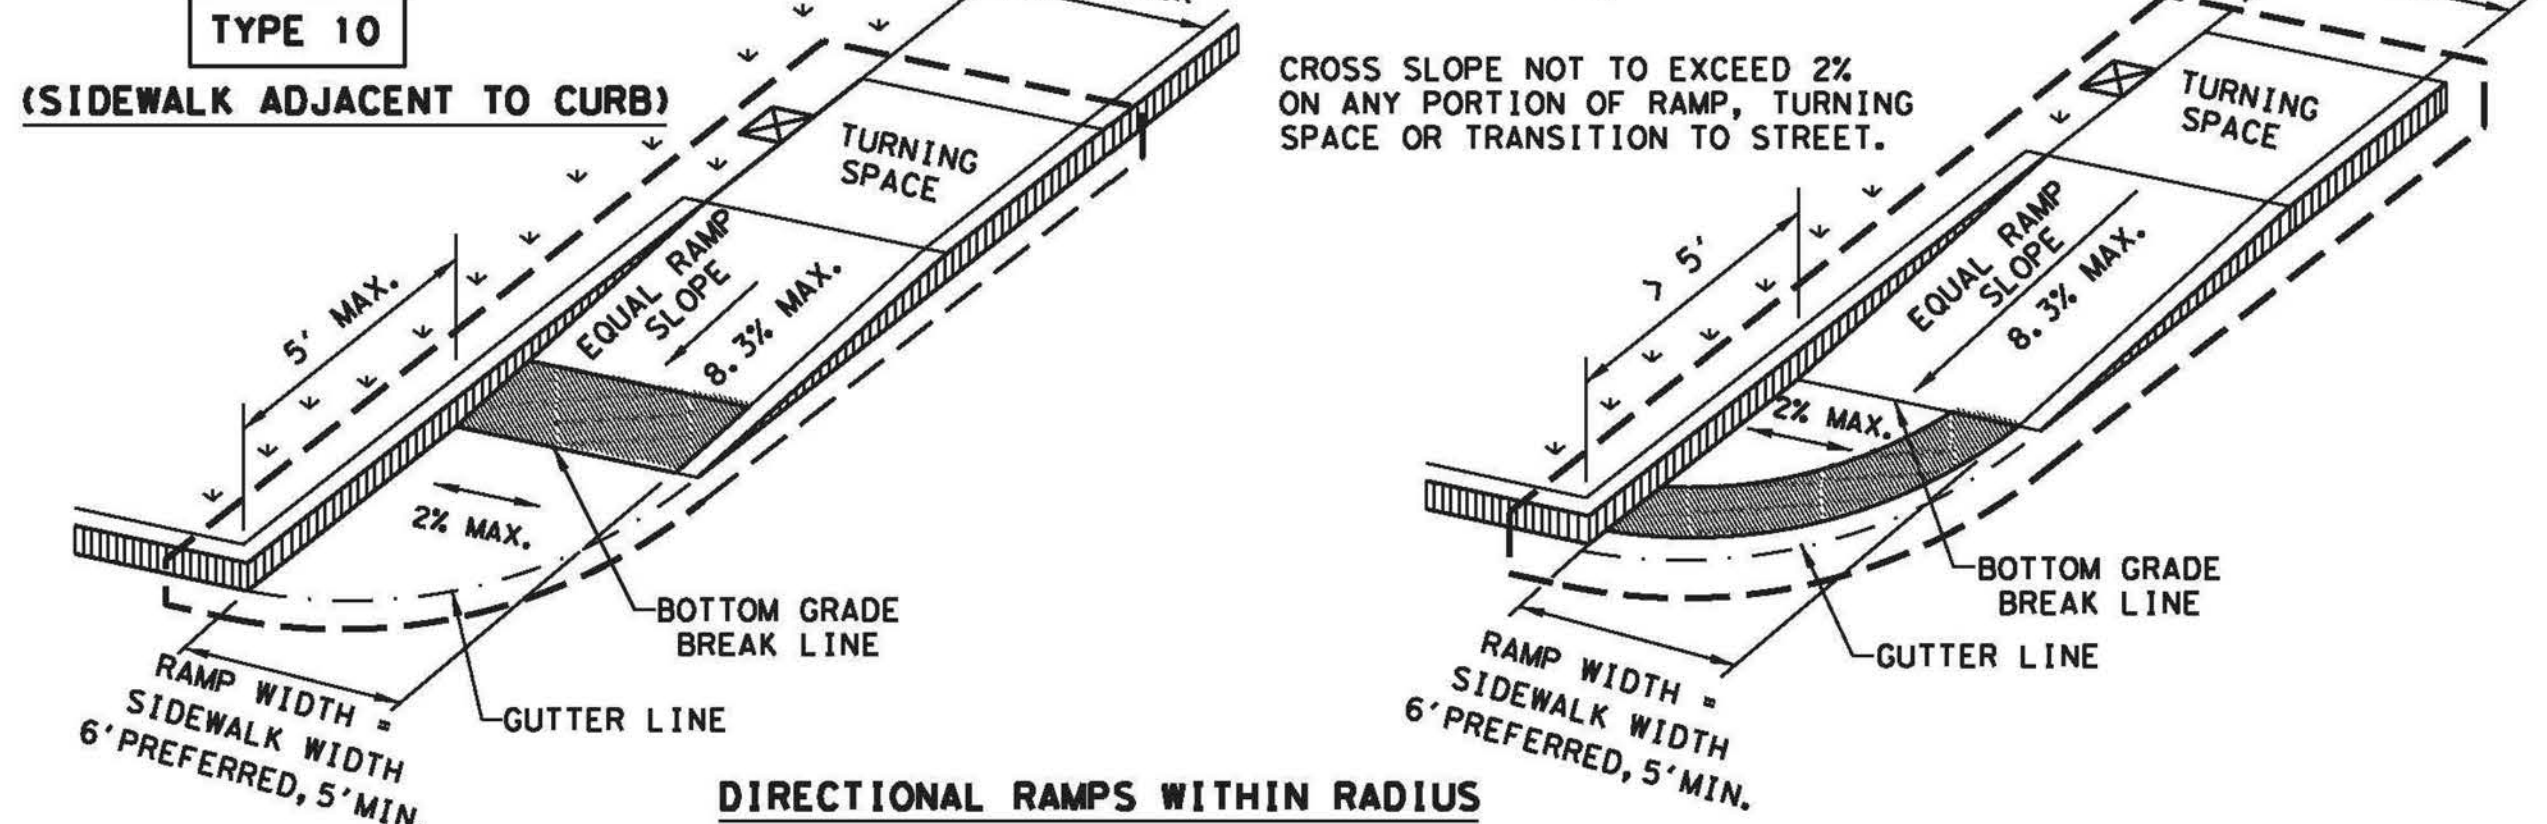
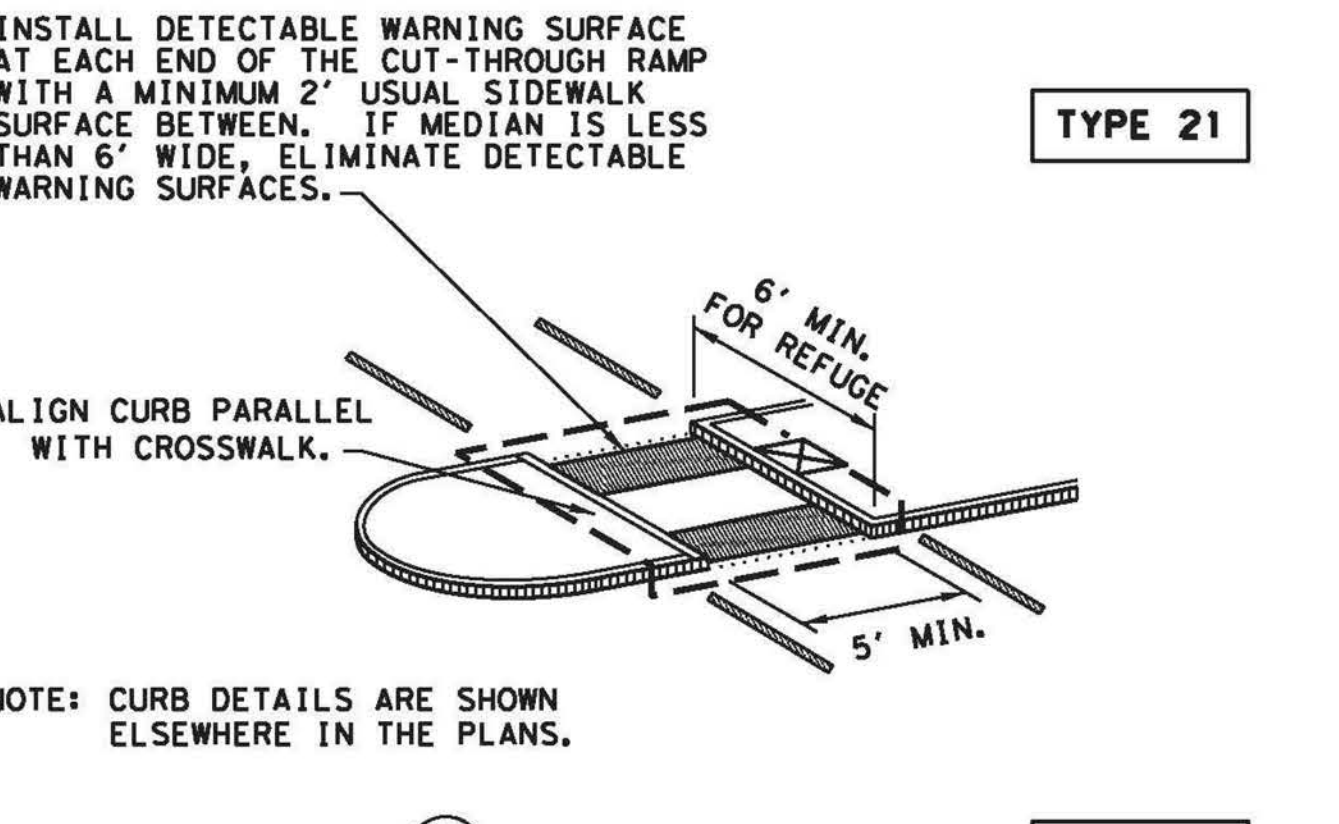
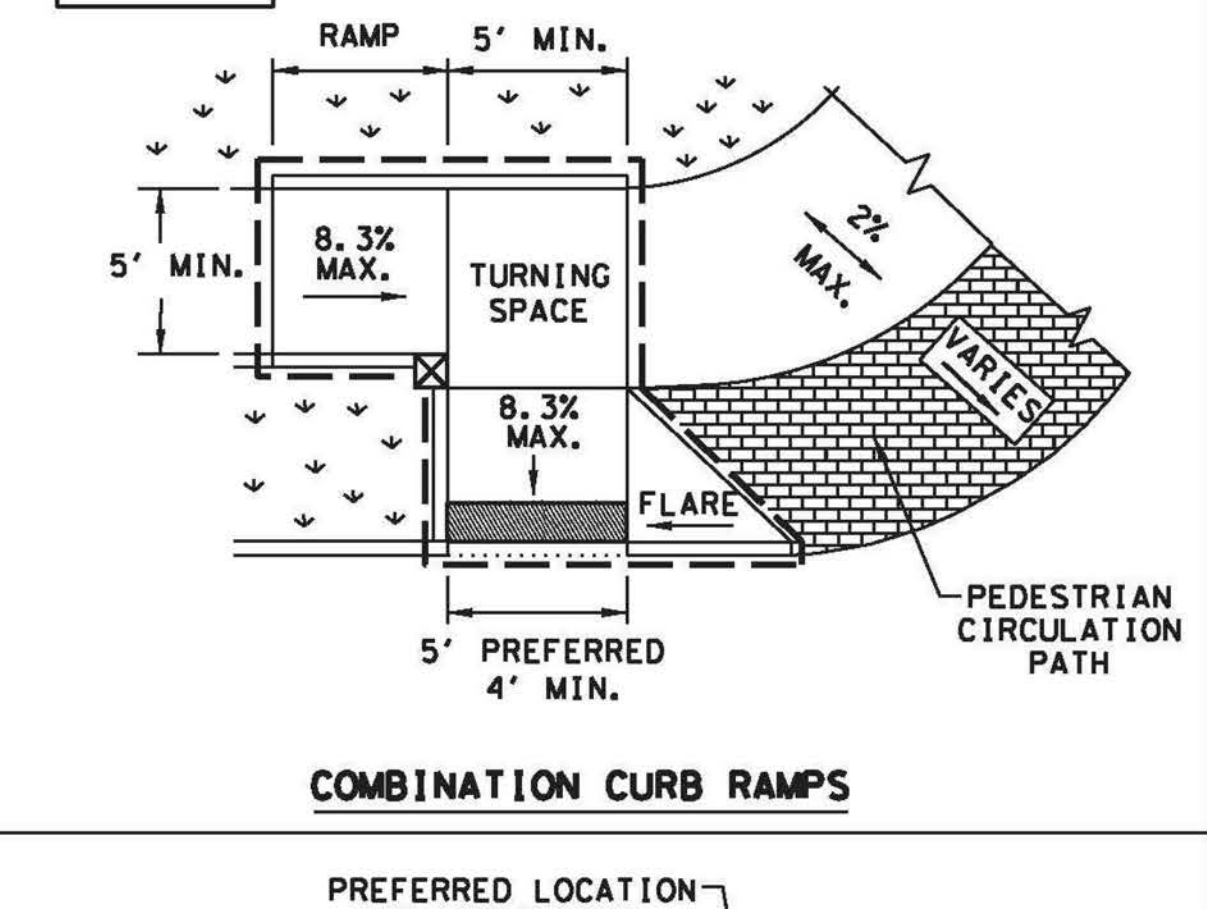
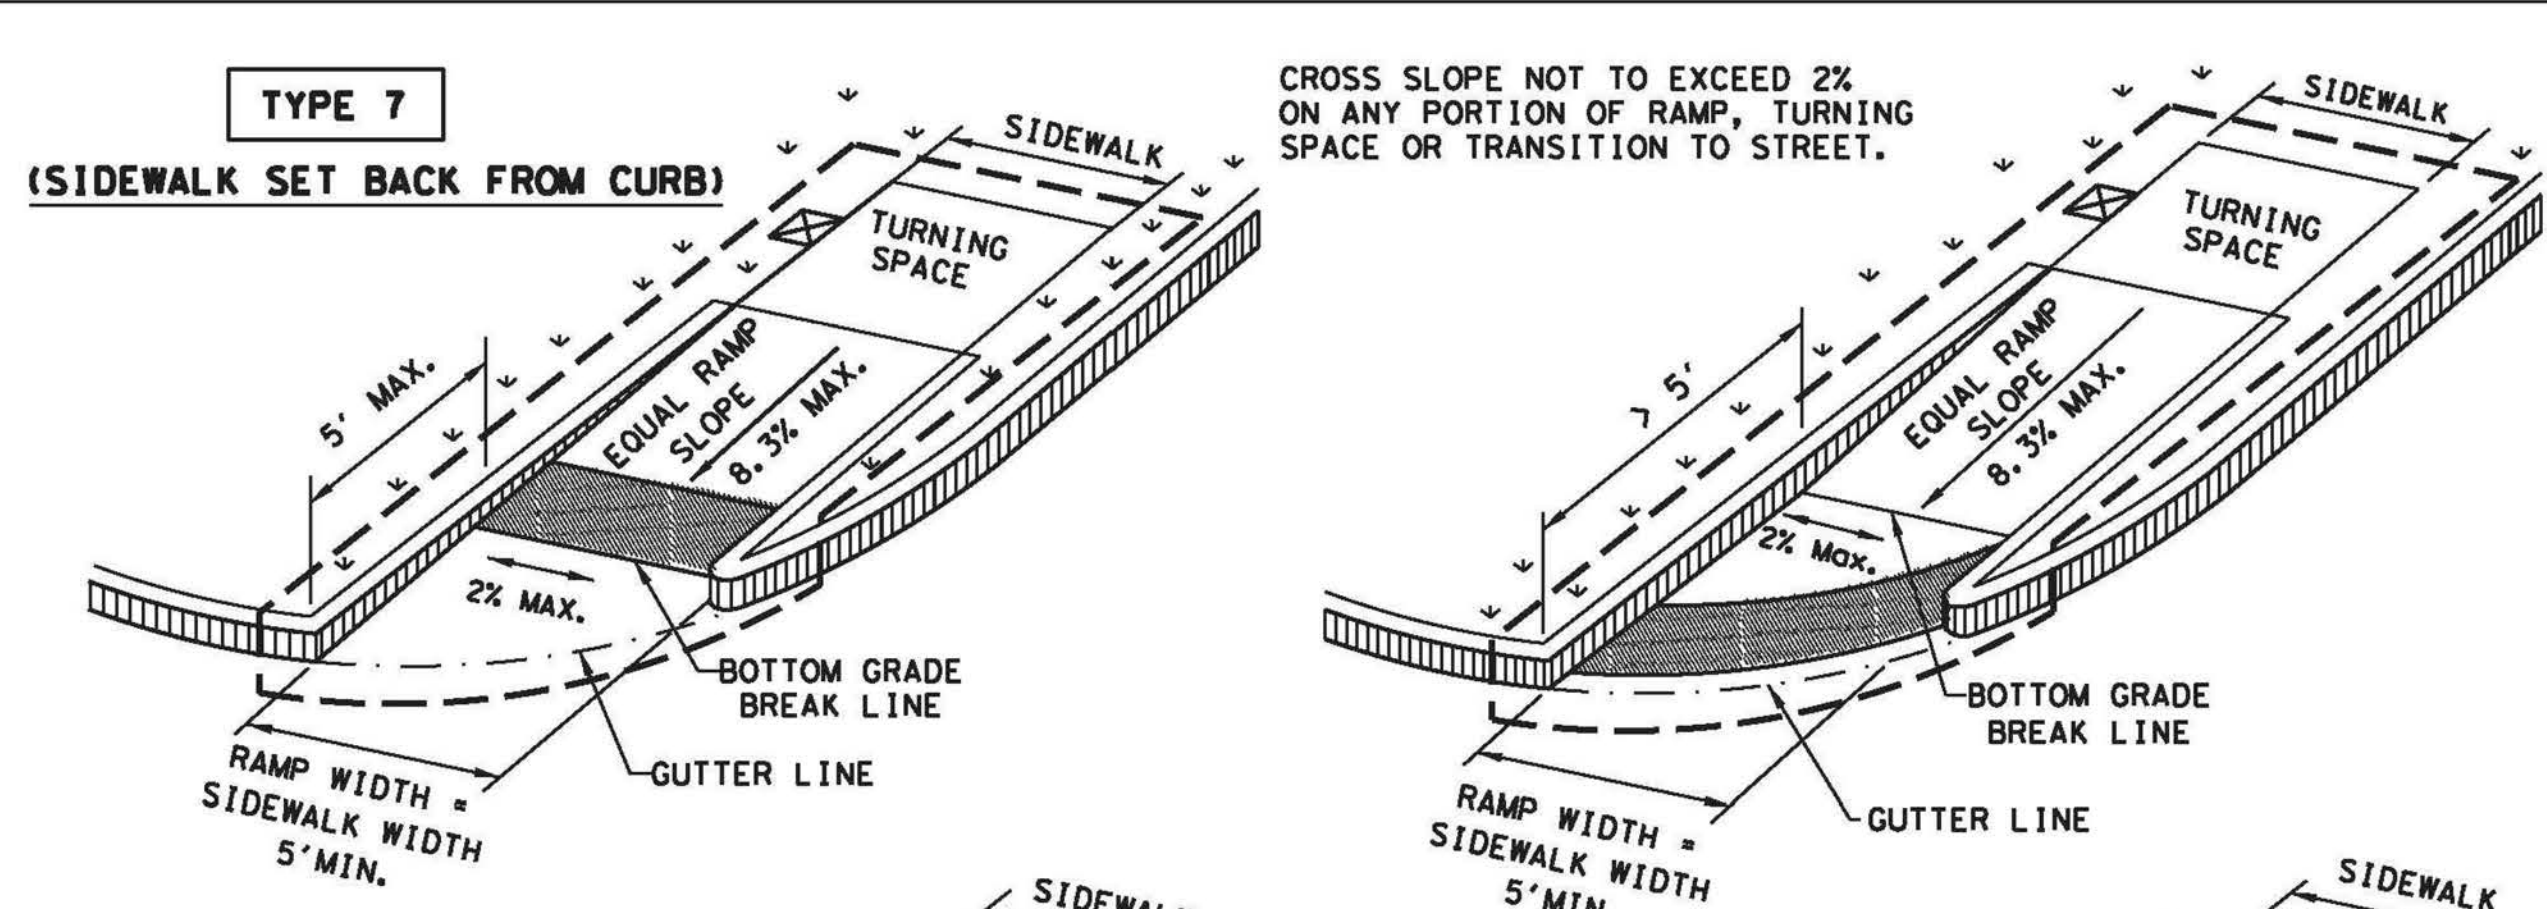
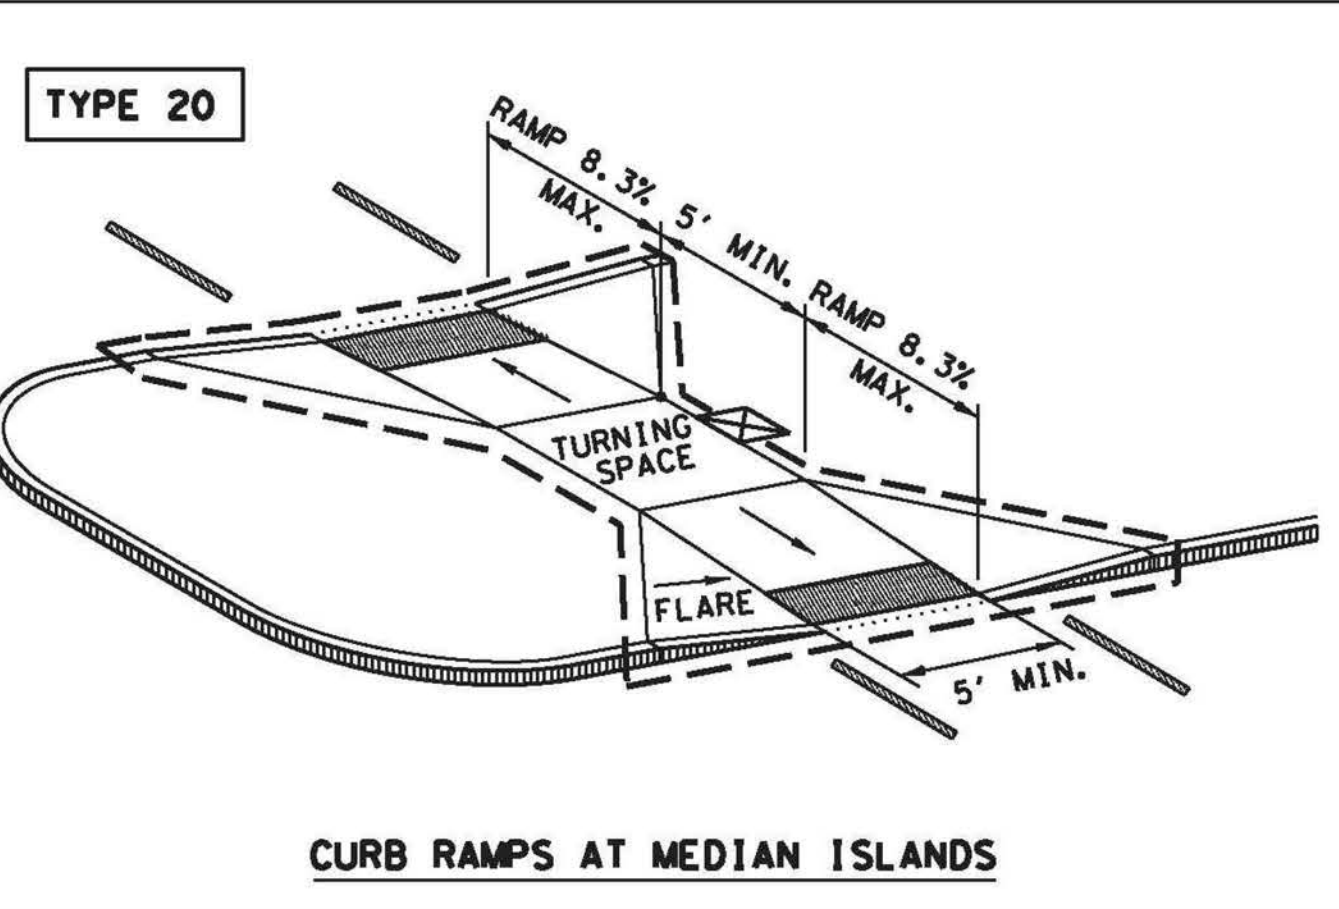
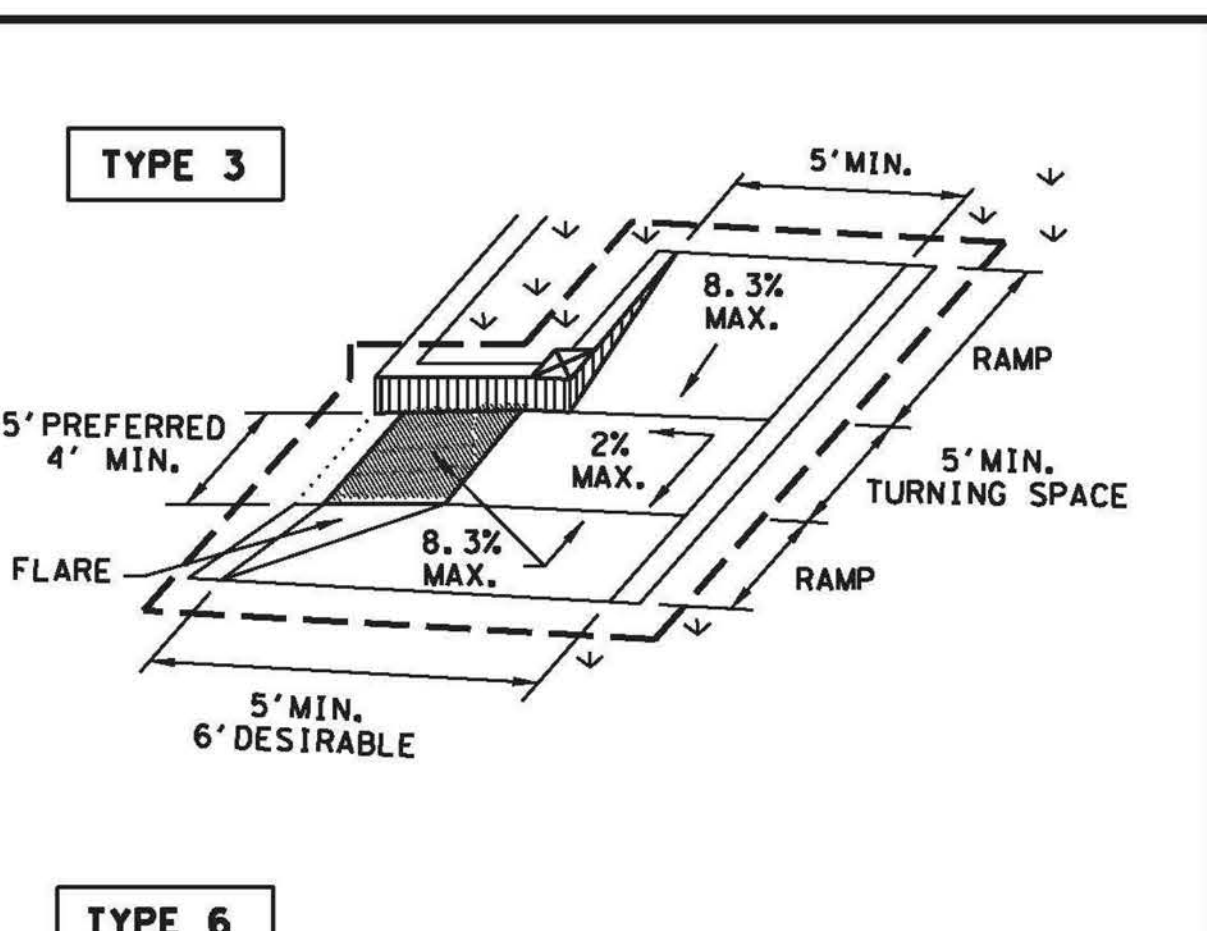
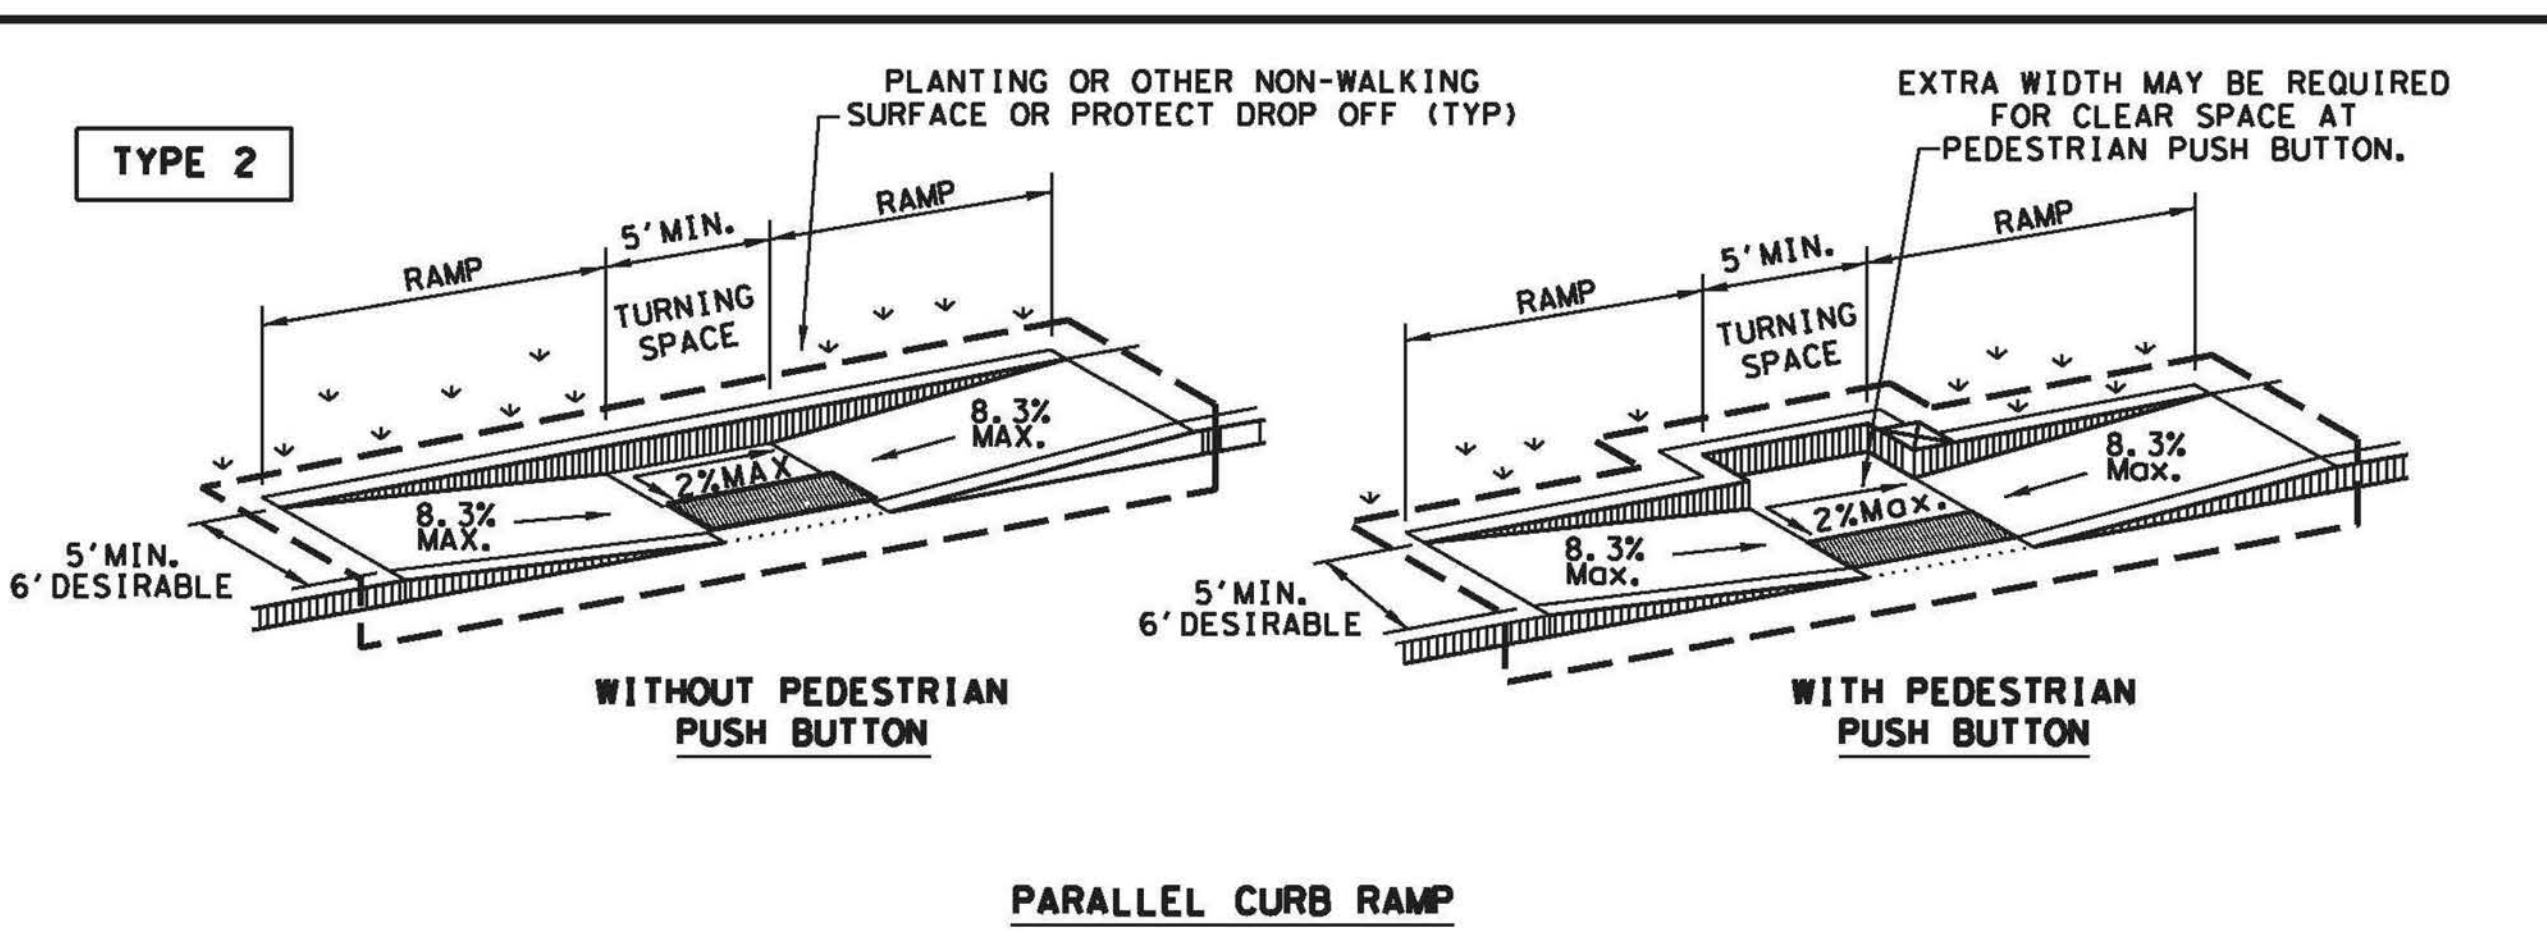


DISCLAIMER: This standard is governed by the "Texas Engineering Practice Act". No warranty of any kind is made by TxDOT for any purpose whatsoever. The use of this standard for the conversion of this standard to other formats or for incorrect results or damages resulting from its use. TxDOT assumes no responsibility for the conversion of this standard to other formats or for incorrect results or damages resulting from its use.

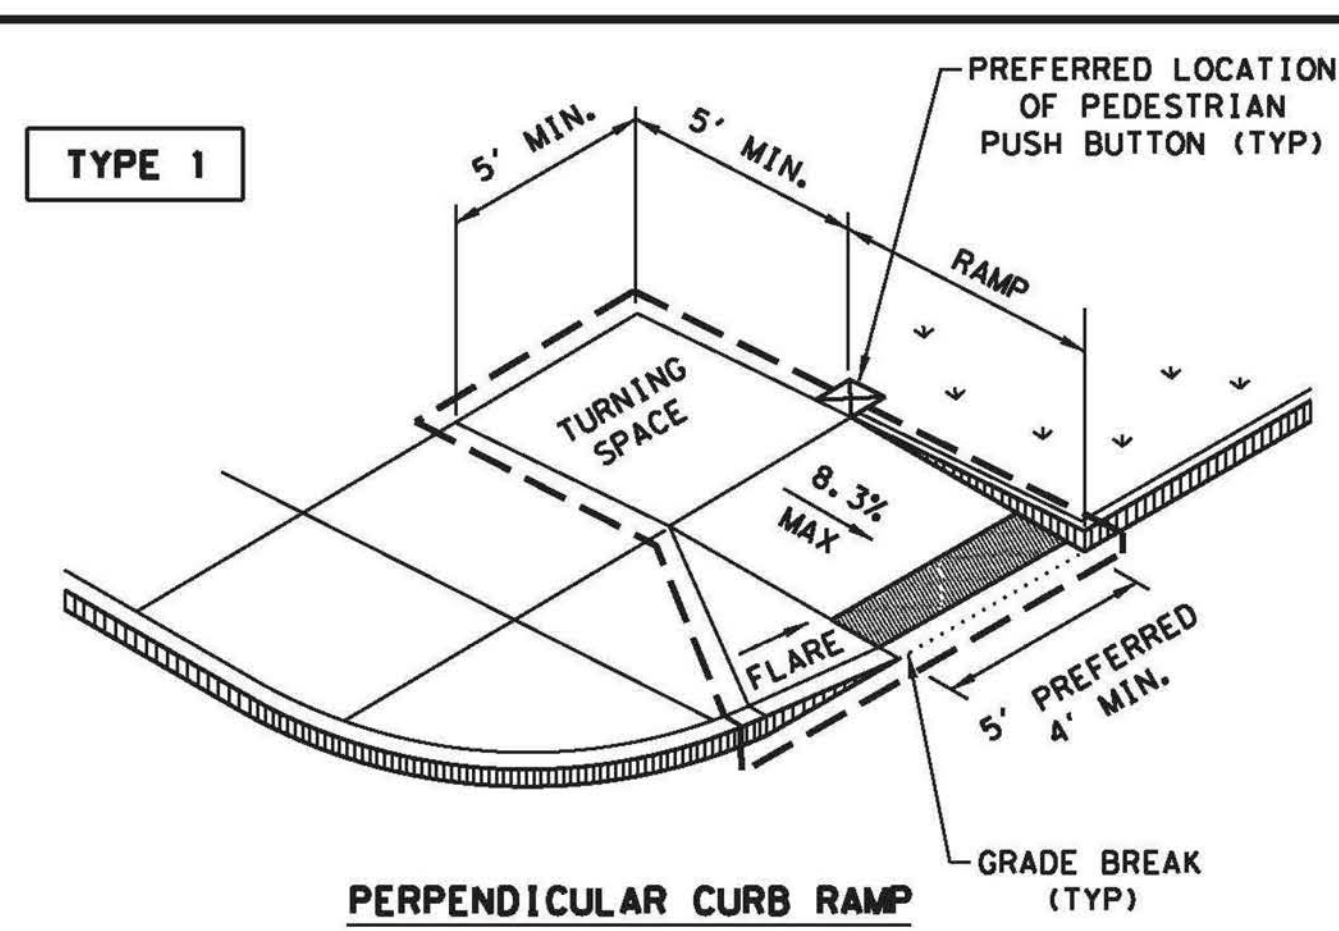

NOTES / LEGEND:
SEE GENERAL NOTES ON SHEET 2 OF 4 FOR MORE INFORMATION.

DENOTES PLANTING OR NON-WALKING SURFACE NOT PART OF PEDESTRIAN CIRCULATION PATH. GUTTER LINE
 DETECTABLE WARNING SURFACE GRADE BREAK
 DENOTES PREFERRED LOCATION OF PEDESTRIAN PUSH BUTTON IF APPLICABLE. RAMP LIMITS OF PAYMENT

SHEET 1 OF 4

Texas Department of Transportation
Design Division Standard

PEDESTRIAN FACILITIES CURB RAMPS
PED-18

FILE: ped18	DIST	COUNTY	SHEET NO.
© TxDOT: MARCH, 2002	CONTRACT	SECTION	HIGHWAY
REVISED 06, 2005			
REVISED 06, 2012			
REVISED 01, 2018			

Drawing: PA PROJECTS\BNA\82010\CD\Drawings\PHASE 1 - NORTH\52 PAVING DETAILS 9 OF 9.dwg at Sep 27, 2019 10:44am by jbellie
Layout: 48 PAVING DETAILS 5 OF 9
Author: xer@dot.state.tx.us

no.	revision	by	date

teague nall and perkins, inc
825 Watters Creek Blvd., Suite M300
Allen, Texas 75013
214.461.9867 ph 214.461.9864 fx
www.tnpsc.com
TBPE: F-230; TBPLS: 10011600, 10011601, 10194381

City of Rockwall
The New Horizon

scale
when bar is
1 inch long

horiz
N/A

vert
N/A

SEP 2019

RECORD DOCUMENTS

THESE PLANS ARE FOR THE OWNER'S USE AS RECORD SET OF THE CONSTRUCTED PROJECT, AND REFLECT REVISIONS AND CONSTRUCTION RELATED CHANGES AS RECORDED BY THE CONTRACTOR. CHANGES MADE FROM THE ORIGINAL CONSTRUCTION DOCUMENTS DO NOT DEPICT ENGINEERING AND ARE NOT THE RESPONSIBILITY OF TEAGUE NALL & PERKINS, INC. OR THE ENGINEER OF RECORD ON THE ORIGINAL DOCUMENTS. ORIGINAL PLANS RELEASED FOR CONSTRUCTION WERE SEALED BY GYANENDRA POKHREL, P.E. NO. 118159 ON 09/28/2018.

CITY OF ROCKWALL, TEXAS
HIGHLAND DRIVE RECONSTRUCTION, PHASE I
(DRIFTWOOD STREET TO BEDFORD FALLS LANE)
PAVING DETAILS 5 OF 9

tnp project
RWL18219
sheet
46