

Drawing: P:\PROJECTS\1818219\CAD\Sheet\PHASE 1 - NORTH\58_SIGNAGE & STRIPING PLAN.dwg at Sep 27, 2019, 2:13pm by Heidielle
 Layout: 58_SIGNAGE & STRIPING PLAN.dwg at Sep 27, 2019, 2:13pm by Heidielle
 Project: 1818219 - Highland Drive Reconstruction, Phase I (Driftwood Street to Bedford Falls Lane)
 User: Heidielle




LEGEND	
	PROPOSED PAVT. MARKING
	SIGN DESIGNATION (SEE SHEET 58)
	PROPOSED SIGN

SCHOOL CROSSING AHEAD S1-1 (36X36) SW16-9P (24X12) A-HEAD 	SCHOOL CROSSING SIGN S1-1 (36X36) SW16-7P (24X12) 	
SCHOOL SPEED LIMIT S4-3P (24X8) R2-1 (24X30) S4-1P (24X10) 	SCHOOL CROSSING AHEAD S1-1 (36X36) S4-3P (36X12) 	END SCHOOL ZONE S5-2 (24X30)

SEE SHEET 55 FOR HIGHLAND DRIVE SIGNAGE AND PAVT. MARKINGS

- NOTES:
- ALL SIGNAGE AND PAVEMENT MARKINGS SHALL CONFORM TO THE LATEST EDITION OF THE TEXAS MANUAL ON UNIFORM TRAFFIC CONTROL DEVICES AND CITY OF ROCKWALL STANDARDS.
 - ALL SCHOOL ZONE SIGNAGE SHALL BE FLUORESCENT YELLOW GREEN.
 - SIGN INSTALLATION SHALL INCLUDE SIGN PLATES, HARDWARE, POLES AND FOUNDATION.
 - STANDARD STREET SIGN POLE SHALL BE 12' LONG MIN. 2 3/8" GALVANIZED STEEL ROUND POLE WITH A MIN. OF 60 MIL WALL THICKNESS.
 - STREET SIGN MOUNT FOR BOTTOM BLADE SHALL BE 18" CAST ALUMINUM ROUND POST.
 - STREET SIGN MOUNT FOR TOP STREET BLADE SHALL BE 12" CAST ALUMINUM TOP CROSSING BRACKET.
 - MOUNTING BRACKET ASSEMBLIES SHALL BEN 2 3/8" DIAMETER ALUMINUM ROUND POST INTERLOCKING BRACKET X 2 PER POLE.
 - ALL WHITE PAVEMENT MARKING TO BE THERMOPLASTIC MATERIAL.
 - ALL PROPOSED SCHOOL SIGNS (F,G,H) SHALL BE LOCATED CLOSE TO LOT LINE. CONTRACTOR SHALL GET APPROVAL FROM CITY STAFF FOR THE PROPOSED LOCATION.

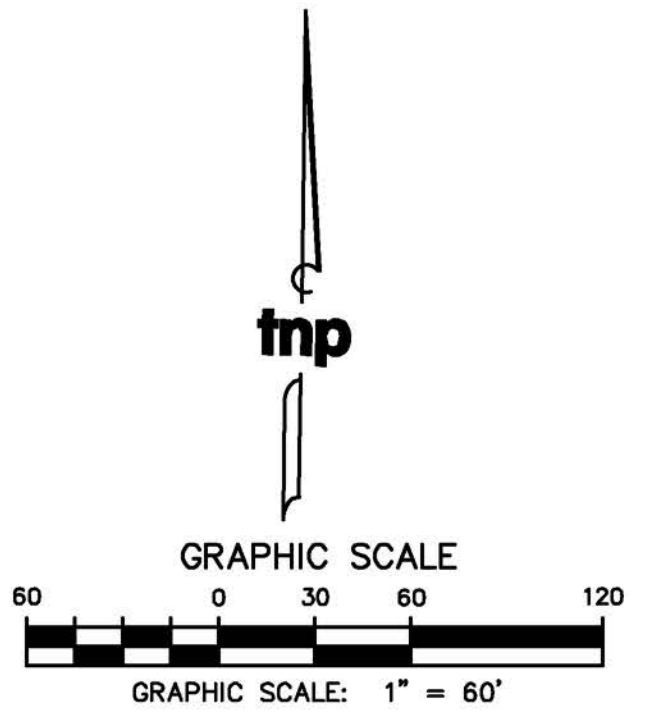

no.	revision	by	date

teague nall and perkins, inc
 825 Watters Creek Blvd., Suite M300
 Allen, Texas 75013
 214.461.9867 ph 214.461.9864 fx
 www.tnpsc.com
 TBPE: F-230; TBPLS: 10011600, 10011601, 10194381



scale
 when bar is
 1 inch long
 horiz
 1" = 60'
 vert
 N/A
 SEP 2019



RECORD DOCUMENTS
 THESE PLANS ARE FOR THE OWNER'S USE AS RECORD SET OF THE CONSTRUCTED PROJECT, AND REFLECT REVISIONS AND CONSTRUCTION RELATED CHANGES AS RECORDED BY THE CONTRACTOR. CHANGES MADE FROM THE ORIGINAL CONSTRUCTION DOCUMENTS DO NOT DEPICT ENGINEERING AND ARE NOT THE RESPONSIBILITY OF TEAGUE NALL & PERKINS, INC. OR THE ENGINEER OF RECORD ON THE ORIGINAL DOCUMENTS. ORIGINAL PLANS RELEASED FOR CONSTRUCTION WERE SEALED BY GYANENDRA POKHREL, P.E. NO. 118159 ON 09/28/2018.

CITY OF ROCKWALL, TEXAS
HIGHLAND DRIVE RECONSTRUCTION, PHASE I
 (DRIFTWOOD STREET TO BEDFORD FALLS LANE)
SIGNAGE & STRIPING PLAN
SHEET 2 OF 2

tnp project
 RWL18219
 sheet
56