

CITY OF ROCKWALL, TEXAS

CONSTRUCTION PLANS FOR

HIGHWOOD SANITARY SEWER REHABILITATION

COUNCIL MEMBERS

KEN JONES, MAYOR
 BILL CECIL, MAYOR PRO-TEM
 BOB COTTI
 JOHN KING
 TERRY RAULSTON
 BILLY MORRIS
 RON COLESON

CITY MANAGER

JULIE COUCH


ASSISTANT CITY MANAGER

RICHARD CROWLEY

CITY ENGINEER


CHUCK TODD, P.E.

SECTION	LINE	REHABILITATION METHOD
A	A	OPEN CUT REPLACEMENT OR CURED IN PLACE PIPE
A	B	CURED IN PLACE PIPE
B	A	CURED IN PLACE PIPE
C	A	CURED IN PLACE PIPE
C	B	CURED IN PLACE PIPE

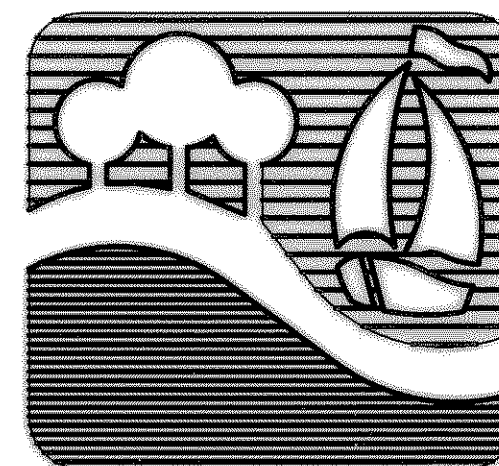

BIRKHOFF, HENDRICKS & CONWAY, L.L.P.
 CONSULTING ENGINEERS
 Dallas, Texas

JULY, 2002

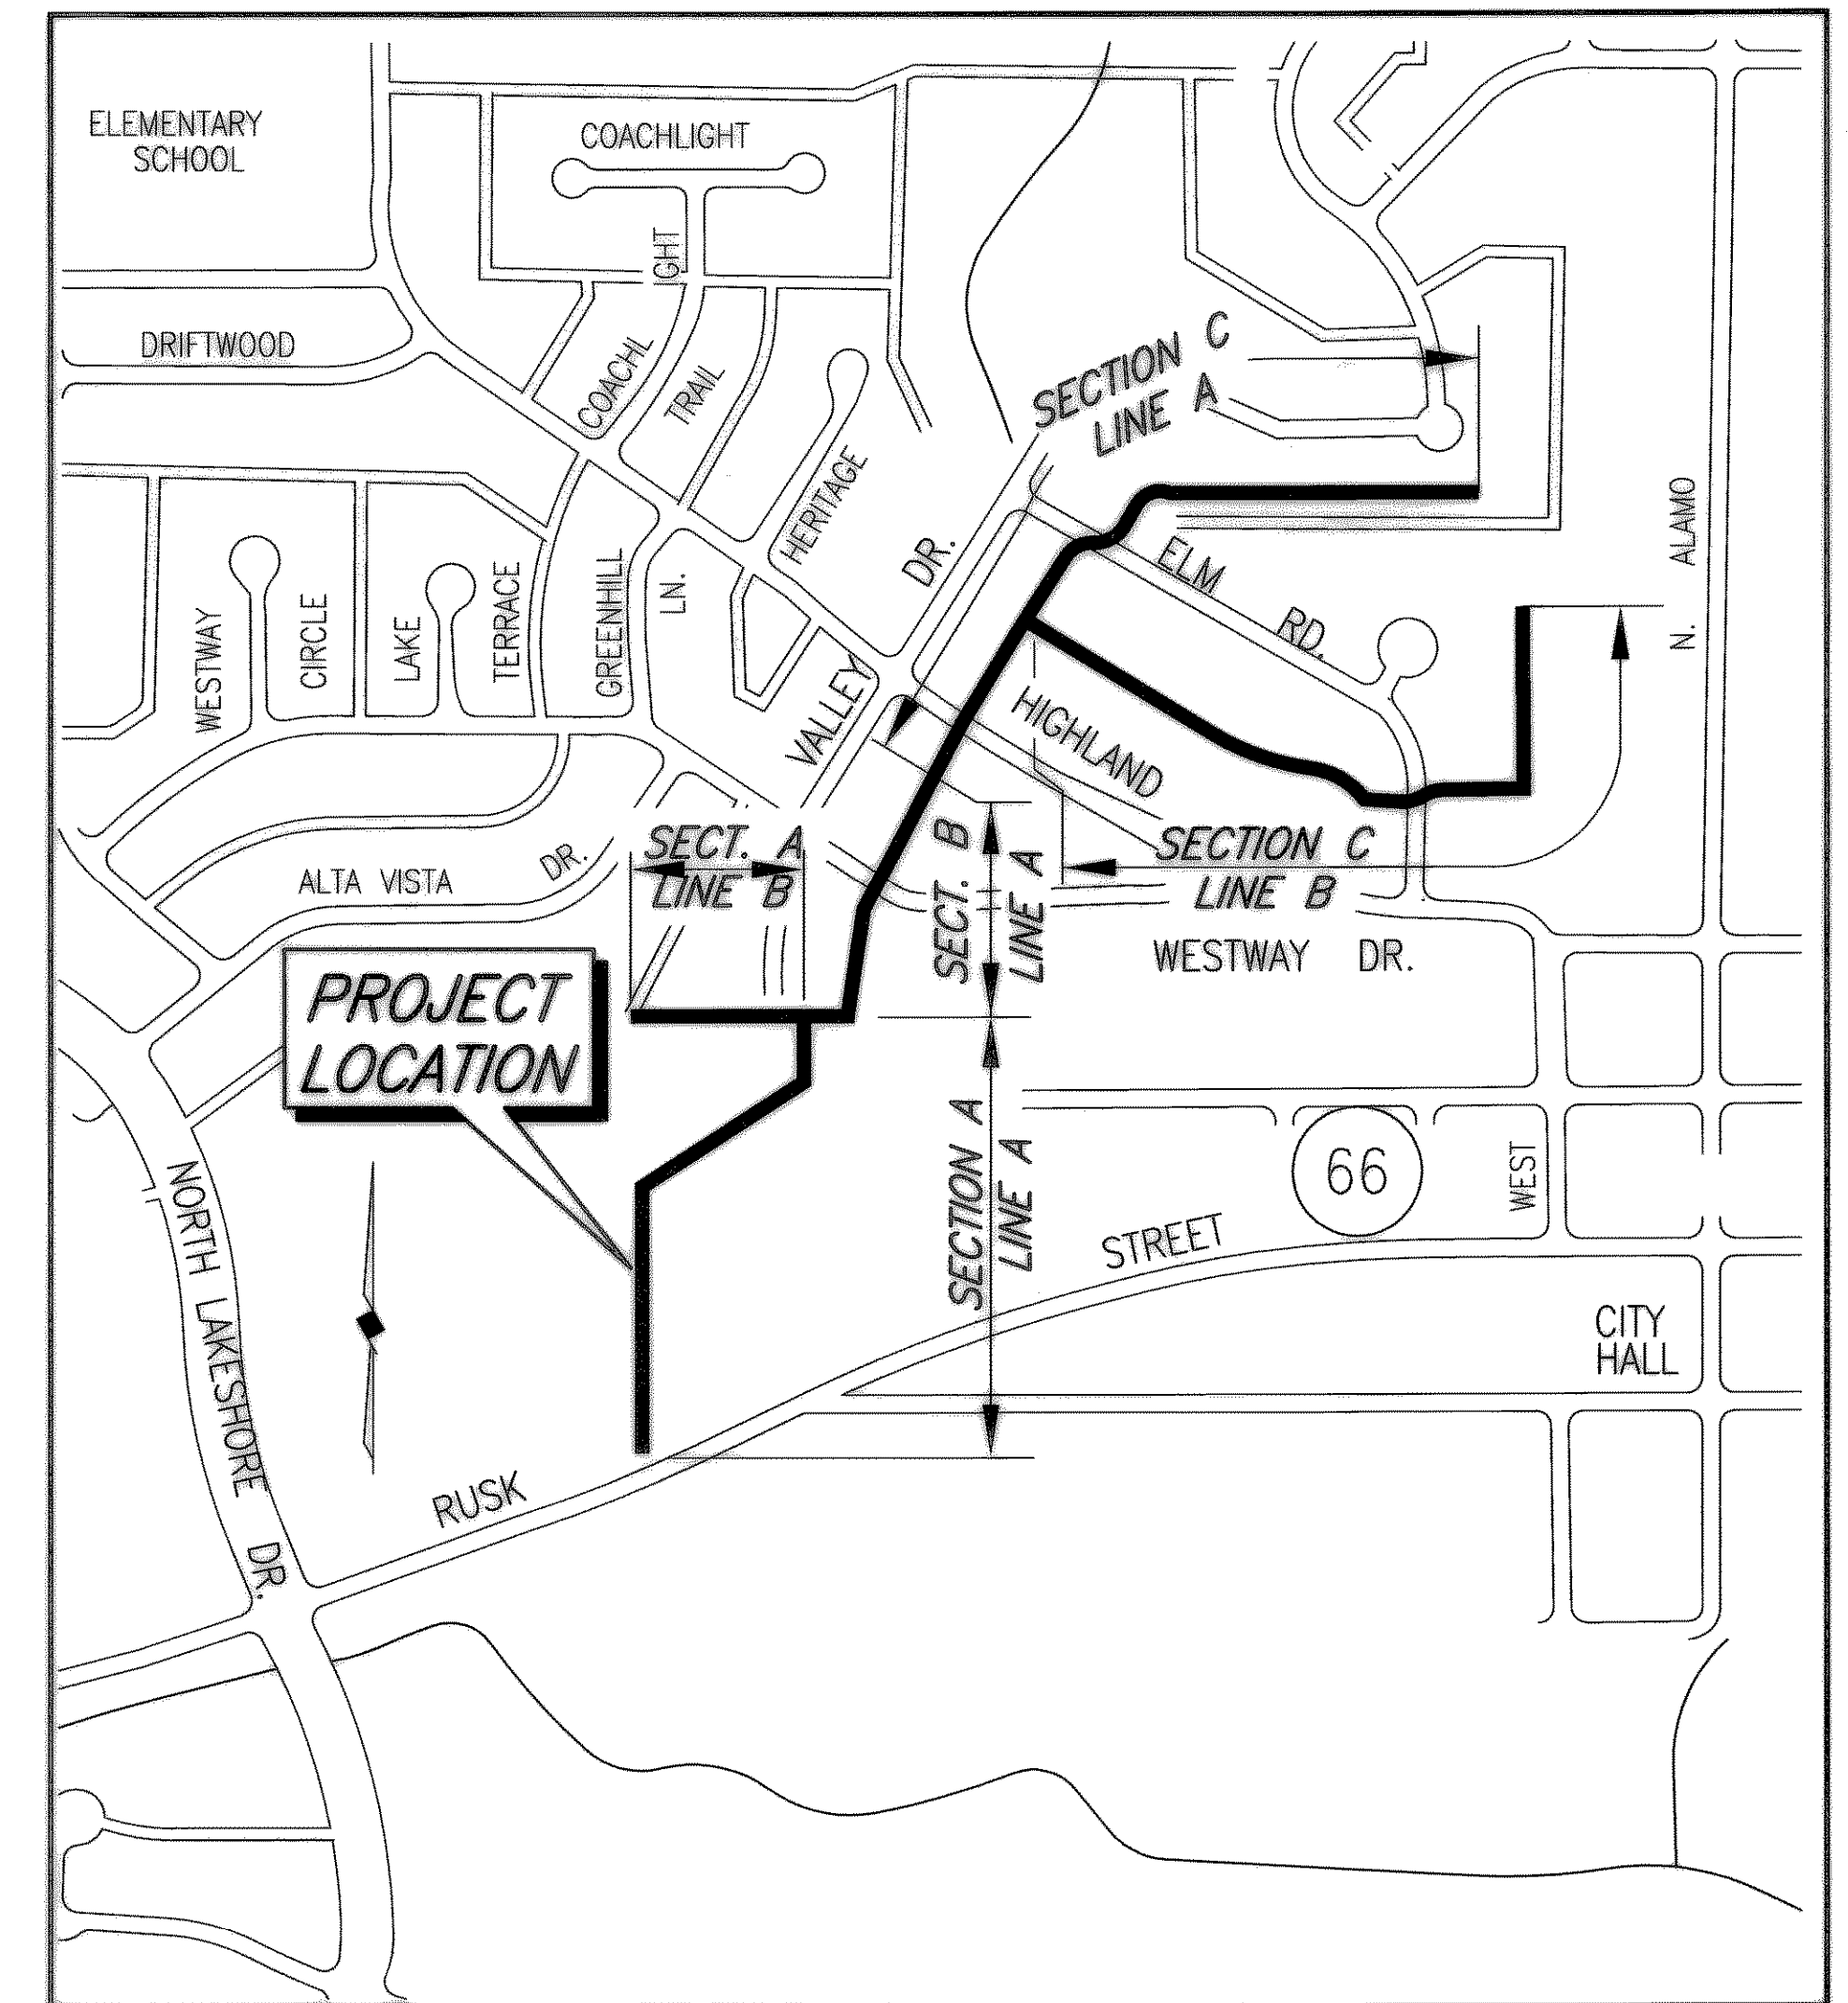

LOCATION MAP
 SCALE: 1"=300'

SHEET INDEX

SHEET NO.	SHEET DESCRIPTION
-	COVER SHEET, LOCATION MAP AND INDEX
1-2	SECTION A, LINE A PLAN-PROFILE STA. 0+00 - 9+45.1
3	SECTION A, LINE B PLAN-PROFILE STA. 0+00 - 3+29.10
4	SECTION B, LINE A & SECTION C, LINE A PLAN-PROFILE STA. 0+00 - 5+00
5-6	SECTION C, LINE A PLAN-PROFILE STA. 5+00 - 13+40.59
7-9	SECTION C, LINE B PLAN-PROFILE STA. 0+00 - 12+08.90
10	GENERAL NOTES & DETAILS

REVISED TO CONFORM
 TO CONSTRUCTION RECORDS
 BY P.A.C. DATE 01/12/2005

THESE DOCUMENTS ARE FOR
 BIDDING, CONSTRUCTION,
 AND PERMIT PURPOSES.
 DATE: 7/12/02

