



PLAN
 NOTE BOOK
 1/11/88

PROFILE
 NOTE BOOK
 1/11/88

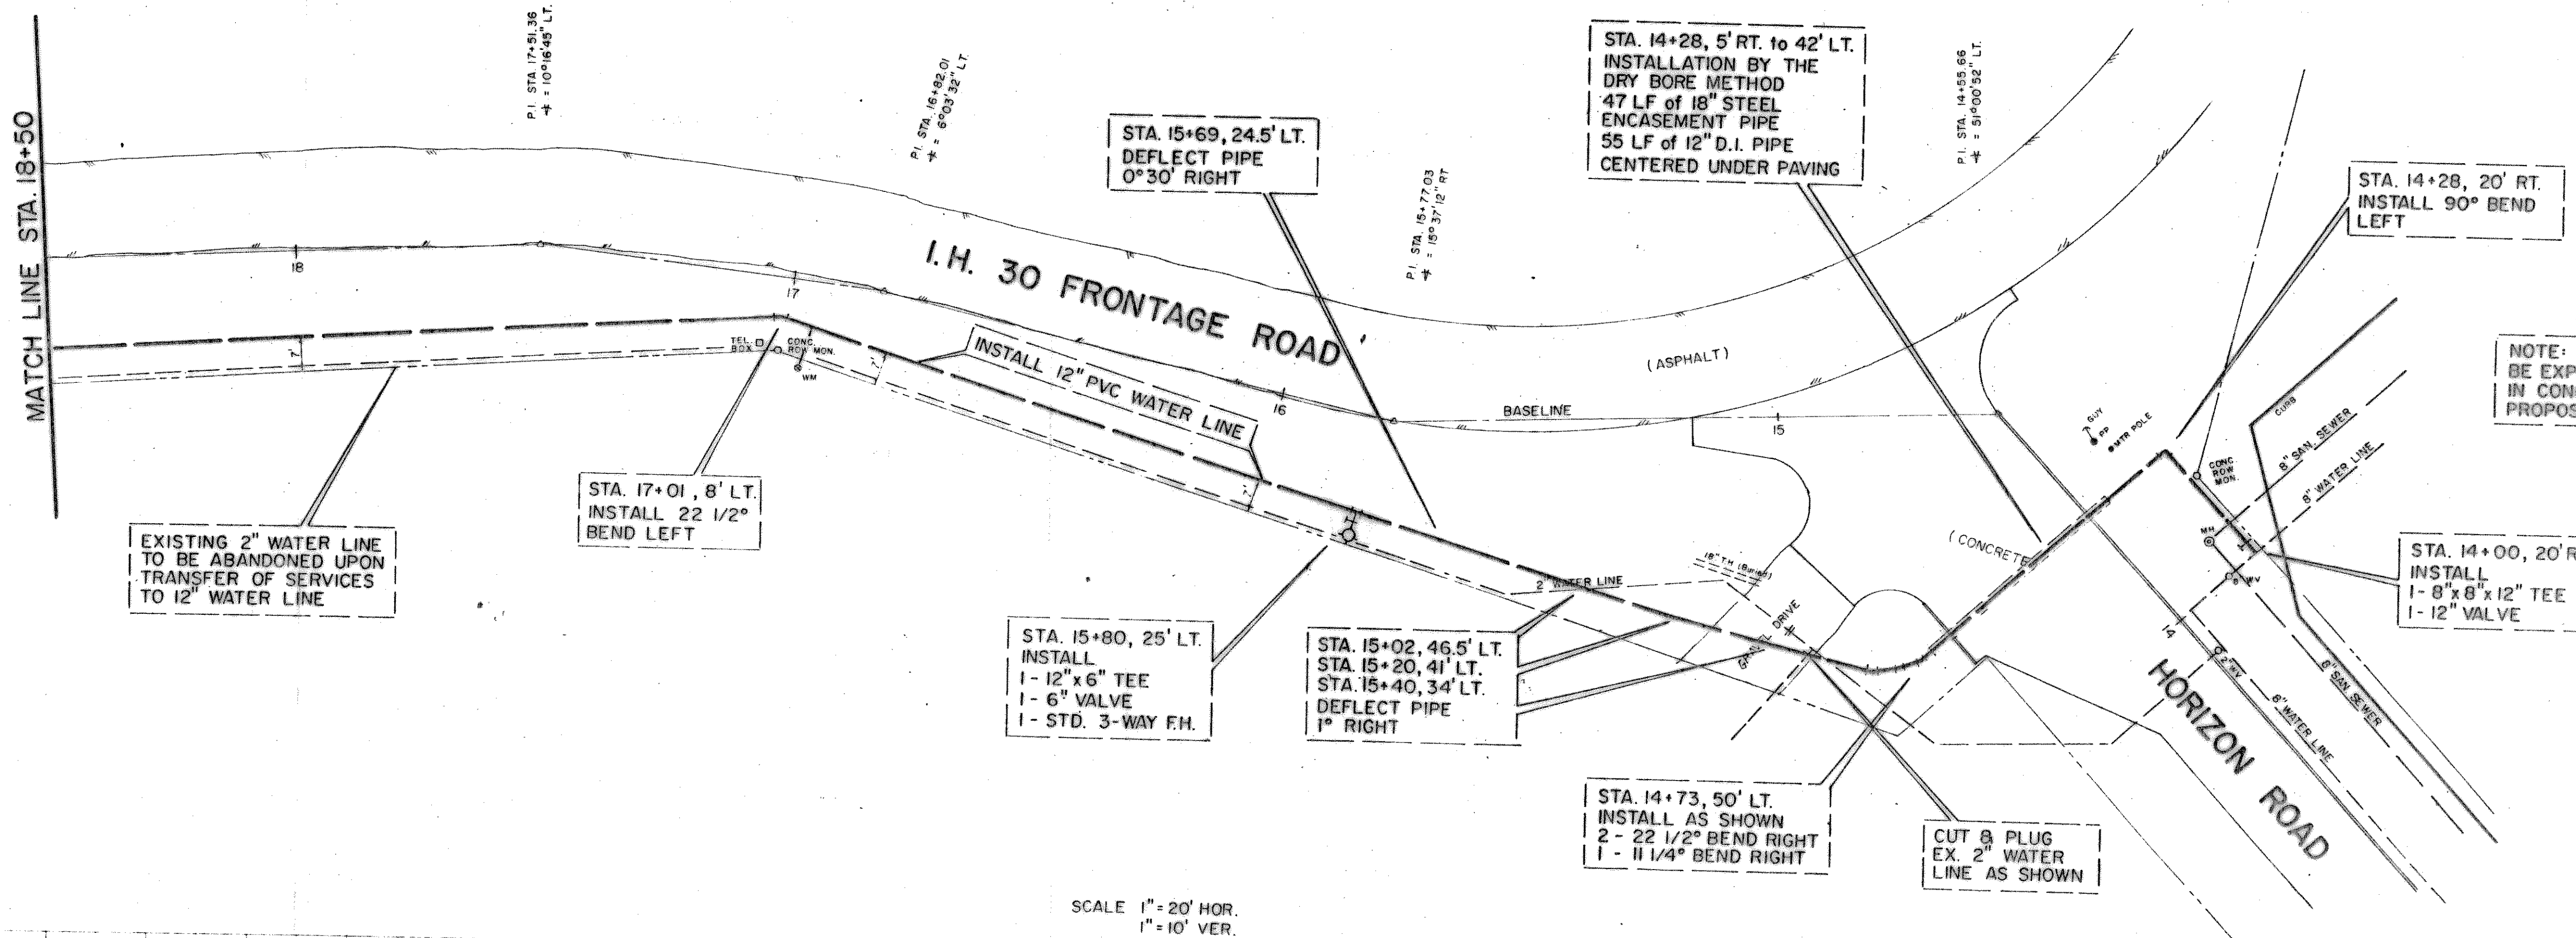

SCALE 1" = 20' HOR.
 1" = 10' VER.

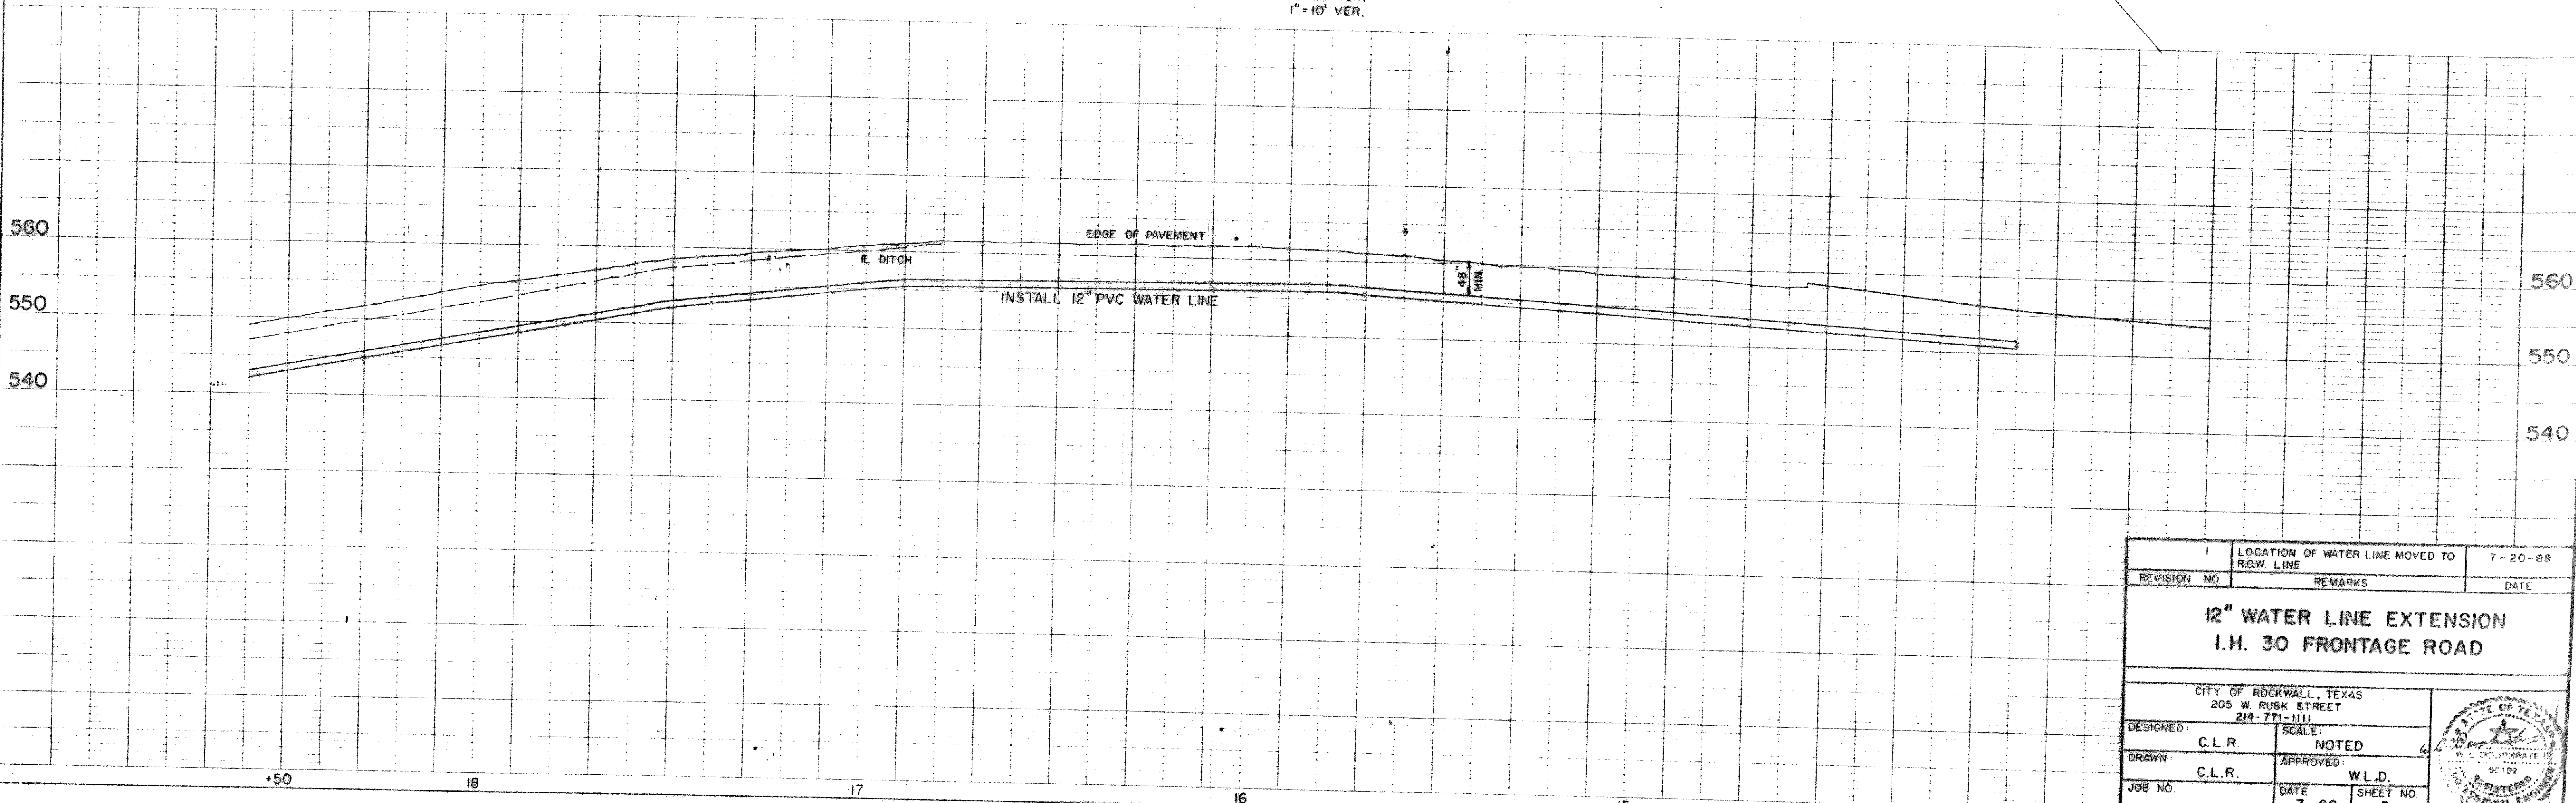

1	LOCATION OF WATER LINE MOVED TO R.O.W. LINE	7-20-88
REVISION NO.	REMARKS	DATE
12" WATER LINE EXTENSION I.H. 30 FRONTAGE ROAD		
CITY OF ROCKWALL, TEXAS 205 W. RUSK STREET 214-771-1111		
DESIGNED:	C.L.R.	SCALE: NOTED
DRAWN:	C.L.R.	APPROVED: W.L.D.
JOB NO.	DATE: 7-88	SHEET NO. 3

