
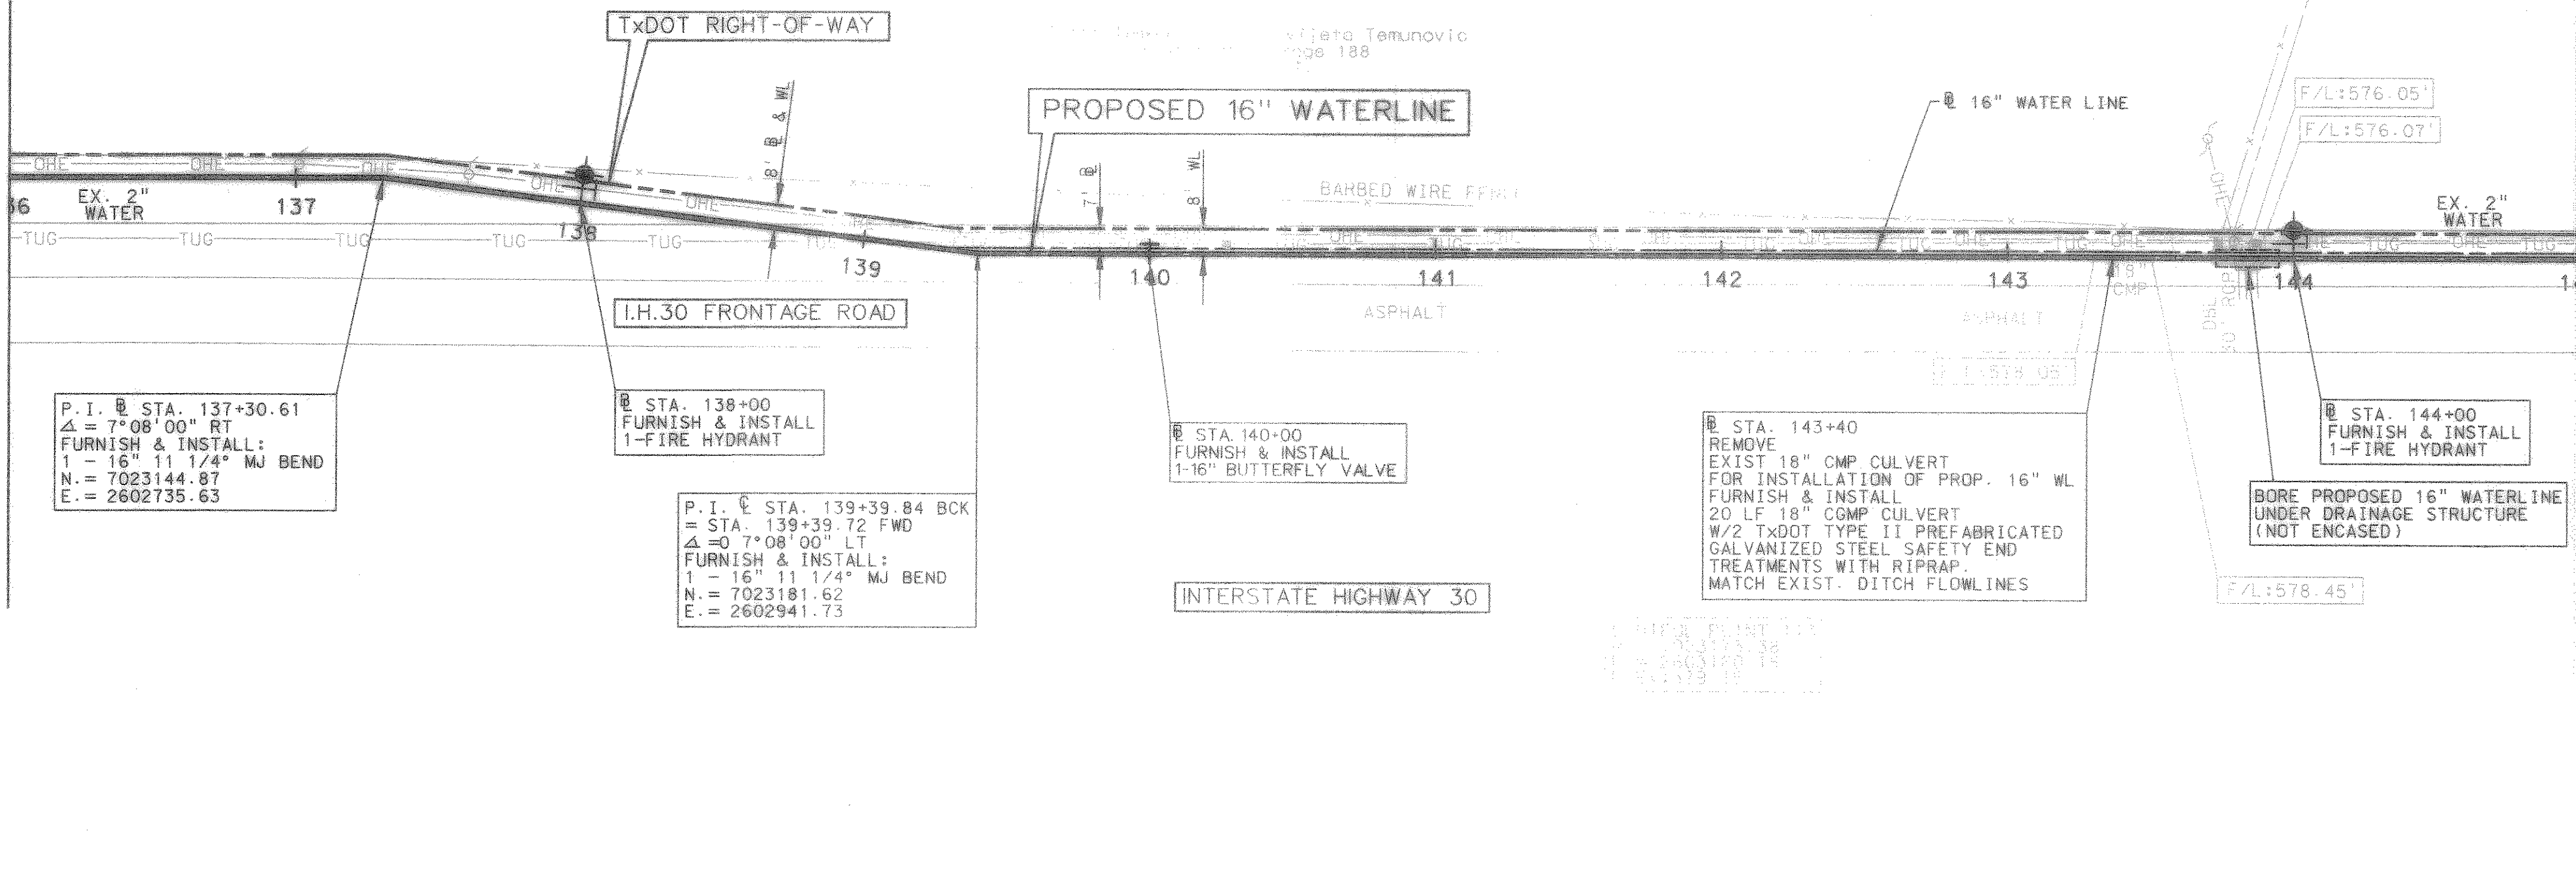
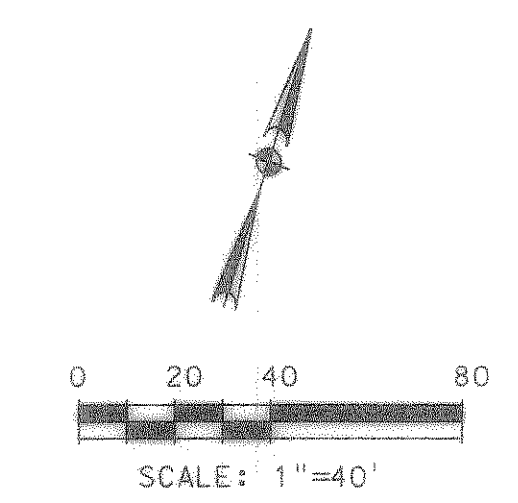


MATCH LINE @ STA. 136+00

MATCH LINE @ STA. 145+00

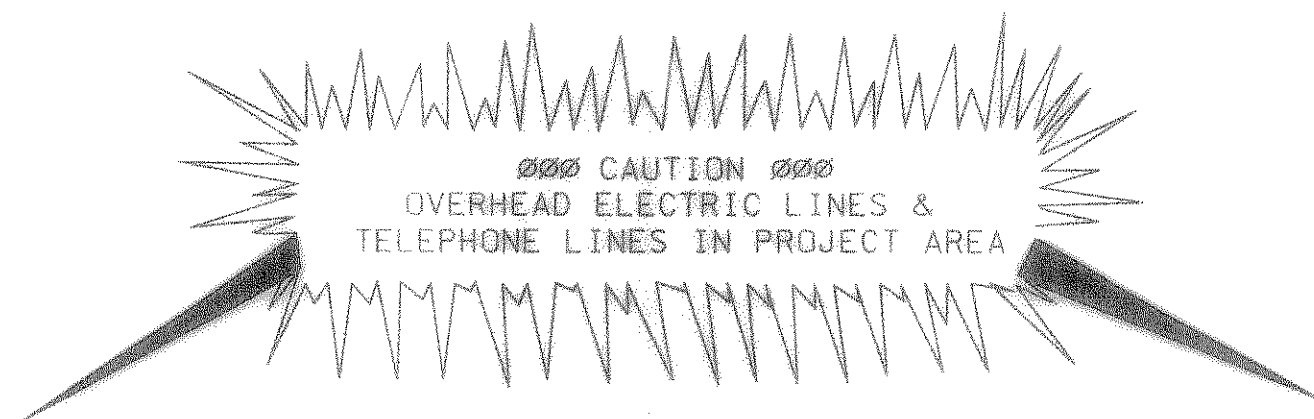

P.I. @ STA. 137+30.61  
Δ = 7°08'00" RT  
FURNISH & INSTALL:  
1 - 16" 11 1/4" MJ BEND  
N = 7023144.87  
E = 2602735.63

@ STA. 138+00  
FURNISH & INSTALL  
1-FIRE HYDRANT

P.I. @ STA. 139+39.84 BCK  
= STA. 139+39.72 FWD  
Δ = 0°07'00" LT  
FURNISH & INSTALL:  
1 - 16" 11 1/4" MJ BEND  
N = 7023181.62  
E = 2602941.73

INTERSTATE HIGHWAY 30

@ STA. 140+00  
FURNISH & INSTALL  
1-16" BUTTERFLY VALVE



@ STA. 144+00  
FURNISH & INSTALL  
1-FIRE HYDRANT

BORE PROPOSED 16" WATERLINE  
UNDER DRAINAGE STRUCTURE  
(NOT ENCASED)

LEGEND	
	POWER POLE
	GUY WIRE
	TELEPHONE BOX
	POST
	SIGN
	IRON ROD
	FIRE HYDRANT
	WATER VALVE
	MAILBOX
	WATER METER
	IRRIGATION CONTROL VALVE
	GUARD RAIL
	GAS METER
	WASTE WATER MANHOLE
	CHAIN LINK FENCE
	WOOD FENCE
	IRON ROD FOUND
	MONUMENT
	ELECTRIC BOX
	BARBED WIRE FENCE
	TREE
	TELEPHONE UNDERGROUND
	APPROXIMATE GAS LINE
	APPROXIMATE WATER LINE
	OVERHEAD POWER LINE
	TELEPHONE MANHOLE
	TRAFFIC SIGNAL CONTROL BOX
	GAS VALVE

**UNDERGROUND UTILITIES**

THE LOCATION OF EXISTING UTILITIES SHOWN ON THESE PLANS ARE APPROXIMATE AND BASED ON DATA FURNISHED BY UTILITY COMPANIES. IT IS THE RESPONSIBILITY OF THE CONTRACTOR TO LOCATE AND VERIFY ON-SITE THE UTILITIES THAT MAY CONFLICT WITH THE CONSTRUCTION.

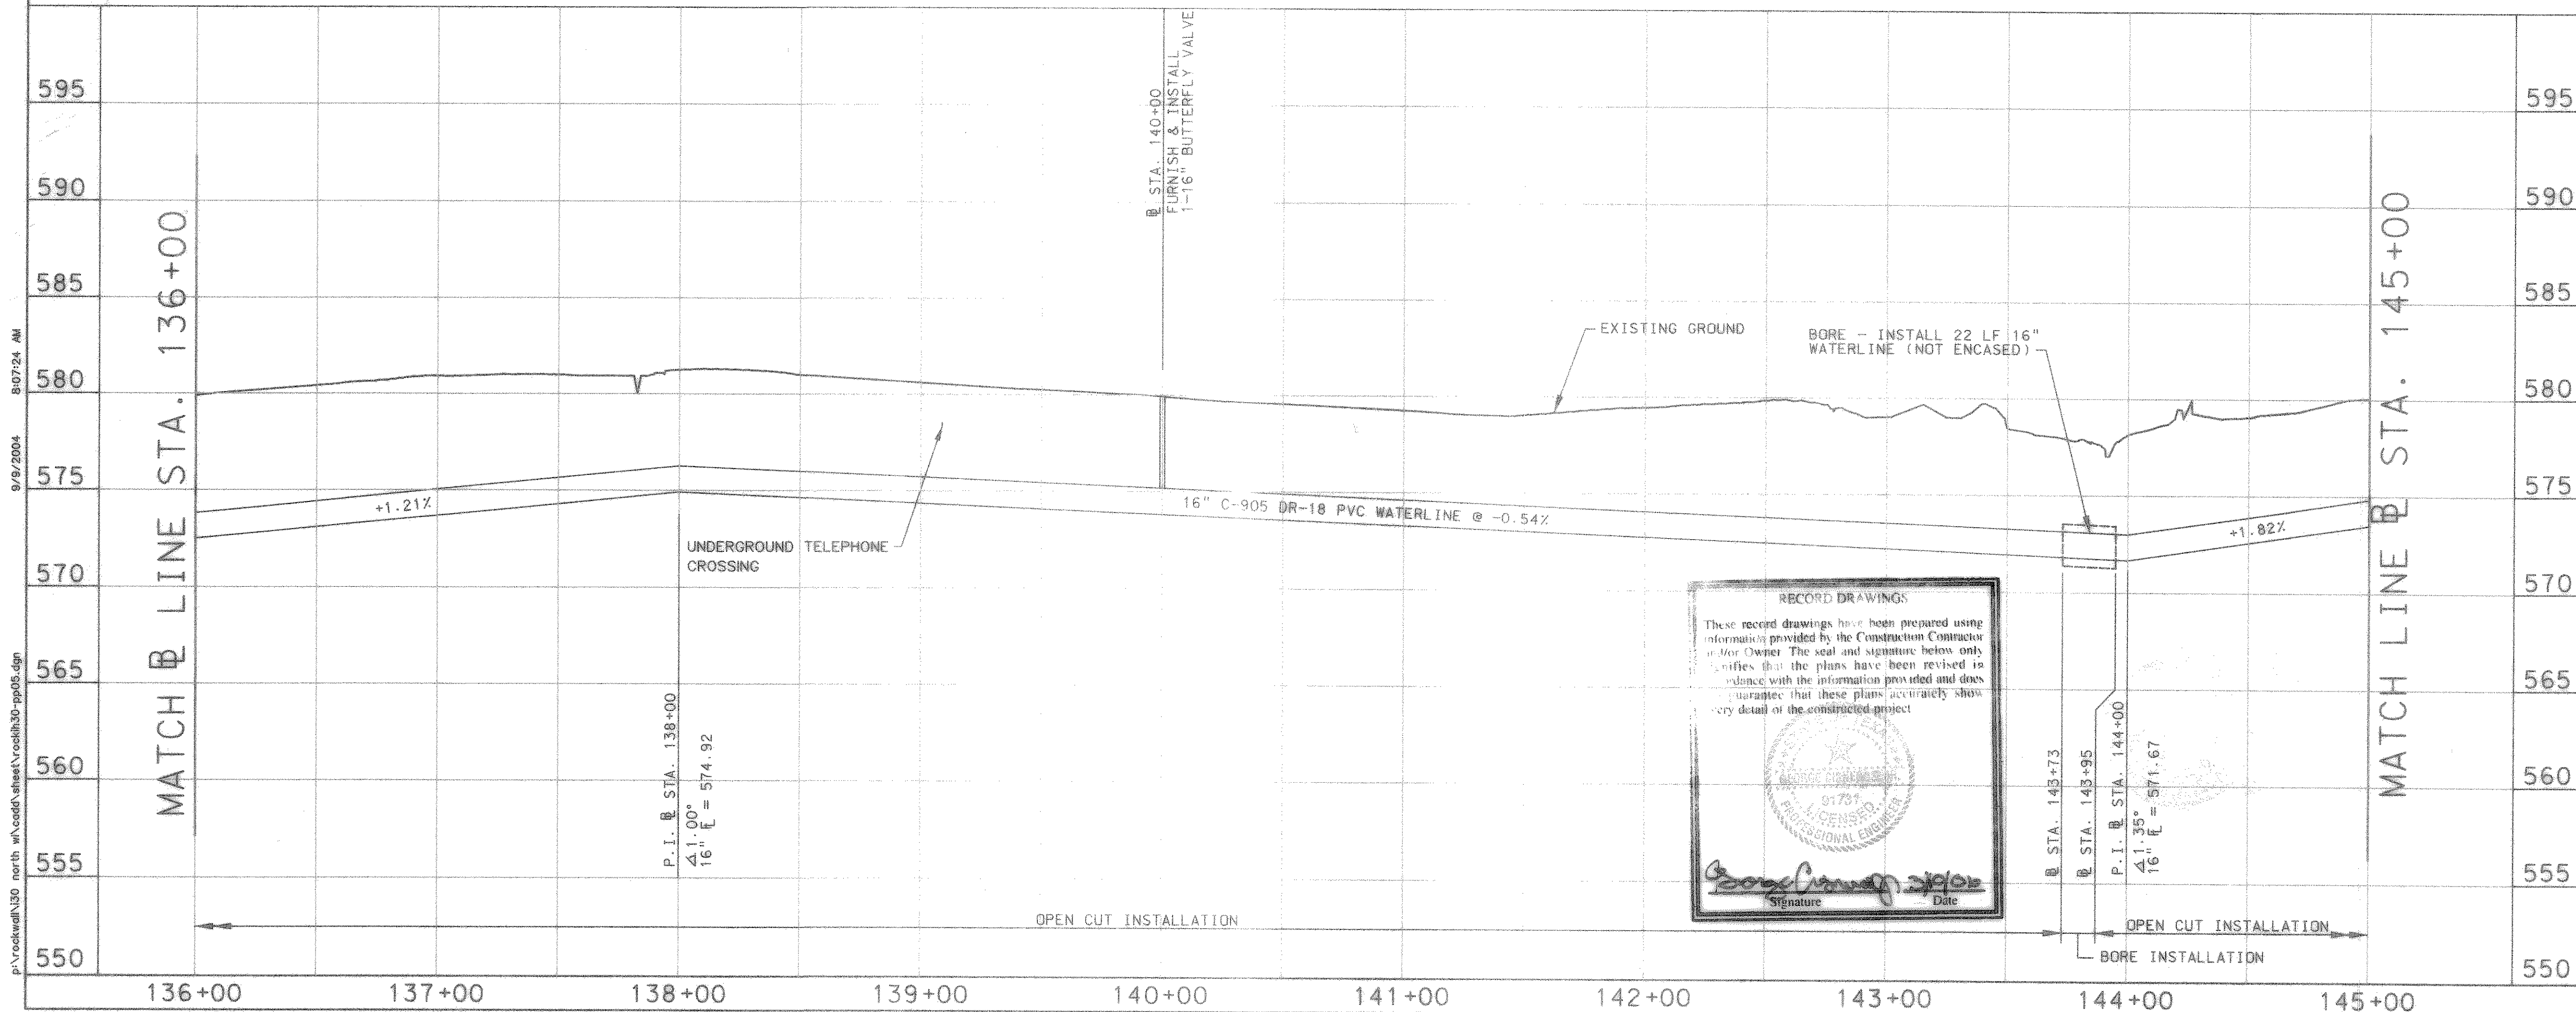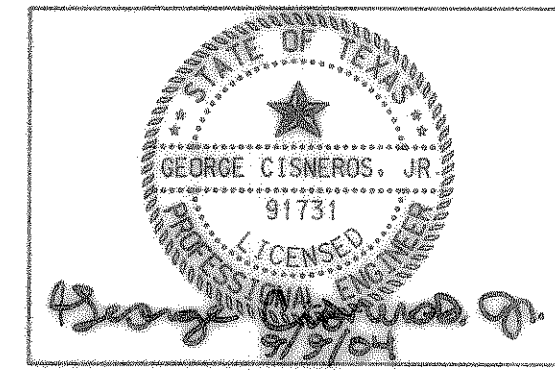

**RECORD DRAWINGS**

These record drawings have been prepared using information provided by the Construction Contractor and/or Owner. The seal and signature below only certifies that the plans have been revised in accordance with the information provided and does not guarantee that these plans accurately show every detail of the constructed project.

*George Cisneros, Jr.*  
Signature Date

NO.	DATE	REVISION	APPROV.
4			
3			
2			
1			

**CITY OF ROCKWALL**  
"THE NEW HORIZON"

IH-30 NORTH AND FM 549  
WATER LINE - PHASE ONE

@ STA. 136+00 TO @ STA. 145+00

**TCB** TurnerCollie & Braden Inc.  
Engineers • Planners • Project Managers

Unit	A123	Scale	Horizontal: 1"=40'	Date	SEPTEMBER 2004
Designed	GC	Checked	TBS	Job No.	052131875-0001
Drawn	GBA	Approved	RCR	Sheet	10 of 25

p:\rockwall\130\_north\rockwall\130\130-30-pp05.dgn 9/9/2004 8:07:24 AM