


MATCH LINE @ STA. 208+00



MATCH LINE @ STA. 217+00

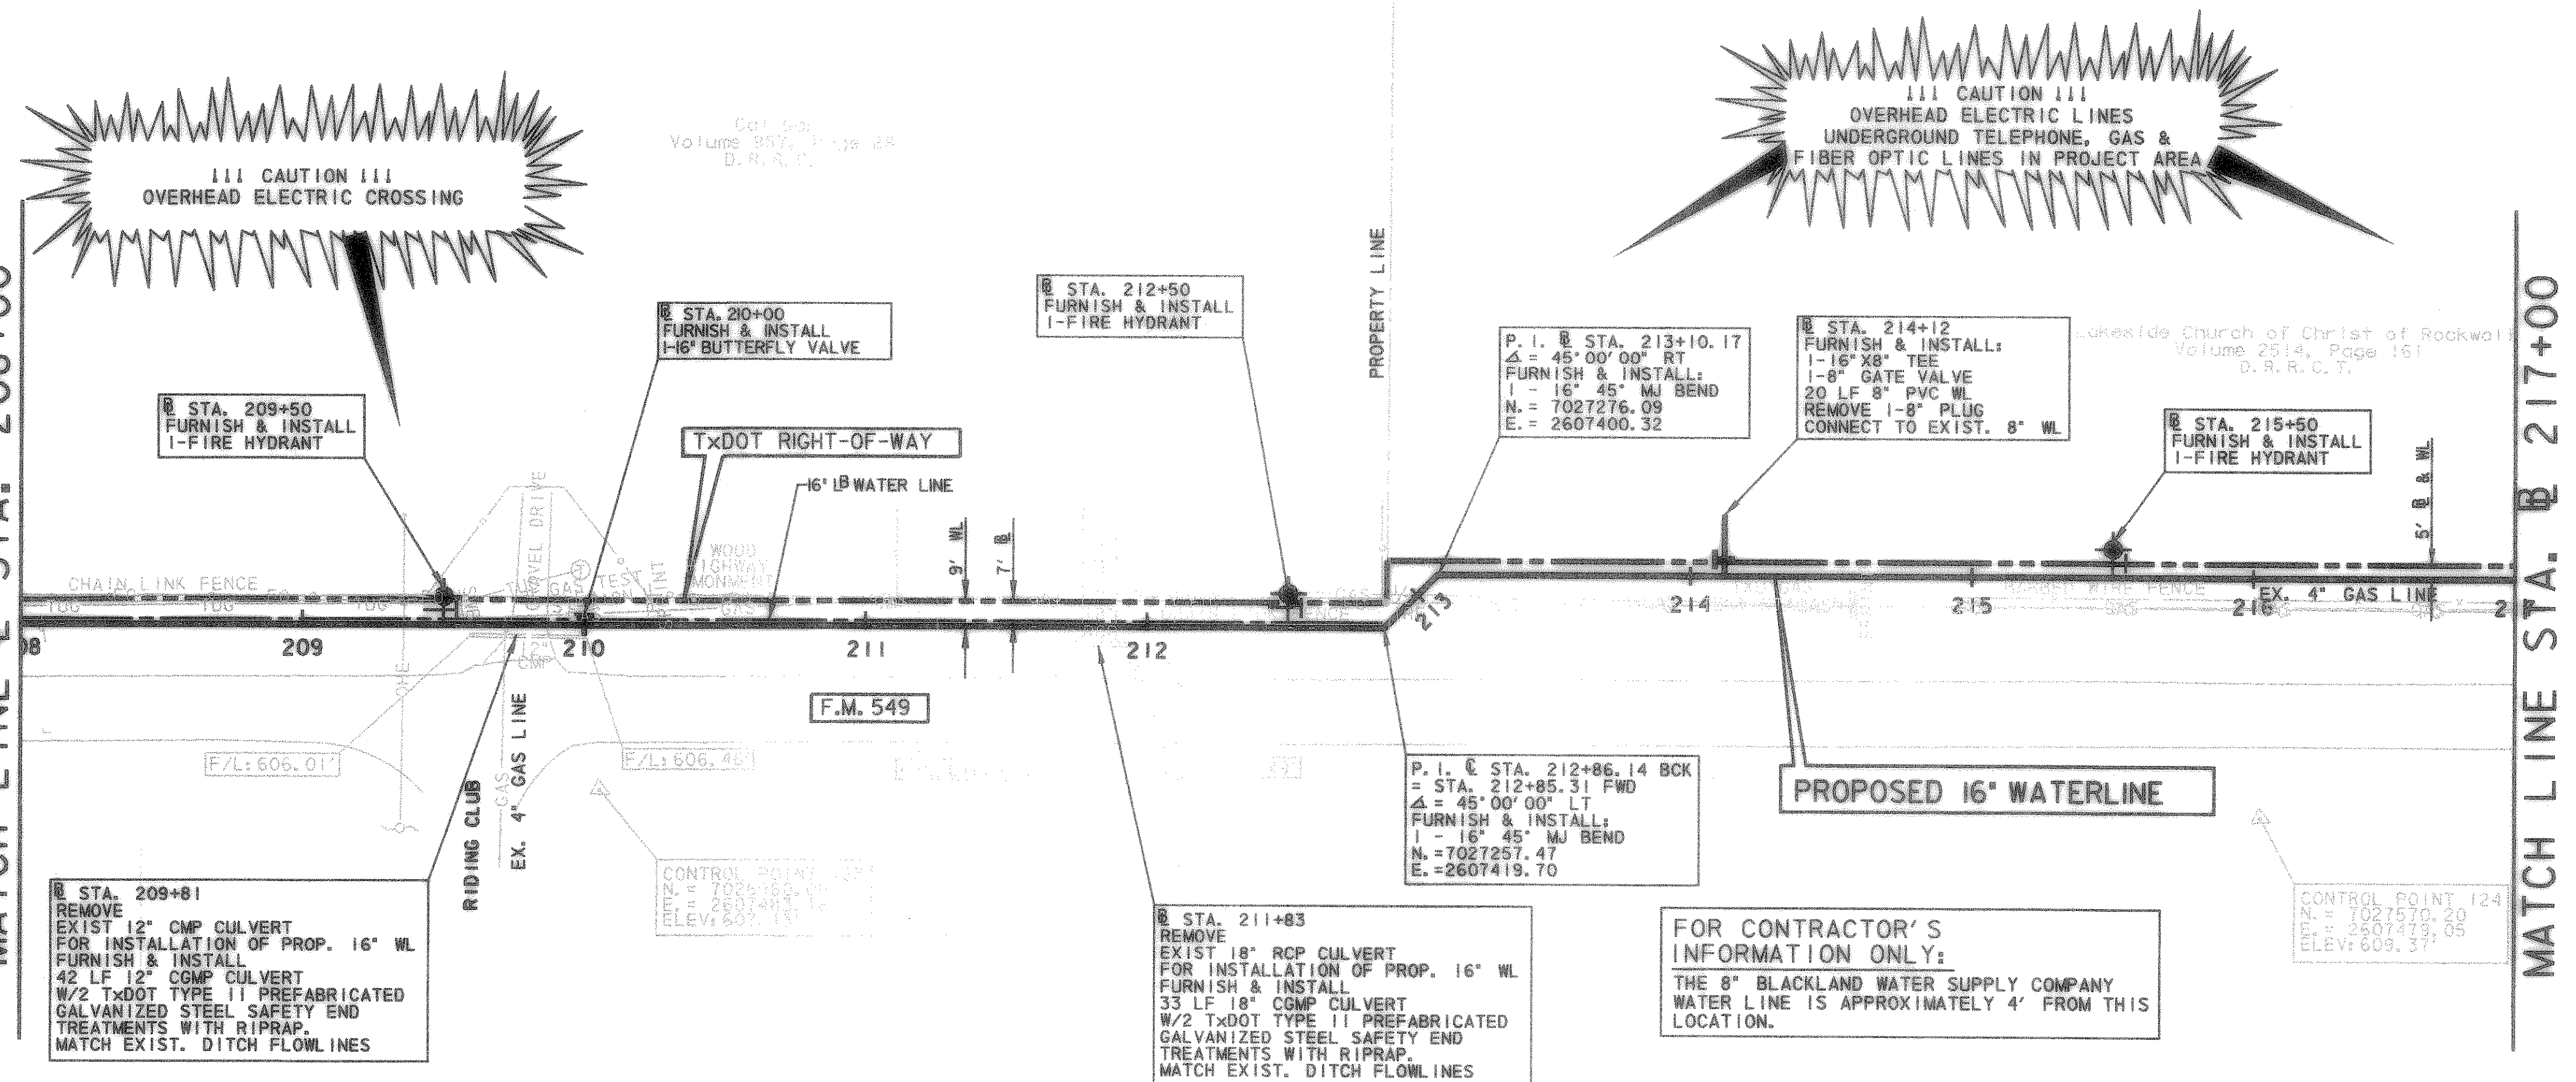

LEGEND	
	POWER POLE
	GUY WIRE
	TELEPHONE BOX
	POST
	SIGN
	IRON ROD
	FIRE HYDRANT
	WATER VALVE
	MAILBOX
	WATER METER
	IRRIGATION CONTROL VALVE
	GUARD RAIL
	GAS METER
	WASTE WATER MANHOLE
	CHAIN LINK FENCE
	WOOD FENCE
	IRON ROD FOUND
	MONUMENT
	ELECTRIC BOX
	BARBED WIRE FENCE
	TREE
	TELEPHONE UNDERGROUND
	APPROXIMATE GAS LINE
	APPROXIMATE WATER LINE
	OVERHEAD POWER LINE
	TELEPHONE MANHOLE
	TRAFFIC SIGNAL CONTROL BOX
	GAS VALVE

FOR CONTRACTOR'S INFORMATION ONLY:
THE 8" BLACKLAND WATER SUPPLY COMPANY WATER LINE IS APPROXIMATELY 4' FROM THIS LOCATION.

UNDERGROUND UTILITIES
THE LOCATION OF EXISTING UTILITIES SHOWN ON THESE PLANS ARE APPROXIMATE AND BASED ON DATA FURNISHED BY UTILITY COMPANIES. IT IS THE RESPONSIBILITY OF THE CONTRACTOR TO LOCATE AND VERIFY ON-SITE THE UTILITIES THAT MAY CONFLICT WITH THE CONSTRUCTION.

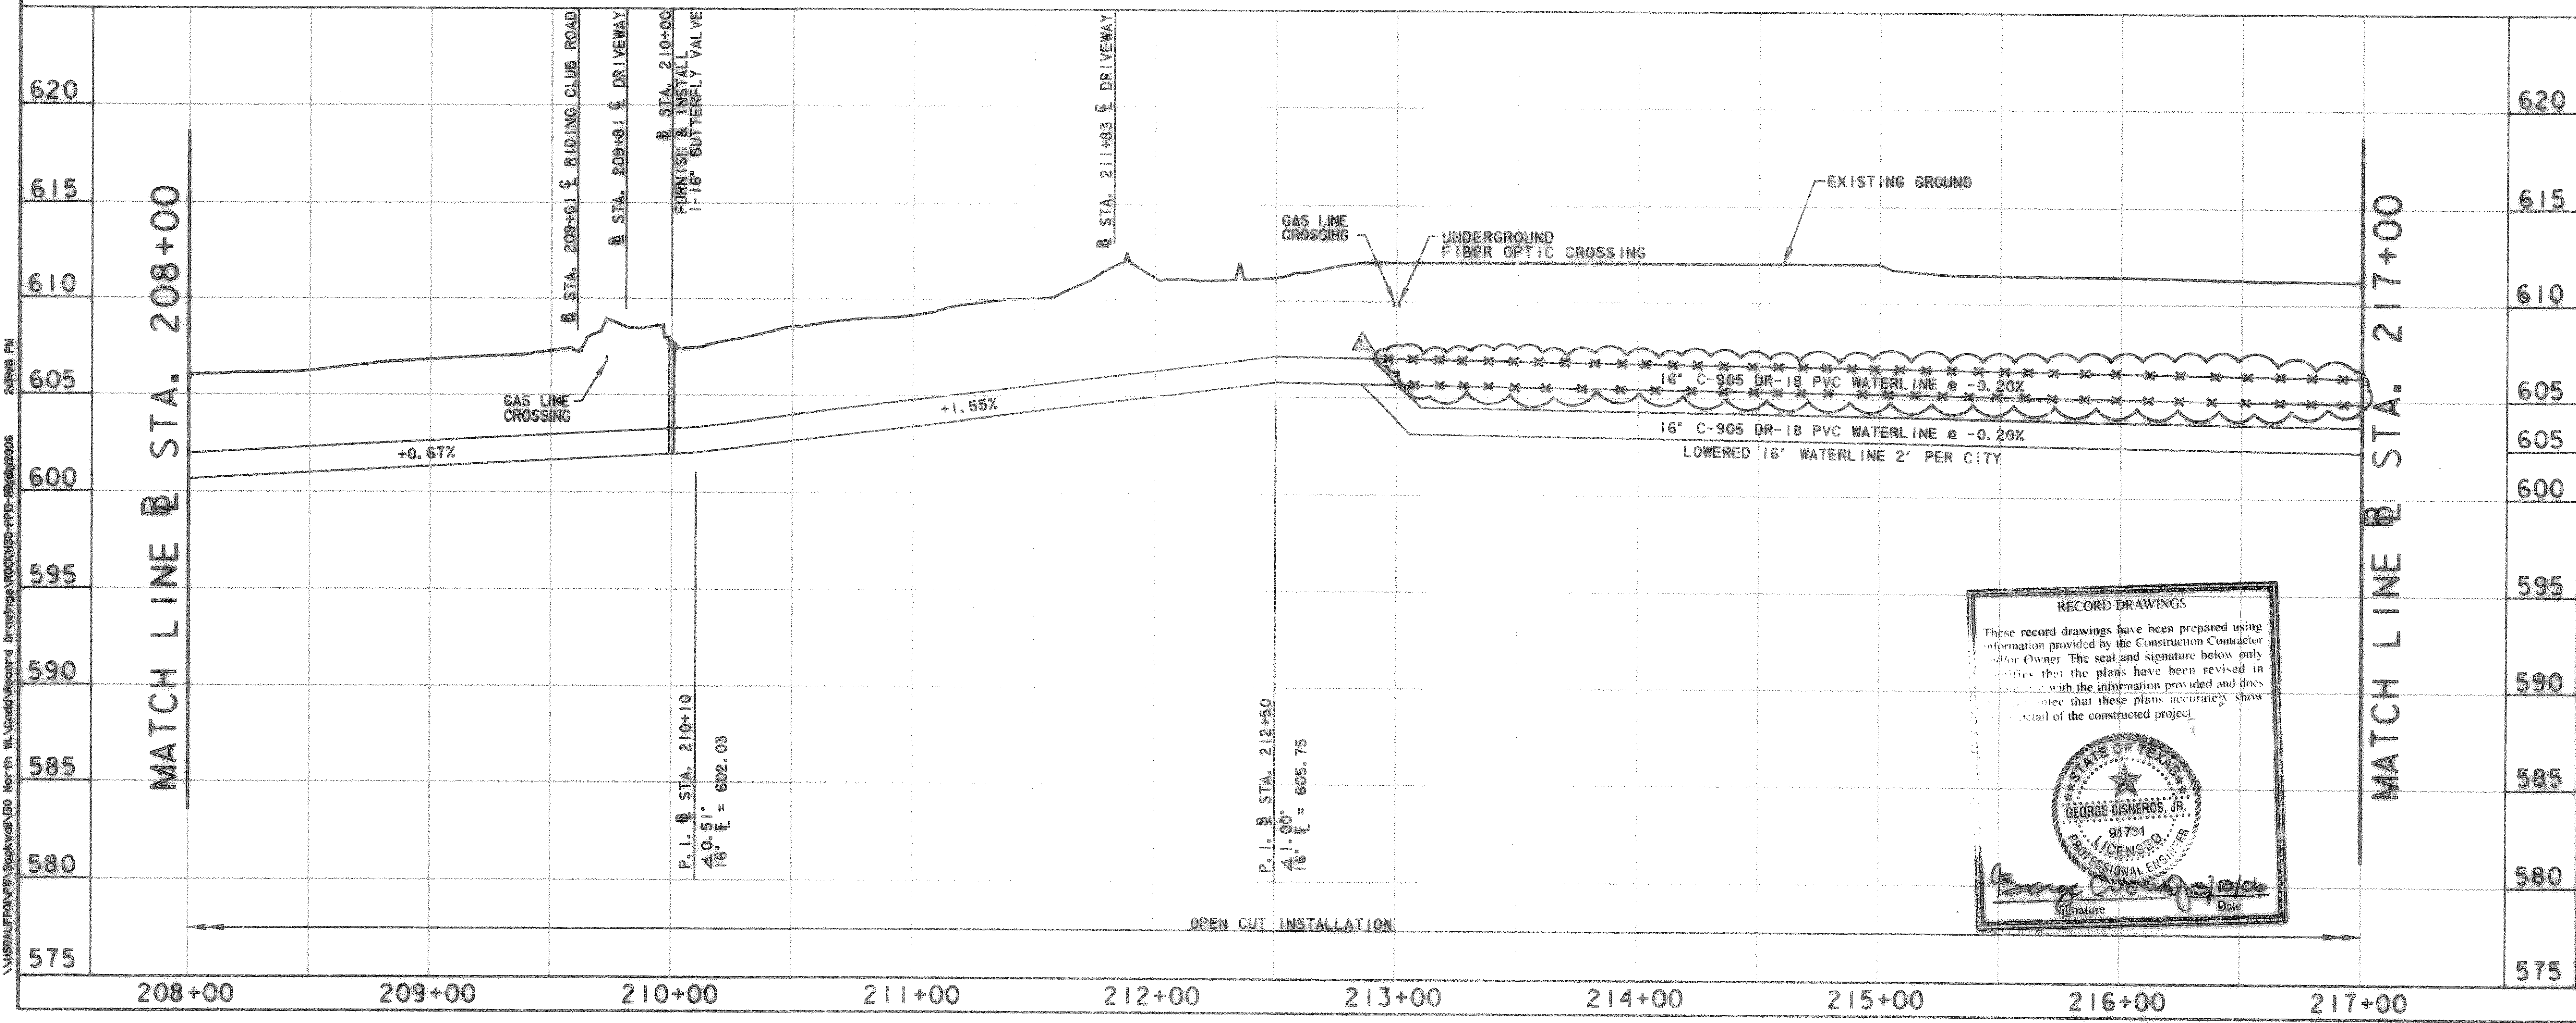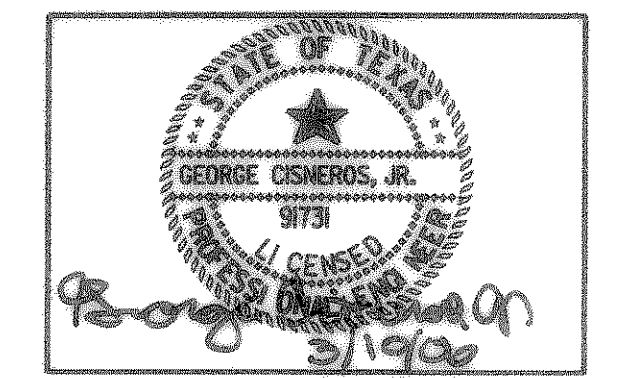

RECORD DRAWINGS
These record drawings have been prepared using information provided by the Construction Contractor and the Owner. The seal and signature below only certify that the plans have been reviewed in accordance with the information provided and does not certify that these plans accurately show the actual of the constructed project.

George Cisneros, Jr.
Signature Date

4			
3			
2			
1	09-09-06	RECORD DRAWING	
	NO.	DATE	REVISION
590	CITY OF ROCKWALL "THE NEW HORIZON"		
585	1H-30 NORTH AND FM 549 WATER LINE - PHASE TWO		
580	@ STA. 208+00 TO @ STA. 217+00		
575	TCB TurnerCollie & Braden Inc. Engineers • Planners • Project Managers		
	Unit: A123	Scale: 1"=40'	Date: SEPTEMBER 2004
	Designed: GC	Checked: TBS	Job No. 052131875.0001
	Drawn: GBA	Approved: RCR	Sheet: 8 of 25

\\MSB\PL\PROJ\Rockwall\130 North Hill\Addtl\Record Drawings\02061830-PP10-1024270005 2/29/06 PM