


LEGEND	
	POWER POLE
	GUY WIRE
	TELEPHONE BOX
	POST
	SIGN
	IRON ROD
	FIRE HYDRANT
	WATER VALVE
	MAILBOX
	WATER METER
	IRRIGATION CONTROL VALVE
	GUARD RAIL
	GAS METER
	WASTE WATER MANHOLE
	CHAIN LINK FENCE
	WOOD FENCE
	IRON ROD FOUND
	MONUMENT
	ELECTRIC BOX
	BARBED WIRE FENCE
	TREE
	TELEPHONE UNDERGROUND
	APPROXIMATE GAS LINE
	APPROXIMATE WATER LINE
	OVERHEAD POWER LINE
	TELEPHONE MANHOLE
	TRAFFIC SIGNAL CONTROL BOX
	GAS VALVE


UNDERGROUND UTILITIES

THE LOCATION OF EXISTING UTILITIES SHOWN ON THESE PLANS ARE APPROXIMATE AND BASED ON DATA FURNISHED BY UTILITY COMPANIES. IT IS THE RESPONSIBILITY OF THE CONTRACTOR TO LOCATE AND VERIFY ON-SITE THE UTILITIES THAT MAY CONFLICT WITH THE CONSTRUCTION.

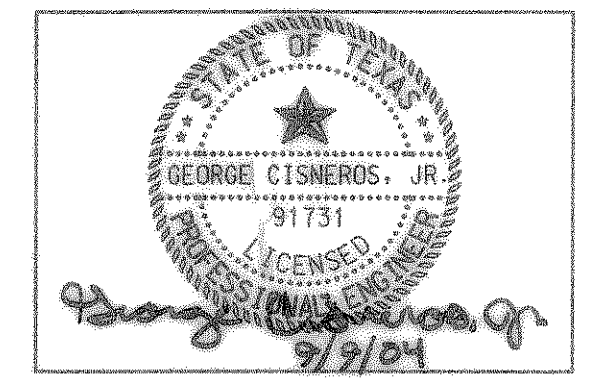



RECORD DRAWINGS

These record drawings have been prepared using information provided by the construction Contractor and/or Owner. The seal and signature below only signifies that the plans have been revised in accordance with the information provided and does not guarantee that these plans accurately show every detail of the constructed project.

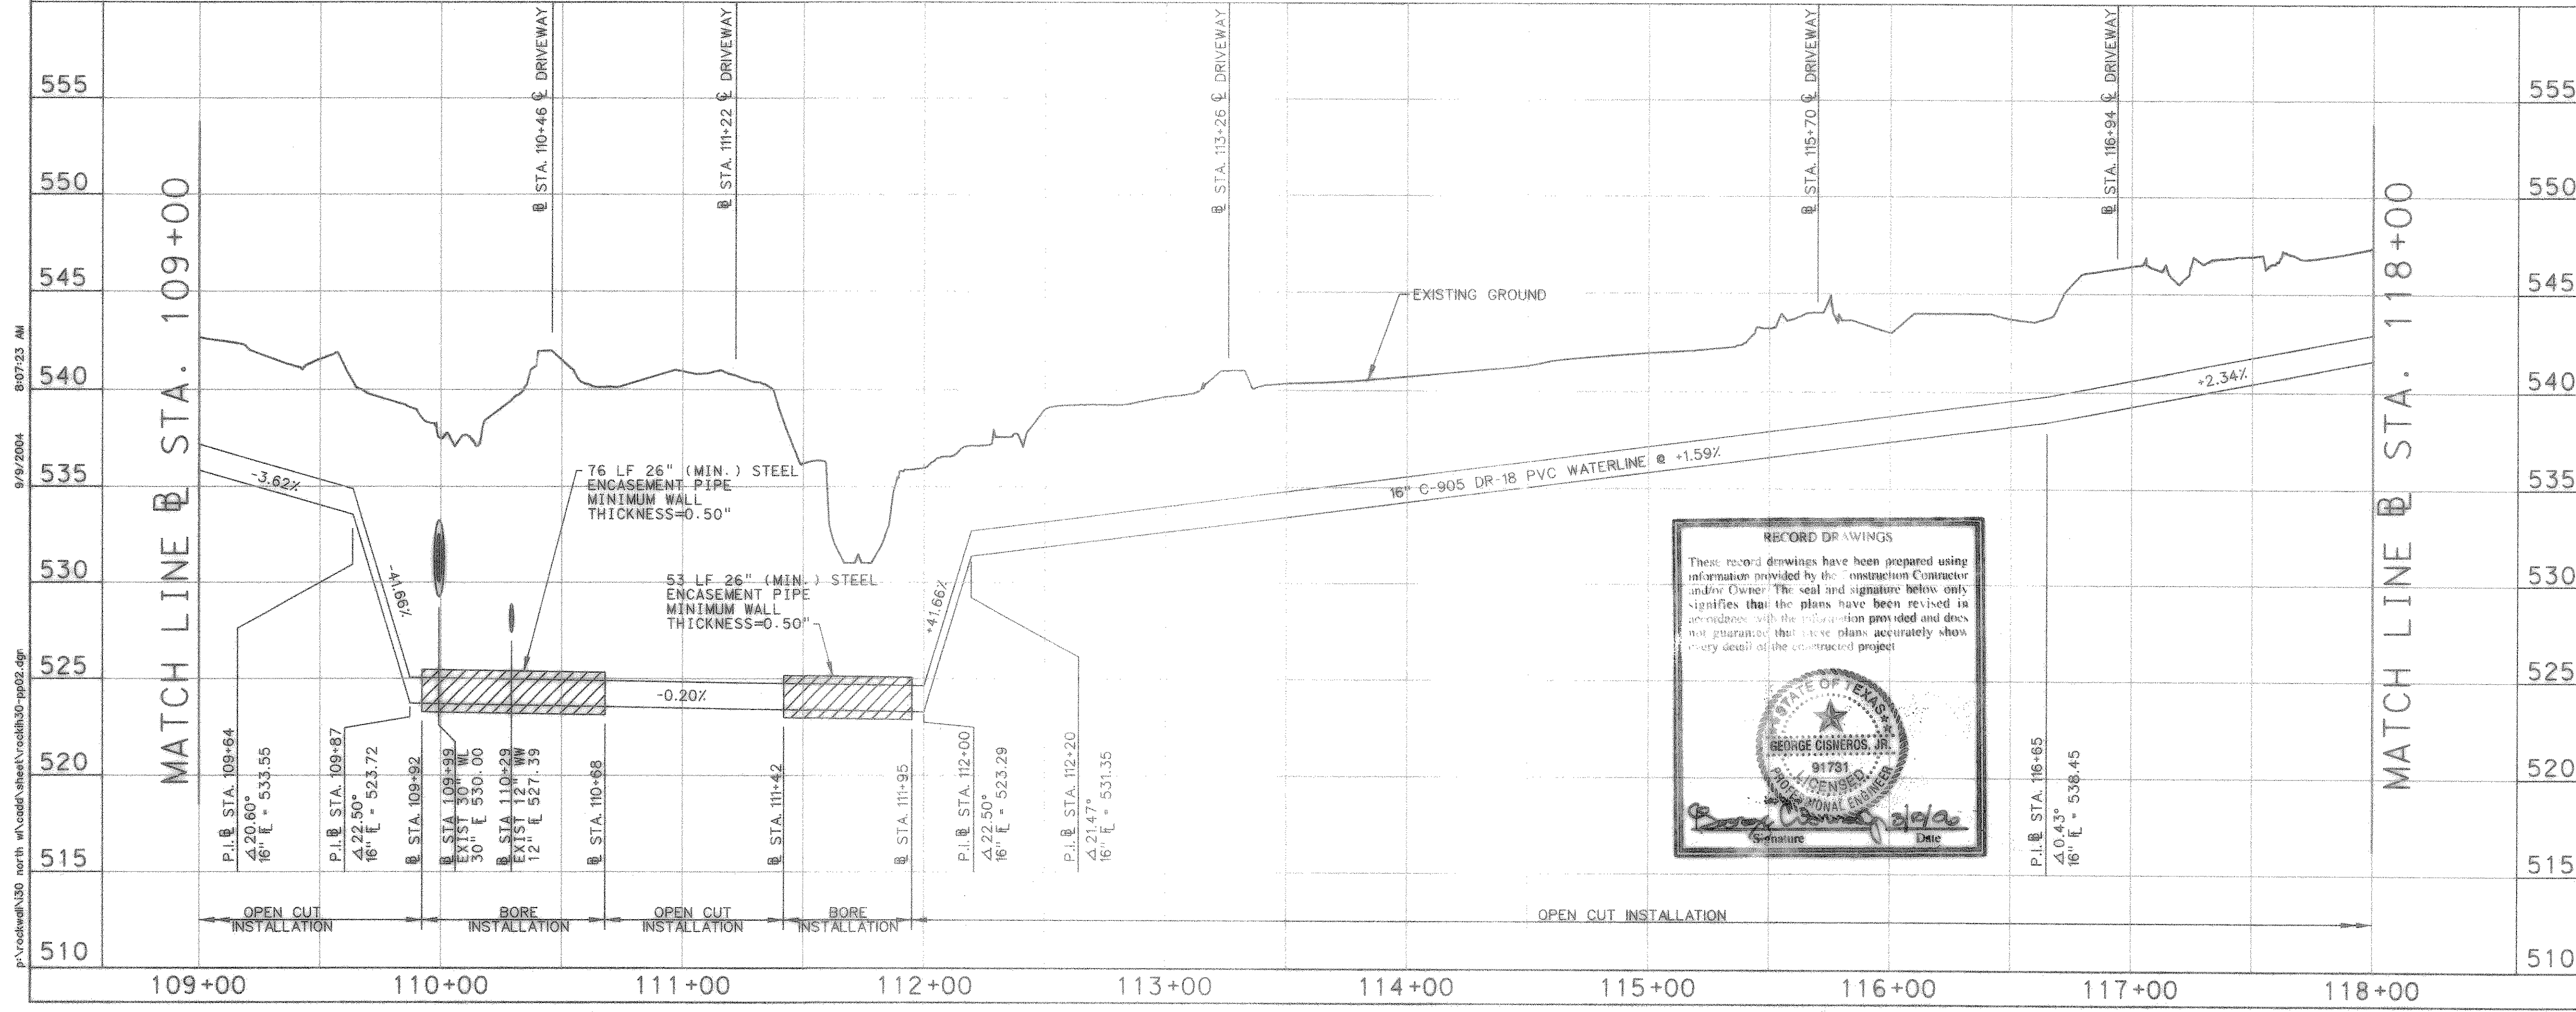

4			
3			
2			
1			
NO.	DATE	REVISION	APPROV.
 CITY OF ROCKWALL "THE NEW HORIZON" IH-30 NORTH AND FM 549 WATER LINE - PHASE ONE STA. 109+00 TO STA. 118+00			
 TCB Turner Collier & Braden, Inc. <small>Engineers • Planners • Project Managers</small>			
Unit	A123	Scale: Horiz. 1"=40' Vert. 1"=5'	Date: SEPTEMBER 2004
Designed	GC	Checked: TBS	Job No. 052131875-0001
Drawn	GBA	Approved: RCR	Sheet 7 of 25


MATCH LINE @ STA. 118+00

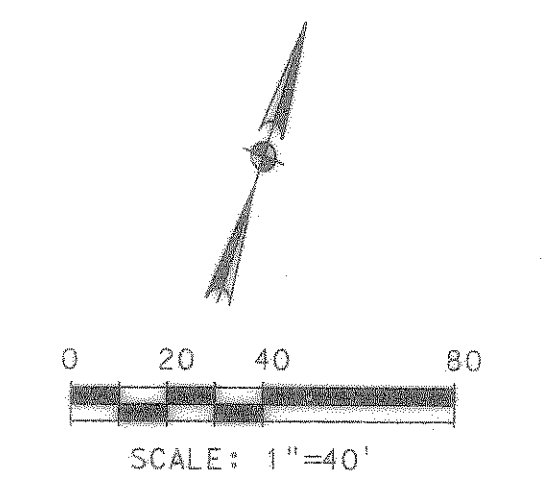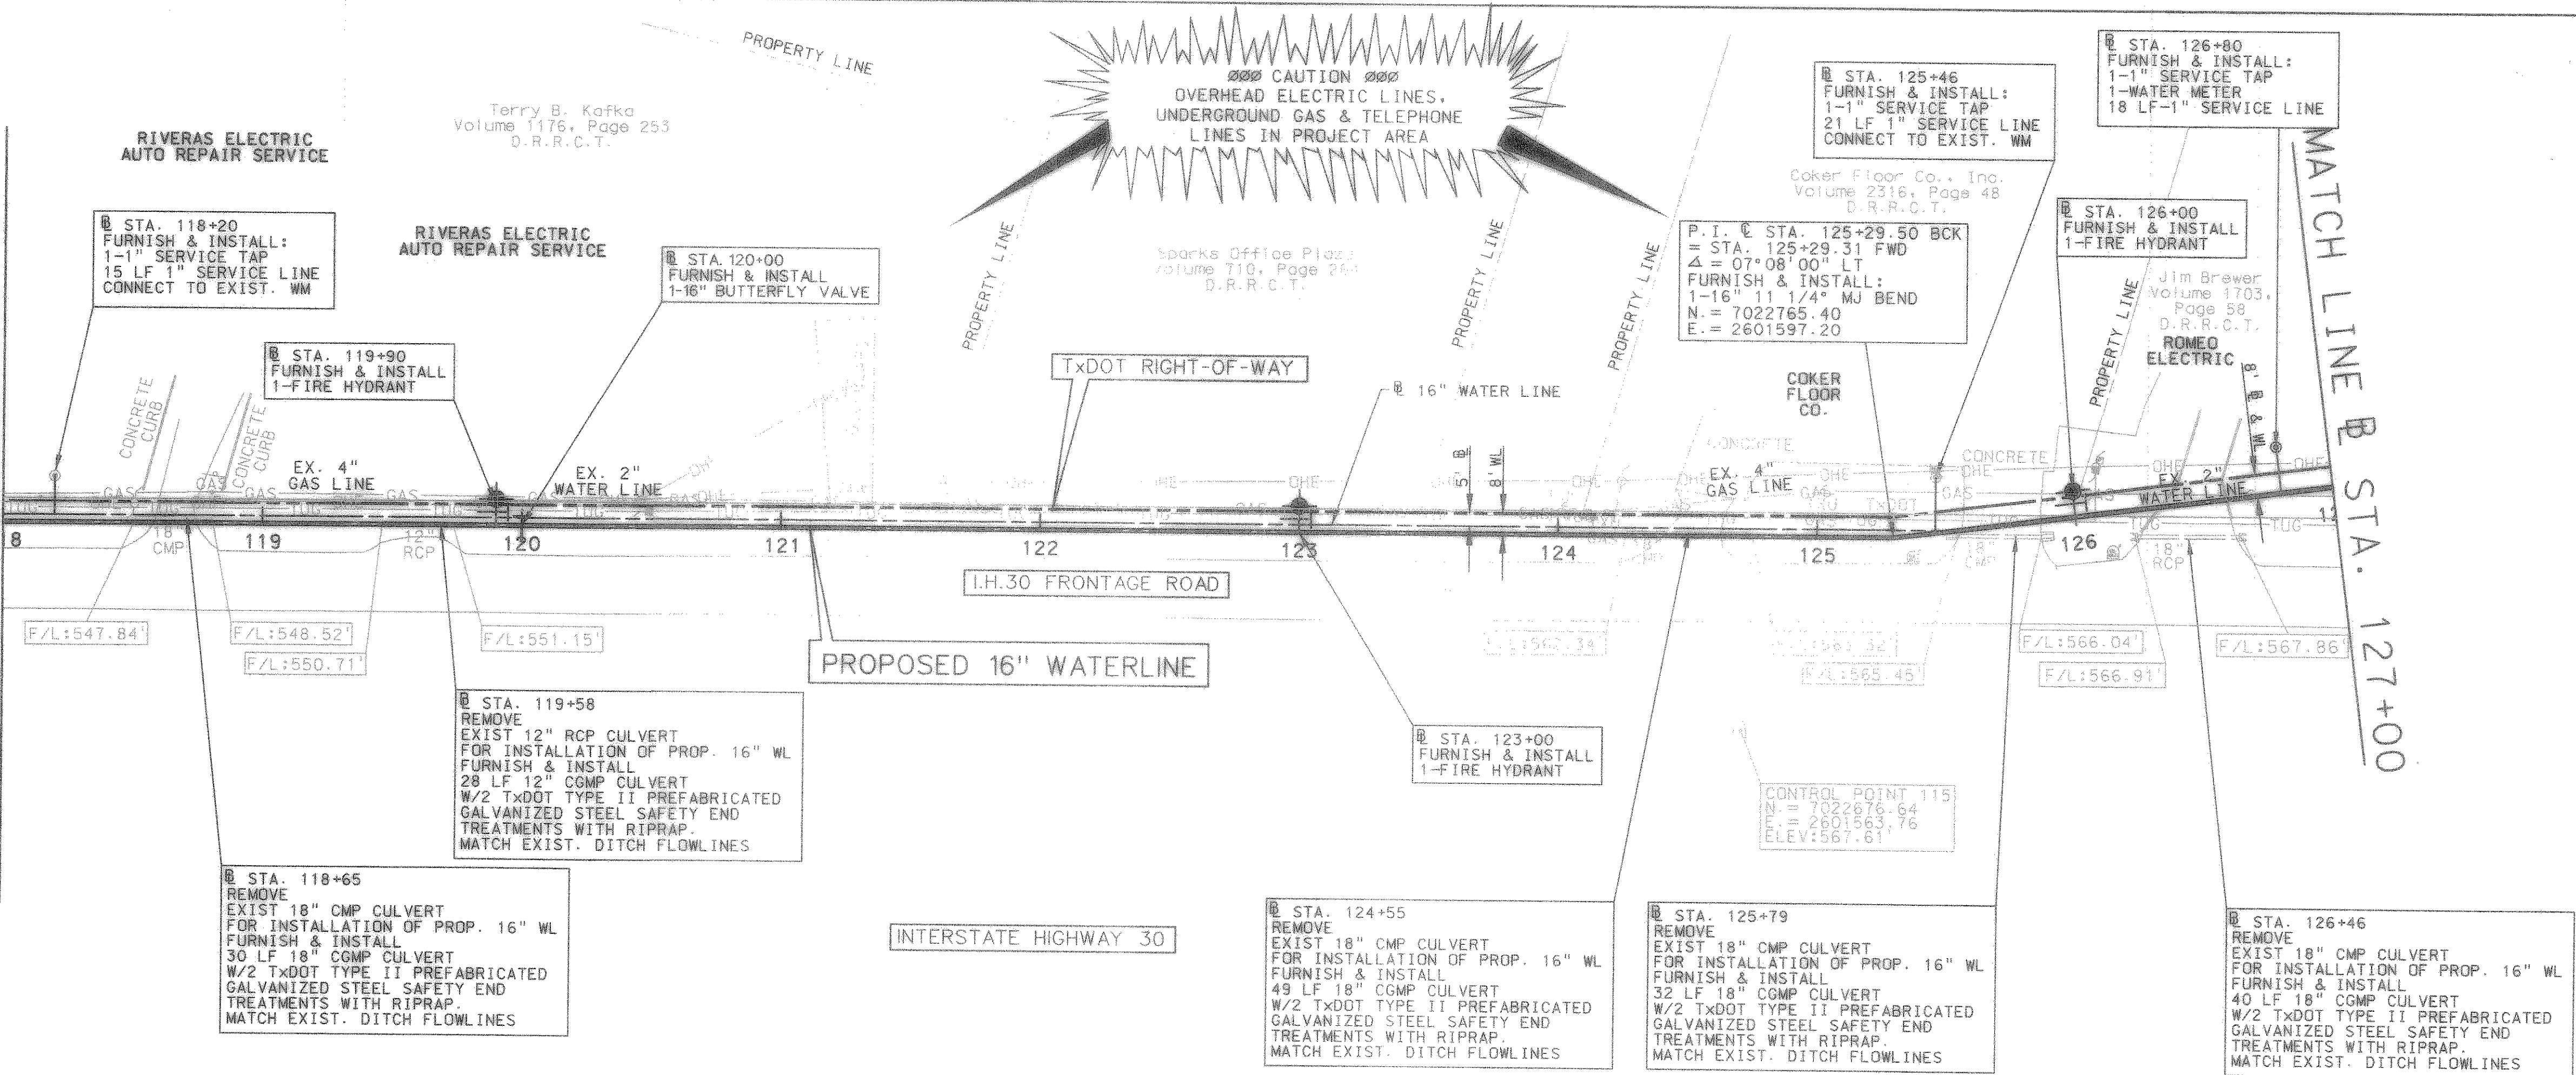

LEGEND	
	POWER POLE
	GUY WIRE
	TELEPHONE BOX
	POST
	SIGN
	IRON ROD
	FIRE HYDRANT
	WATER VALVE
	MAILBOX
	WATER METER
	IRRIGATION CONTROL VALVE
	GAS METER
	WASTE WATER MANHOLE
	CHAIN LINK FENCE
	WOOD FENCE
	IRON ROD FOUND
	MONUMENT
	ELECTRIC BOX
	BARBED WIRE FENCE
	TREE
	TELEPHONE UNDERGROUND
	APPROXIMATE GAS LINE
	APPROXIMATE WATER LINE
	OVERHEAD POWER LINE
	TELEPHONE MANHOLE
	TRAFFIC SIGNAL CONTROL BOX
	GAS VALVE

UNDERGROUND UTILITIES

THE LOCATION OF EXISTING UTILITIES SHOWN ON THESE PLANS ARE APPROXIMATE AND BASED ON DATA FURNISHED BY UTILITY COMPANIES. IT IS THE RESPONSIBILITY OF THE CONTRACTOR TO LOCATE AND VERIFY ON-SITE THE UTILITIES THAT MAY CONFLICT WITH THE CONSTRUCTION.

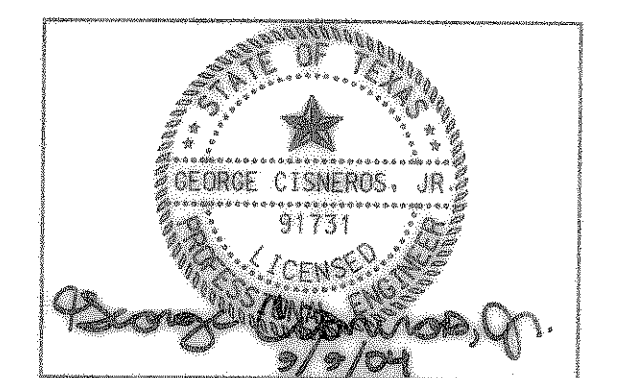

NO.	DATE	REVISION	APPROV.
4			
3			
2			
1			



CITY OF ROCKWALL
"THE NEW HORIZON"

IH-30 NORTH AND FM 549
WATER LINE - PHASE ONE


@ STA. 118+00 TO @ STA. 127+00

TCB TurnerCollieBraden Inc.
Engineers • Planners • Project Managers

Unit	A123	Scale	Horz. 1"=40'	Vert. 1"=5'	Date	SEPTEMBER 2004
Designed	GC	Checked	TBS	Job No.	052131875-0001	
Drawn	GBA	Approved	RCR	Sheet	8 of 25	

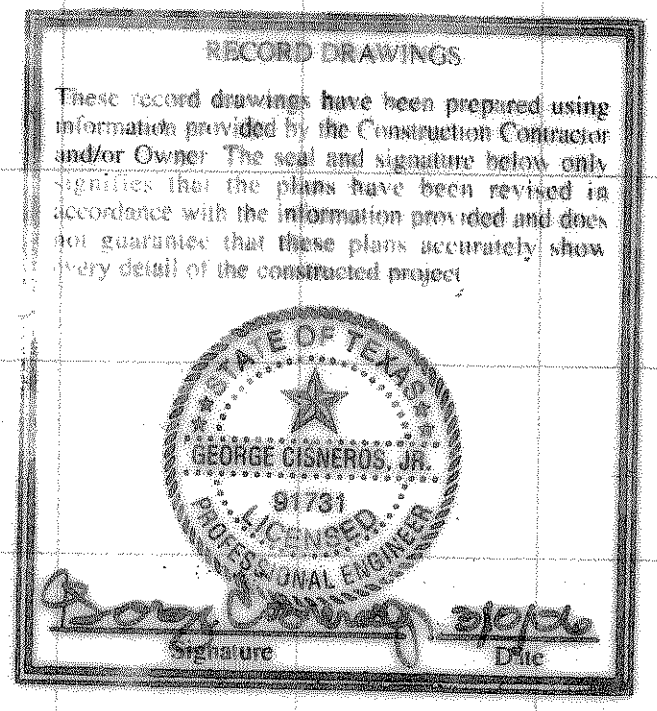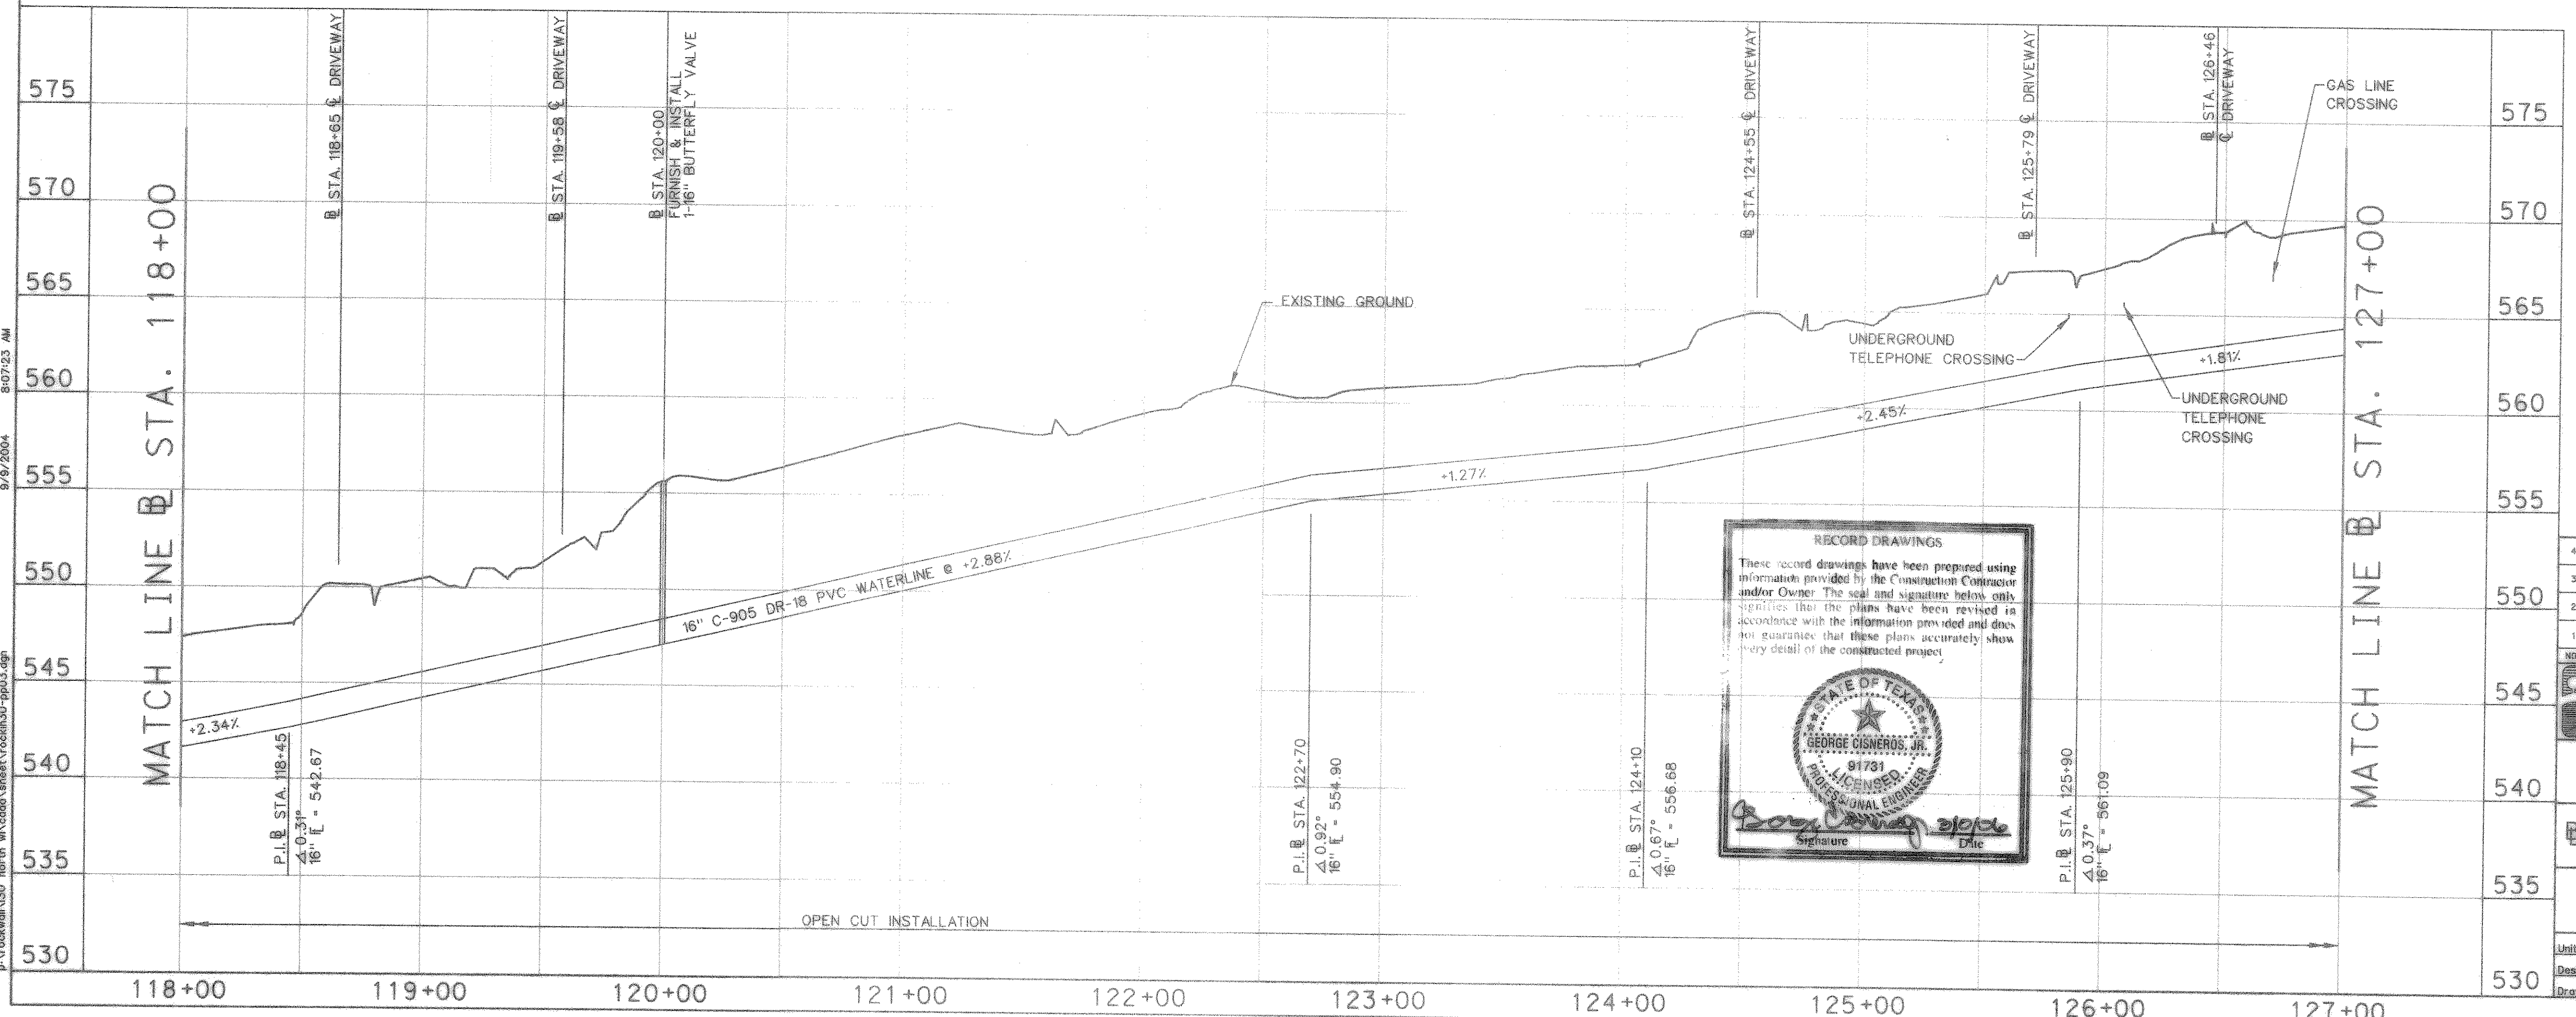




8/9/2004
 8:07:25 AM
 p:\rockwall\130 north\w\cond\sheet\rockwall-pp03.dgn

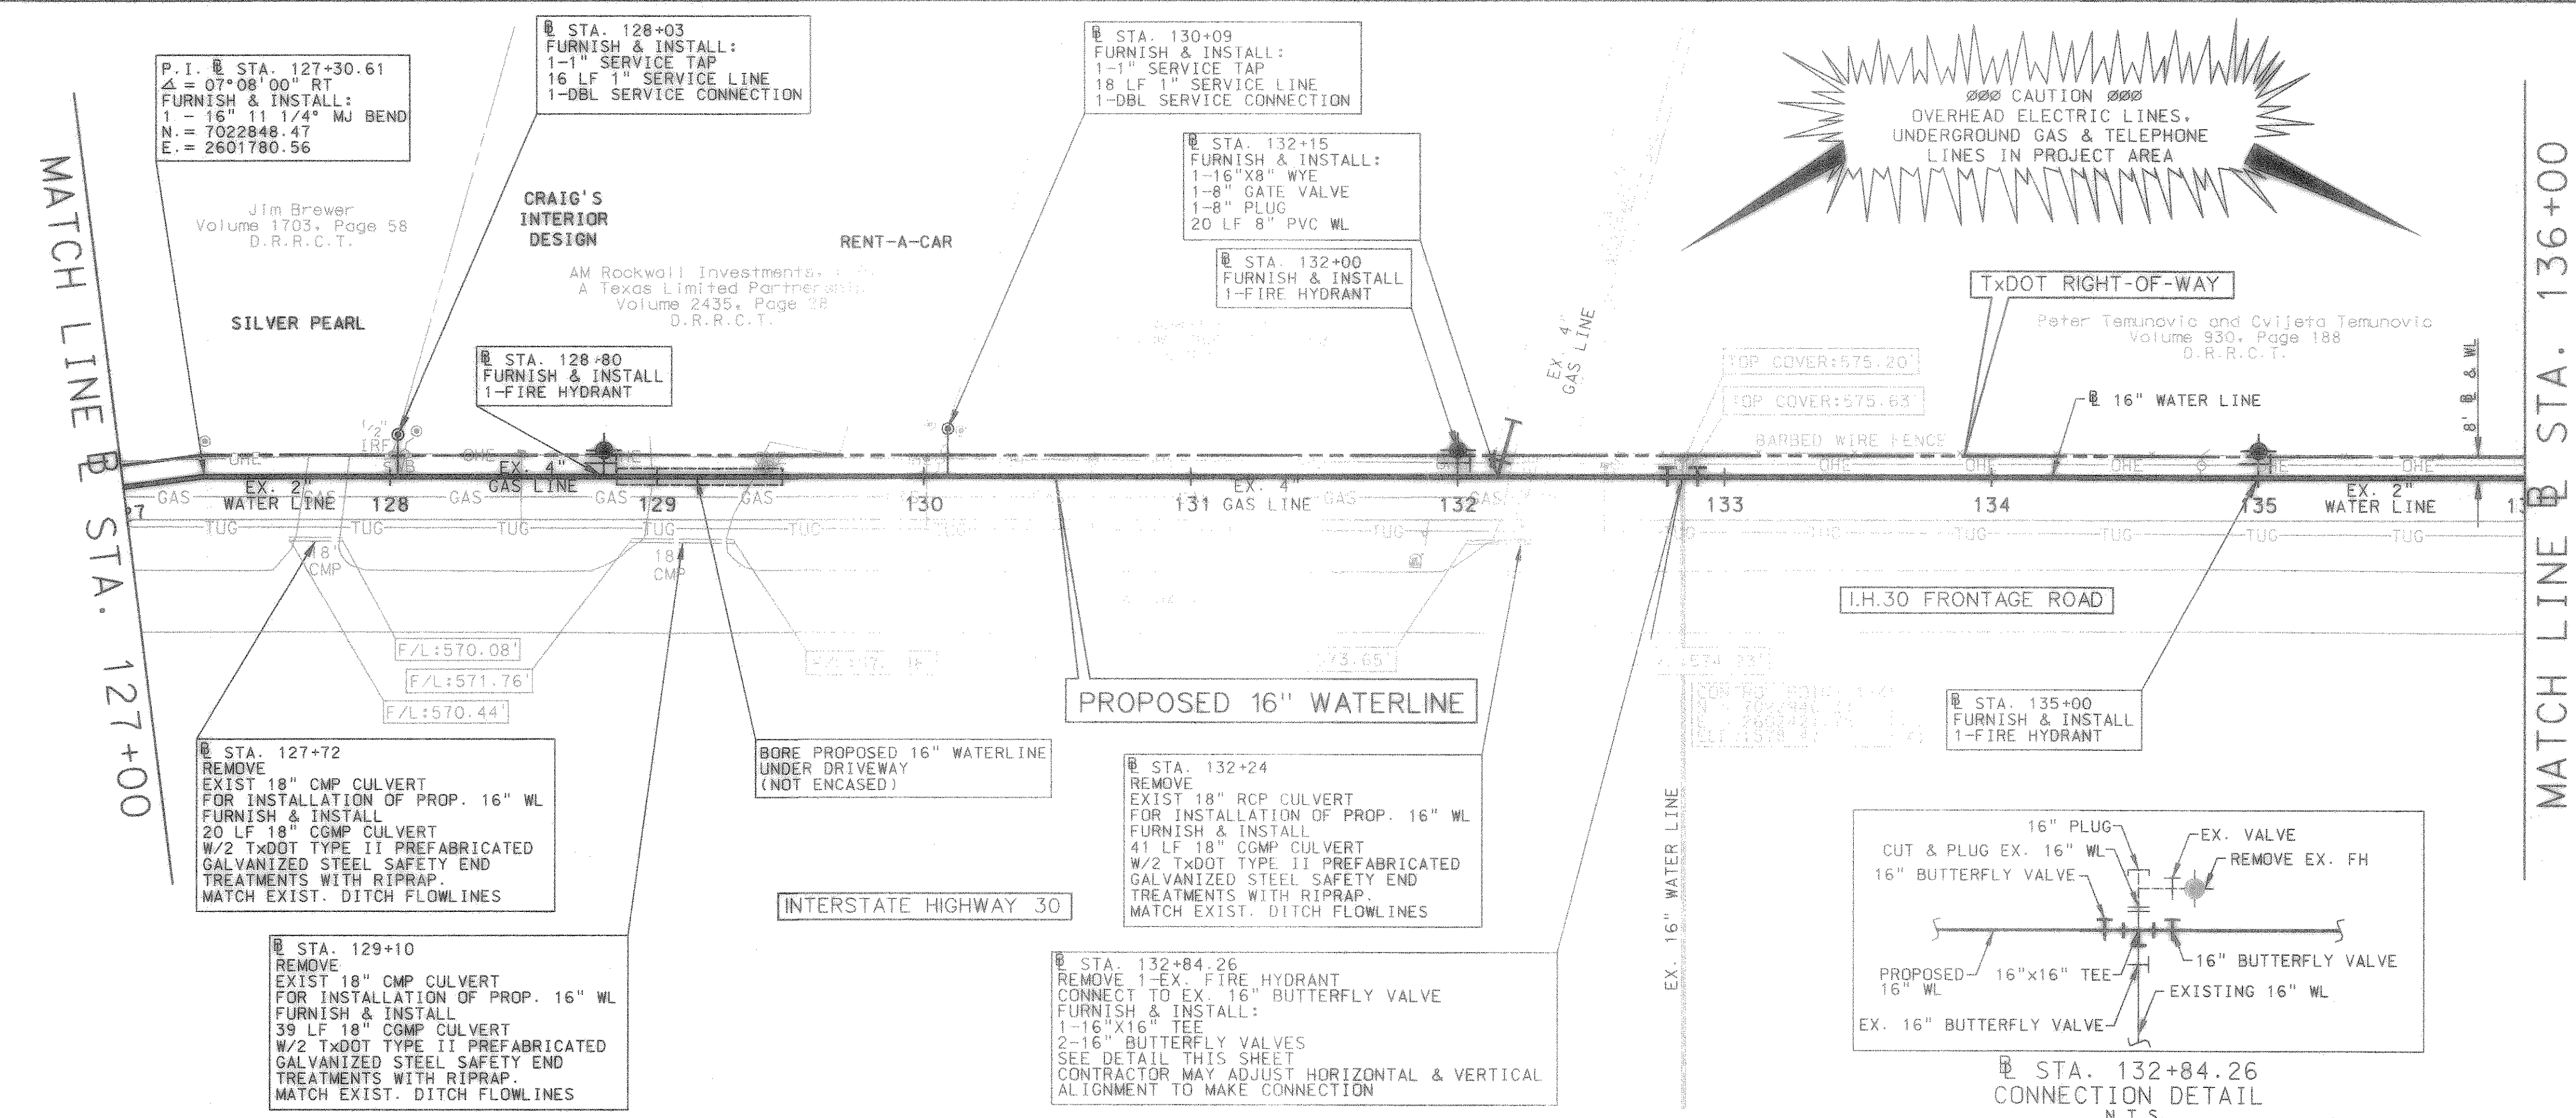

LEGEND	
	POWER POLE
	GUY WIRE
	TELEPHONE BOX
	POST
	SIGN
	IRON ROD
	FIRE HYDRANT
	WATER VALVE
	MAILBOX
	WATER METER
	IRRIGATION CONTROL VALVE
	GUARD RAIL
	GAS METER
	WASTE WATER MANHOLE
	CHAIN LINK FENCE
	WOOD FENCE
	IRON ROD FOUND
	MONUMENT
	ELECTRIC BOX
	BARBED WIRE FENCE
	TREE
	TELEPHONE UNDERGROUND
	APPROXIMATE GAS LINE
	APPROXIMATE WATER LINE
	OVERHEAD POWER LINE
	TELEPHONE MANHOLE
	TRAFFIC SIGNAL CONTROL BOX
	GAS VALVE


UNDERGROUND UTILITIES

THE LOCATION OF EXISTING UTILITIES SHOWN ON THESE PLANS ARE APPROXIMATE AND BASED ON DATA FURNISHED BY UTILITY COMPANIES. IT IS THE RESPONSIBILITY OF THE CONTRACTOR TO LOCATE AND VERIFY ON-SITE THE UTILITIES THAT MAY CONFLICT WITH THE CONSTRUCTION.

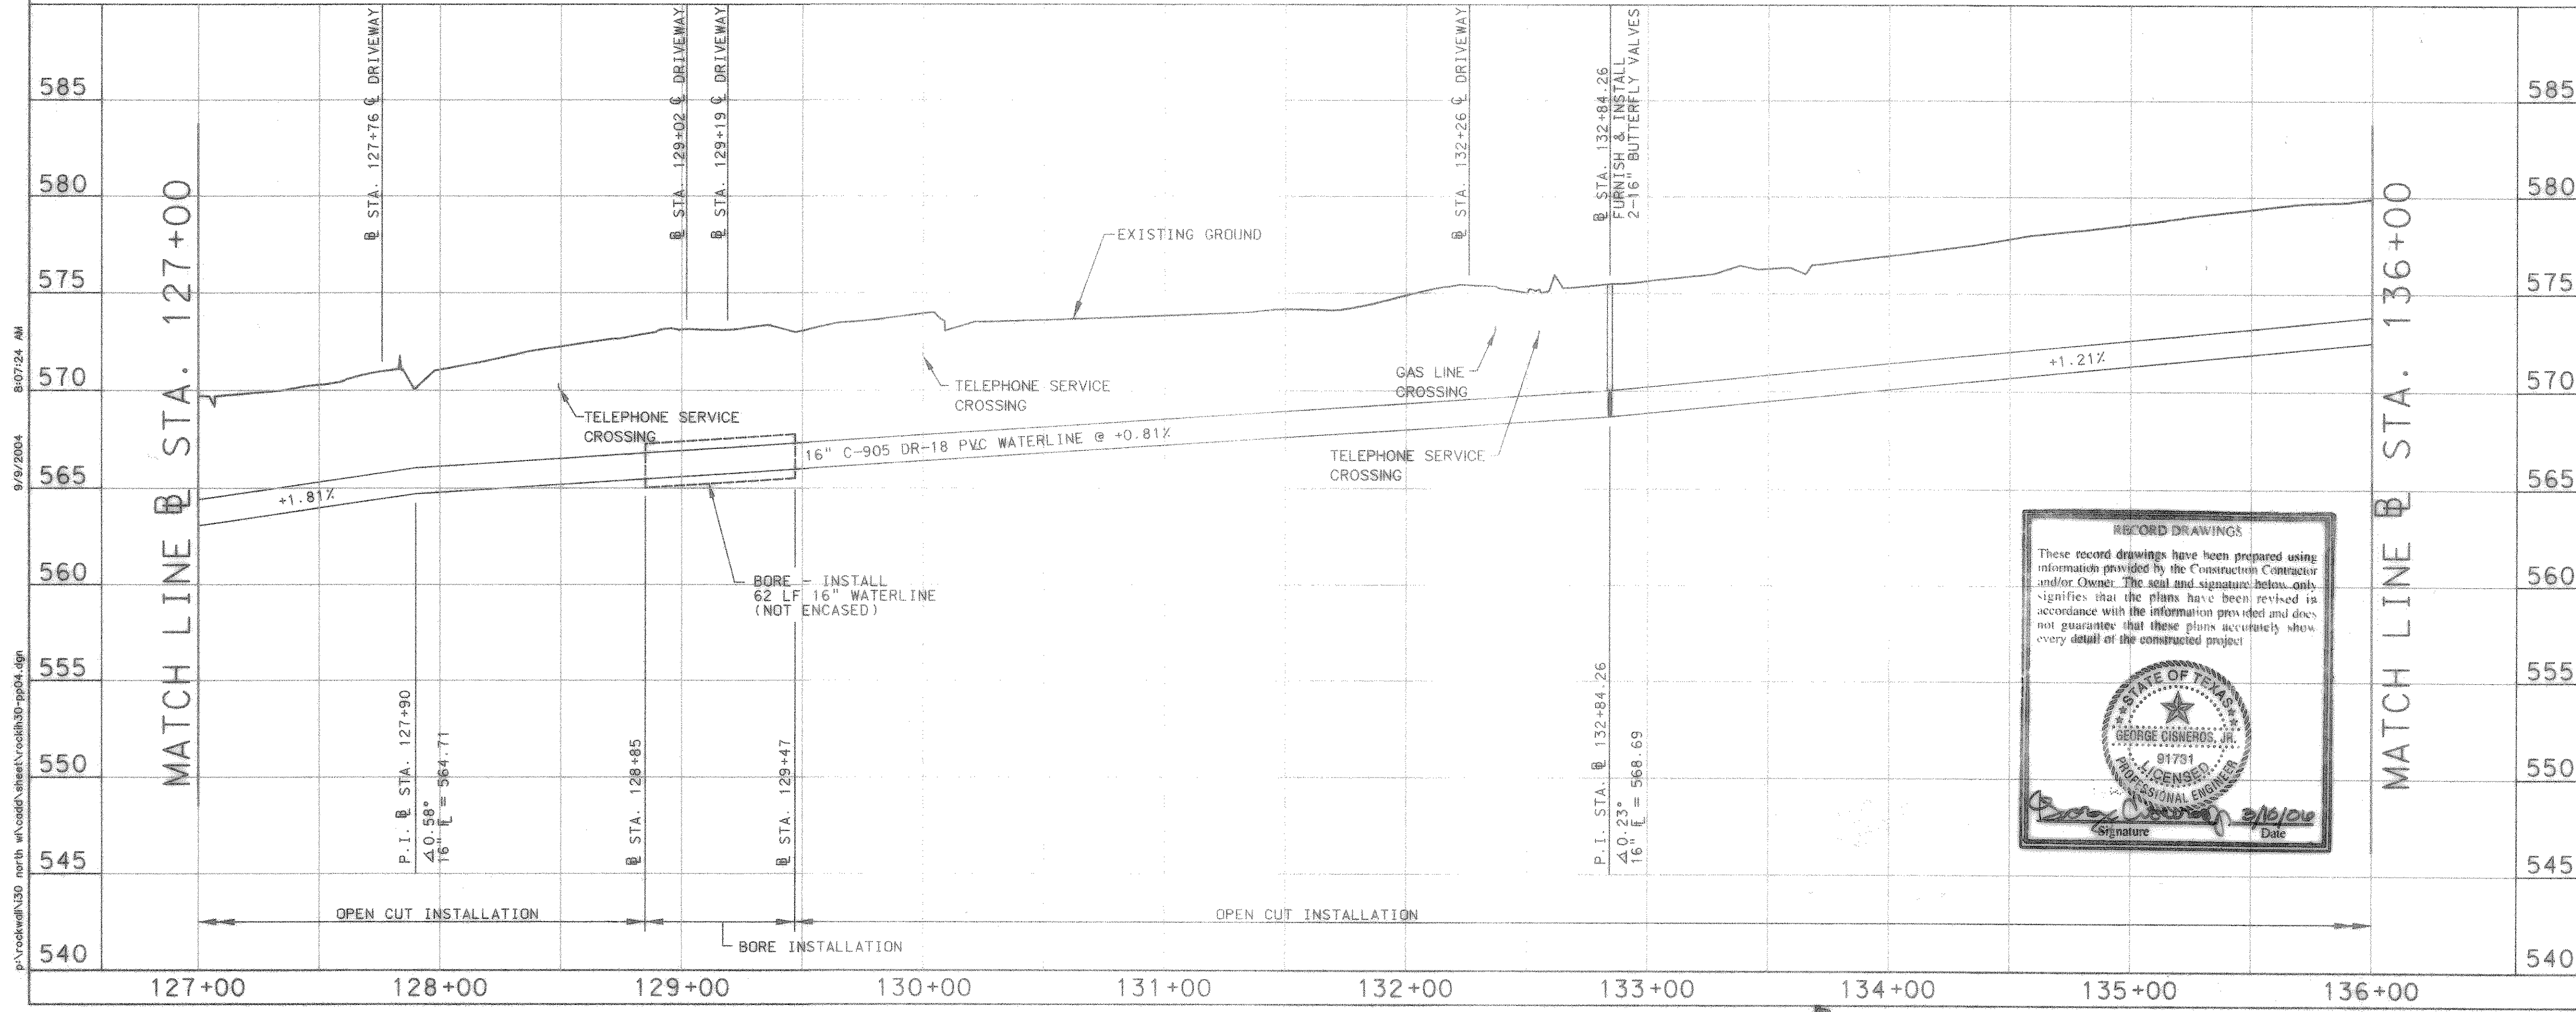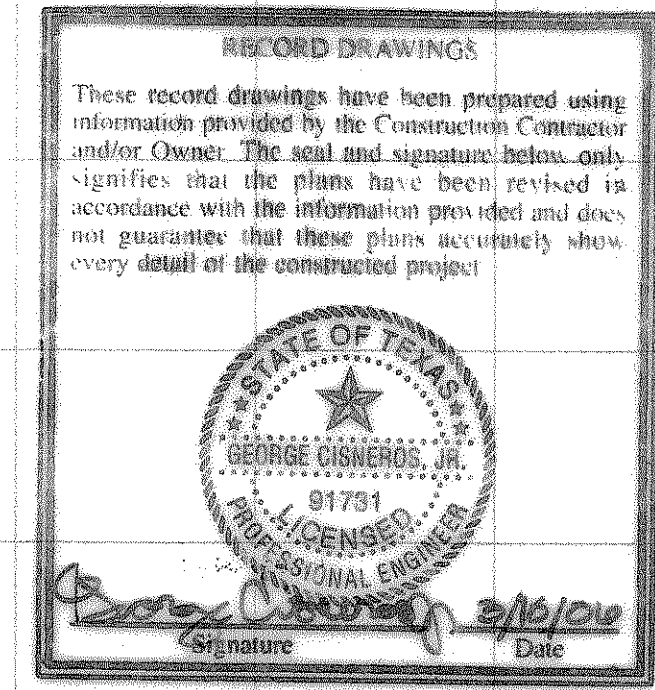
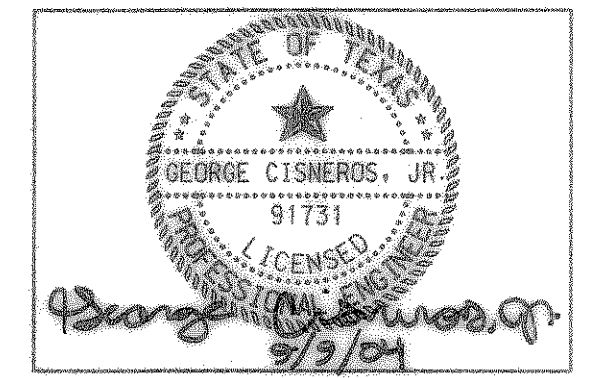


MATCH LINE @ STA. 136+00

MATCH LINE @ STA. 145+00

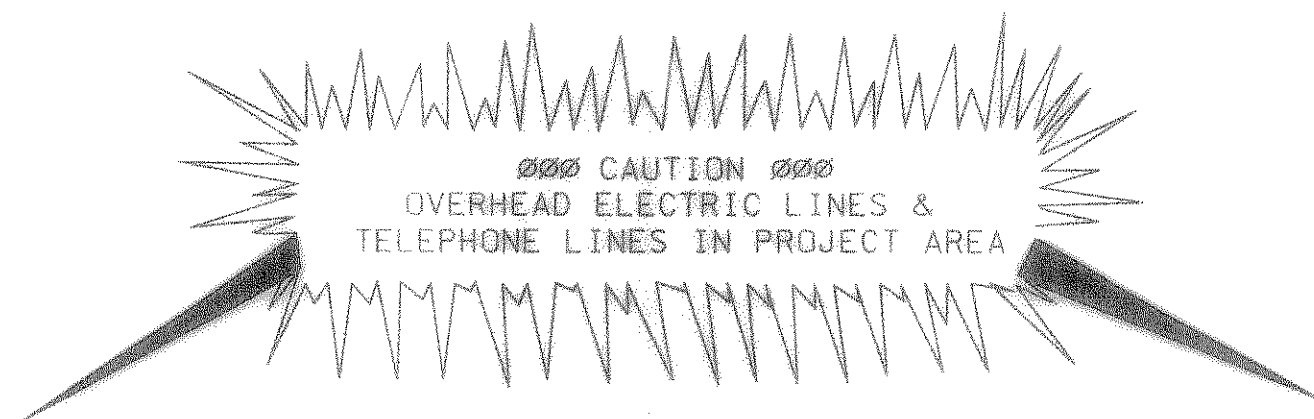

Rockwall Commercial Park Phase 2 Volume XXXX Page XX D.R.R.C.T.

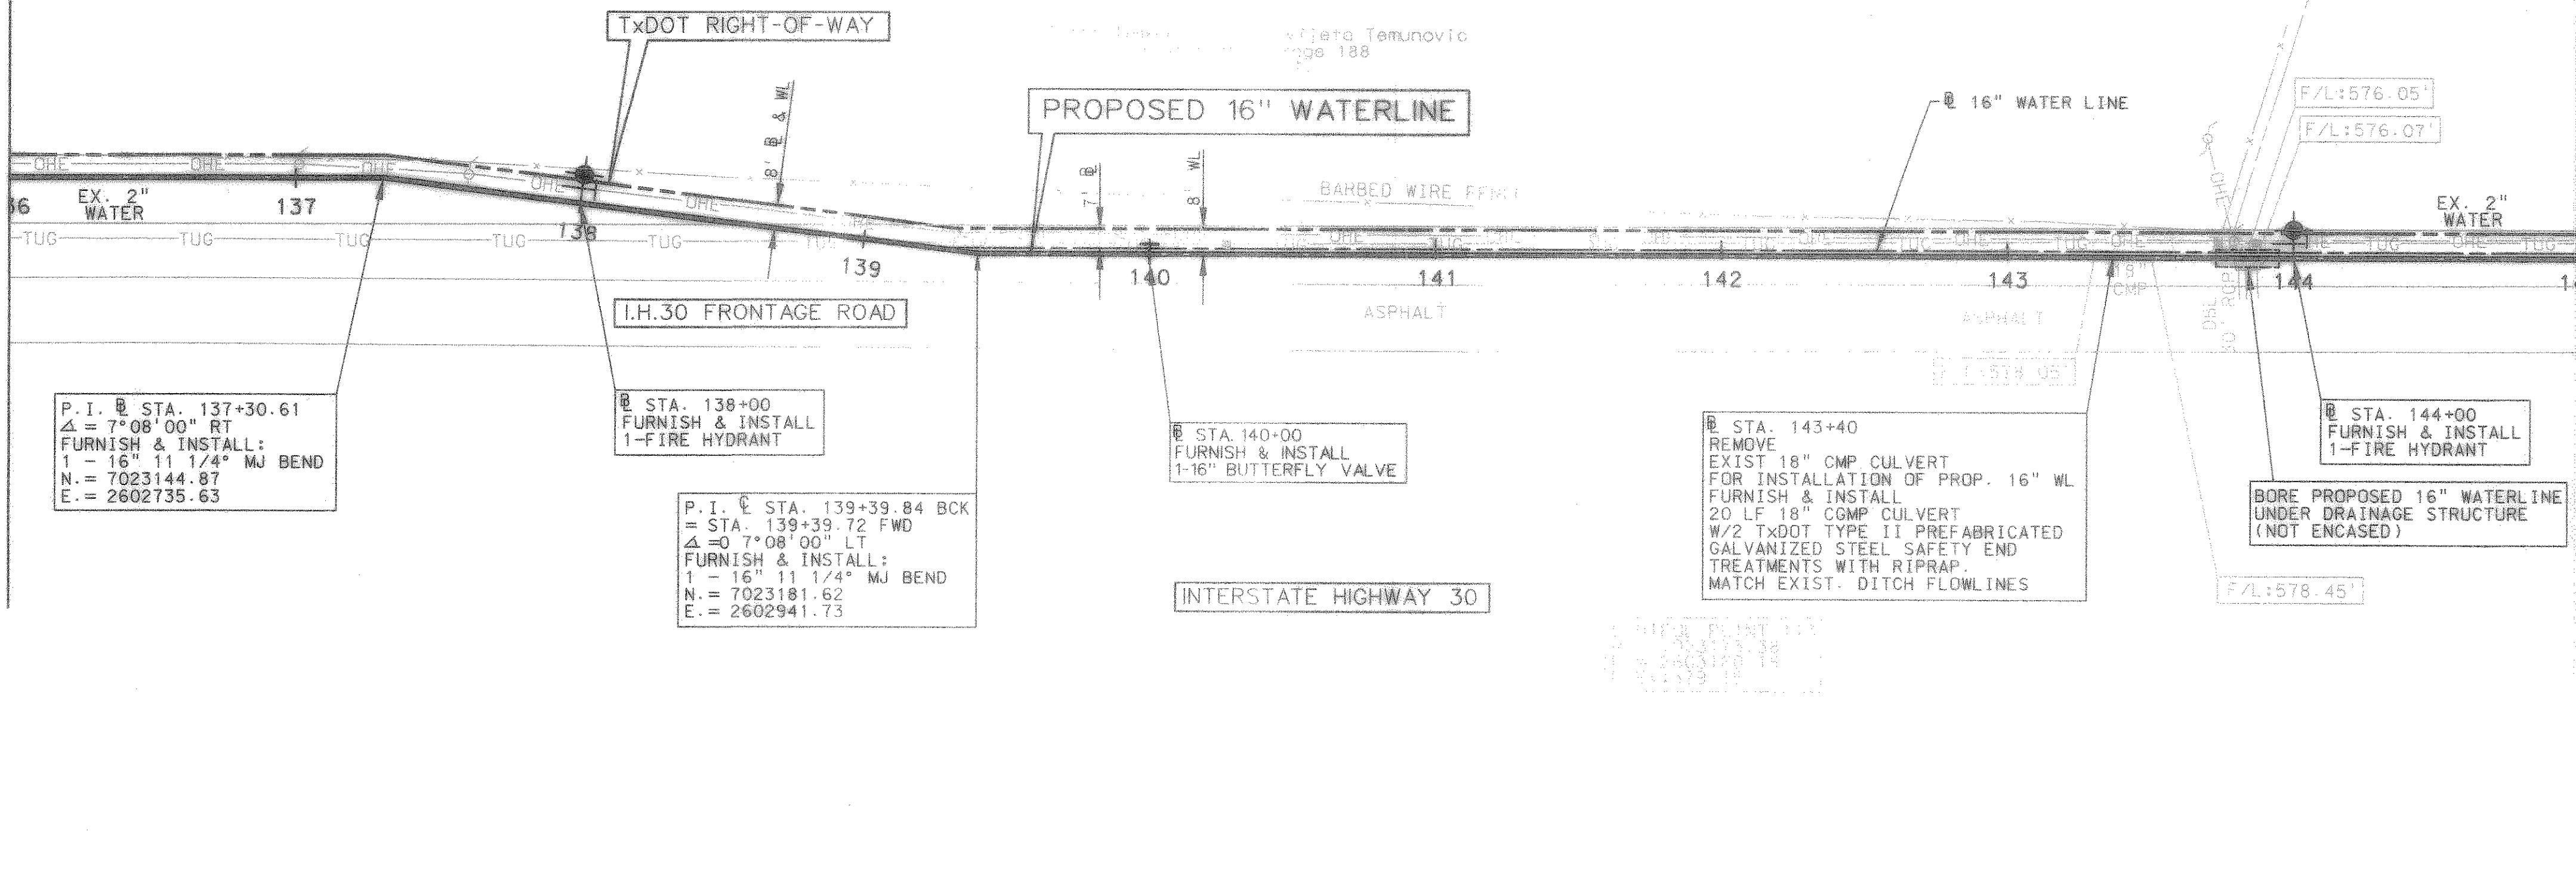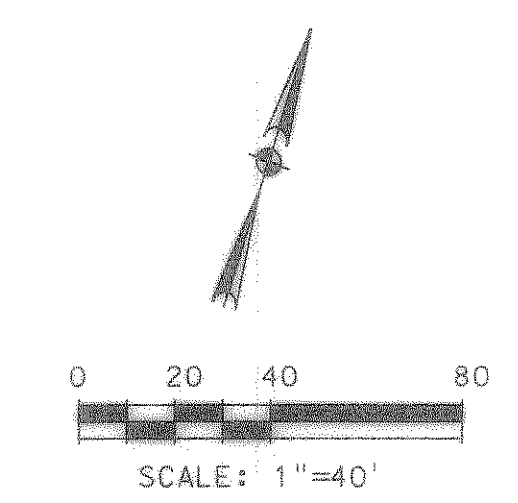

P.I. @ STA. 137+30.61
Δ = 7°08'00" RT
FURNISH & INSTALL:
1 - 16" 11 1/4" MJ BEND
N = 7023144.87
E = 2602735.63

@ STA. 138+00
FURNISH & INSTALL
1-FIRE HYDRANT

P.I. @ STA. 139+39.84 BCK
= STA. 139+39.72 FWD
Δ = 0°7'08" LT
FURNISH & INSTALL:
1 - 16" 11 1/4" MJ BEND
N = 7023181.62
E = 2602941.73


INTERSTATE HIGHWAY 30

@ STA. 140+00
FURNISH & INSTALL
1-16" BUTTERFLY VALVE

@ STA. 143+40
REMOVE
EXIST 18" CMP CULVERT
FOR INSTALLATION OF PROP. 16" WL
FURNISH & INSTALL
20 LF 18" CMP CULVERT
W/2 TXDOT TYPE II PREFABRICATED
GALVANIZED STEEL SAFETY END
TREATMENTS WITH RIPRAP.
MATCH EXIST. DITCH FLOWLINES

@ STA. 144+00
FURNISH & INSTALL
1-FIRE HYDRANT

BORE PROPOSED 16" WATERLINE
UNDER DRAINAGE STRUCTURE
(NOT ENCASED)

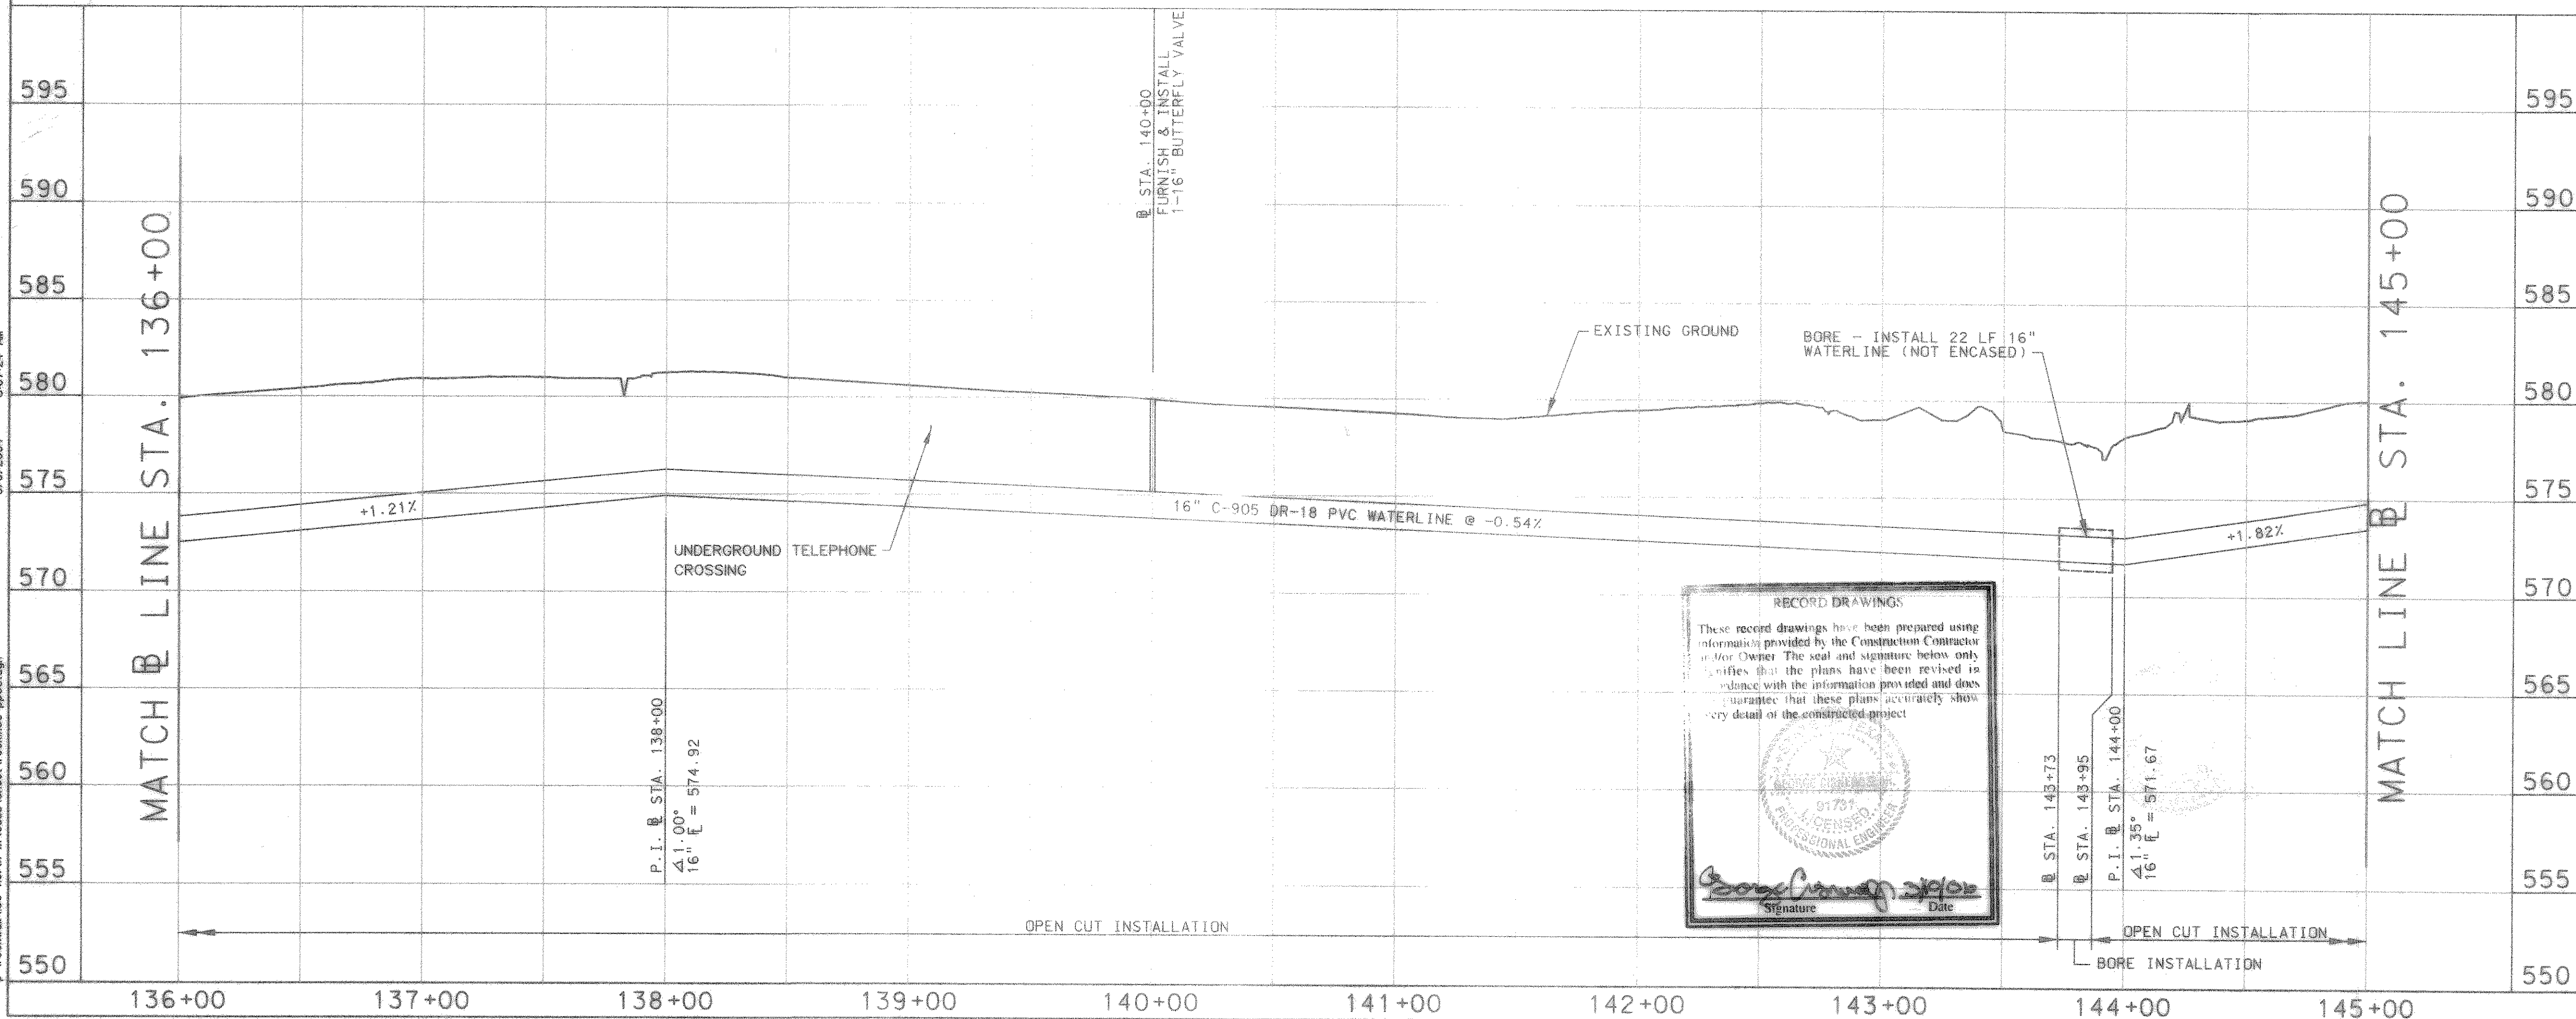


RECORD DRAWINGS
These record drawings have been prepared using information provided by the Construction Contractor and/or Owner. The seal and signature below only certifies that the plans have been revised in accordance with the information provided and does not guarantee that these plans accurately show every detail of the constructed project.

Signature: *George Cisneros, Jr.* Date: *9/9/04*

LEGEND	
	POWER POLE
	GUY WIRE
	TELEPHONE BOX
	POST
	SIGN
	IRON ROD
	FIRE HYDRANT
	WATER VALVE
	MAILBOX
	WATER METER
	IRRIGATION CONTROL VALVE
	GUARD RAIL
	GAS METER
	WASTE WATER MANHOLE
	CHAIN LINK FENCE
	WOOD FENCE
	IRON ROD FOUND
	MONUMENT
	ELECTRIC BOX
	BARBED WIRE FENCE
	TREE
	TELEPHONE UNDERGROUND
	APPROXIMATE GAS LINE
	APPROXIMATE WATER LINE
	OVERHEAD POWER LINE
	TELEPHONE MANHOLE
	TRAFFIC SIGNAL CONTROL BOX
	GAS VALVE

UNDERGROUND UTILITIES
THE LOCATION OF EXISTING UTILITIES SHOWN ON THESE PLANS ARE APPROXIMATE AND BASED ON DATA FURNISHED BY UTILITY COMPANIES. IT IS THE RESPONSIBILITY OF THE CONTRACTOR TO LOCATE AND VERIFY ON-SITE THE UTILITIES THAT MAY CONFLICT WITH THE CONSTRUCTION.

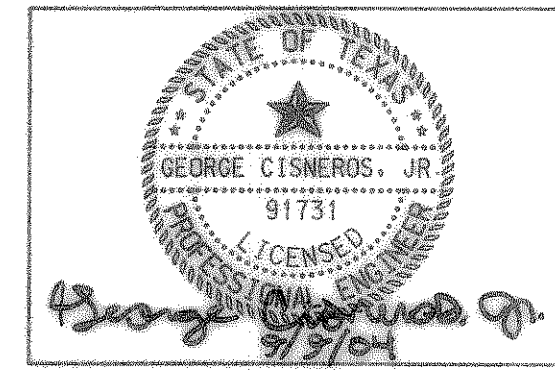

NO.	DATE	REVISION	APPROV.
4			
3			
2			
1			

CITY OF ROCKWALL
"THE NEW HORIZON"
IH-30 NORTH AND FM 549
WATER LINE - PHASE ONE
@ STA. 136+00 TO @ STA. 145+00



TCB TurnerCollie & Braden Inc.
Engineers • Planners • Project Managers

Unit	A123	Scale	Horizontal: 1"=40'	Date	SEPTEMBER 2004
Designed	GC	Checked	TBS	Job No.	052131875-0001
Drawn	GBA	Approved	RCR	Sheet	10 of 25

9/9/2004 8:07:24 AM
p:\rockwall\30_north\rockwall\30\136-145\136-145.dwg

MATCH LINE @ STA. 145+00



MATCH LINE @ STA. 154+00

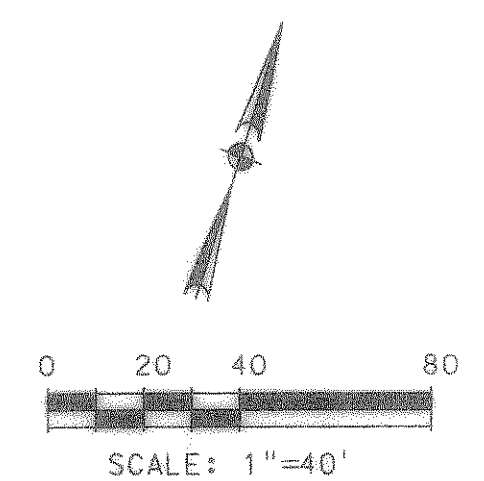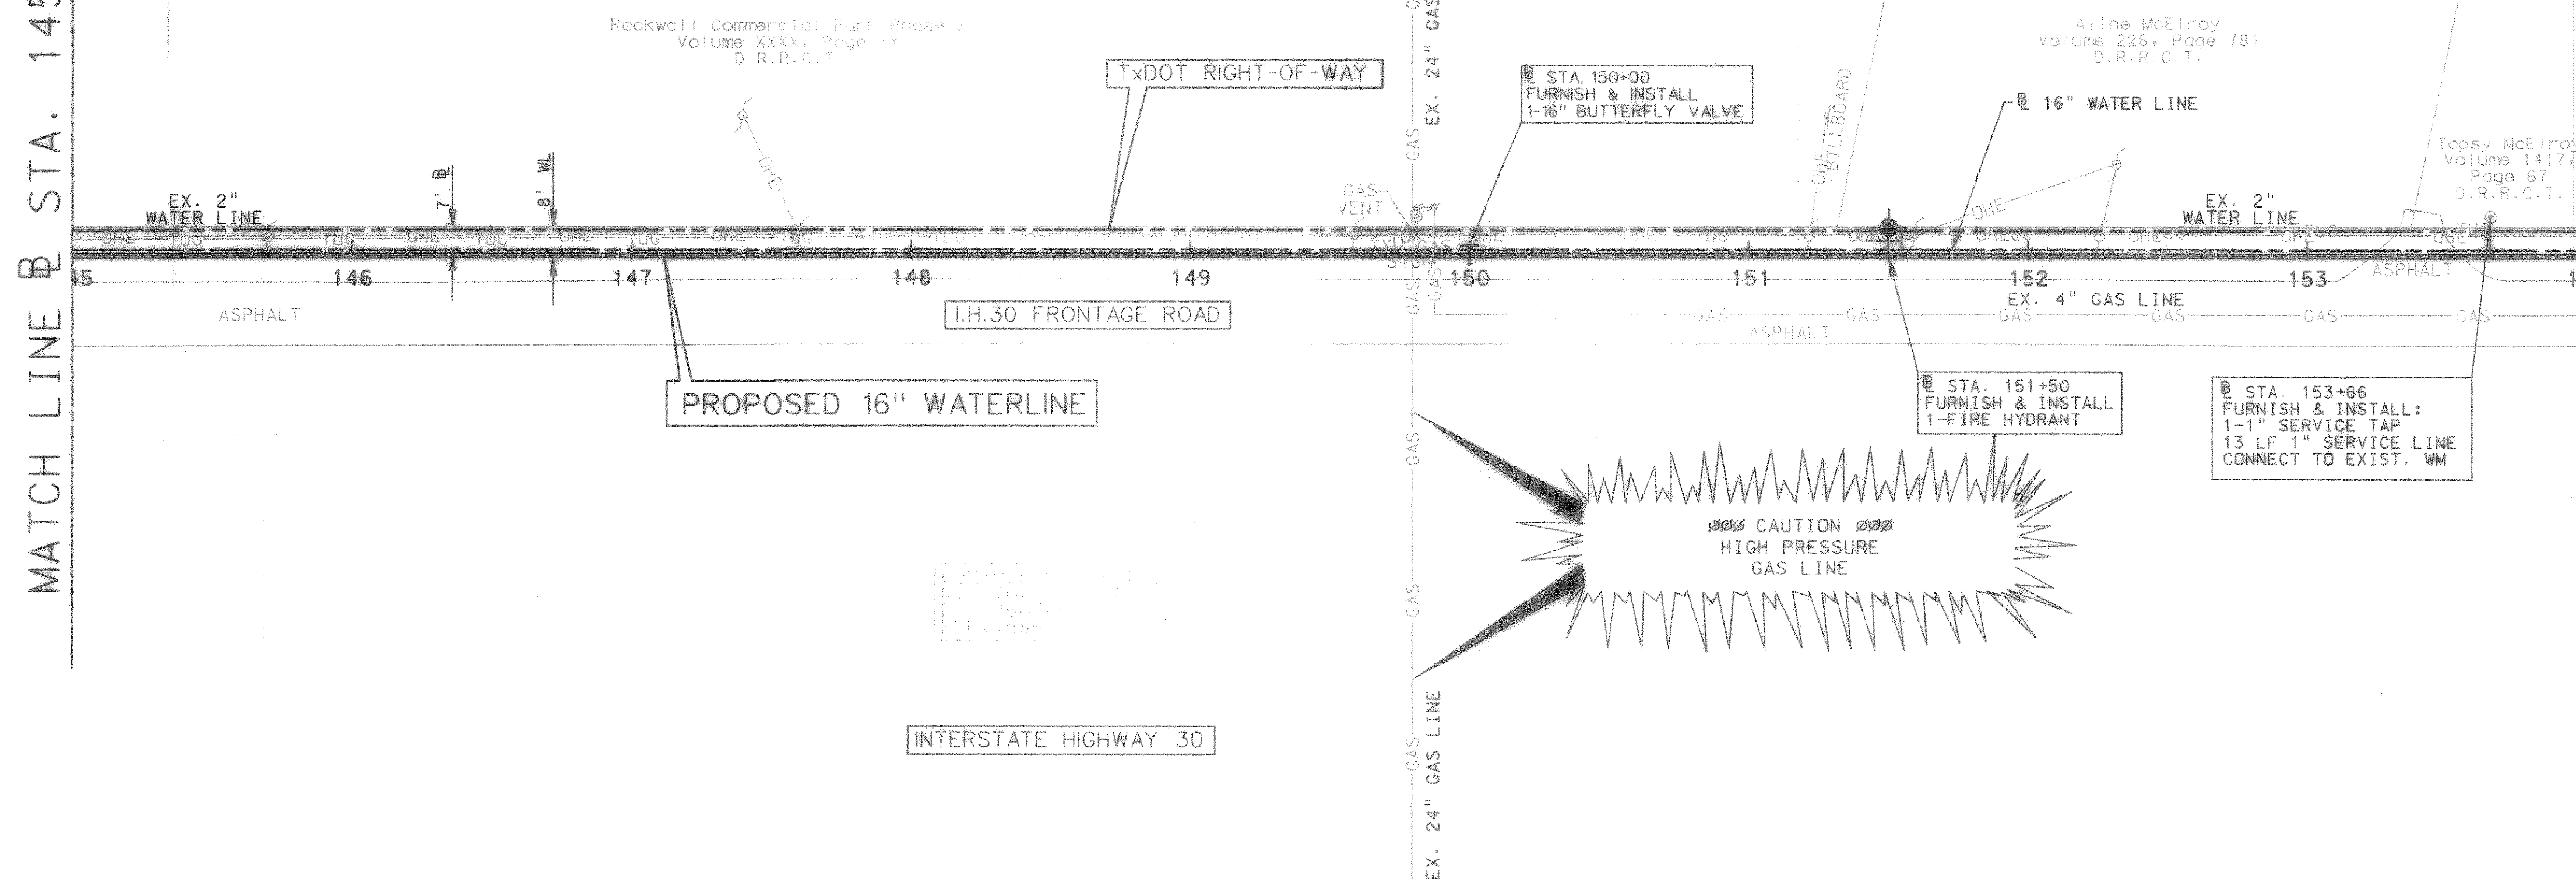

LEGEND	
	POWER POLE
	GUY WIRE
	TELEPHONE BOX
	POST
	SIGN
	IRON ROD
	FIRE HYDRANT
	WATER VALVE
	MAILBOX
	WATER METER
	IRRIGATION CONTROL VALVE
	GUARD RAIL
	GAS METER
	WASTE WATER MANHOLE
	CHAIN LINK FENCE
	WOOD FENCE
	IRON ROD FOUND
	MONUMENT
	ELECTRIC BOX
	BARBED WIRE FENCE
	TREE
	TELEPHONE UNDERGROUND
	APPROXIMATE GAS LINE
	APPROXIMATE WATER LINE
	OVERHEAD POWER LINE
	TELEPHONE MANHOLE
	TRAFFIC SIGNAL CONTROL BOX
	GAS VALVE

UNDERGROUND UTILITIES

THE LOCATION OF EXISTING UTILITIES SHOWN ON THESE PLANS ARE APPROXIMATE AND BASED ON DATA FURNISHED BY UTILITY COMPANIES. IT IS THE RESPONSIBILITY OF THE CONTRACTOR TO LOCATE AND VERIFY ON-SITE THE UTILITIES THAT MAY CONFLICT WITH THE CONSTRUCTION.

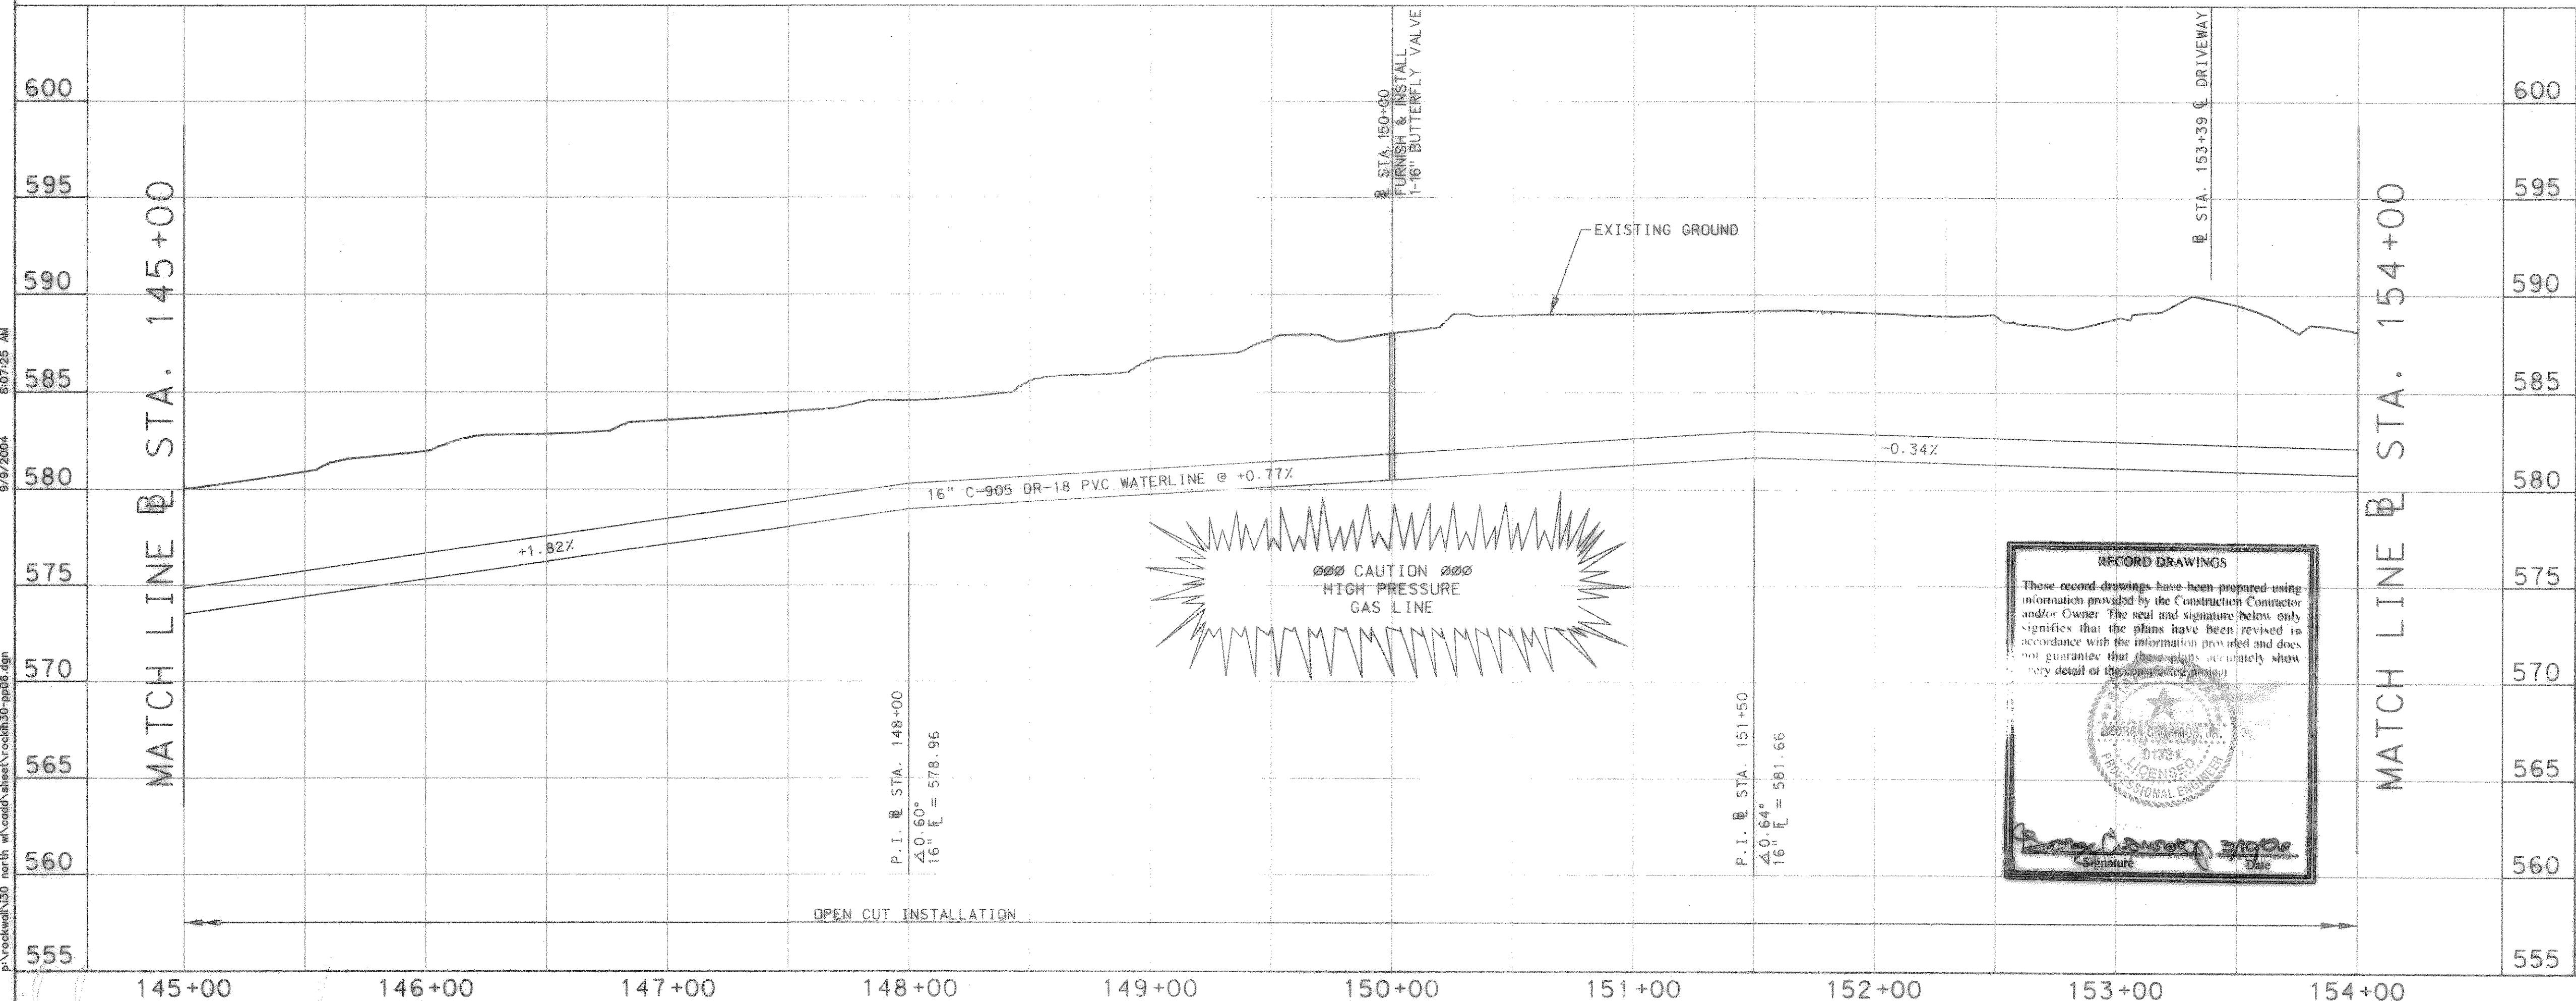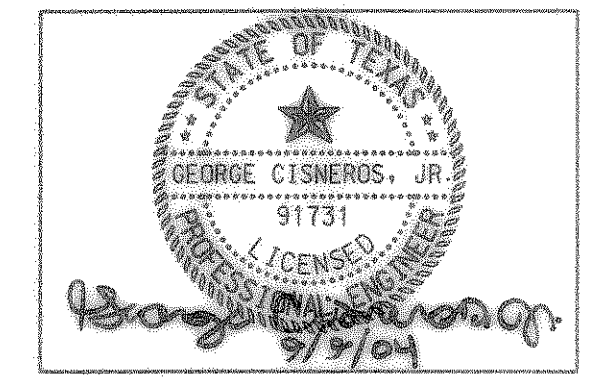

RECORD DRAWINGS

These record drawings have been prepared using information provided by the Construction Contractor and/or Owner. The seal and signature below only signifies that the plans have been revised in accordance with the information provided and does not guarantee that these plans accurately show every detail of the construction project.

Signature: _____ Date: _____

NO.	DATE	REVISION	APPROV.
4			
3			
2			
1			

CITY OF ROCKWALL
"THE NEW HORIZON"

IH-30 NORTH AND FM 549
WATER LINE - PHASE ONE

@ STA. 145+00 TO @ STA. 154+00




TCB TurnerCollie & Braden Inc.
Engineers • Planners • Project Managers

Unit: A123 Scale: Horiz. 1"=40' Vert. 1"=5' Date: SEPTEMBER 2004
Designed: GC Checked: TBS Job No.: 052131875-0001
Drawn: GBA Approved: RCR Sheet: 11 of 25

9/9/2004 8:07:25 AM P:\rockwall\30 north\rockwall\sheet\rockwall30-pl08.dgn

MATCH LINE @ STA. 154+00

MATCH LINE @ STA. 163+00

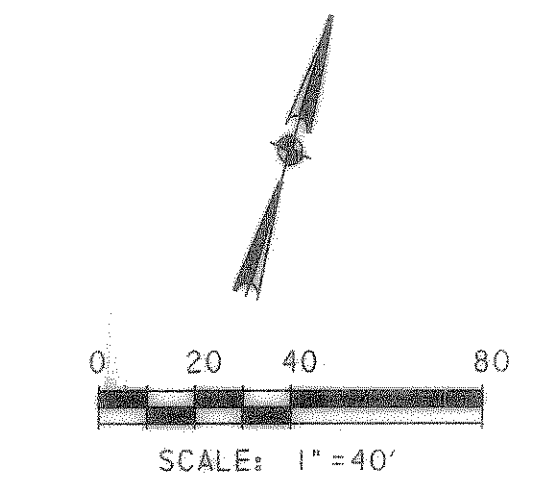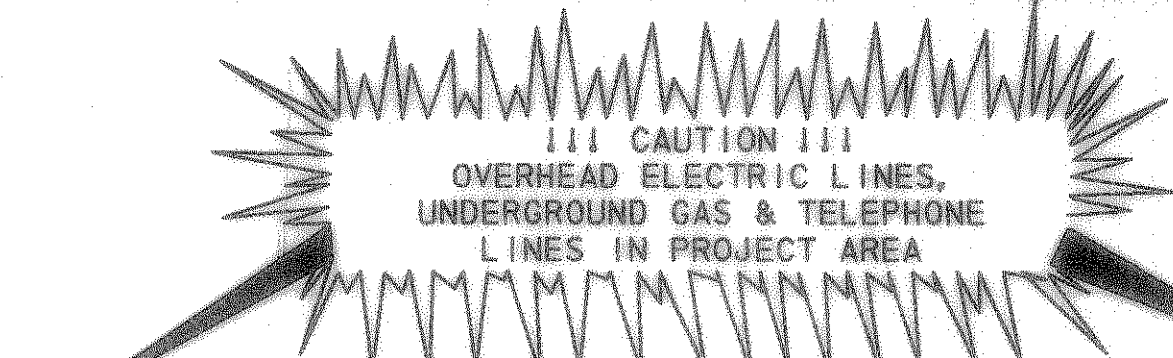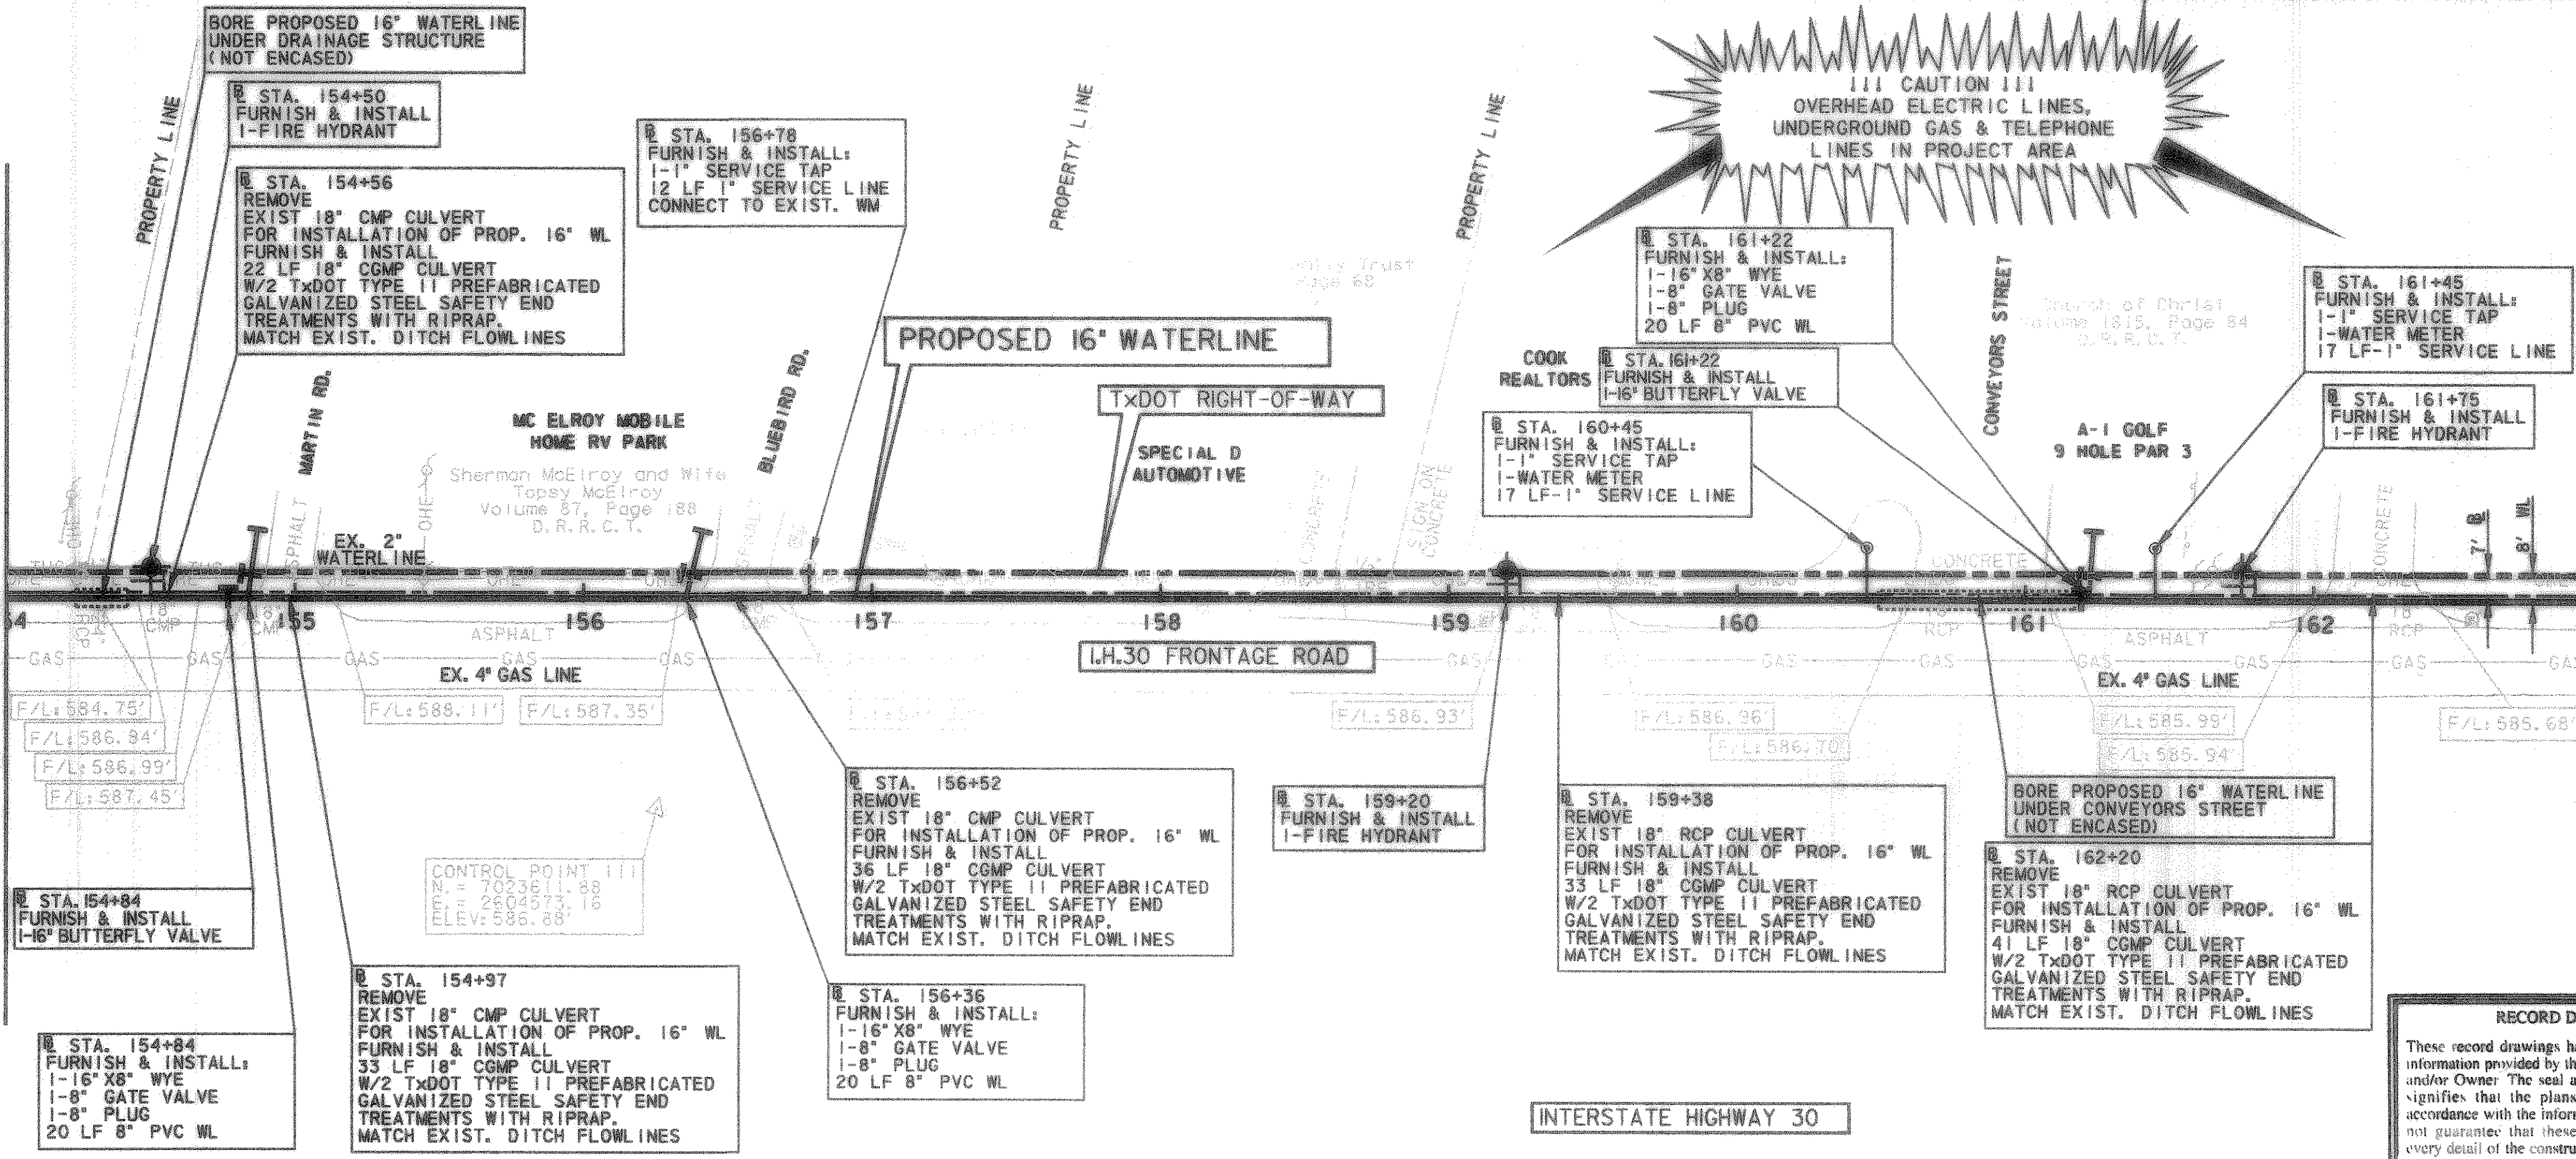

LEGEND	
	POWER POLE
	GUY WIRE
	TELEPHONE BOX
	POST
	SIGN
	IRON ROD
	FIRE HYDRANT
	WATER VALVE
	MAIL BOX
	WATER METER
	IRRIGATION CONTROL VALVE
	GUARD RAIL
	GAS METER
	WASTE WATER MANHOLE
	CHAIN LINK FENCE
	WOOD FENCE
	IRON ROD FOUND
	MONUMENT
	ELECTRIC BOX
	BARBED WIRE FENCE
	TREE
	TELEPHONE UNDERGROUND
	APPROXIMATE GAS LINE
	APPROXIMATE WATER LINE
	OVERHEAD POWER LINE
	TELEPHONE MANHOLE
	TRAFFIC SIGNAL CONTROL BOX
	GAS VALVE



RECORD DRAWINGS

These record drawings have been prepared using information provided by the Construction Contractor and/or Owner. The seal and signature below only signifies that the plans have been revised in accordance with the information provided and does not guarantee that these plans accurately show every detail of the constructed project.

Signature: _____ Date: _____


UNDERGROUND UTILITIES

THE LOCATION OF EXISTING UTILITIES SHOWN ON THESE PLANS ARE APPROXIMATE AND BASED ON DATA FURNISHED BY UTILITY COMPANIES. IT IS THE RESPONSIBILITY OF THE CONTRACTOR TO LOCATE AND VERIFY ON-SITE THE UTILITIES THAT MAY CONFLICT WITH THE CONSTRUCTION.

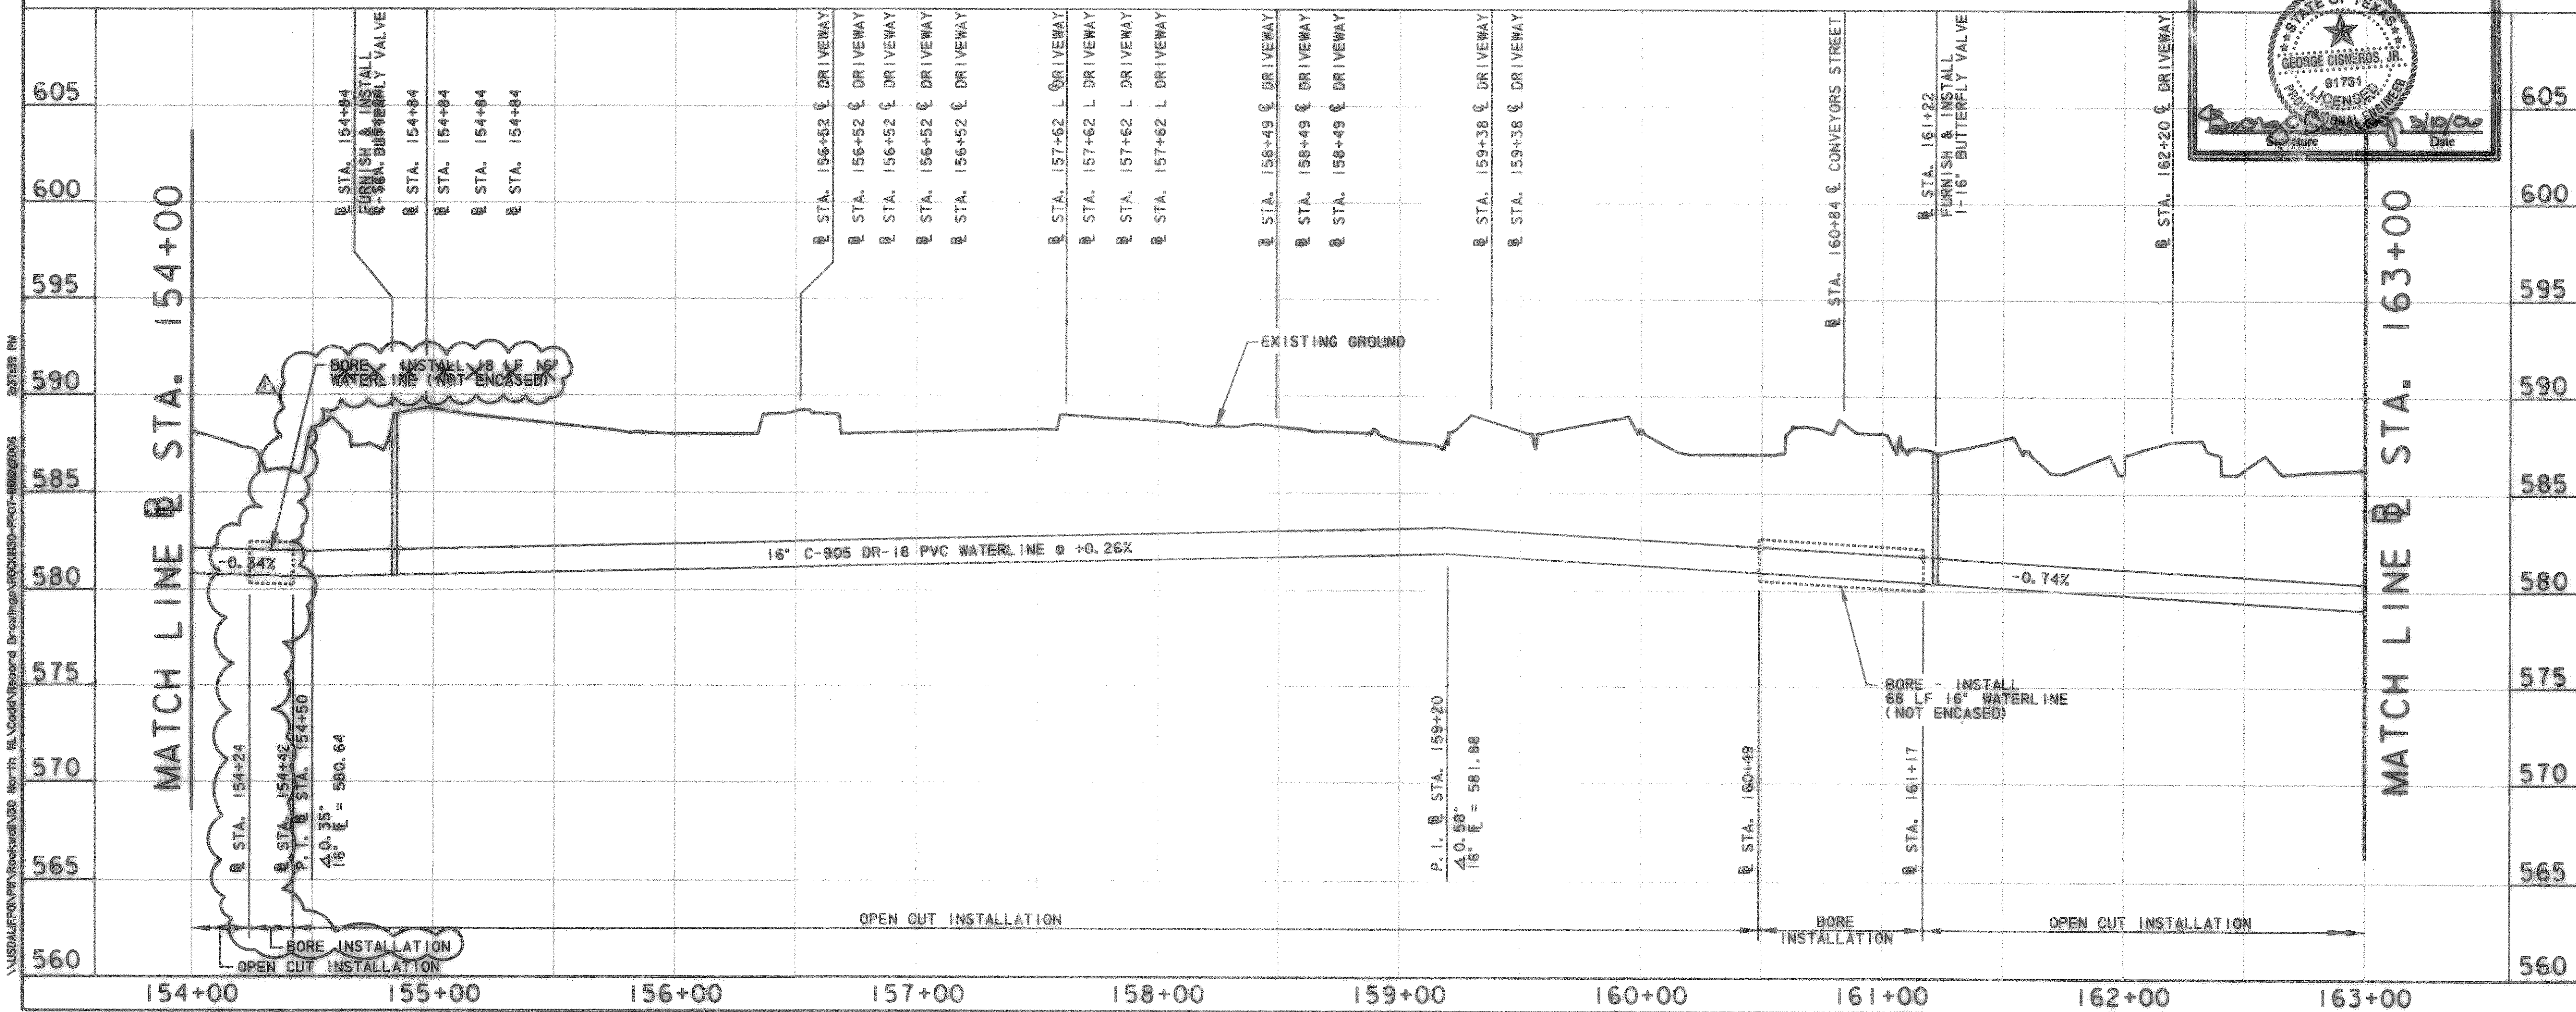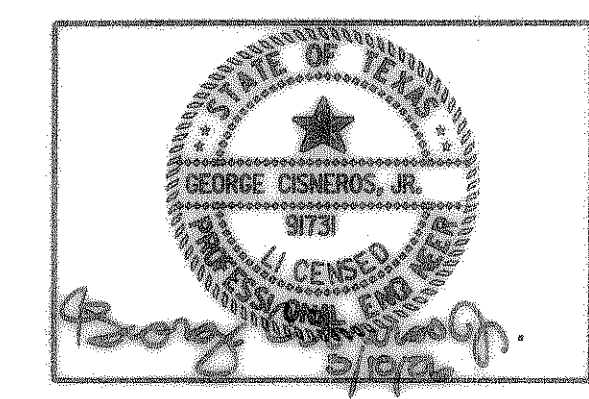


2:57:08 PM
 \\S:\A\FR\PM\Rockwall\SD North\16\Cond\Record Drawings\ROCKWALL-PP17-0816\0005

1			
2			
3			
4			
NO.		DATE	REVISION
CITY OF ROCKWALL "THE NEW HORIZON"			
1H-30 NORTH AND FM 549 WATER LINE - PHASE ONE			
STA. 154+00 TO STA. 163+00			
TCB <small>TurnerCollie & Braden Inc.</small> <small>Engineers • Planners • Project Managers</small>			
Unit	A123	Scale	Horizontal = 1" = 40' Vertical = 1" = 5'
Drawn	JBA	Checked	TBS
Design	JBA	Approved	RCR
Date		SEPTEMBER 2004	
Job No.		082131875.0001	
Sheet		18 of 25	

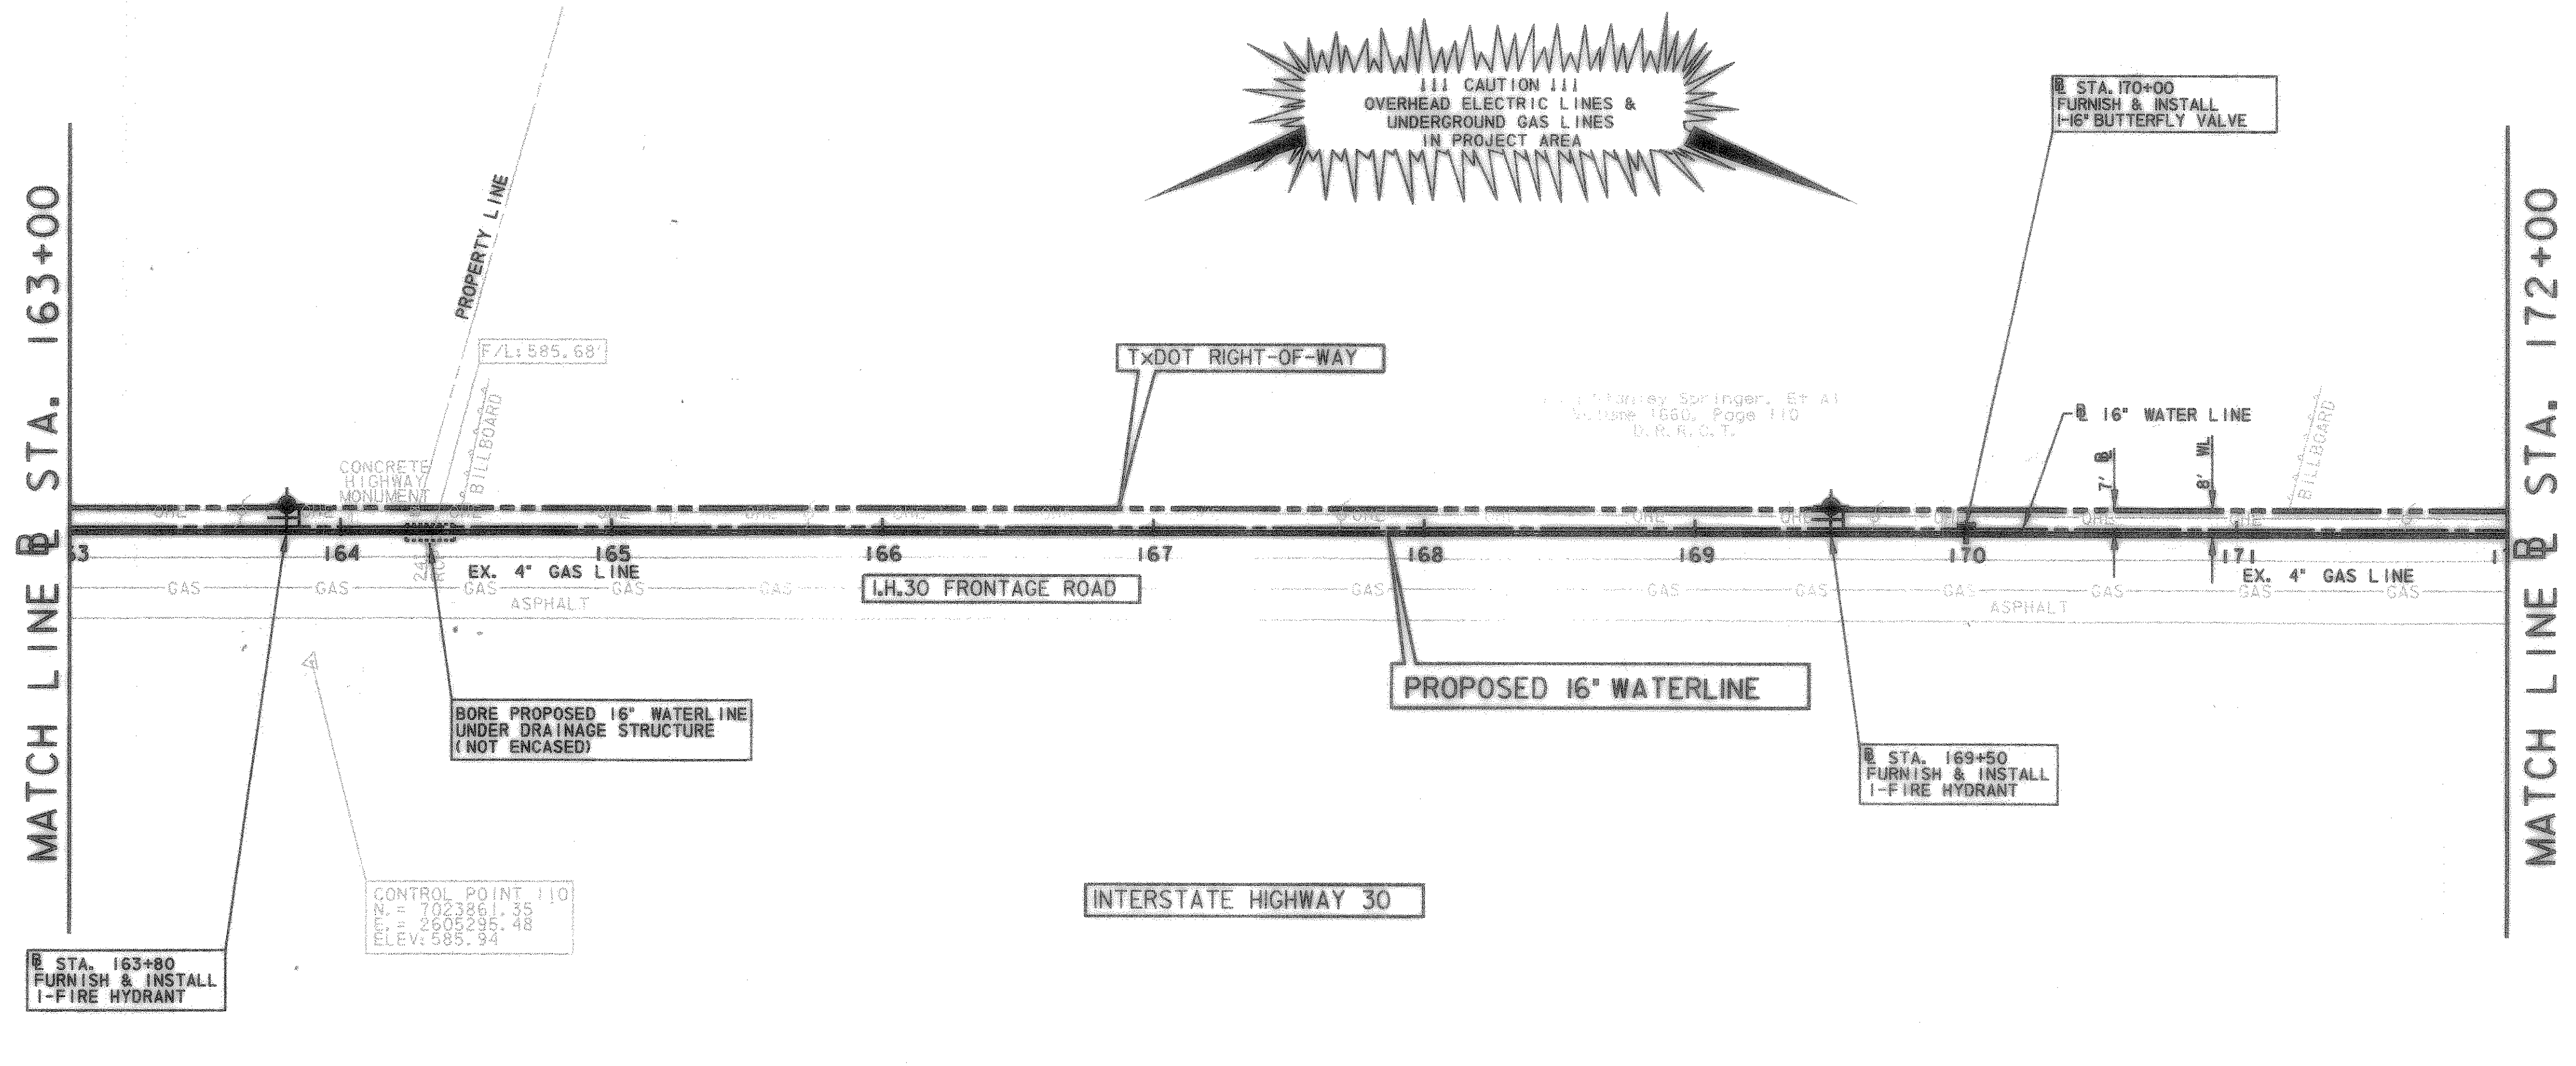



!!! CAUTION !!!
 OVERHEAD ELECTRIC LINES &
 UNDERGROUND GAS LINES
 IN PROJECT AREA

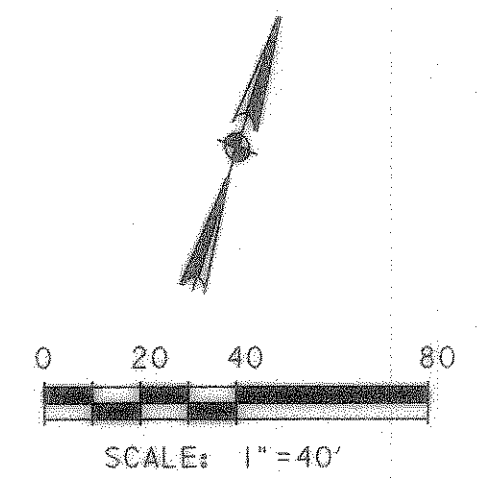

LEGEND	
	POWER POLE
	GUY WIRE
	TELEPHONE BOX
	POST
	SIGN
	IRON ROD
	FIRE HYDRANT
	WATER VALVE
	MANHOLE
	WATER METER
	IRRIGATION CONTROL VALVE
	GUARD RAIL
	GAS METER
	WASTE WATER MANHOLE
	CHAIN LINK FENCE
	WOOD FENCE
	IRON ROD FOUND
	MONUMENT
	ELECTRIC BOX
	BARBED WIRE FENCE
	TREE
	TELEPHONE UNDERGROUND
	APPROXIMATE GAS LINE
	APPROXIMATE WATER LINE
	OVERHEAD POWER LINE
	TELEPHONE MANHOLE
	TRAFFIC SIGNAL CONTROL BOX
	GAS VALVE

UNDERGROUND UTILITIES

THE LOCATION OF EXISTING UTILITIES SHOWN ON THESE PLANS ARE APPROXIMATE AND BASED ON DATA FURNISHED BY UTILITY COMPANIES. IT IS THE RESPONSIBILITY OF THE CONTRACTOR TO LOCATE AND VERIFY ON-SITE THE UTILITIES THAT MAY CONFLICT WITH THE CONSTRUCTION.

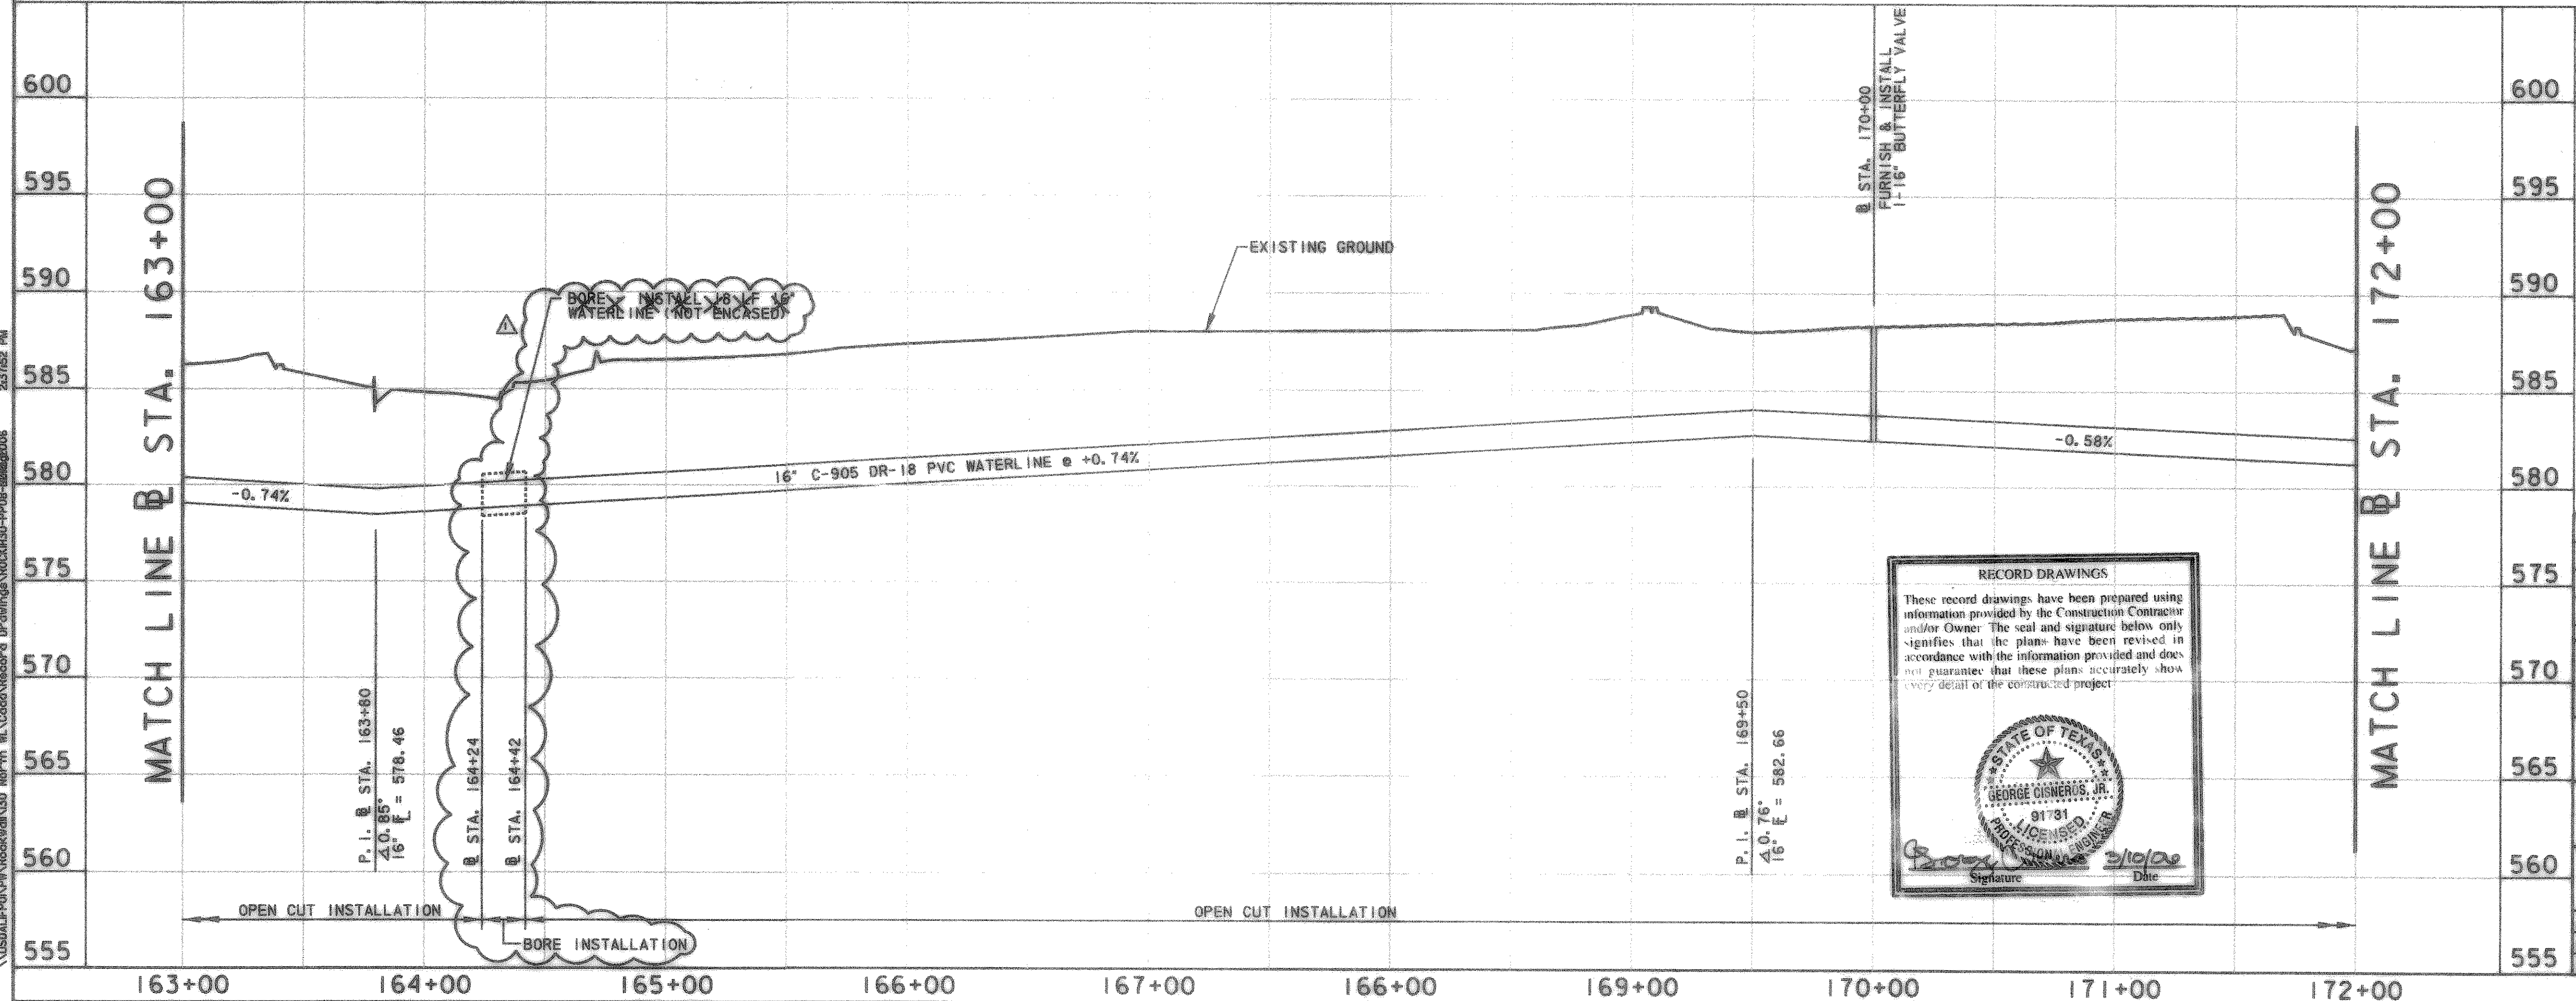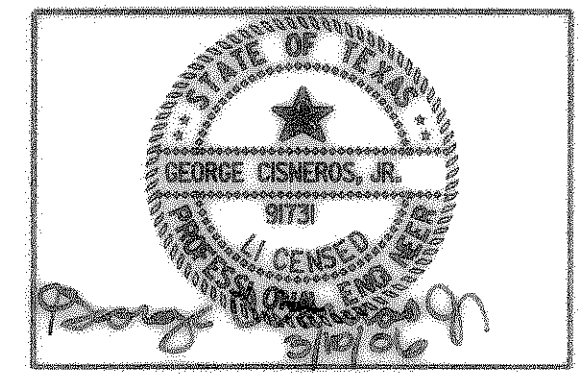


RECORD DRAWINGS

These record drawings have been prepared using information provided by the Construction Contractor and/or Owner. The seal and signature below only signifies that the plans have been revised in accordance with the information provided and does not guarantee that these plans accurately show every detail of the constructed project.

Signature: _____ Date: 9/10/06


4			
3			
2			
1	07-09-06	RECORD DRAWING	
NO.	DATE	REVISION	APPROV.
 CITY OF ROCKWALL "THE NEW HORIZON" IH-30 NORTH AND FM 549 WATER LINE - PHASE ONE STA. 163+00 TO STA. 172+00			
 TCB Turner Collier & Braden Inc. Engineers • Planners • Project Managers			
Unit:	A123	Scale:	Horizontal: 1"=40'
Designed:	GC	Checked:	TBS
Drawn:	GBA	Approved:	RCR
Date:	SEPTEMBER 2004	Job No.:	052131875.0001
Sheet:	15 of 25		

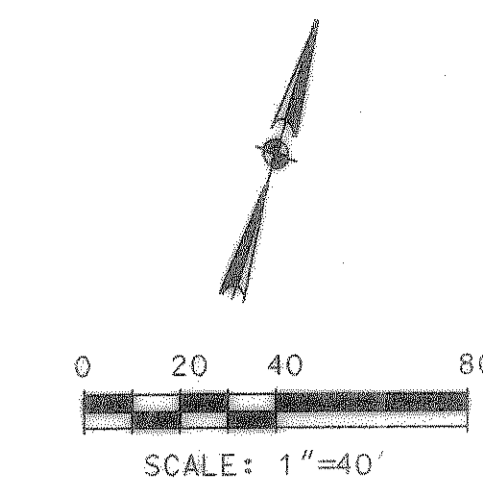

!!! CAUTION !!!
OVERHEAD ELECTRIC LINES &
UNDERGROUND GAS LINES &
IN PROJECT AREA

MATCH LINE @ STA. 172+00



MATCH LINE @ STA. 181+00

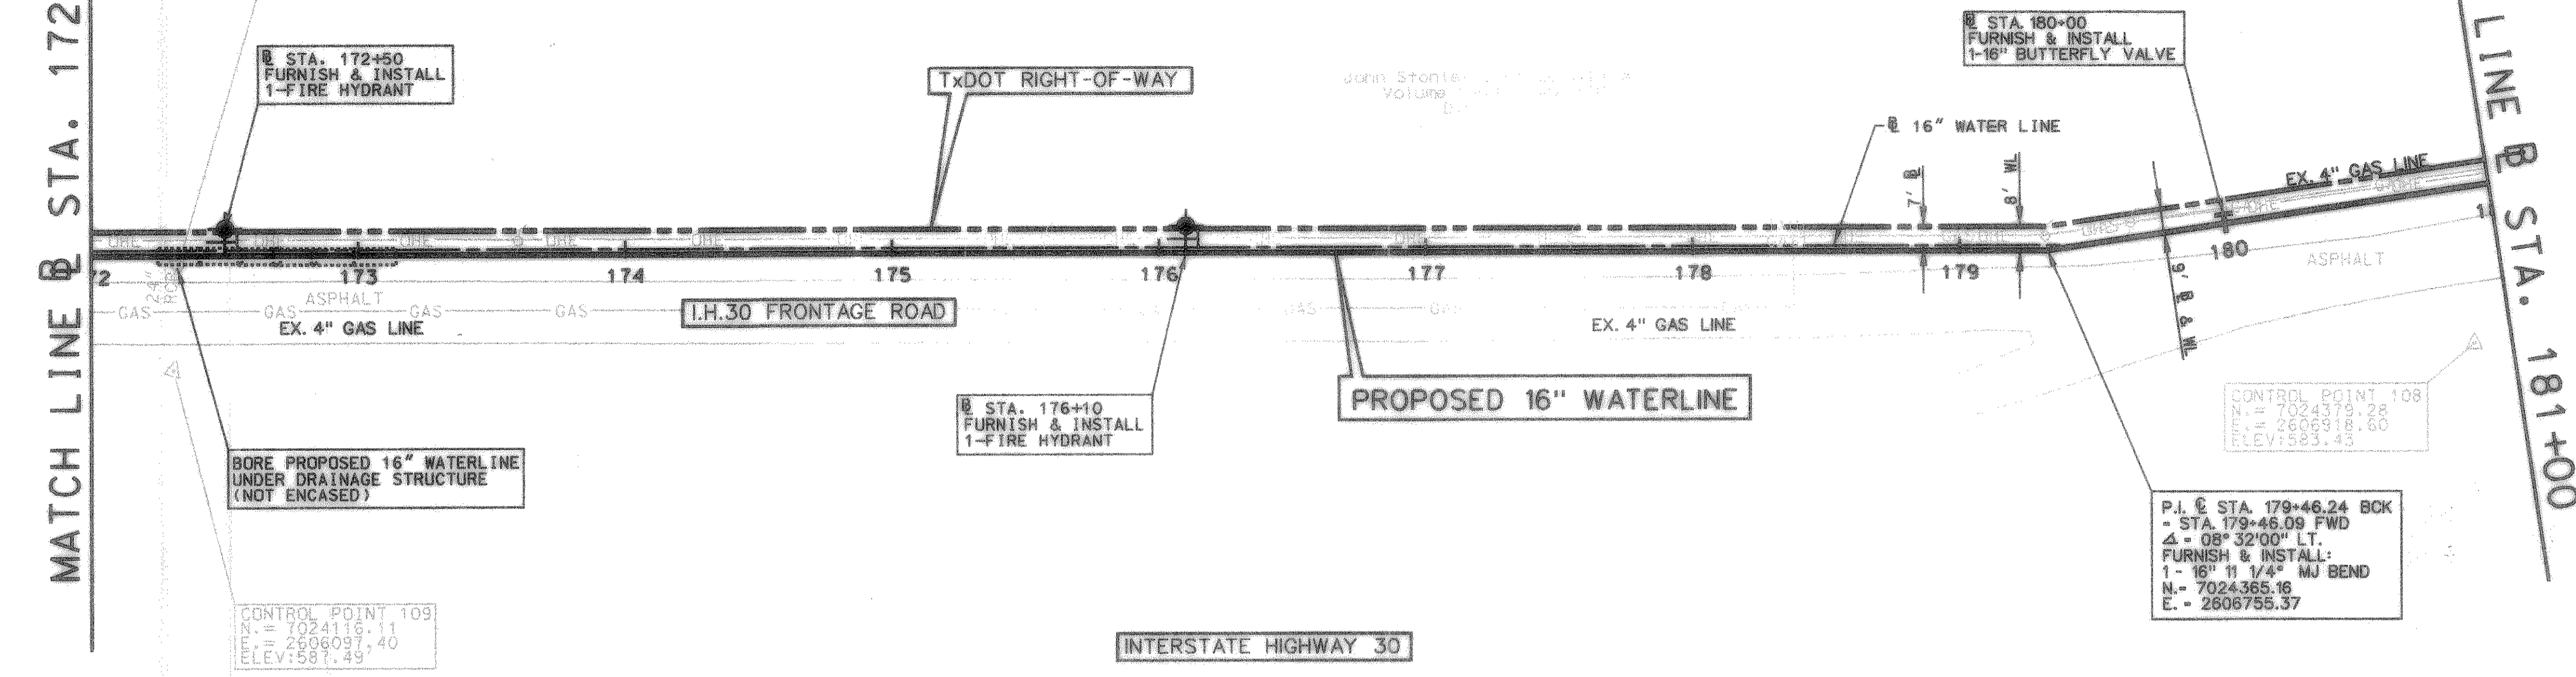

LEGEND	
	POWER POLE
	GUY WIRE
	TELEPHONE BOX
	POST
	SIGN
	IRON ROD
	FIRE HYDRANT
	WATER VALVE
	MAILBOX
	WATER METER
	IRRIGATION CONTROL VALVE
	GUARD RAIL
	GAS METER
	WASTE WATER MANHOLE
	CHAIN LINK FENCE
	WOOD FENCE
	IRON ROD FOUND
	MONUMENT
	ELECTRIC BOX
	BARBED WIRE FENCE
	TREE
	TELEPHONE UNDERGROUND
	APPROXIMATE GAS LINE
	APPROXIMATE WATER LINE
	OVERHEAD POWER LINE
	TELEPHONE MANHOLE
	TRAFFIC SIGNAL CONTROL BOX
	GAS VALVE

UNDERGROUND UTILITIES

THE LOCATION OF EXISTING UTILITIES SHOWN ON THESE PLANS ARE APPROXIMATE AND BASED ON DATA FURNISHED BY UTILITY COMPANIES. IT IS THE RESPONSIBILITY OF THE CONTRACTOR TO LOCATE AND VERIFY ON-SITE THE UTILITIES THAT MAY CONFLICT WITH THE CONSTRUCTION.

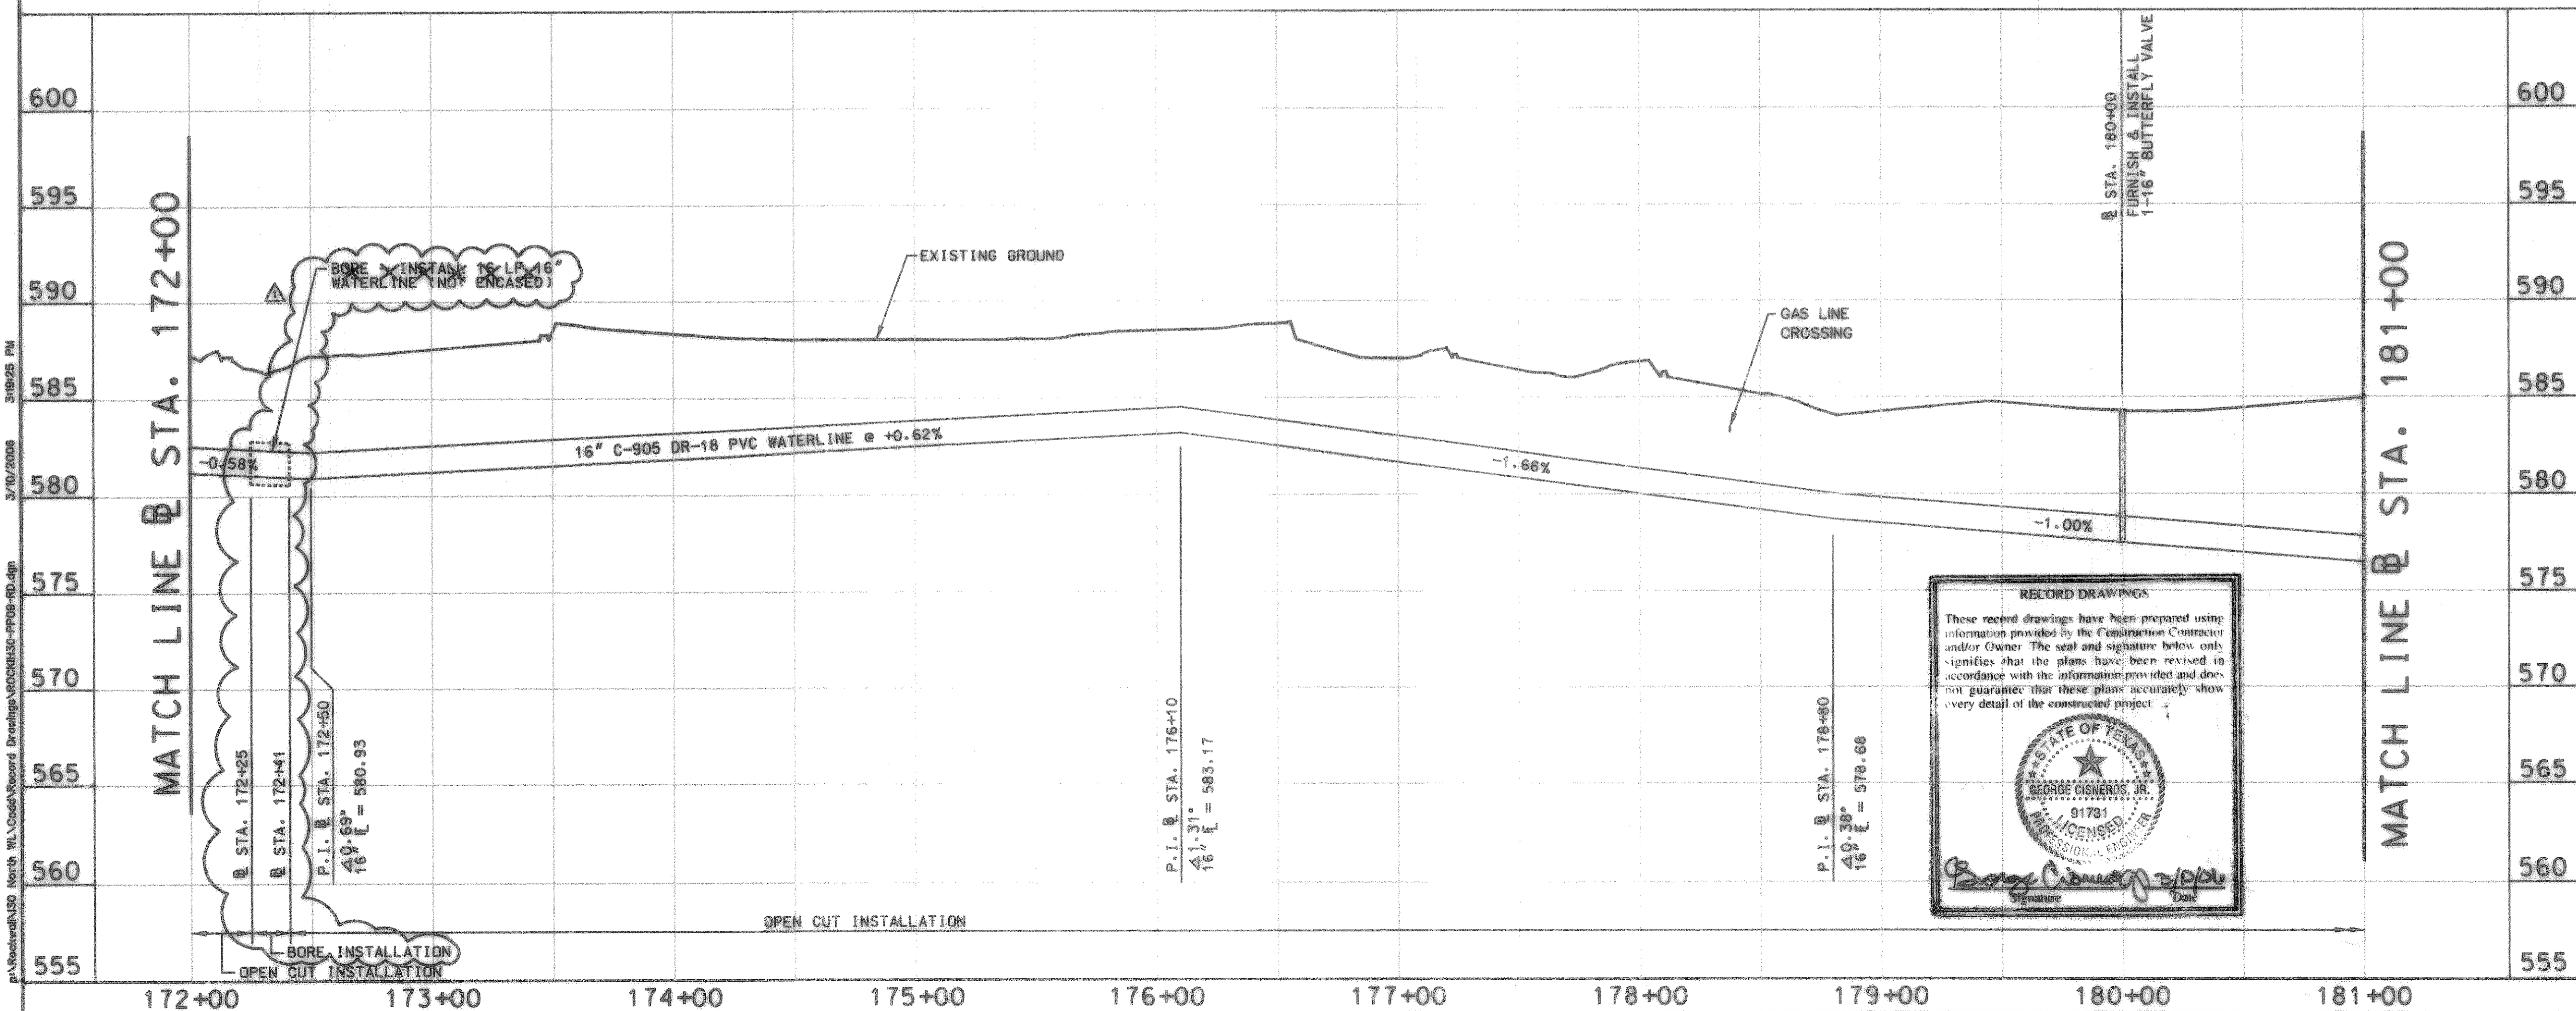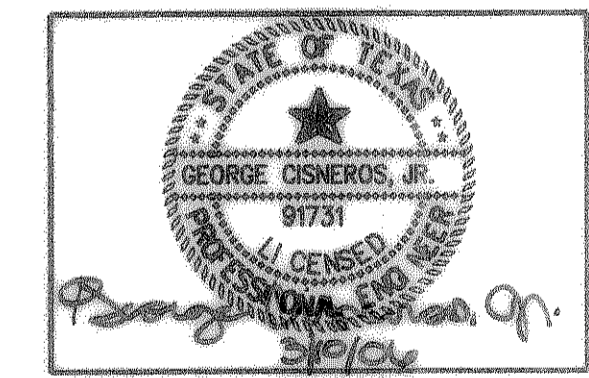

RECORD DRAWINGS

These record drawings have been prepared using information provided by the Consignee Contractor and/or Owner. The seal and signature below only signifies that the plans have been revised in accordance with the information provided and does not guarantee that these plans accurately show every detail of the constructed project.

George Cisneros, Jr.
Signature Date

3/7/2008 3:48:25 PM p:\rockwell\ISO_Merch_WL\Coord\Record Drawings\ROCKWELL\PP08-10.dwg

4			
3			
2			
1	03-08-08	RECORD DRAWING	
NO.	DATE	REVISION	APP'D.
CITY OF ROCKWALL "THE NEW HORIZON"			
I-30 NORTH AND FM 549 WATER LINE - PHASE ONE			
@ STA. 172+00 TO @ STA. 181+00			
TCB Turner Collier & Braden Inc. Engineers • Planners • Project Managers			
Unit	A123	Scale	Horizontal: 1"=40' Vertical: 1"=20'
Drawn	GBA	Checked	TBS
Date	SEPTEMBER 2004	Job No.	052131075-0001
Approved	RCR	Sheet	14 of 25

