



City of Rockwall, Texas

CONSTRUCTION PLANS FOR IH 30 WATER LINE IMPROVEMENTS FROM TOWNSEND DRIVE TO FM 549

RECORD DRAWING

This drawing is a compilation of the original sealed engineering drawing and modifications by addenda, change orders and information furnished by the contractor. Information shown that was provided by the contractor and others not associated with the design engineer cannot be verified for accuracy or completeness. Original sealed drawing is on file at the office of AECOM TECHNICAL SERVICES, Inc., TBPE REG. NO. F-3580

INDEX OF DRAWINGS

SHEET NO.	TITLE
1	COVER SHEET
2	GENERAL NOTES
3	LOCATION MAP
4	PROJECT LAYOUT AND CONTROL POINTS
5	QUANTITIES SHEET
6	N WL STA. 99+00 TO STA. 105+00
7	N WL STA. 105+00 TO STA. 111+00
8	N WL STA. 111+00 TO STA. 117+00
9	N WL STA. 124+00 TO STA. 129+00
10	N WL STA. 129+00 TO STA. 135+75
11	S WL STA. 199+00 TO STA. 205+00
12	S WL STA. 213+50 TO STA. 219+00
13	S WL STA. 219+00 TO STA. 223+00
14	S WL STA. 223+00 TO STA. 229+00
15	S WL STA. 229+00 TO STA. 235+00
16	S WL STA. 235+00 TO STA. 241+00
17	STORMWATER POLLUTION PREVENTION PLAN (SW3P)
18-21	STORMWATER POLLUTION PREVENTION PLAN LAYOUT
22-24	STANDARD WATER DETAILS
* 25-26	PREFABRICATED GALVANIZED STEEL END SECTION SAFETY END TREATMENT FOR 12" TO 60" DIA CMP CULVERTS TYPE 11 PARALLEL DRAINAGE: GS-ES-PD
* 27	TRAFFIC CONTROL PLAN: TCP (2-2)-03
* 28	TEMPORARY EROSION, SEDIMENT AND WATER POLLUTION CONTROL MEASURES: EC (1)-93

* THE TxDOT STANDARD SHEETS SPECIFICALLY IDENTIFIED ABOVE HAVE BEEN SELECTED BY ME OR UNDER MY RESPONSIBLE SUPERVISION AS BEING APPLICABLE TO THIS PROJECT.

NAME _____, P. E. DATE _____

ORIGINAL DRAWING
SEALED & SIGNED BY
T.H. Gaertner, P.E.
TX NO. 37124
ON 1-4-11

MAYOR
Bill Cecil

MAYOR PRO-TEM
Glen Farris

CITY COUNCIL
David Sweet
Mark Russo
Cliff Sevier
Matt Scott
Margo Nielsen

CITY MANAGER
Julie Couch


CITY ENGINEER
Chuck Todd

AFTER THE ORIGINAL ISSUANCE OF THESE PLANS BY AECOM USA GROUP INC., LICENSE NO. F-3082, AECOM USA GROUP, INC.'S CONTRACT WAS ASSIGNED TO AECOM TECHNICAL SERVICES, INC., LICENSE NO. F-3580. AECOM IS THE PRIME CONSULTANT TO THE OWNER OF THIS PROJECT.



AECOM TECHNICAL SERVICES, INC.
16000 DALLAS PARKWAY, SUITE 350
DALLAS, TEXAS 75248
WWW.AECOM.COM
TBPE REG. NO. F-3580

AUGUST 2009

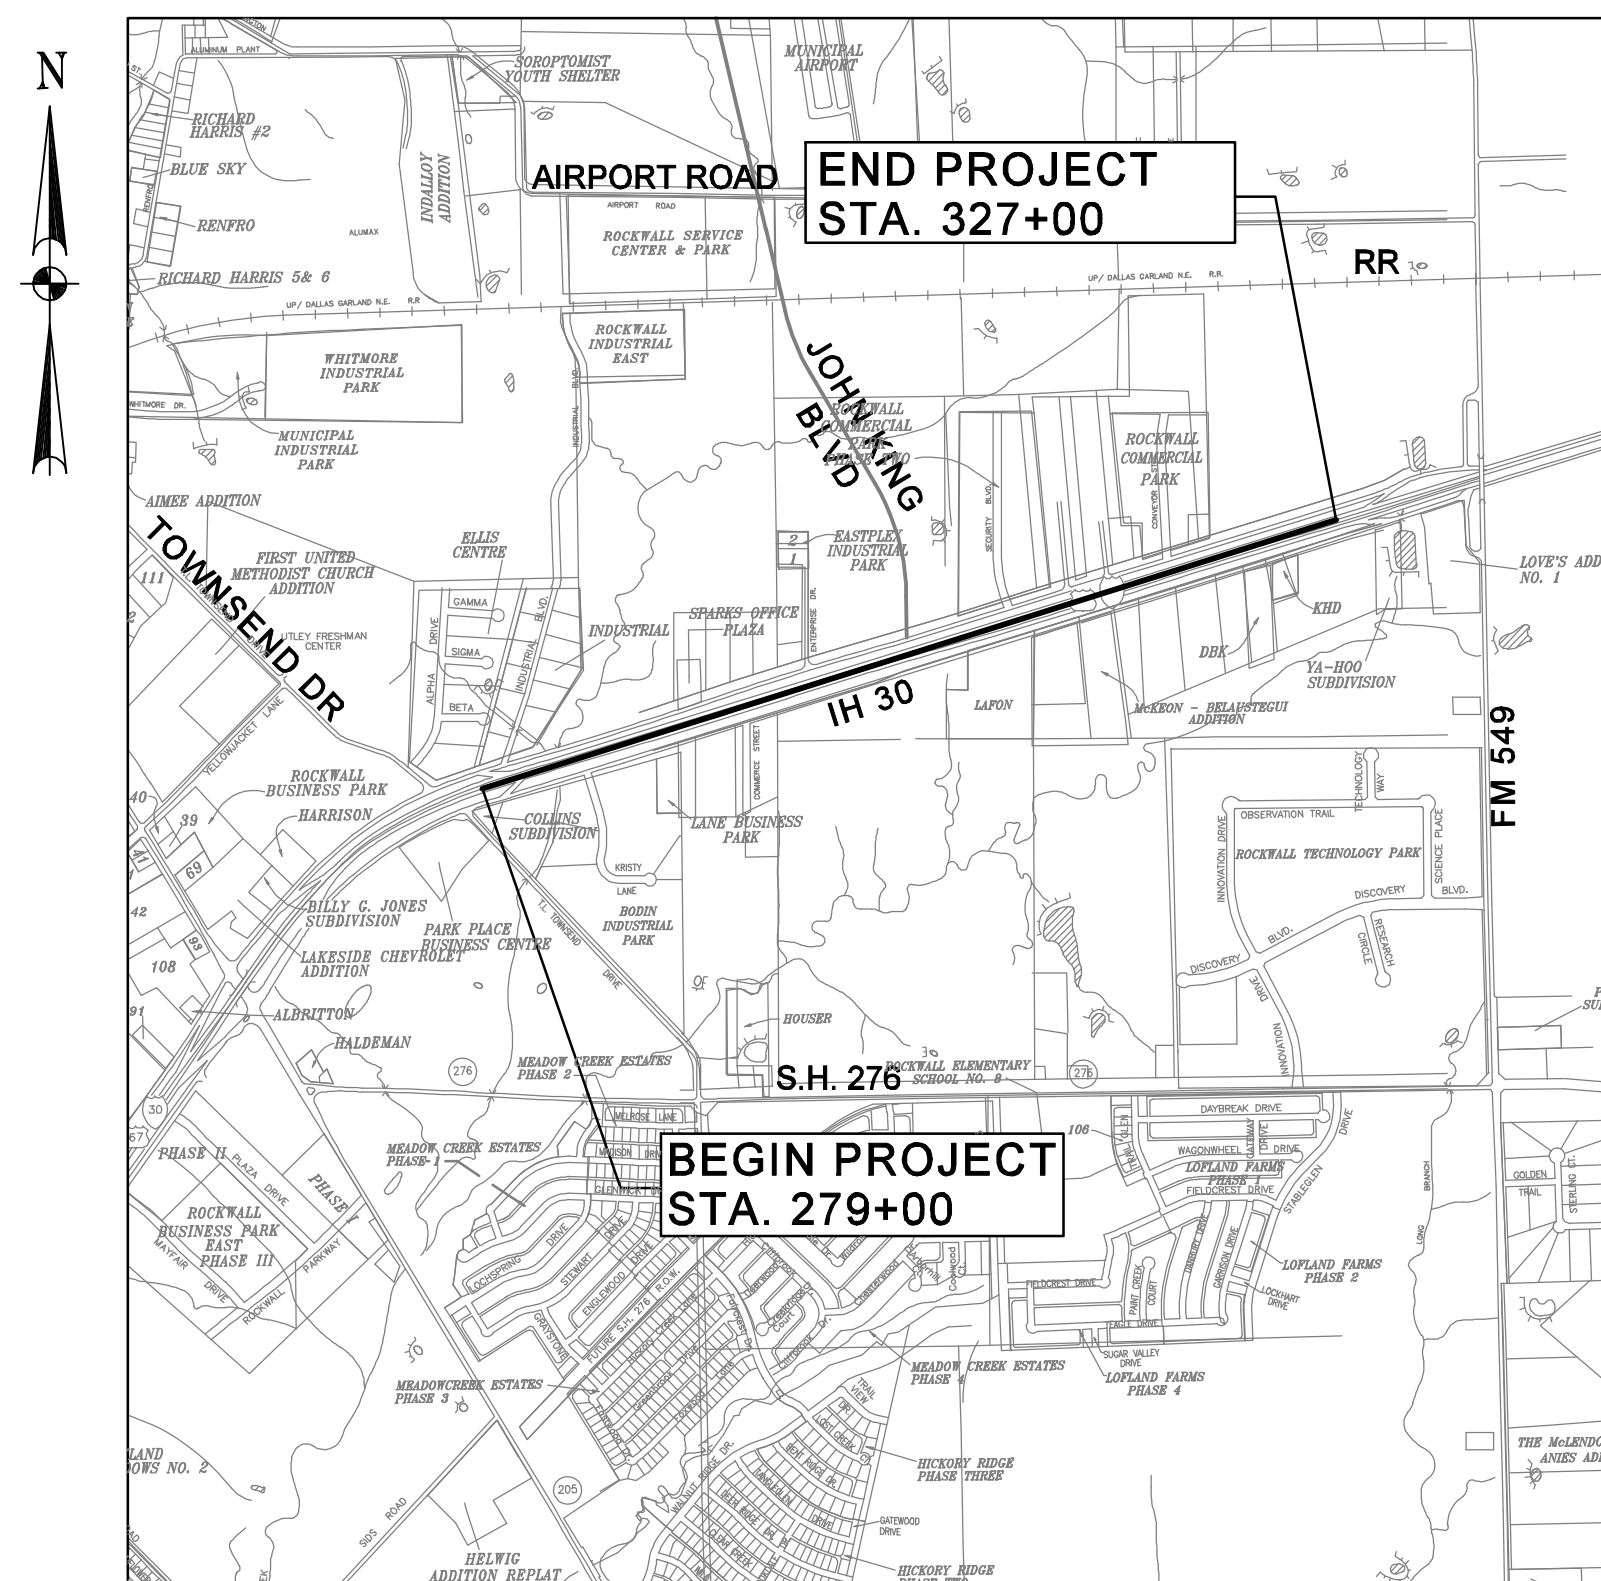

VICINITY MAP
SCALE: N.T.S.

AECOM PROJECT NO. 60072620