


UNDERGROUND UTILITIES
 THE LOCATION OF EXISTING UTILITIES SHOWN ON THESE PLANS ARE APPROXIMATE AND BASED ON DATA FURNISHED BY UTILITY COMPANIES. IT IS THE RESPONSIBILITY OF THE CONTRACTOR TO LOCATE AND VERIFY ON-SITE THE UTILITIES THAT MAY CONFLICT WITH THE CONSTRUCTION. THERE SHALL BE A MINIMUM CLEARANCE OF 24" BETWEEN EXISTING UTILITIES.

RECORD DRAWING
 This drawing is a compilation of the original sealed engineering drawing and modifications by addenda, change orders and information furnished by the contractor. Information shown that was provided by the contractor and others not associated with the design engineer cannot be verified for accuracy or completeness. Original sealed drawing is on file at the office of AECOM TECHNICAL SERVICES, Inc., TBPE REG. NO. F-3580

ORIGINAL DRAWING SEALED & SIGNED BY
 T.H. Gaertner, P.E.
 TX NO. 37124
 ON 8-7-09

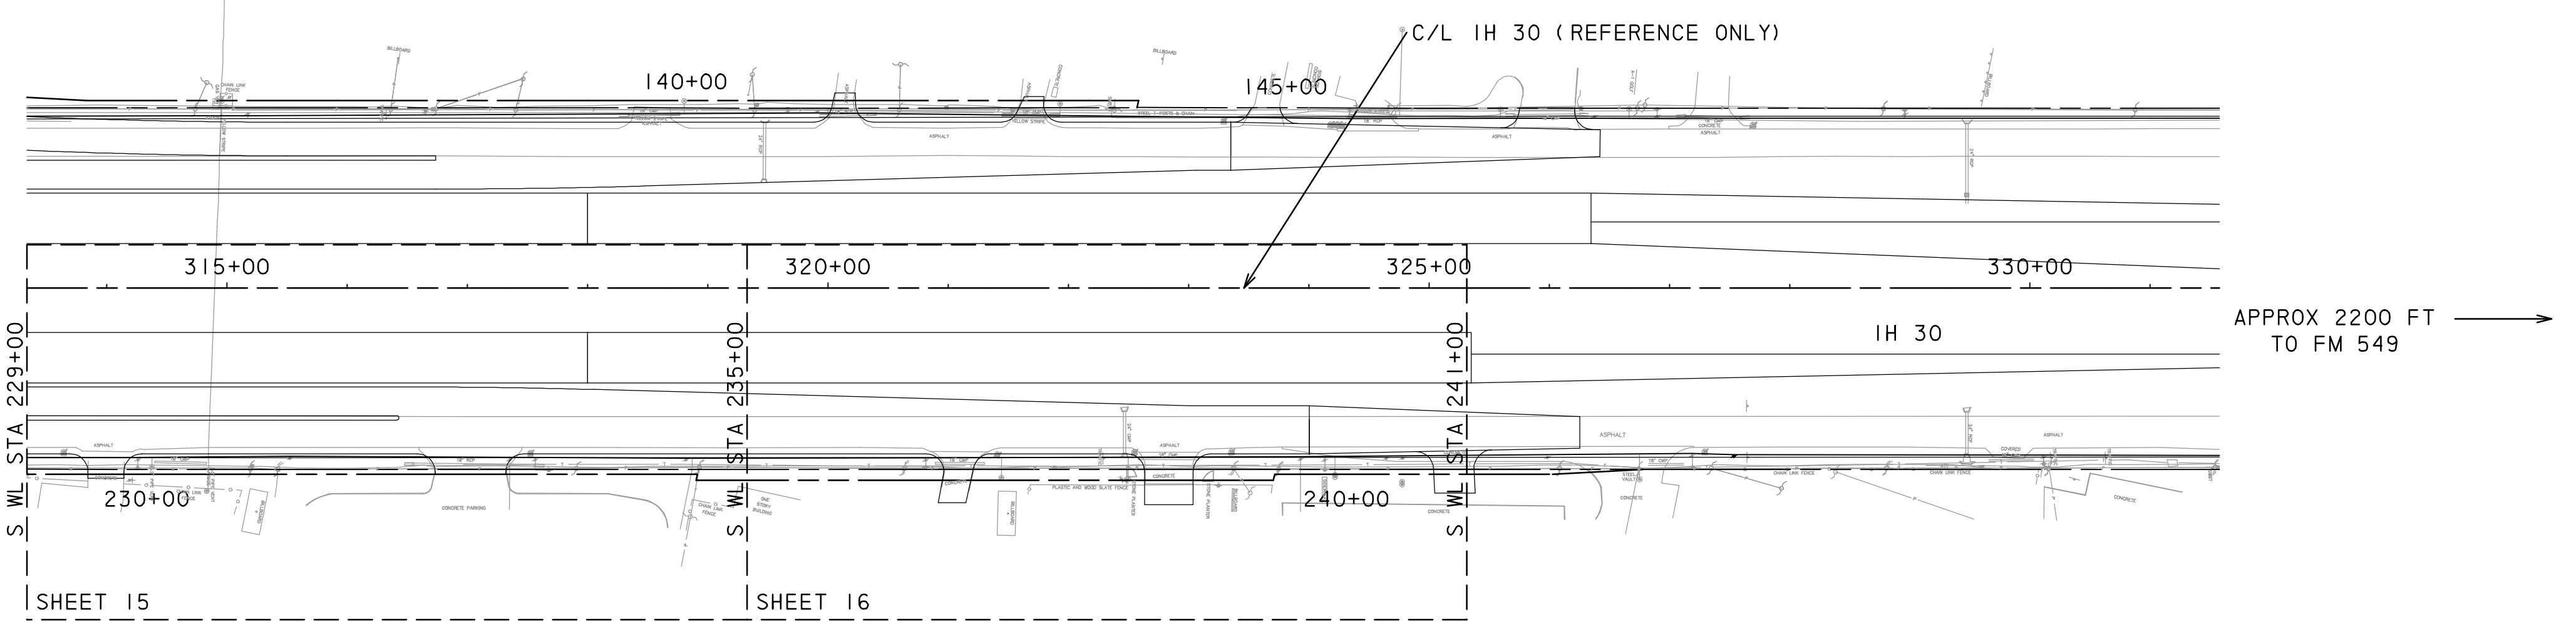

NO.	REVISION	BY	DATE

City of Rockwall, Texas

**IH 30
WATER LINE IMPROVEMENTS**

LOCATION MAP

AECOM
AECOM TECHNICAL SERVICES, INC.
 19000 DALLAS PARKWAY, SUITE 350
 DALLAS, TEXAS 75248
 WWW.AECOM.COM
 TBPE REG. NO. F-3580

Unit	AECOM Water	Scale	Horz: AS SHOWN Vert: AS SHOWN	Date	11/4/2011
Designed	JR/RH	Checked	JR/TG	Project No.	60072620
Drawn	RH/FG	Approved	GH	Sheet	3 of 28

\\usd011\p002\PM\Rockw01\IH30_UF11\FY\CADD\Sheets\REC 10_26_11\IH30U_Locaf tonMap_REC10_26_11.dgn
 11/24/2011