


- NOTES:
1. INSTALL BALED HAY FOR EROSION CONTROL PER DETAIL SHEET EC(1)-93.
  2. INSTALL SILT FENCE PER NCTCOG STANDARD DRAWING NO. 1020A AND 1020B.
  3. INSTALL ROCK BERM PER NCTCOG STANDARD DRAWING NO. 1060A AND 1060B.

STA 280+00

MATCHLINE STA 291+00

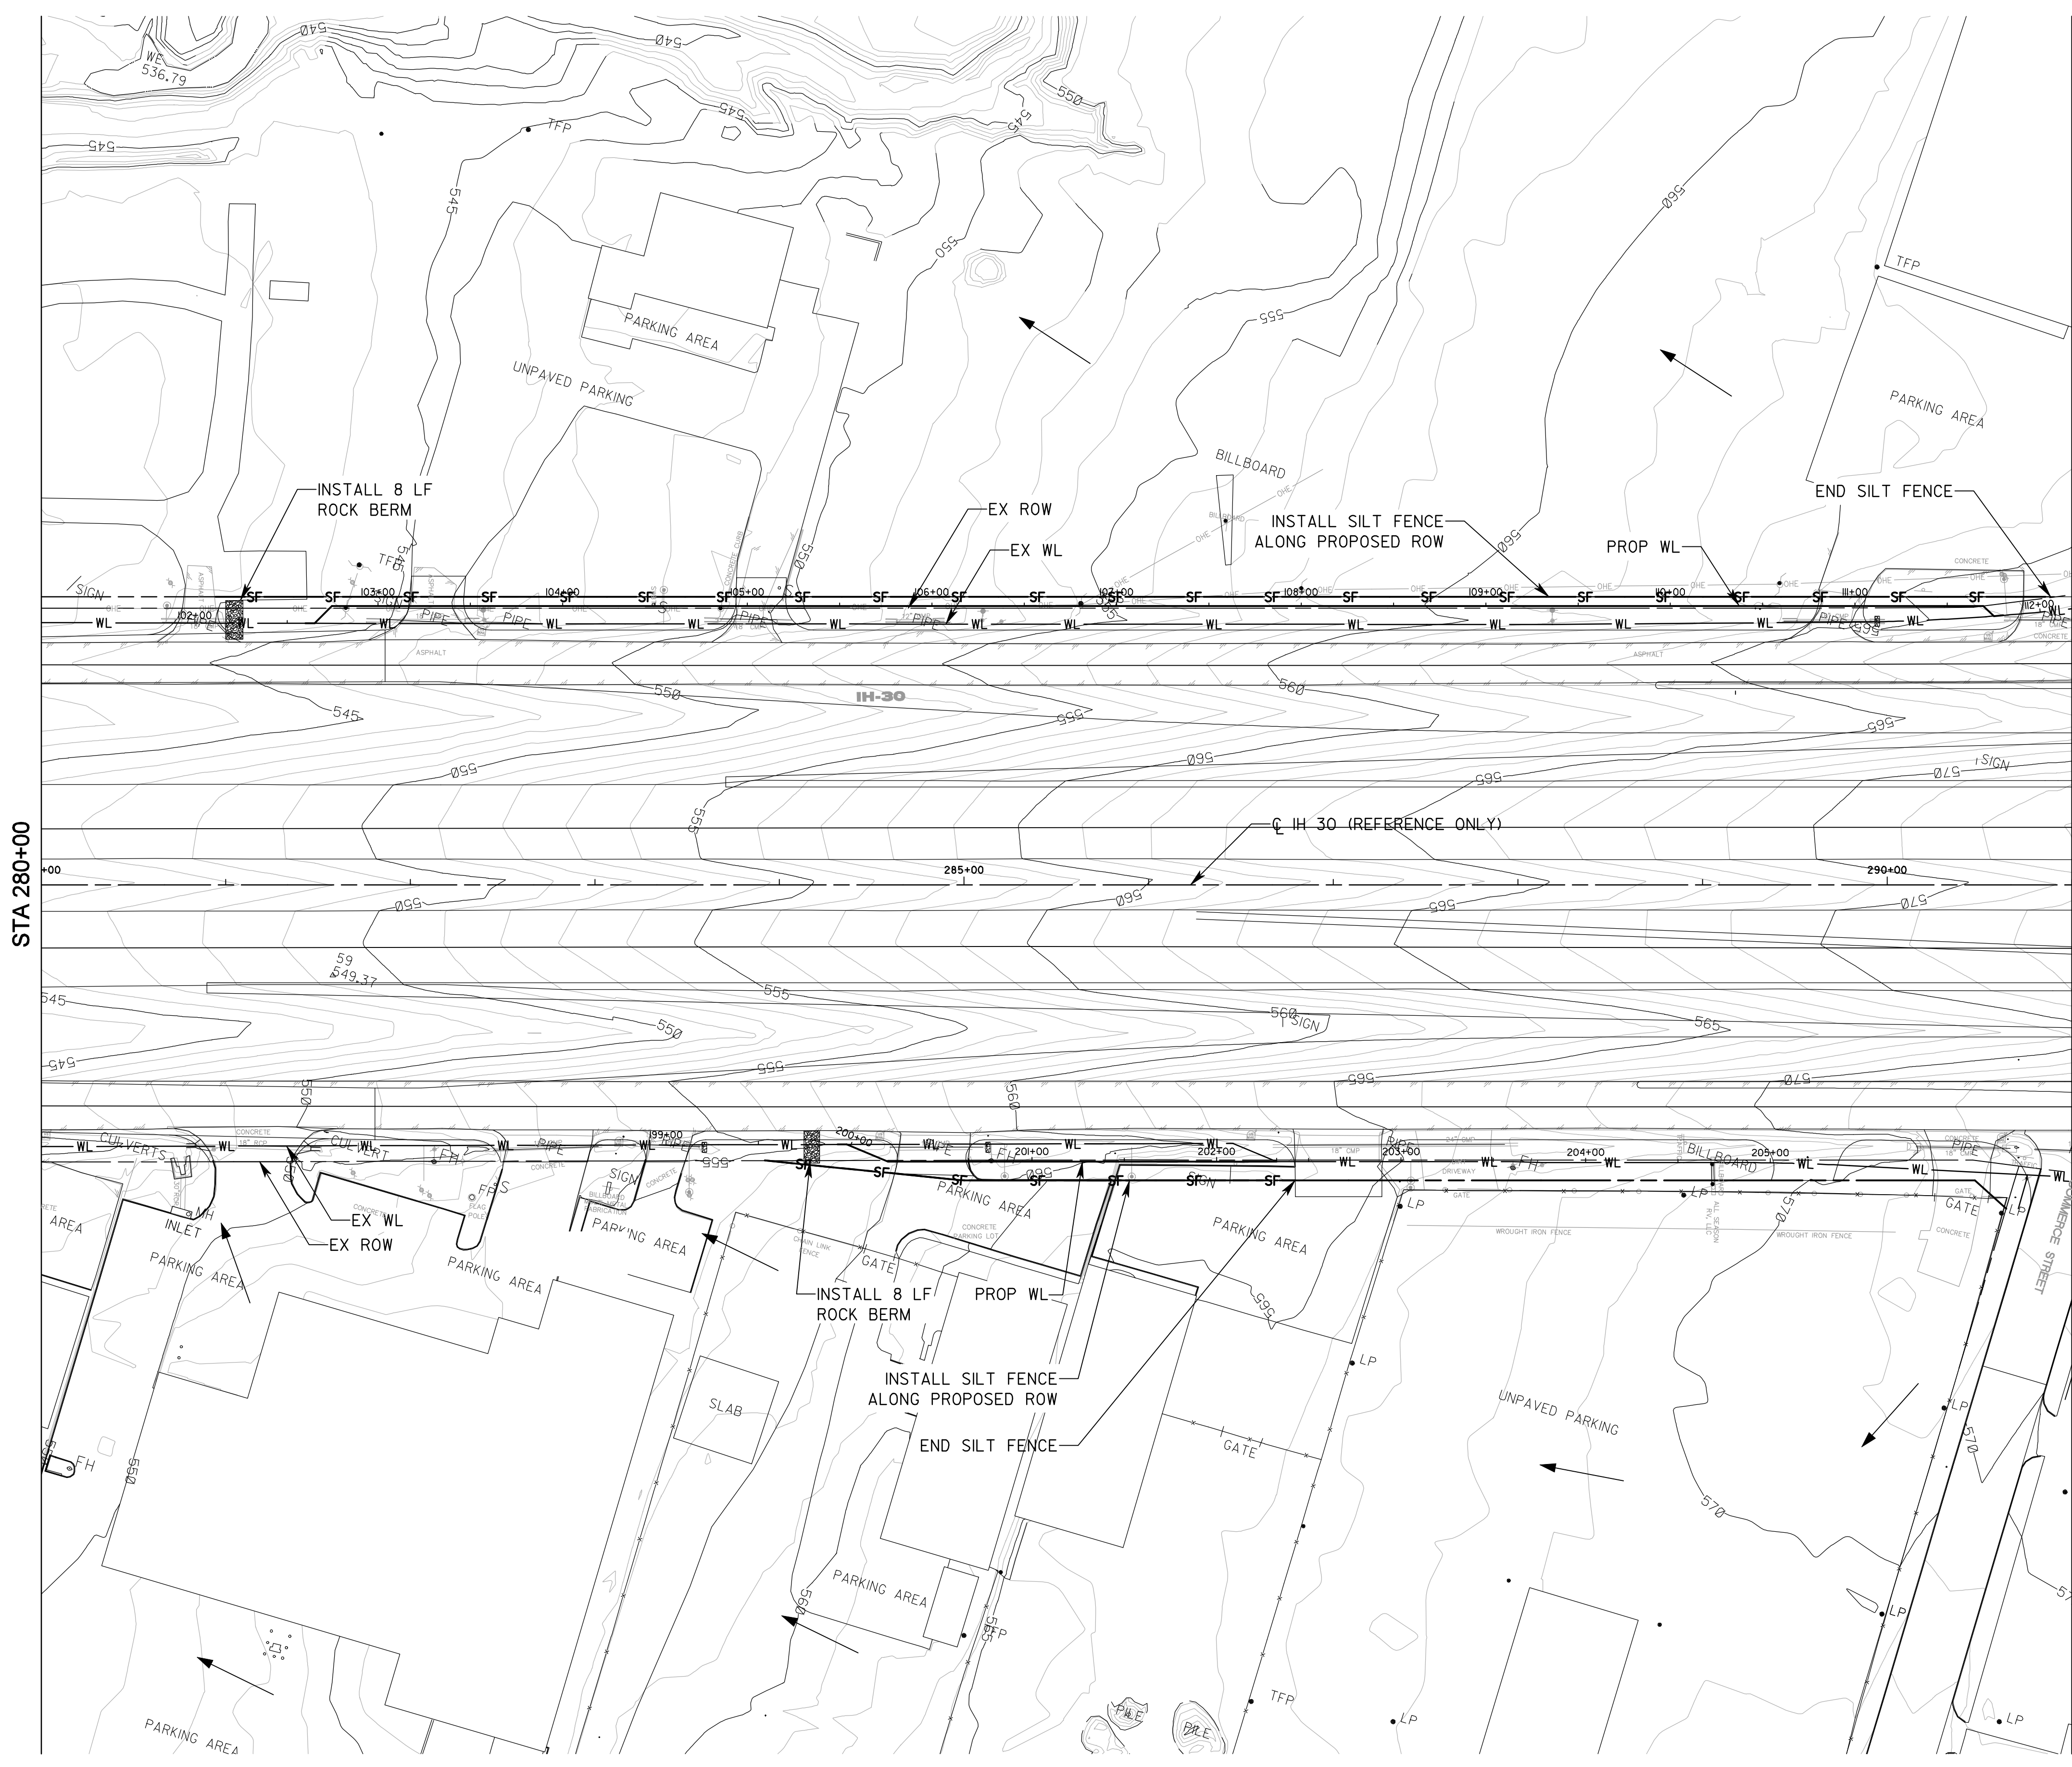

**RECORD DRAWING**

This drawing is a compilation of the original sealed engineering drawing and modifications by addenda, change orders and information furnished by the contractor. Information shown that was provided by the contractor and others not associated with the design engineer cannot be verified for accuracy or completeness. Original sealed drawing is on file at the office of AECOM TECHNICAL SERVICES, Inc., TBPE REG. NO. F-3580

**ORIGINAL DRAWING SEALED & SIGNED BY**

T.H. Gaertner, P.E.  
 TX NO. 37124  
 ON 8-7-09

NO.	REVISION	BY	DATE

**City of Rockwall, Texas**

**IH 30  
 WATER LINE IMPROVEMENTS**

**STORM WATER & POLLUTION  
 PREVENTION PLAN LAYOUT**

1 OF 4

**AECOM**

AECOM TECHNICAL SERVICES, INC.  
 18000 DALLAS PARKWAY, SUITE 350  
 DALLAS, TEXAS 75248  
 WWW.AECOM.COM  
 TBPE REG. NO. F-3580

Unit	AECOM Water	Scale	Horz: AS SHOWN Vert: AS SHOWN	Date	11/4/2011
Designed	JR/RH	Checked	JR/TG	Project No.	60072620
Drawn	RH/FG	Approved	GH	Sheet	18 of 28

\\usd011\p0202\pwr\Rockwall\IH30\_U111\FYACADD\Sheet\REC 10\_26\_11\IH30UL\_SWPPP01\_30\_REC10\_26.dgn  
 11/24/2011