

- NOTES:
1. INSTALL BALED HAY FOR EROSION CONTROL PER DETAIL SHEET ECI(1)-93.
 2. INSTALL SILT FENCE PER NCTCOG STANDARD DRAWING NO. 1020A AND 1020B.
 3. INSTALL ROCK BERM PER NCTCOG STANDARD DRAWING NO. 1060A AND 1060B.

RECORD DRAWING

This drawing is a compilation of the original sealed engineering drawing and modifications by addenda, change orders and information furnished by the contractor. Information shown that was provided by the contractor and others not associated with the design engineer cannot be verified for accuracy or completeness. Original sealed drawing is on file at the office of AECOM TECHNICAL SERVICES, Inc., TBPE REG. NO. F-3580

ORIGINAL DRAWING SEALED & SIGNED BY
 T.H. Gaertner, P.E.
 TX NO. 37124
 ON 8-7-09

NO.	REVISION	BY	DATE




**IH 30
 WATER LINE IMPROVEMENTS**

**STORM WATER & POLLUTION
 PREVENTION PLAN LAYOUT**

2 OF 4

AECOM
 AECOM TECHNICAL SERVICES, INC.
 19000 DALLAS PARKWAY, SUITE 350
 DALLAS, TEXAS 75248
 WWW.AECOM.COM
 TBPE REG. NO. F-3580

Unit	AECOM Water	Scale	Horz: AS SHOWN Vert: AS SHOWN	Date	11/4/2011
Designed	JR/RH	Checked	JR/TG	Project No.	60072620
Drawn	RH/FG	Approved	GH	Sheet	19 of 28

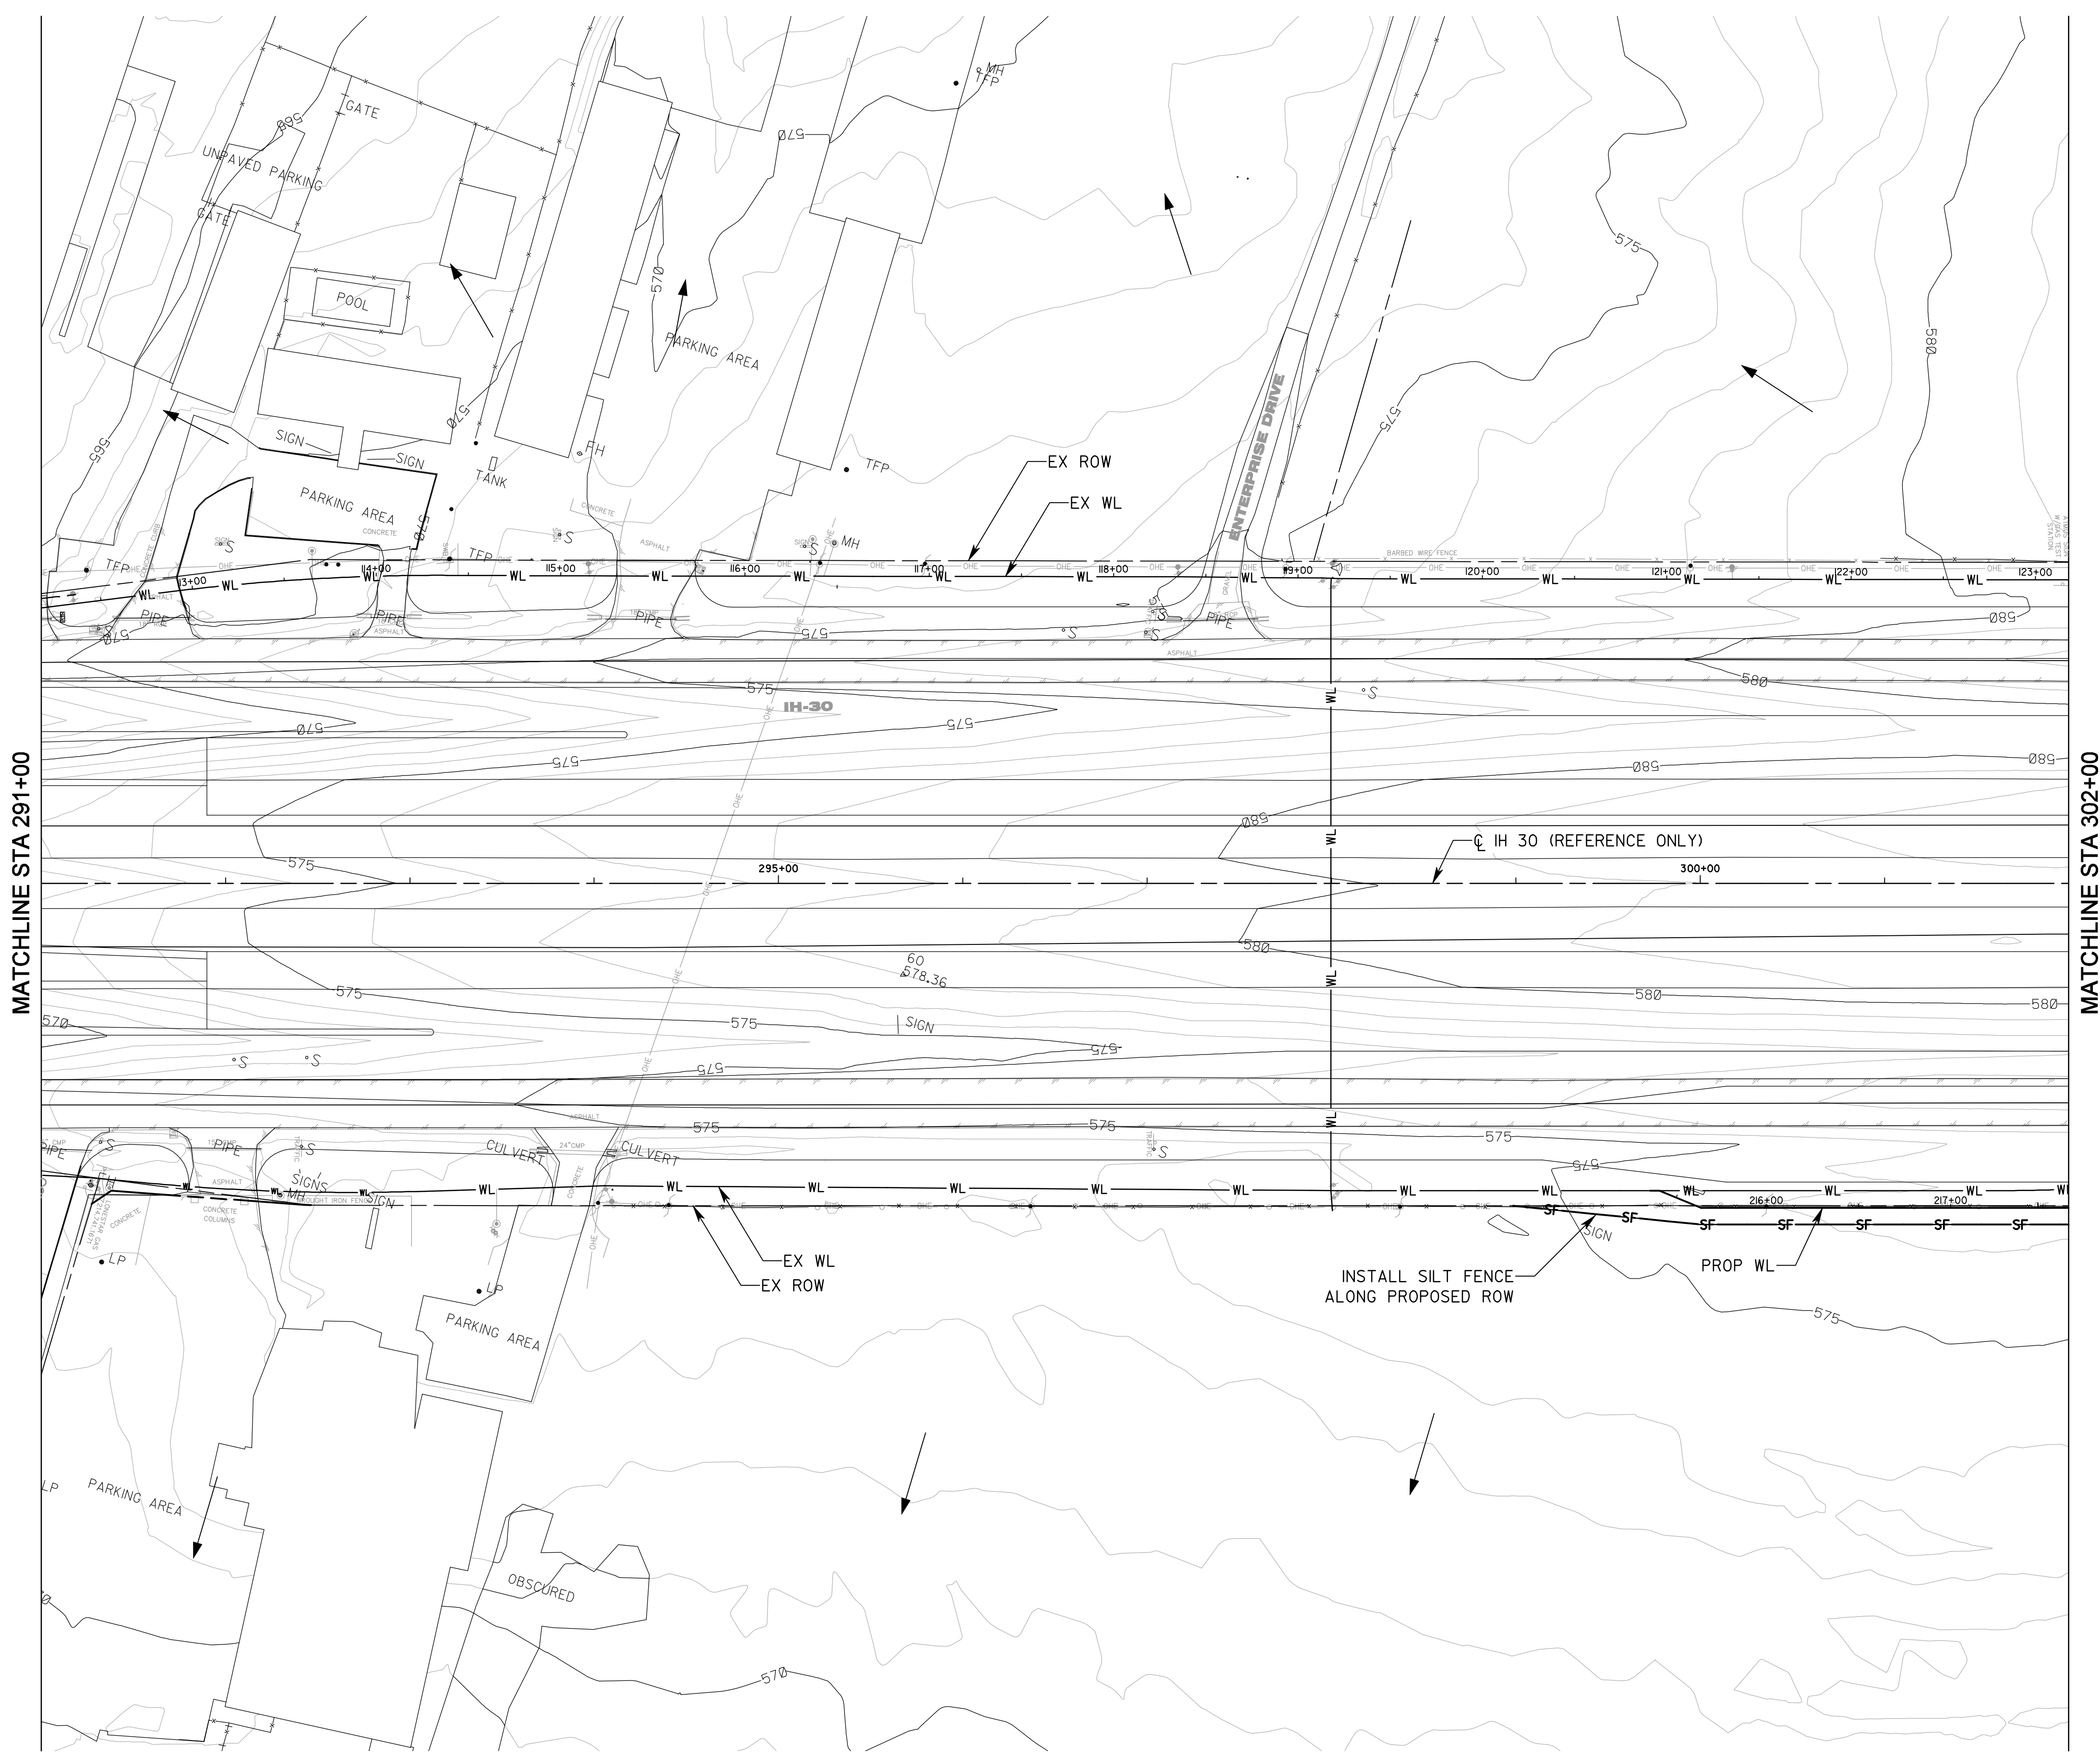

\\usd011\p002\p\Rockwall\IH30_U111\FY\CADD\Sheet\REC 10.26.11\IH30L_SWPPP02_30_REC 10.26.dgn
 11/24/2011