


LEGEND	
	POWER POLE
	GUY WIRE
	TELEPHONE BOX
	POST
	SIGN
	IRON ROD
	FIRE HYDRANT
	WATER METER
	MAILBOX
	WATER METER
	IRRIGATION CONTROL VALVE
	GUARD RAIL
	GAS METER
	GROUND LIGHT
	CHAIN LINK FENCE
	WOOD FENCE
	ASH TREE
	OAK TREE
	CEDAR TREE
	BARBED WIRE FENCE
	REFLECTOR
	APPROXIMATE TELEPHONE LINE
	APPROXIMATE GAS LINE
	APPROXIMATE WATER LINE
	OVERHEAD POWER LINE
	PINE TREE
	PECAN TREE

RECORD DRAWING

by *Dominique Simon*
DATE 3-6-02

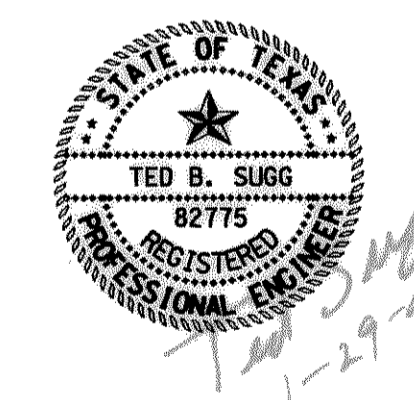

NO.	DATE	REVISION	APPROV
1	1-29-02	RECORD DRAWING	TBS

CITY OF ROCKWALL
"THE NEW HORIZON"

I. H. 30 AND FM 549
WATER LINE IMPROVEMENTS

PIPE LAYOUT STA. 127+00

TurnerCollie & Braden Inc.
ENGINEERS • PLANNERS • PROJECT MANAGERS

Designed	TBS	Checked	DWN	Date	FEBRUARY, 1999
Drawn	JLC	Approved	RCR	Job No.	15-98925-200
					SHEET 25 OF 33

P:\ROCKWALL\1580\DRAWINGS\PIPE 1.DWG