



STA. 86+75

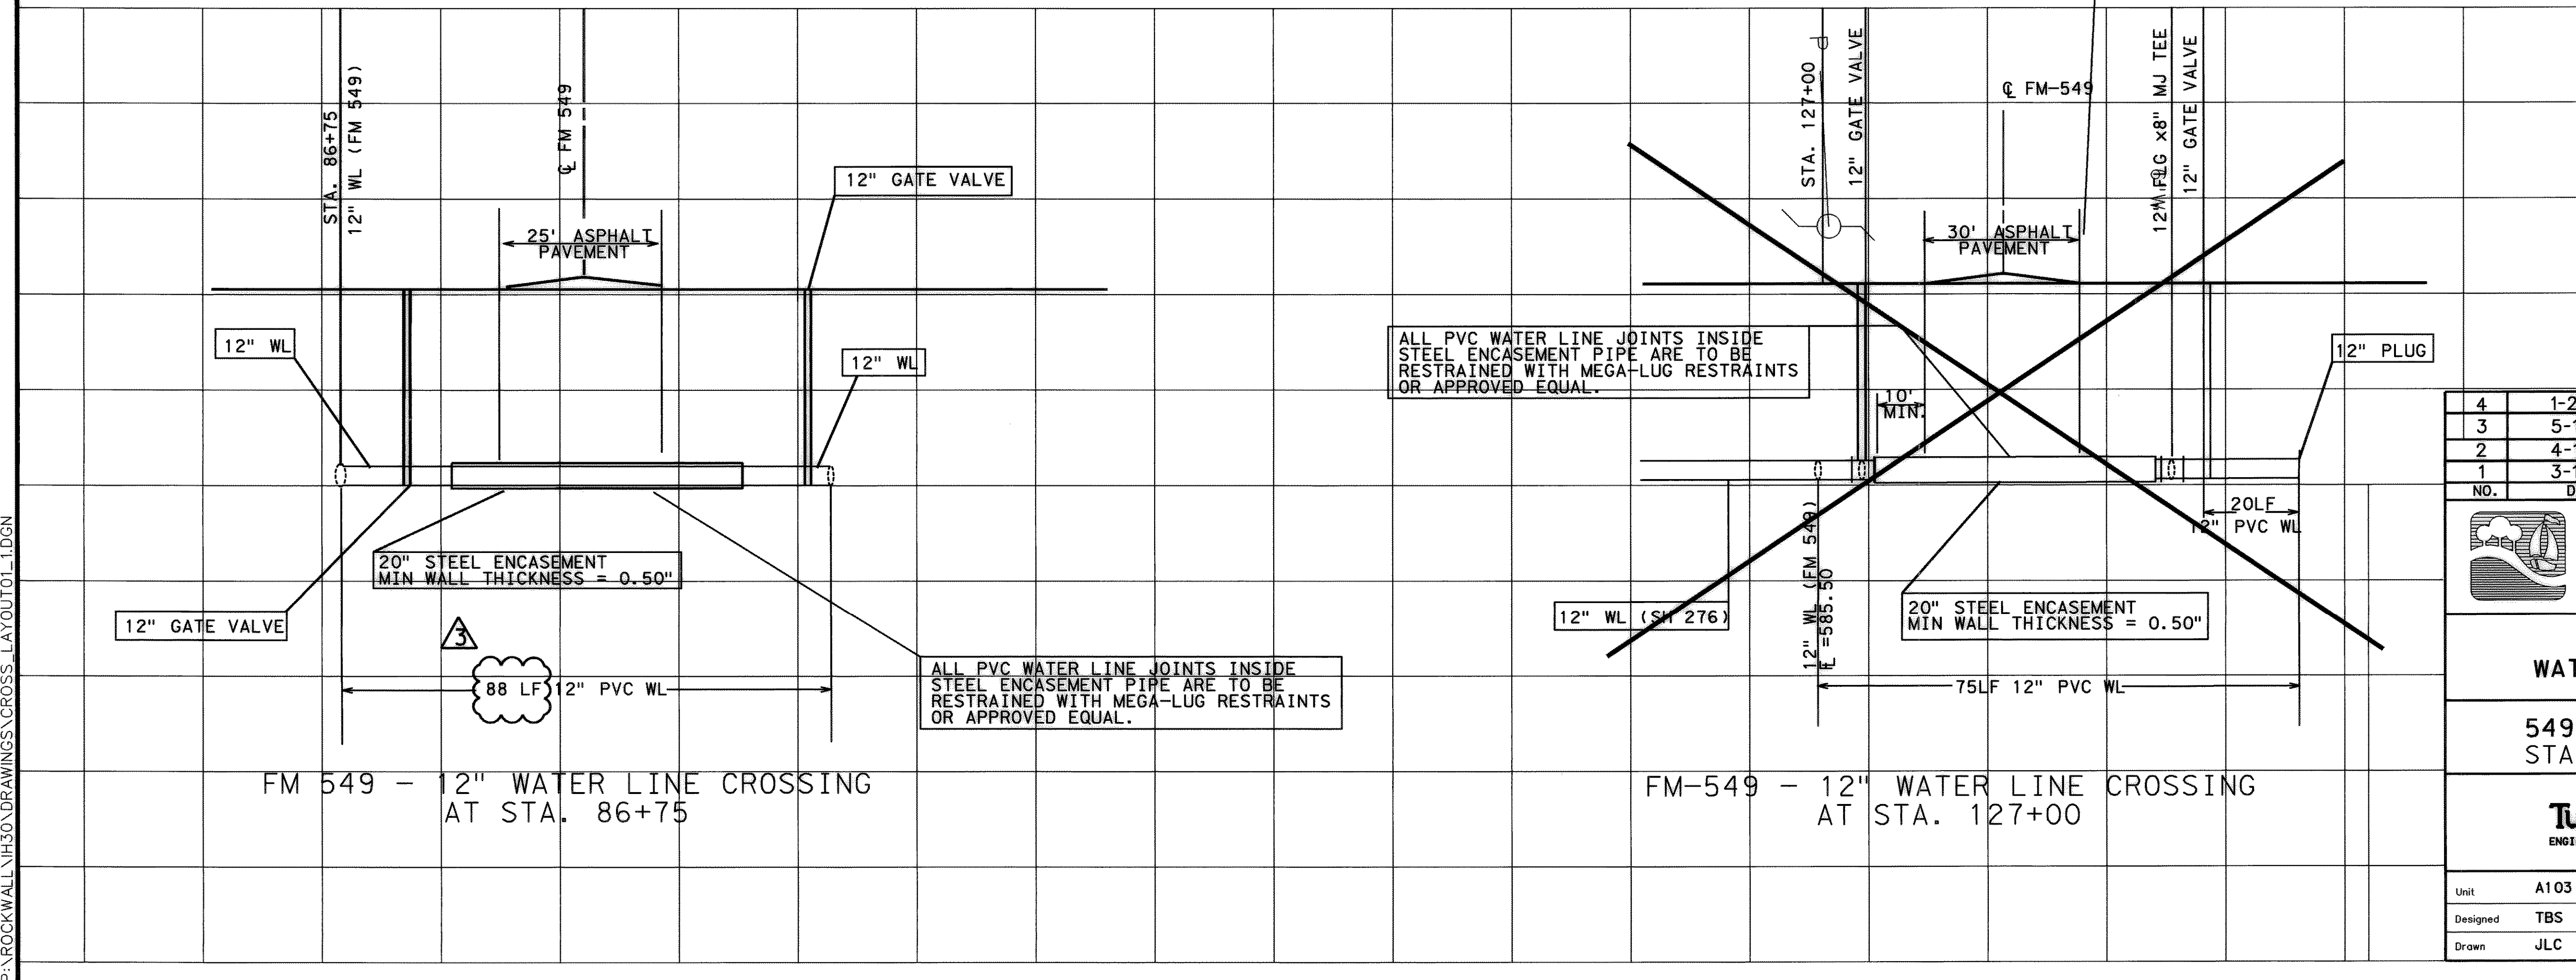

FM 549 - 12" WATER LINE CROSSING AT STA. 86+75

FM-549 - 12" WATER LINE CROSSING AT STA. 127+00

RECORD DRAWING
Voniga Lima
 DATE 3-6-02

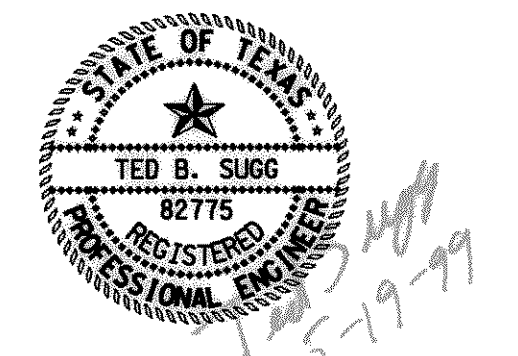

NO.	DATE	REVISION	APPROV
4	1-29-02	RECORD DRAWING	TBS
3	5-19-99	TXDOT CHANGES	TBS
2	4-16-99	CENTERLINE STATIONING	TBS
1	3-17-99	REALIGNMENT	TBS

CITY OF ROCKWALL
 "THE NEW HORIZON"

I.H. 30 AND FM 549
 WATER LINE IMPROVEMENTS

549 WATER LINE CROSSINGS
 STA. 86+75 & STA. 127+00

Turner Collie & Braden Inc.
 ENGINEERS • PLANNERS • PROJECT MANAGERS

Unit	A103	Scale: Horz. 1" = 20' Vert. 1" = 10'	Date	FEBRUARY, 1999
Designed	TBS	Checked	DWN	Job No. 15-98925-200
Drawn	JLC	Approved	RCR	SHEET 23 OF 33

P:\ROCKWALL\NH30\DRAWINGS\CROSS_LAYOUT01-1.DGN