


LEGEND

- POWER POLE
- GUY WIRE
- TELEPHONE BOX
- POST
- SIGN
- IRON ROD
- FIRE HYDRANT
- WATER METER
- MAILBOX
- WATER METER
- IRRIGATION CONTROL VALVE
- GUARD RAIL
- GAS METER
- GROUND LIGHT
- CHAIN LINK FENCE
- WOOD FENCE
- ASH TREE
- OAK TREE
- CEDAR TREE
- BARBED WIRE FENCE
- REFLECTOR
- APPROXIMATE TELEPHONE LINE
- APPROXIMATE GAS LINE
- APPROXIMATE WATER LINE
- OVERHEAD POWER LINE
- PINE TREE
- PECAN TREE

UNDERGROUND UTILITIES

THE LOCATION OF EXISTING UTILITIES SHOWN ON THESE PLANS ARE APPROXIMATE AND BASED ON DATA FURNISHED BY UTILITY COMPANIES. IT IS THE RESPONSIBILITY OF THE CONTRACTOR TO LOCATE AND VERIFY ON-SITE THE UTILITIES THAT MAY CONFLICT WITH THE CONSTRUCTION.

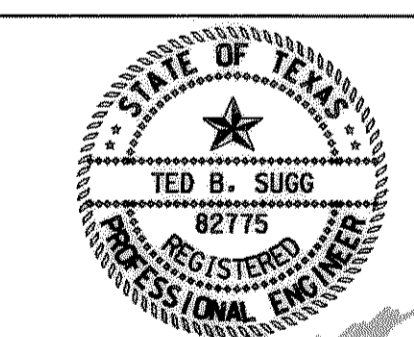

RECORD DRAWING
 VERIFIED BY *[Signature]*
 DATE 11-27-01

| | | | |
|---|---------|------------------------------------|----------------------|
| 1 | 4-16-99 | REALIGNMENT | TBS |
| NO. | DATE | REVISION | APPROV |
| CITY OF ROCKWALL "THE NEW HORIZON" | | | |
| I.H. 30 AND FM 549 WATER LINE IMPROVEMENTS | | | |
| UTILITY PLAN AND PROFILE 16" PVC WATER LINE STA. 0+00 TO STA. 9+00 | | | |
| Turner Collie & Braden Inc. ENGINEERS • PLANNERS • PROJECT MANAGERS | | | |
| Unit | A103 | Scale: Horz. 1"=40' Vert. 1"=5' | Date FEBRUARY, 1999 |
| Designed | TBS | Checked DWN | Job No. 15-98925-200 |
| Drawn | JLC | Approved RCR | SHEET 3 OF 33 |

P:\ROCKWALL\1509\DWG\1509-01.DWG